



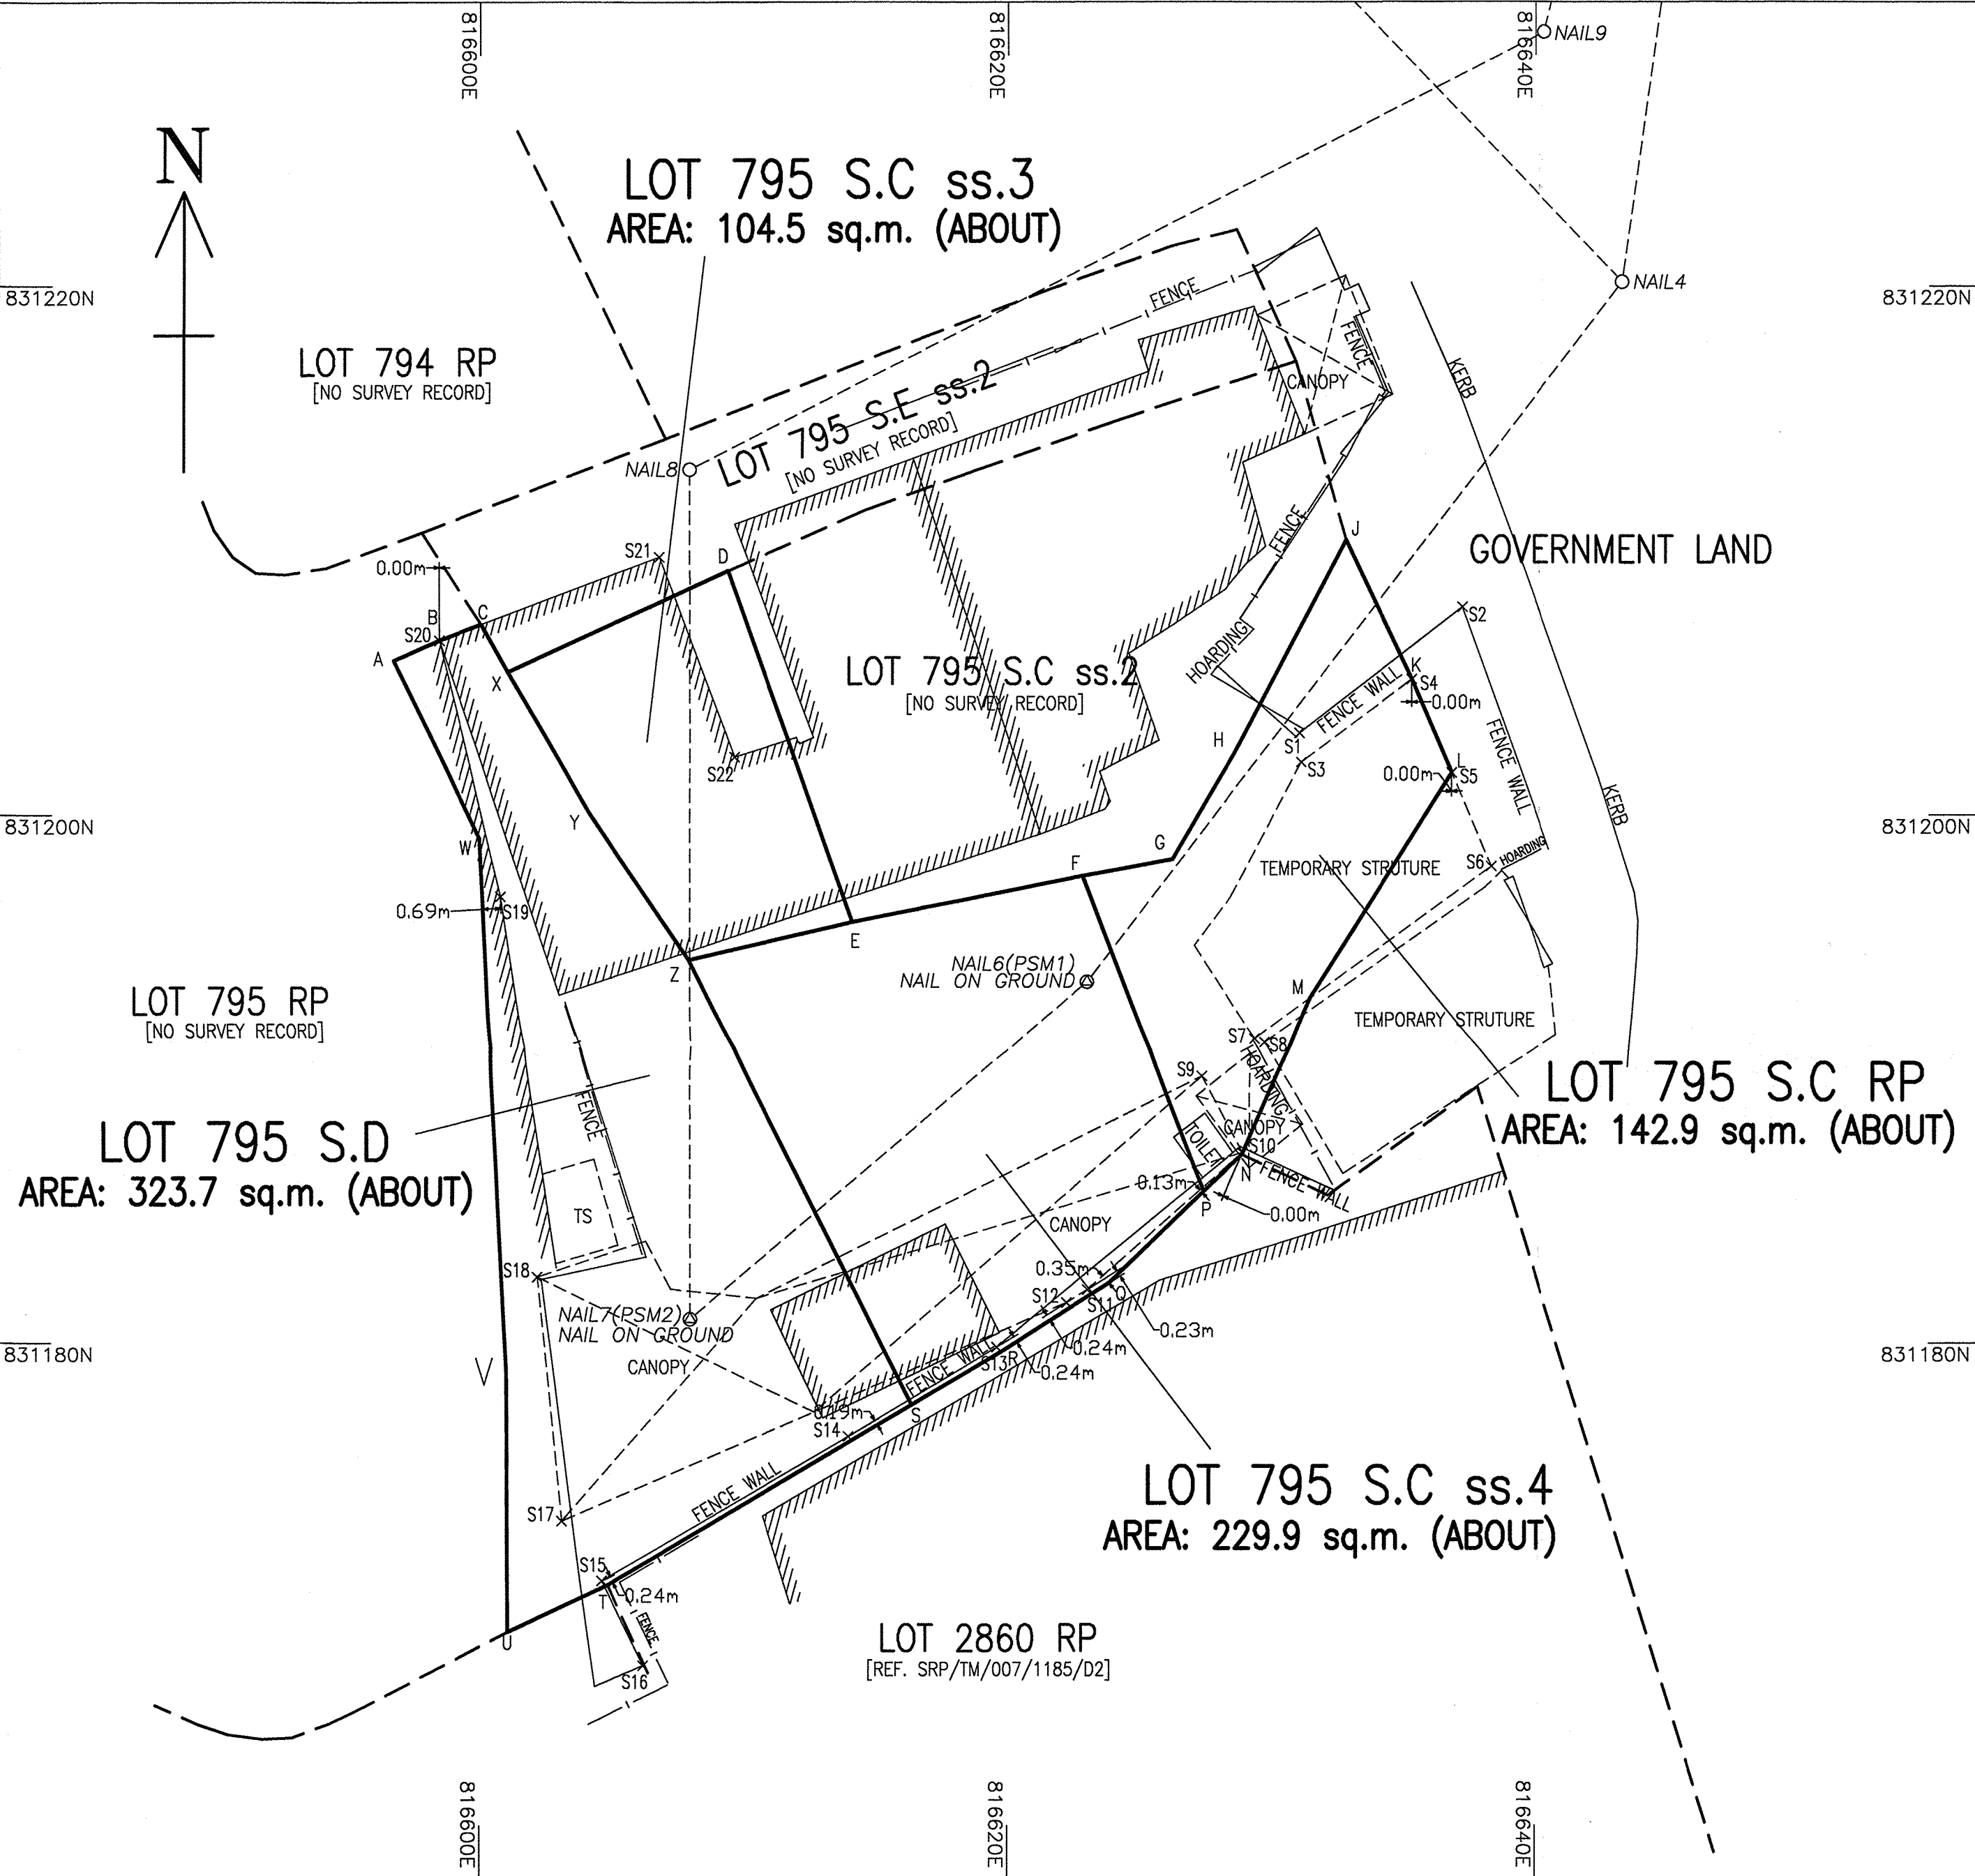

TRAVERSE				
Station Point	Bearing	Distance	Northing	Easting
OUSM8160.014				
NAIL1	208°44'36"	168.521	831657.252	816698.430
NAIL2	217°53'00"	116.042	831417.907	816546.137
NAIL3	144°26'10"	179.482	831271.904	816650.527
NAIL4	187°57'55"	52.252	831220.156	816643.286
NAIL5	316°05'24"	201.338	831365.206	816503.655
OUSM8160.013				
NAIL4	03°54'12"	56.303	831421.378	816507.488
FROM NAIL6(PSM1)				
NAIL6(PSM1)	217°27'04"	33.336	831193.692	816623.016
FROM NAIL7(PSM2)				
NAIL7(PSM2)	229°37'24"	19.739	831180.905	816607.979
NAIL8	359°54'23"	32.155	831213.061	816607.926
NAIL9	62°57'17"	36.366	831229.597	816640.316
NAIL3	13°34'05"	43.521	831271.904	816650.527
RADIATIONS				
Survey Point	Bearing	Distance	Northing	Easting
FROM NAIL6(PSM1)				
TO S1	40°31'51"	12.363	831203.089	816631.050
S2	45°05'39"	20.051	831207.847	816637.217
S3	44°20'06"	11.598	831201.988	816631.121
S4	47°04'16"	16.780	831205.121	816635.302
S5	60°13'55"	15.897	831201.585	816636.815
S6	74°02'50"	15.917	831198.067	816638.320
S7	108°47'45"	6.868	831191.538	816629.345
S8	108°49'45"	7.087	831191.405	816629.723
S9	129°38'59"	5.644	831190.091	816627.361
S10	137°46'09"	8.764	831187.203	816628.906
S11	179°56'38"	11.682	831182.010	816623.027
S12	183°40'20"	12.187	831181.530	816622.235
S13	193°54'13"	14.248	831179.862	816619.592
FROM NAIL7(PSM2)				
TO S14	126°35'21"	7.449	831180.905	816607.979
S15	198°39'40"	10.443	831176.465	816613.960
S16	187°46'23"	13.217	831171.011	816604.637
S17	212°29'12"	9.046	831167.810	816606.191
S18	285°19'49"	6.001	831173.275	816603.120
S19	335°45'27"	17.573	831182.492	816602.191
FROM NAIL8				
TO S20	235°44'28"	11.479	809447.421	829613.705
S21	199°10'15"	3.503	809447.421	829613.705
S22	171°05'36"	11.010	809447.421	829613.705

NOTES :				
SUBJECT LOT COORDINATES & DIMENSIONS:				
Boundary Point	Bearing	Distance	Northing	Easting
SUBJECT LOT NO. 795 S.D in D.D.130				
A			831205.829	816596.703
B	66°04'49"	1.899	831206.599	816598.439
C	69°16'53"	1.690	831207.197	816600.020
X	150°38'27"	2.064	831205.398	816601.032
Y	149°52'26"	6.135	831200.092	816604.111
Z	145°43'22"	6.738	831194.524	816607.906
S	153°21'51"	18.857	831177.668	816616.360
T	239°20'33"	13.379	831170.846	816604.851
U	244°48'46"	4.185	831169.065	816601.064
V	359°38'24"	9.871	831178.936	816601.002
W	357°03'21"	20.210	831199.119	816599.964
A	334°04'50"	7.460	831205.829	816596.703
AREA: 323.7 sq.m. (about)				

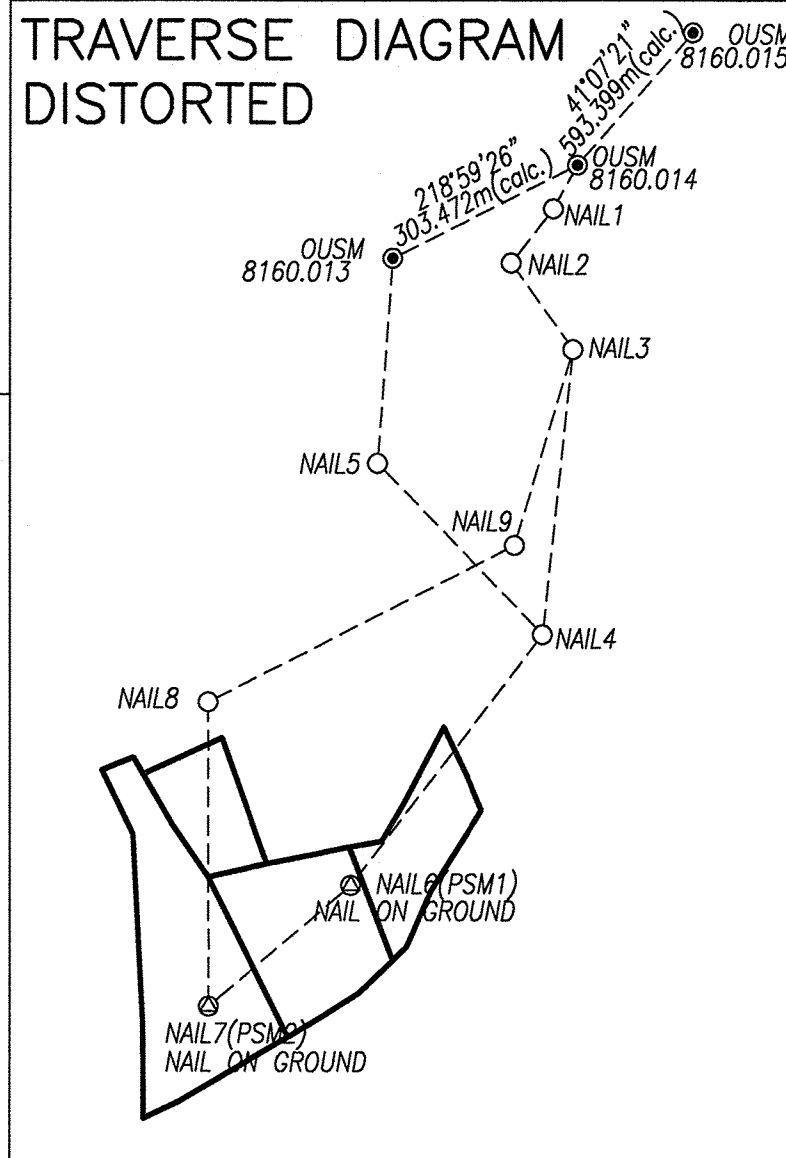

SUBJECT LOT NO. 795 S.C ss.3 in D.D.130				
X			831205.398	816601.032
D	65°19'59"	9.182	831209.230	816609.376
E	160°24'50"	14.089	831195.956	816614.099
Z	256°58'49"	6.356	831194.524	816607.906
Y	325°43'22"	6.738	831200.092	816604.111
X	329°52'26"	6.135	831205.398	816601.032
AREA: 104.5 sq.m. (about)				
SUBJECT LOT NO. 795 S.C ss.4 in D.D.130				
Z			831194.524	816607.906
E	76°58'49"	6.356	831195.956	816614.099
F	78°39'26"	8.908	831197.708	816622.833
P	159°00'29"	12.829	831185.730	816627.429
Q	225°55'35"	4.986	831182.262	816623.847
R	237°42'10"	4.701	831179.750	816619.873
S	239°20'48"	4.084	831177.668	816616.360
Z	333°21'51"	18.857	831194.524	816607.906
AREA: 229.9 sq.m. (about)				

SUBJECT LOT NO. 795 S.C RP in D.D.130				
F			831197.708	816622.833
G	79°42'52"	3.456	831198.325	816626.233
H	30°25'21"	4.593	831202.286	816628.559
J	27°37'16"	9.148	831210.391	816632.800
K	154°36'12"	5.834	831205.121	816635.302
L	156°50'05"	3.846	831201.585	816636.815
M	212°11'25"	10.056	831193.075	816631.458
N	203°27'53"	6.474	831187.136	816628.880
P	225°54'09"	2.020	831185.730	816627.429
F	339°00'29"	12.829	831197.708	816622.833
AREA: 142.9 sq.m. (about)				

TABLE OF AREA	
D.D.130	SURVEYED AREA
795 S.D	323.7 sq.m.(about)
795 S.C ss.3	104.5 sq.m.(about)
795 S.C ss.4	229.9 sq.m.(about)
795 S.C RP	142.9 sq.m.(about)
TOTAL	801.0 sq.m.(about)

I, WONG YIU CHO JOSEPH, an Authorized Land Surveyor registered under the Land Survey Ordinance (Cap.473), hereby certify that this survey record plan has been prepared from land boundary surveys that were carried out by me or under my direct supervision in conformity with the Code of Practice approved by the Land Survey Authority under the above Ordinance, and that this plan correctly represents that survey completed on the sixteenth of June 20 15.

Dated this twenty-eighth day of August 20 15
.....
Authorized Land Surveyor

Survey District : TUEN MUN
Date of survey: JUNE 2015
Scale 1:200 Field Bk: 4233
Survey Sheet : 6-NW-17C&22A
Reference SRP's : SRP/TM/007/1185/D2

PLAN OF LOT NOS. 795 S.C ss.3, 795 S.C ss.4,
795 S.C RP AND 795 S.D IN D.D.130 AT
LAM TEI, TUEN MUN, NEW TERRITORIES

FOR OFFICE USE

SRP NO.: SRP/TM/057/4233/D1