


Responses-to-Comments


**Temporary Shop and Services and Eating Place with Ancillary Facilities
for a Period of 5 Years in "Open Space" Zone, Lot 2905 S.C RP (Part) in D.D.104
and Adjoining Government Land, Mai Po, Yuen Long, New Territories**

(Application No. A/YL-MP/382)


- (i) The applicant has provided supplementary photographic records in response to the following comments from the Chief Engineer/Mainland North, Drainage Services Department:
- Photo 4, 8 and 10 - Waste was observed in the surface channel. Please remove.
 - Photo 7 - The size of u-channel was changed in the middle of channel. Please rectify.
 - Photo 8 - The internal and general view of discharge connection point still cannot be identified. Please provide photo record for general view as well.

As-built drainage plan

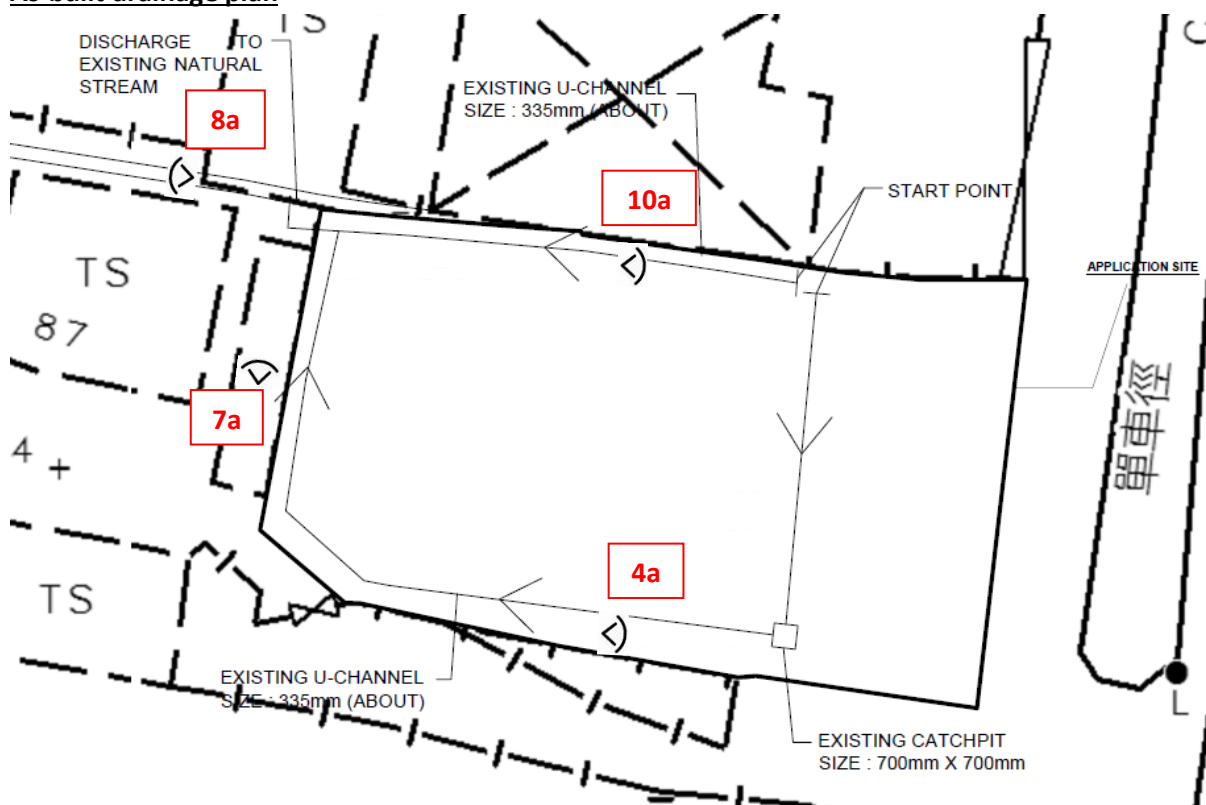

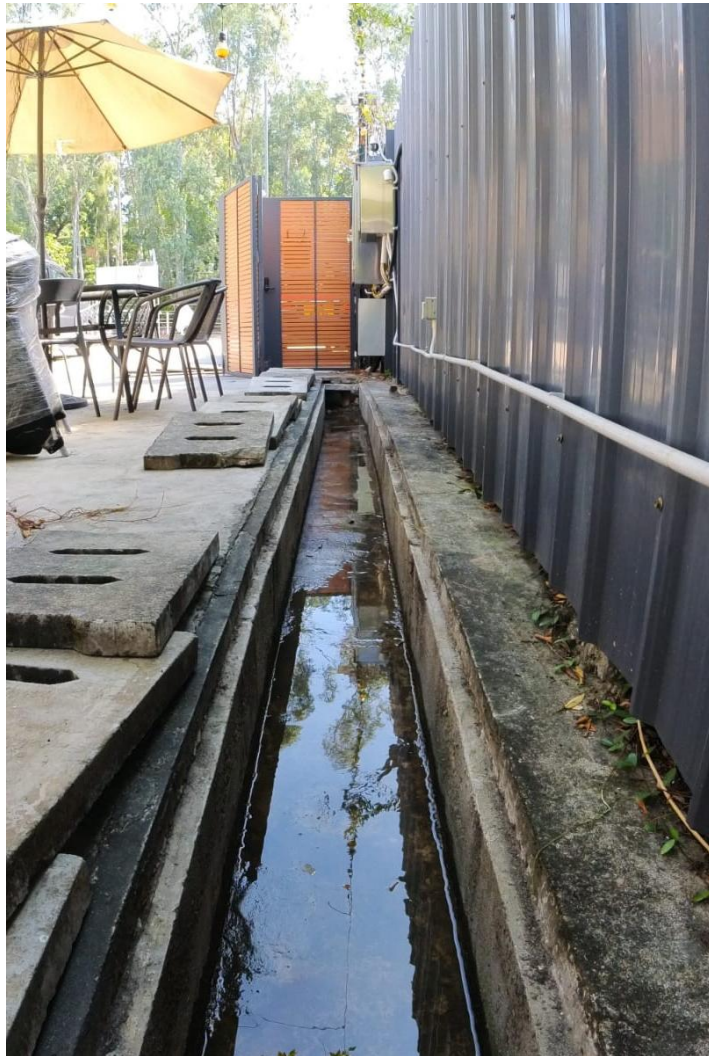

Viewpoint 4a

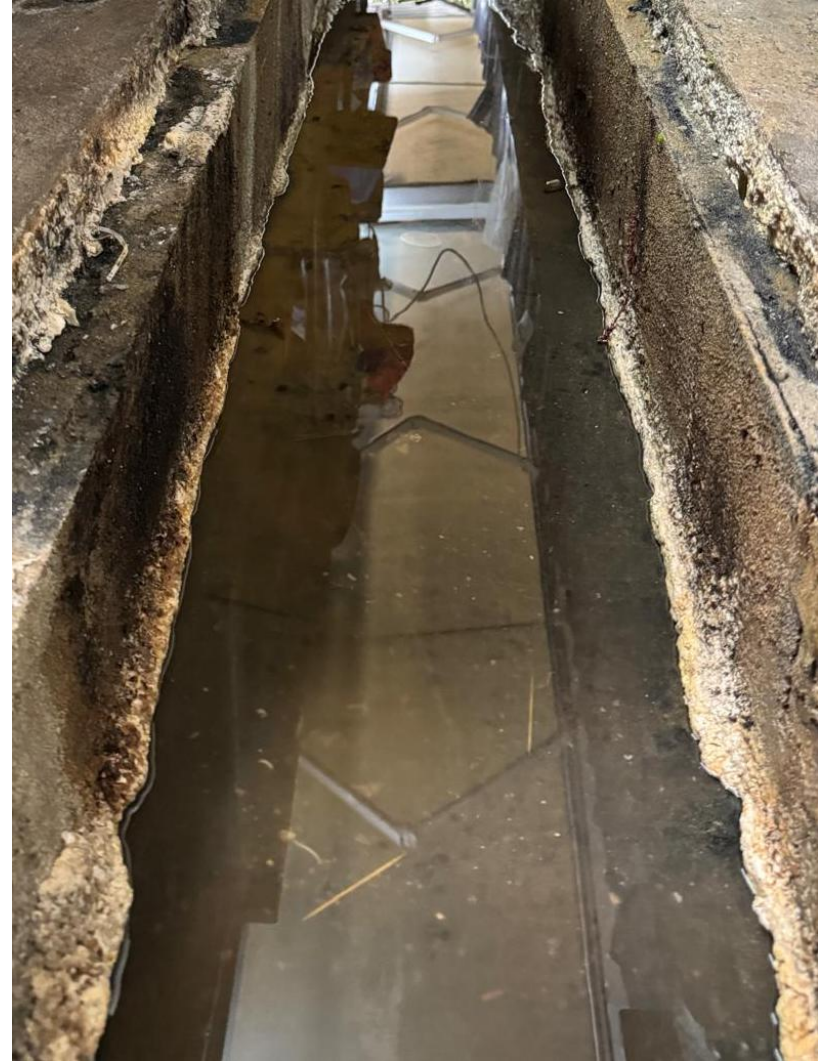

Viewpoint 7a



Viewpoint 8a



Viewpoint 10a