
Appendix A
Supplementary Drawings



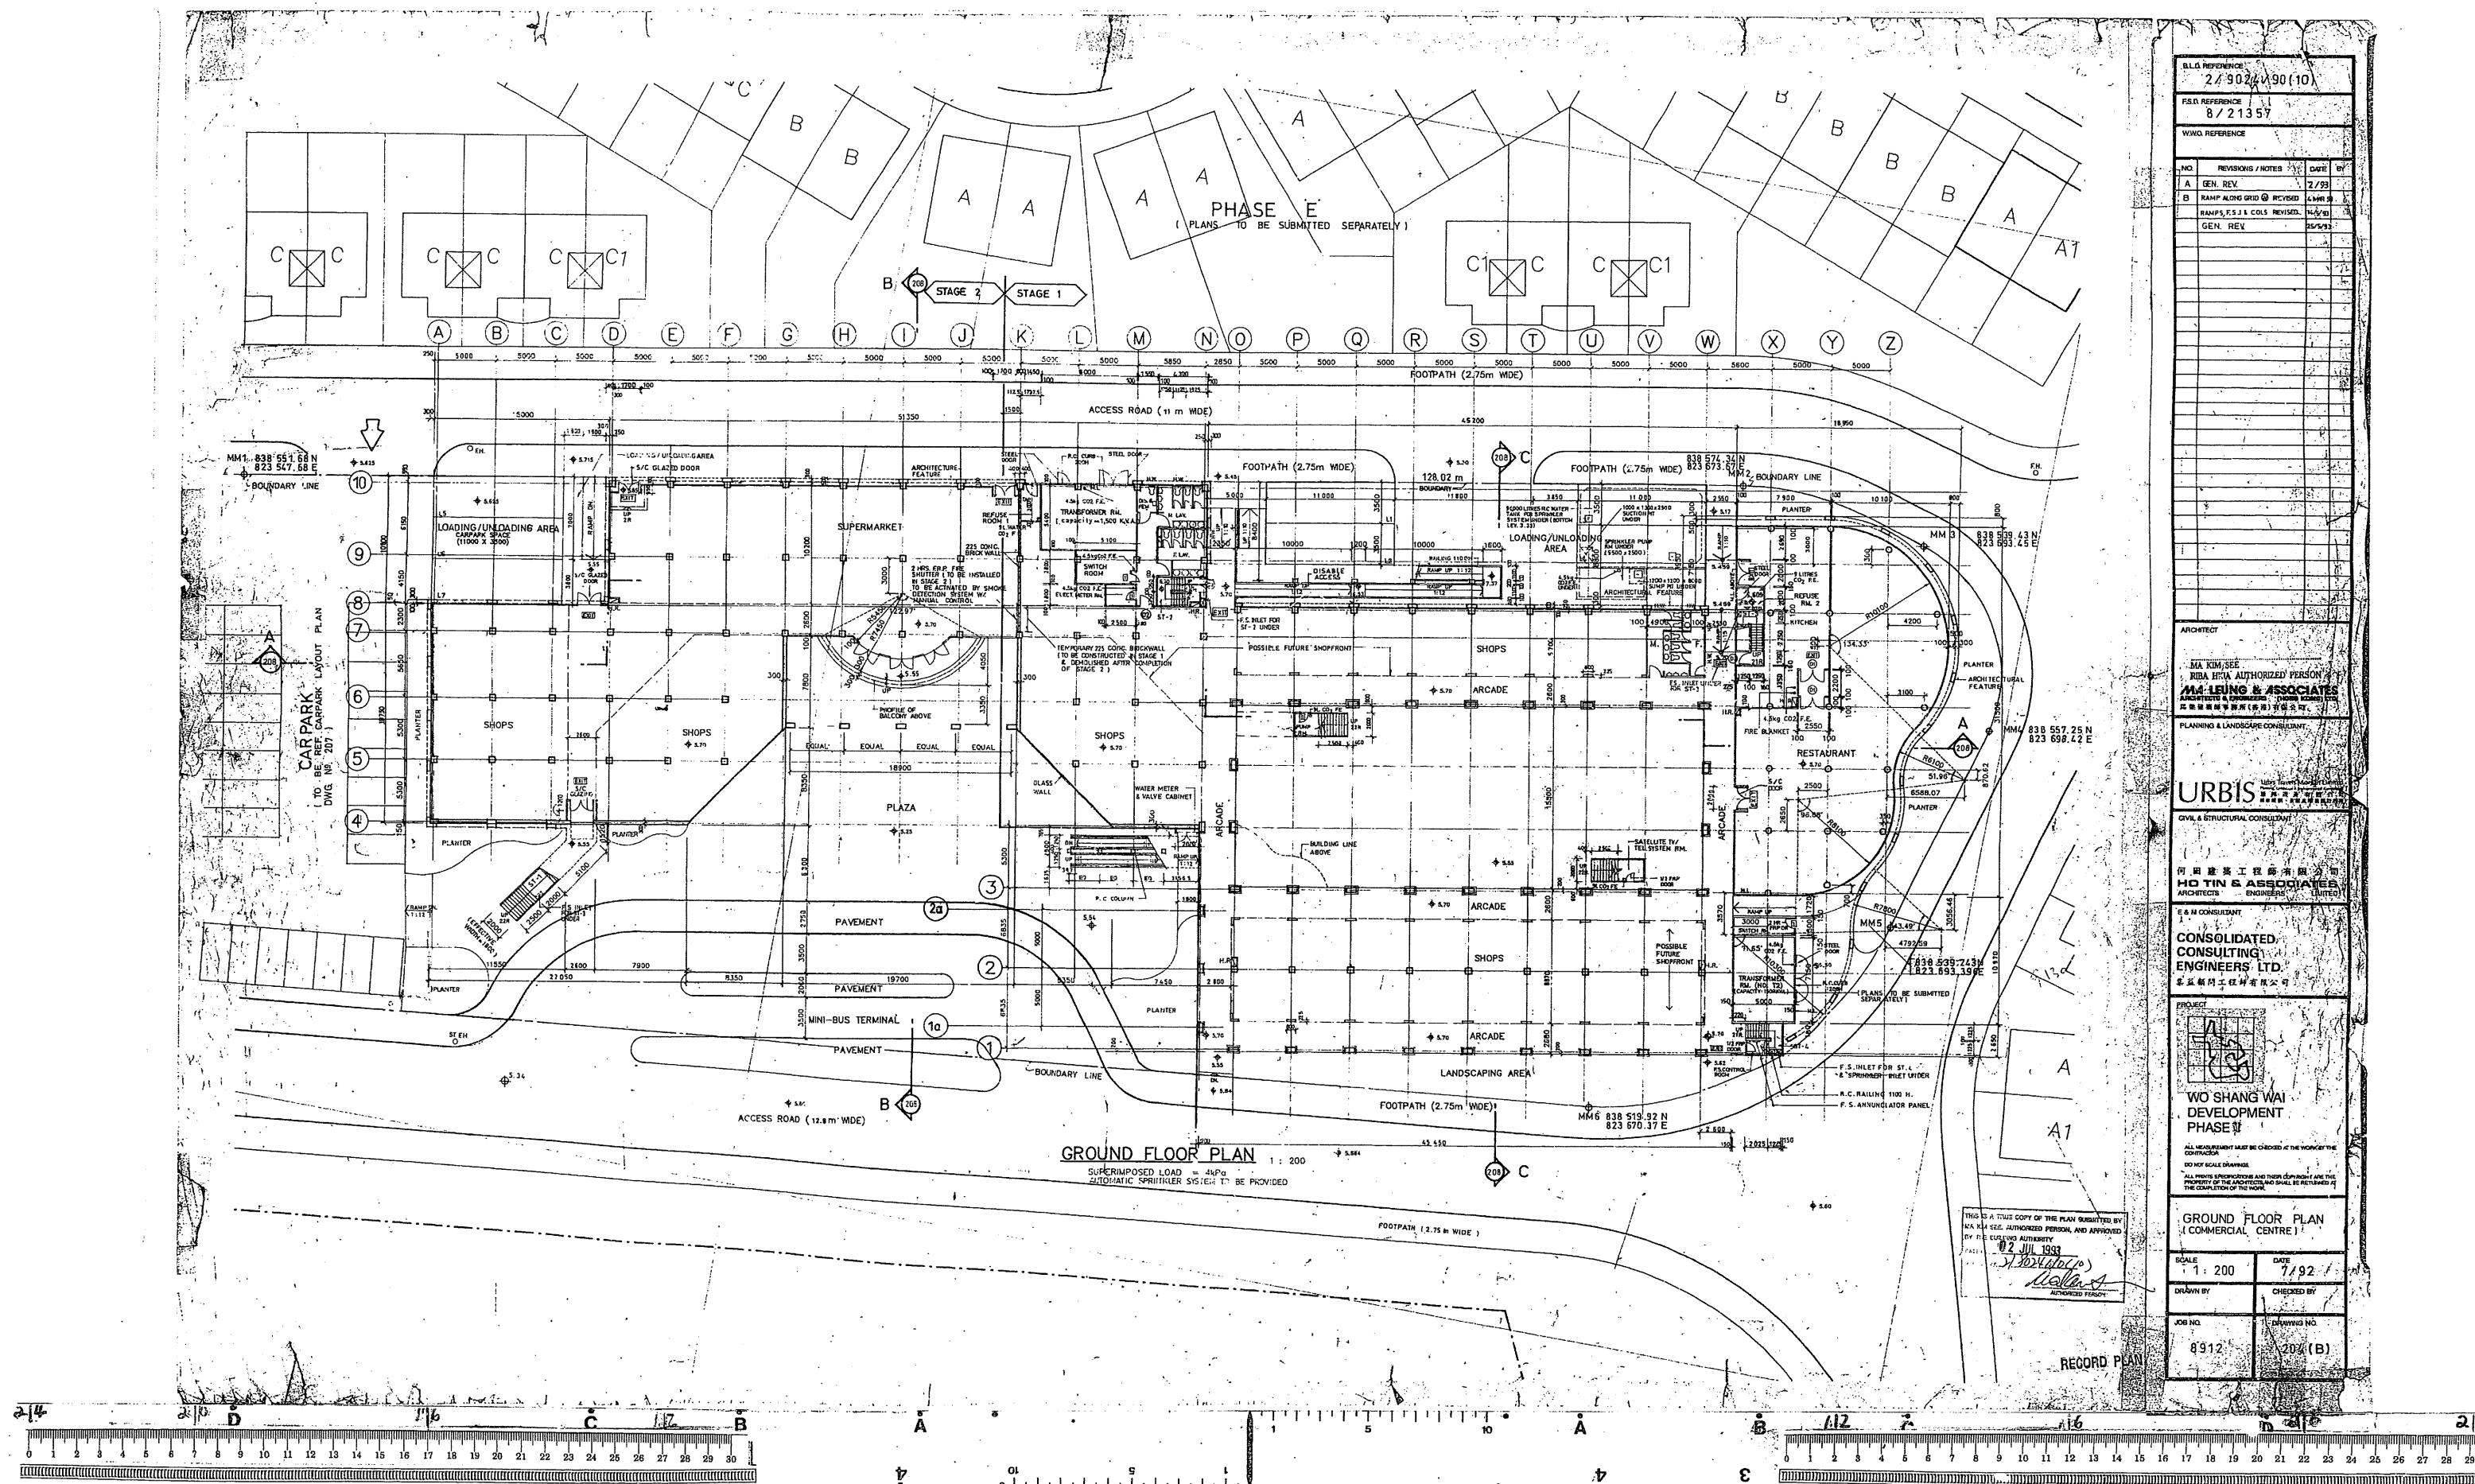


Figure 1a: G/F Plan of Palm Springs Plaza

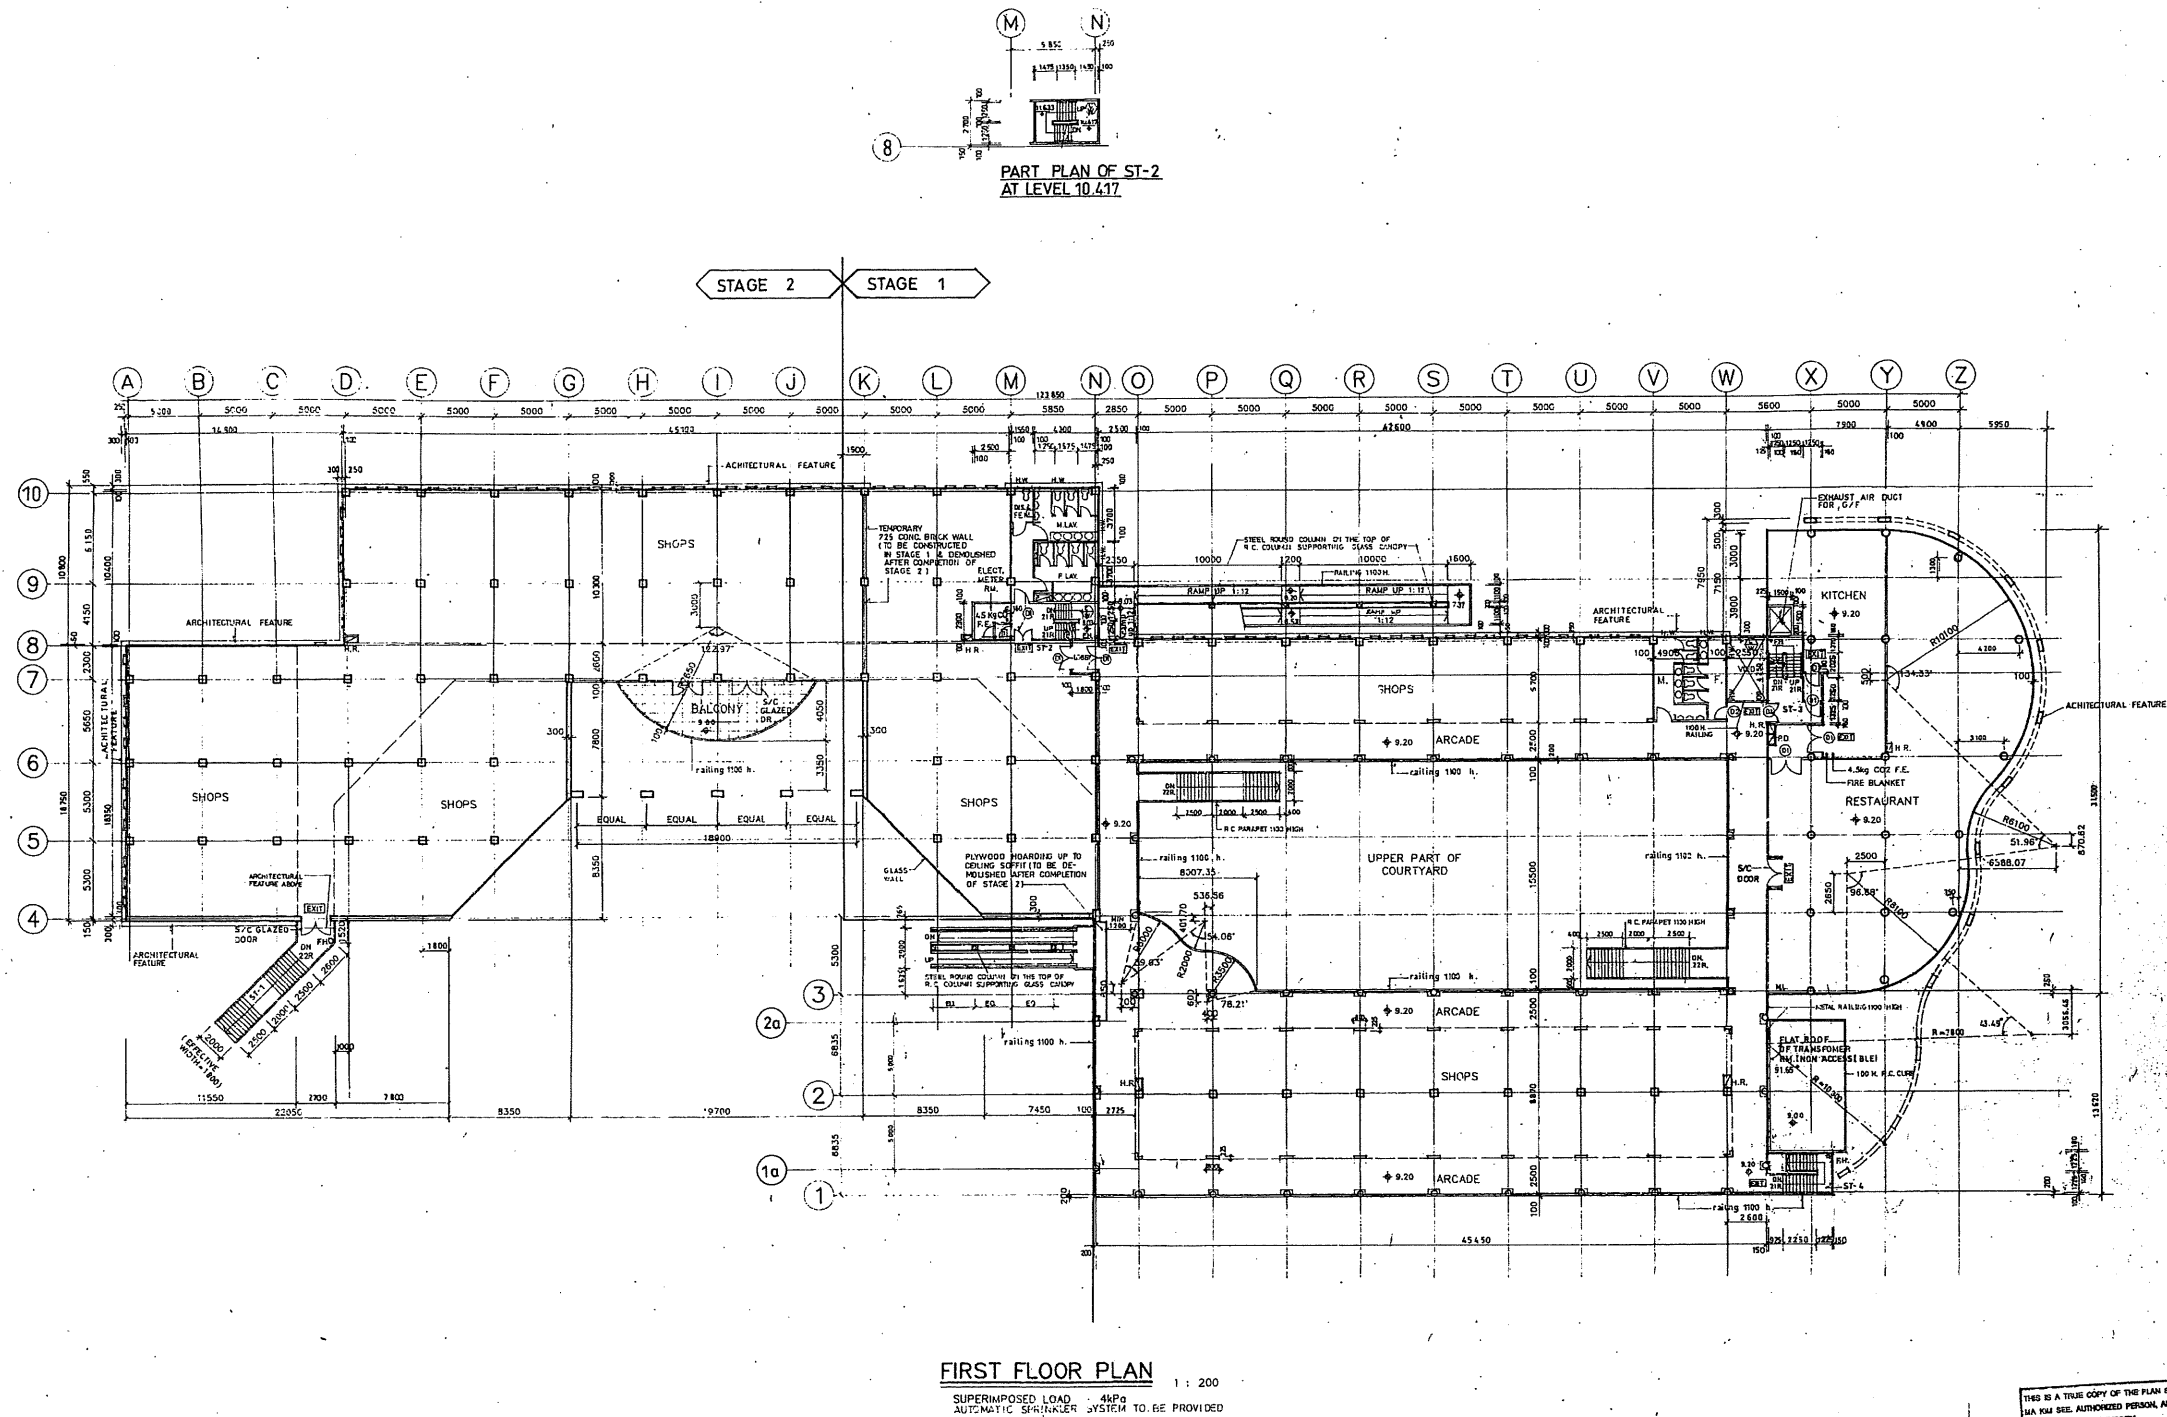

B.L.D. REFERENCE 2/9024/90(10)			
R.S.D. REFERENCE 8/21357			
W.W.D. REFERENCE			
NO.	REVISIONS / NOTES	DATE	BY
A	GEN. REV.	2/93	
B	GEN. REV.	5/93	
ARCHITECT			
KIA KIM SEE RIBA REG. AUTHORIZED PERSON MA LEUNG & ASSOCIATES ARCHITECTS & ENGINEERS (INCORPORATED IN H.K.) 香港測量師學會 (香港) 註冊分會			
PLANNING & LANDSCAPE CONSULTANT			
URBIS LIFE INVESTMENT MANAGEMENT CIVIL & STRUCTURAL CONSULTANT			
何田建築工程師有限公司 HO TIN & ASSOCIATES ARCHITECTS (ENGINEERS) - LIMITED E & M CONSULTANT			
CONSOLIDATED CONSULTING ENGINEERS LTD. 葛立頓工程顧問有限公司			
PROJECT			
 WO SHANG WAI DEVELOPMENT PHASE I			
ALL MEASUREMENTS MUST BE CHECKED AT THE WORK IN THE CONTRACTOR. DO NOT SCALE DRAWINGS. ALL NOTES SPECIFICATIONS AND THEIR COMMENTS ARE THE PROPERTY OF THE ARCHITECTS AND SHALL BE RETURNED AT THE COMPLETION OF THE WORK.			
FIRST FLOOR PLAN (COMMERCIAL CENTRE)			
SCALE 1: 200	DATE 7/92		
DRAWN BY	CHECKED BY		
JOB NO. 8912	DRAWING NO. 205(B)		


Figure 1b: 1/F Plan of Palm Springs Plaza

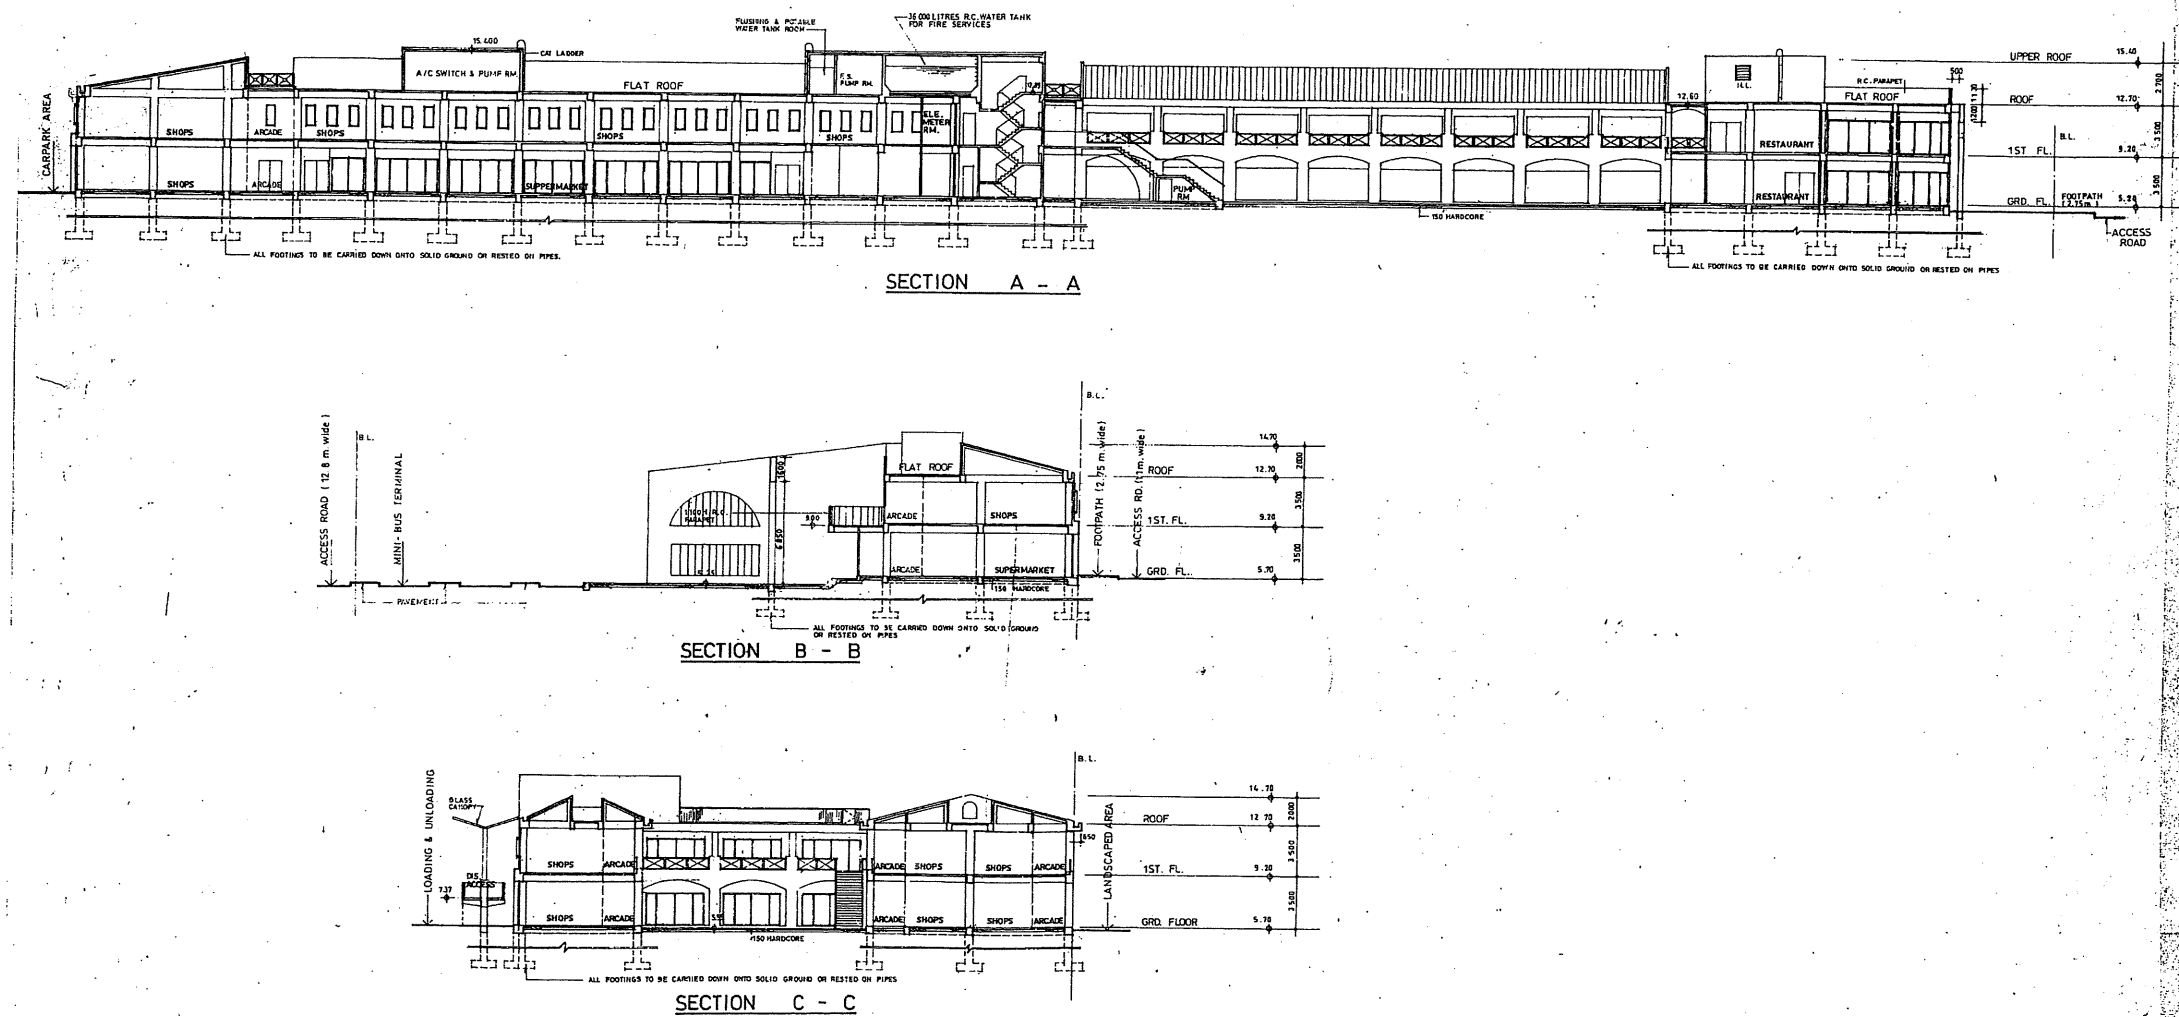

S.D. REFERENCE		2/9024/90 (10)	
P.S.D. REFERENCE		8/21357	
W.W.D. REFERENCE			
NO.	REVISIONS / NOTES	DATE	BY
A	GEN. REV.	2/93	
B	GEN. REV.	5/93	
ARCHITECT			
MA KIM SEE RIBA HKIA AUTHORIZED PERSON MA LEUNG & ASSOCIATES ARCHITECTS & ENGINEERS 香港建築師學會 (會員) 註冊建築師			
PLANNING & LANDSCAPE CONSULTANT			
URBIS Urban Design & Planning URBAN DESIGN & PLANNING 香港城市規劃師學會 (會員) 註冊城市規劃師			
CIVIL & STRUCTURAL CONSULTANT			
何田建築工程顧問有限公司 HO TIN & ASSOCIATES ARCHITECTS & ENGINEERS 香港工程師學會 (會員) 註冊工程師			
E & M CONSULTANT			
CONSOLIDATED CONSULTING ENGINEERS LTD. 香港聯合工程師有限公司			
PROJECT			
 WO SHANG WAI DEVELOPMENT PHASE I ALL MEASUREMENTS SHOWN ARE BASED ON THE RECORD OF THE CONSTRUCTION. DO NOT SCALE DRAWINGS. ALL RIGHTS RESERVED AND THIS DOCUMENT AND THE PROPERTY OF THE ARCHITECTS AND SHALL BE RETURNED AT THE COMPLETION OF THE WORK.			
SEC. A-A, B-B & C-C (COMMERCIAL CENTRE)			
SCALE	1:200	DATE	7/92
DRAWN BY		CHECKED BY	
JOB NO.	8912	DRAWING NO.	208 (B)


Figure 1c: Section Plan of Palm Springs Plaza

Figure 2a - Existing Uses of Palm Springs Plaza – G/F

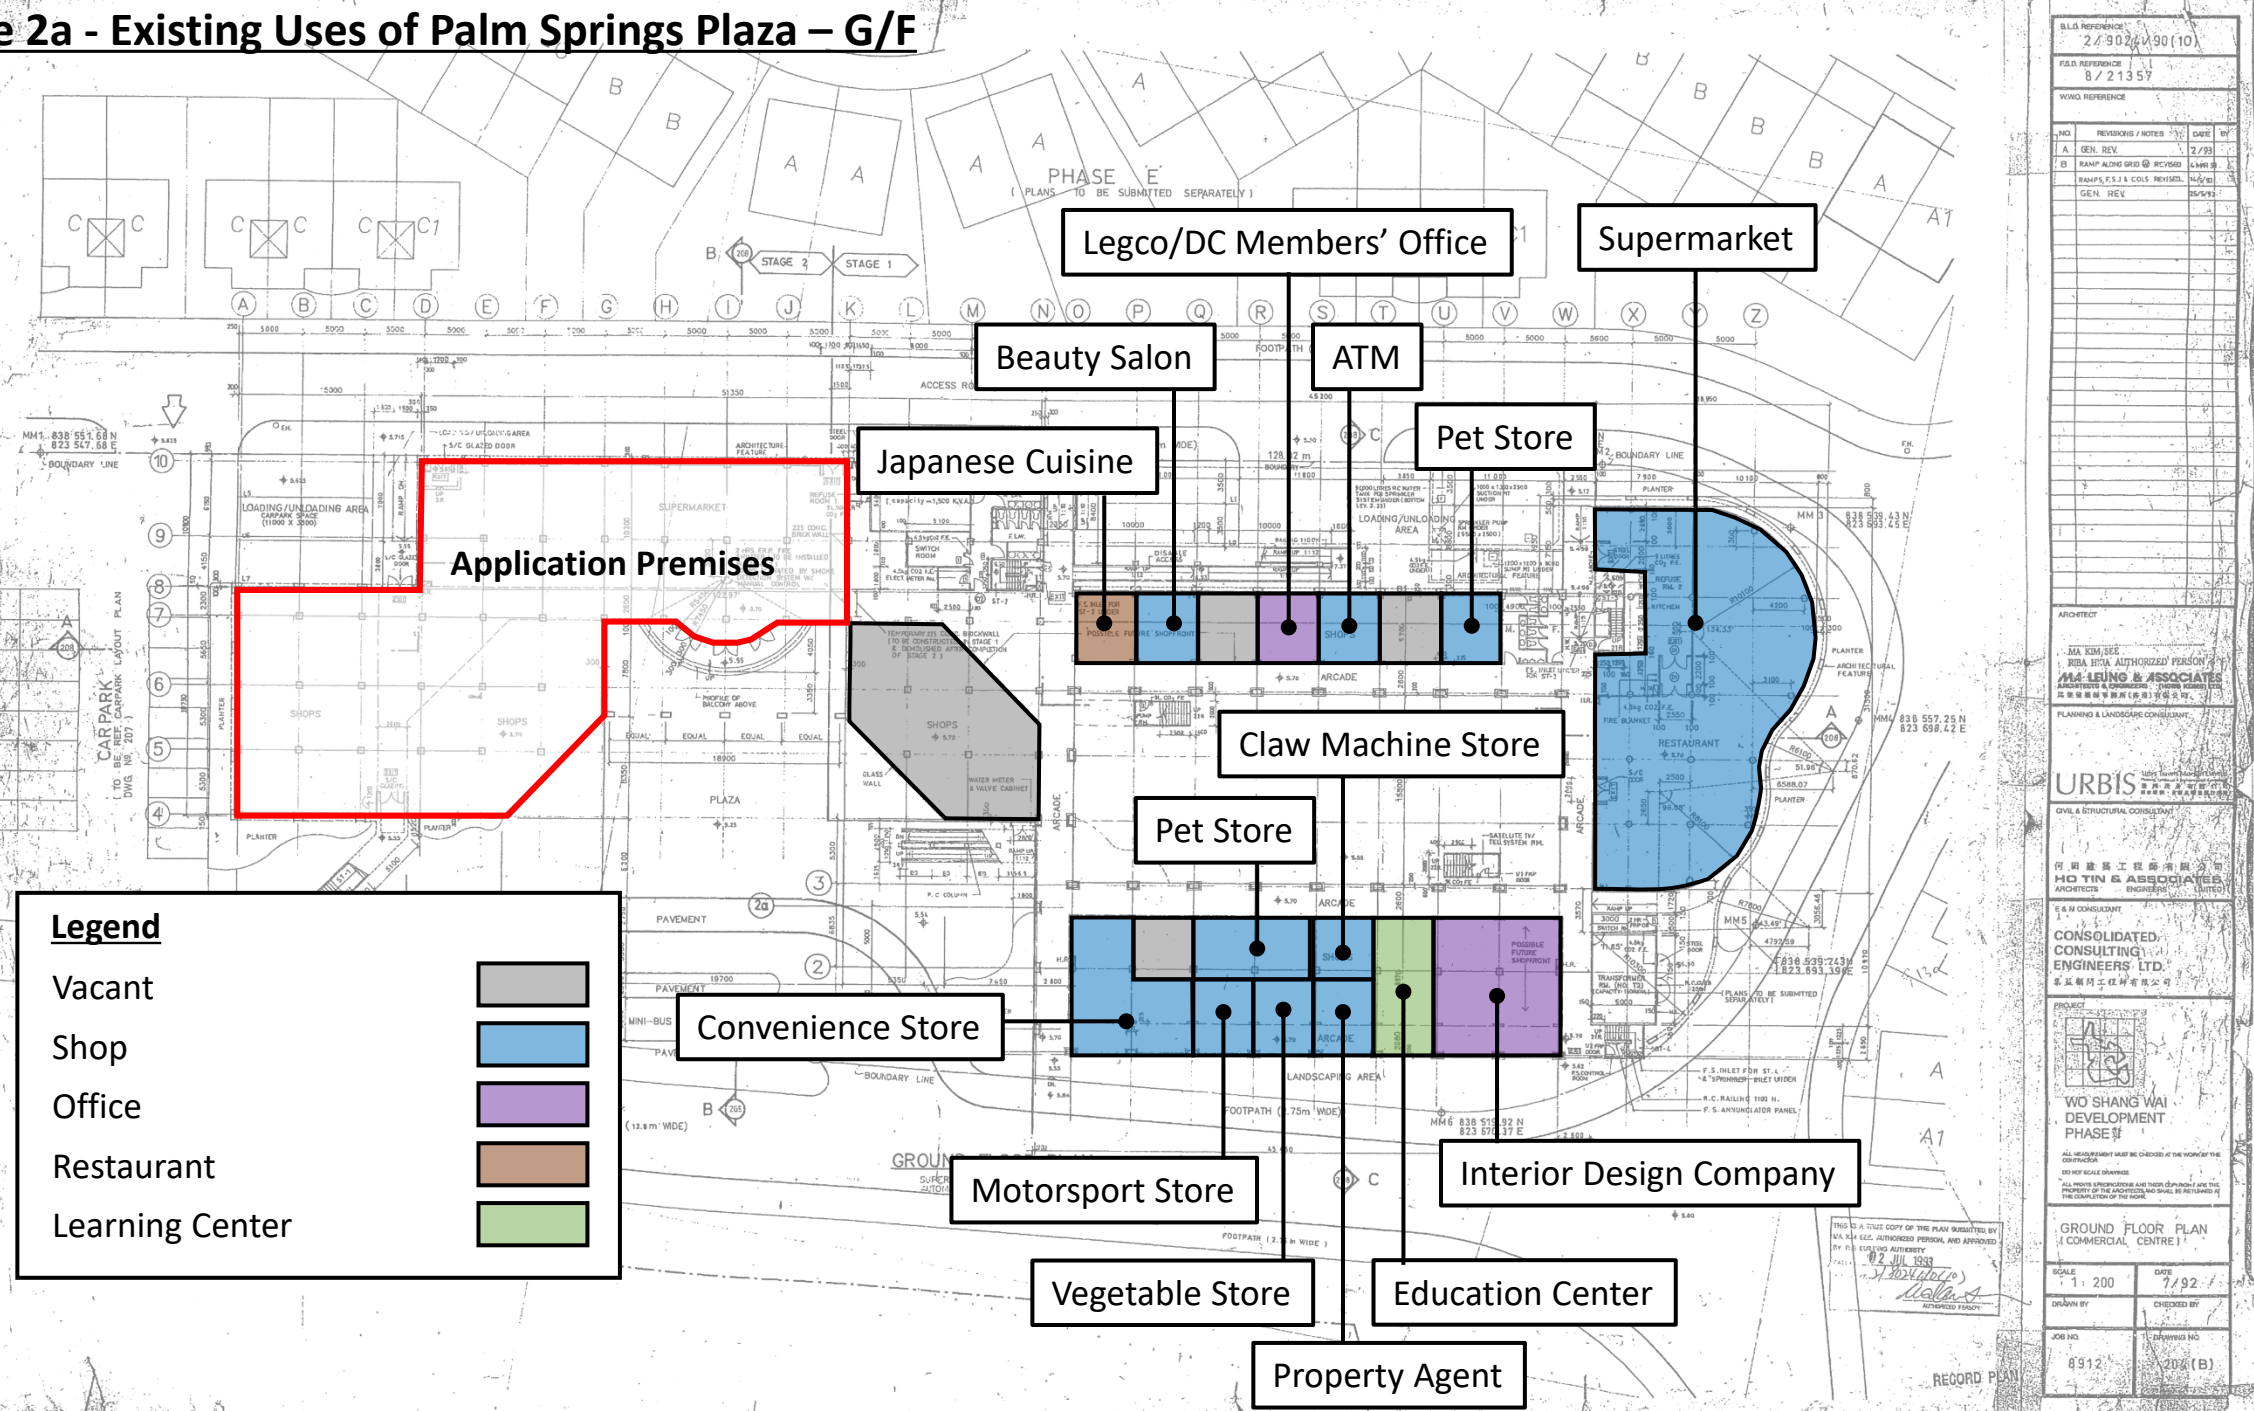

B.L.S. REFERENCE 24/9024/90(10)			
FIELD REFERENCE 8/21355			
WING REFERENCE			
NO.	REVISIONS / NOTES	DATE	BY
A	GEN. REV.	2/99	
B	RAMP ALONG GRID @ REVISION	4/99	
	RAMP, F.S. & C.O.S. REVISION	10/99	
	GEN. REV.	10/99	
ARCHITECT			
KIM KIM SEE KIM KIM SEE AUTHORIZED PERSON M.A. LEUNG & ASSOCIATES ARCHITECTS & ENGINEERS (INCORPORATED IN H.K.) PLANNING & LANDSCAPE CONSULTANT			
URBIS CIVIL & STRUCTURAL CONSULTANT			
何國建建築工程師有限公司 HO TIN & ASSOCIATES ARCHITECTS S.A. IN CONSULTANT			
CONSOLIDATED CONSULTING ENGINEERS LTD. CONSOLIDATED CONSULTING ENGINEERS LTD.			
PROJECT			
WU SHANG WAI DEVELOPMENT PHASE II			
ALL MEASUREMENTS MUST BE CHECKED AT THE WORK OF THE CONTRACTOR DO NOT SCALE DRAWINGS ALL RIGHTS RESERVED AND THEIR CLARIFICATION ARE THE PROPERTY OF THE ARCHITECTS AND SHALL BE RETURNED AT THE COMPLETION OF THE WORK.			
GROUND FLOOR PLAN (COMMERCIAL CENTRE I)			
SCALE 1: 200	DATE 7/92		
DRAWN BY	CHECKED BY		
JOB NO.	DRAWING NO.		
8912	204 (B)		

Figure 2b - Existing Uses of Palm Springs Plaza – 1/F

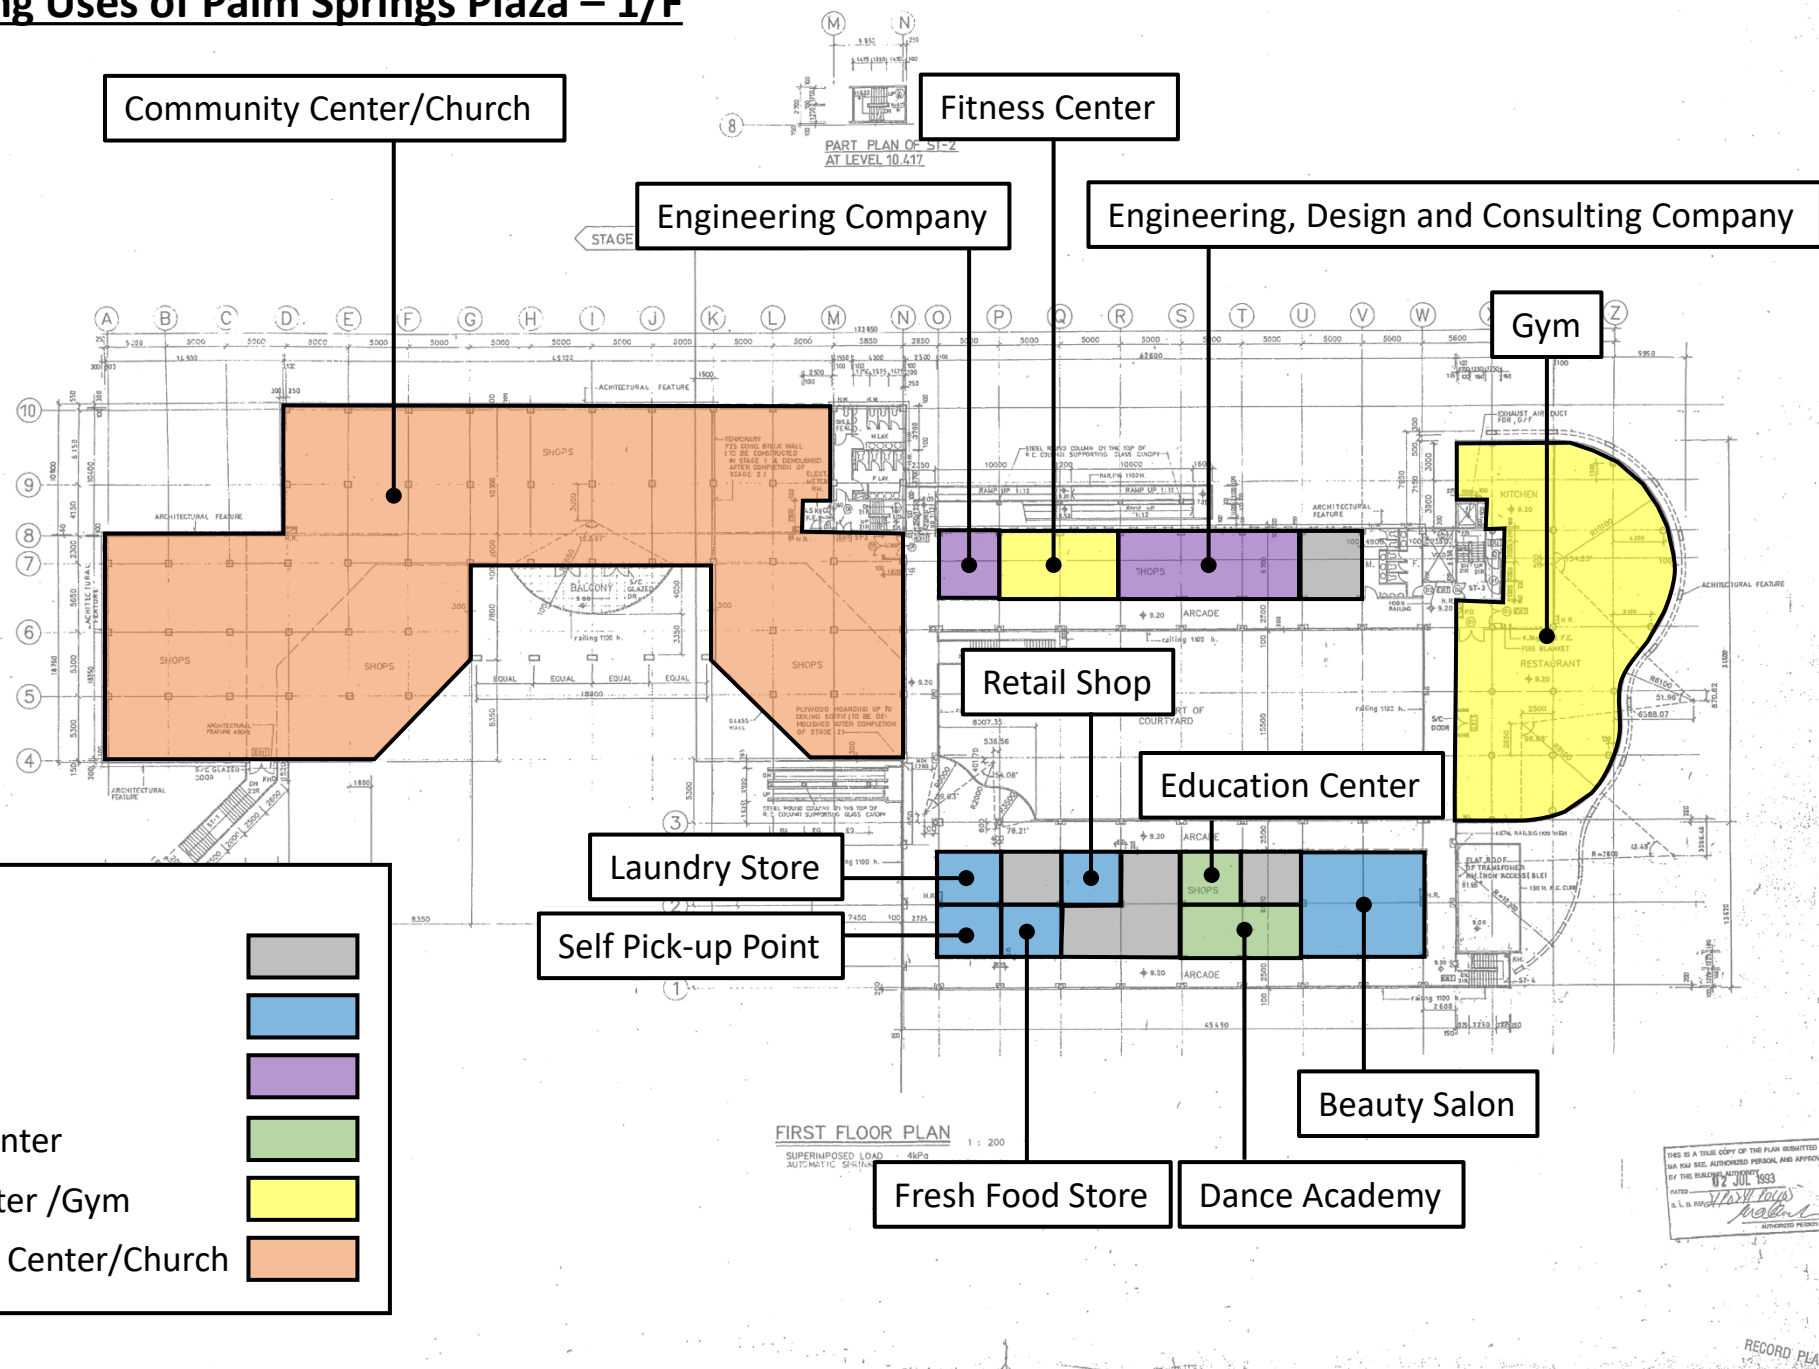

Legend

- Vacant
- Shop
- Office
- Learning Center
- Fitness Center /Gym
- Community Center/Church

B.L.D. REFERENCE
2 / 9024 / 90 (10)

B.L.D. REFERENCE
8 / 21357

W.W.D. REFERENCE

NO.	REVISIONS / NOTES	DATE	BY
A	GEN. REV.	2/93	
B	GEN. REV.	5/93	

ARCHITECT

MA KIM SEK
RUBA HSIA AUTHORIZED PERSON
MA LEUNG & ASSOCIATES
ARCHITECTS & ENGINEERS
PLANNING & LANDSCAPE CONSULTANTS

URBIS
CIVIL & STRUCTURAL CONSULTANTS

HO TIN & ASSOCIATES
ARCHITECTS
(INCORPORATED IN HONG KONG)

CONSOLIDATED
CONSULTING
ENGINEERS LTD.
CONSOLIDATED CONSULTING ENGINEERS LTD.

PROJECT

WO SHANG WAI
DEVELOPMENT
PHASE II

DO NOT SCALE DRAWINGS.
ALL DIMENSIONS SHOWN ON THIS DRAWING ARE TO BE TAKEN FROM THE DIMENSIONS OF THE ARCHITECT'S ORIGINAL DRAWINGS AND NOT FROM THIS COPY OF THE DRAWING.

THIS IS A TRUE COPY OF THE PLAN SUBMITTED BY THE ARCHITECT AND APPROVED BY THE BUILDING DEPARTMENT.

DATE: 1 JUL 1993
S. L. H. HONG
AUTHORIZED PERSON

FIRST FLOOR PLAN
(COMMERCIAL CENTRE)

SCALE: 1 : 200

DATE: 7/92

DRAWN BY: / CHECKED BY:

JOB NO. 8912

DRAWING NO. 205 (B)

RECORD PLAN