


Appendix I

As-built Drainage Plan

accepted under previous application No. A/YL-SK/294

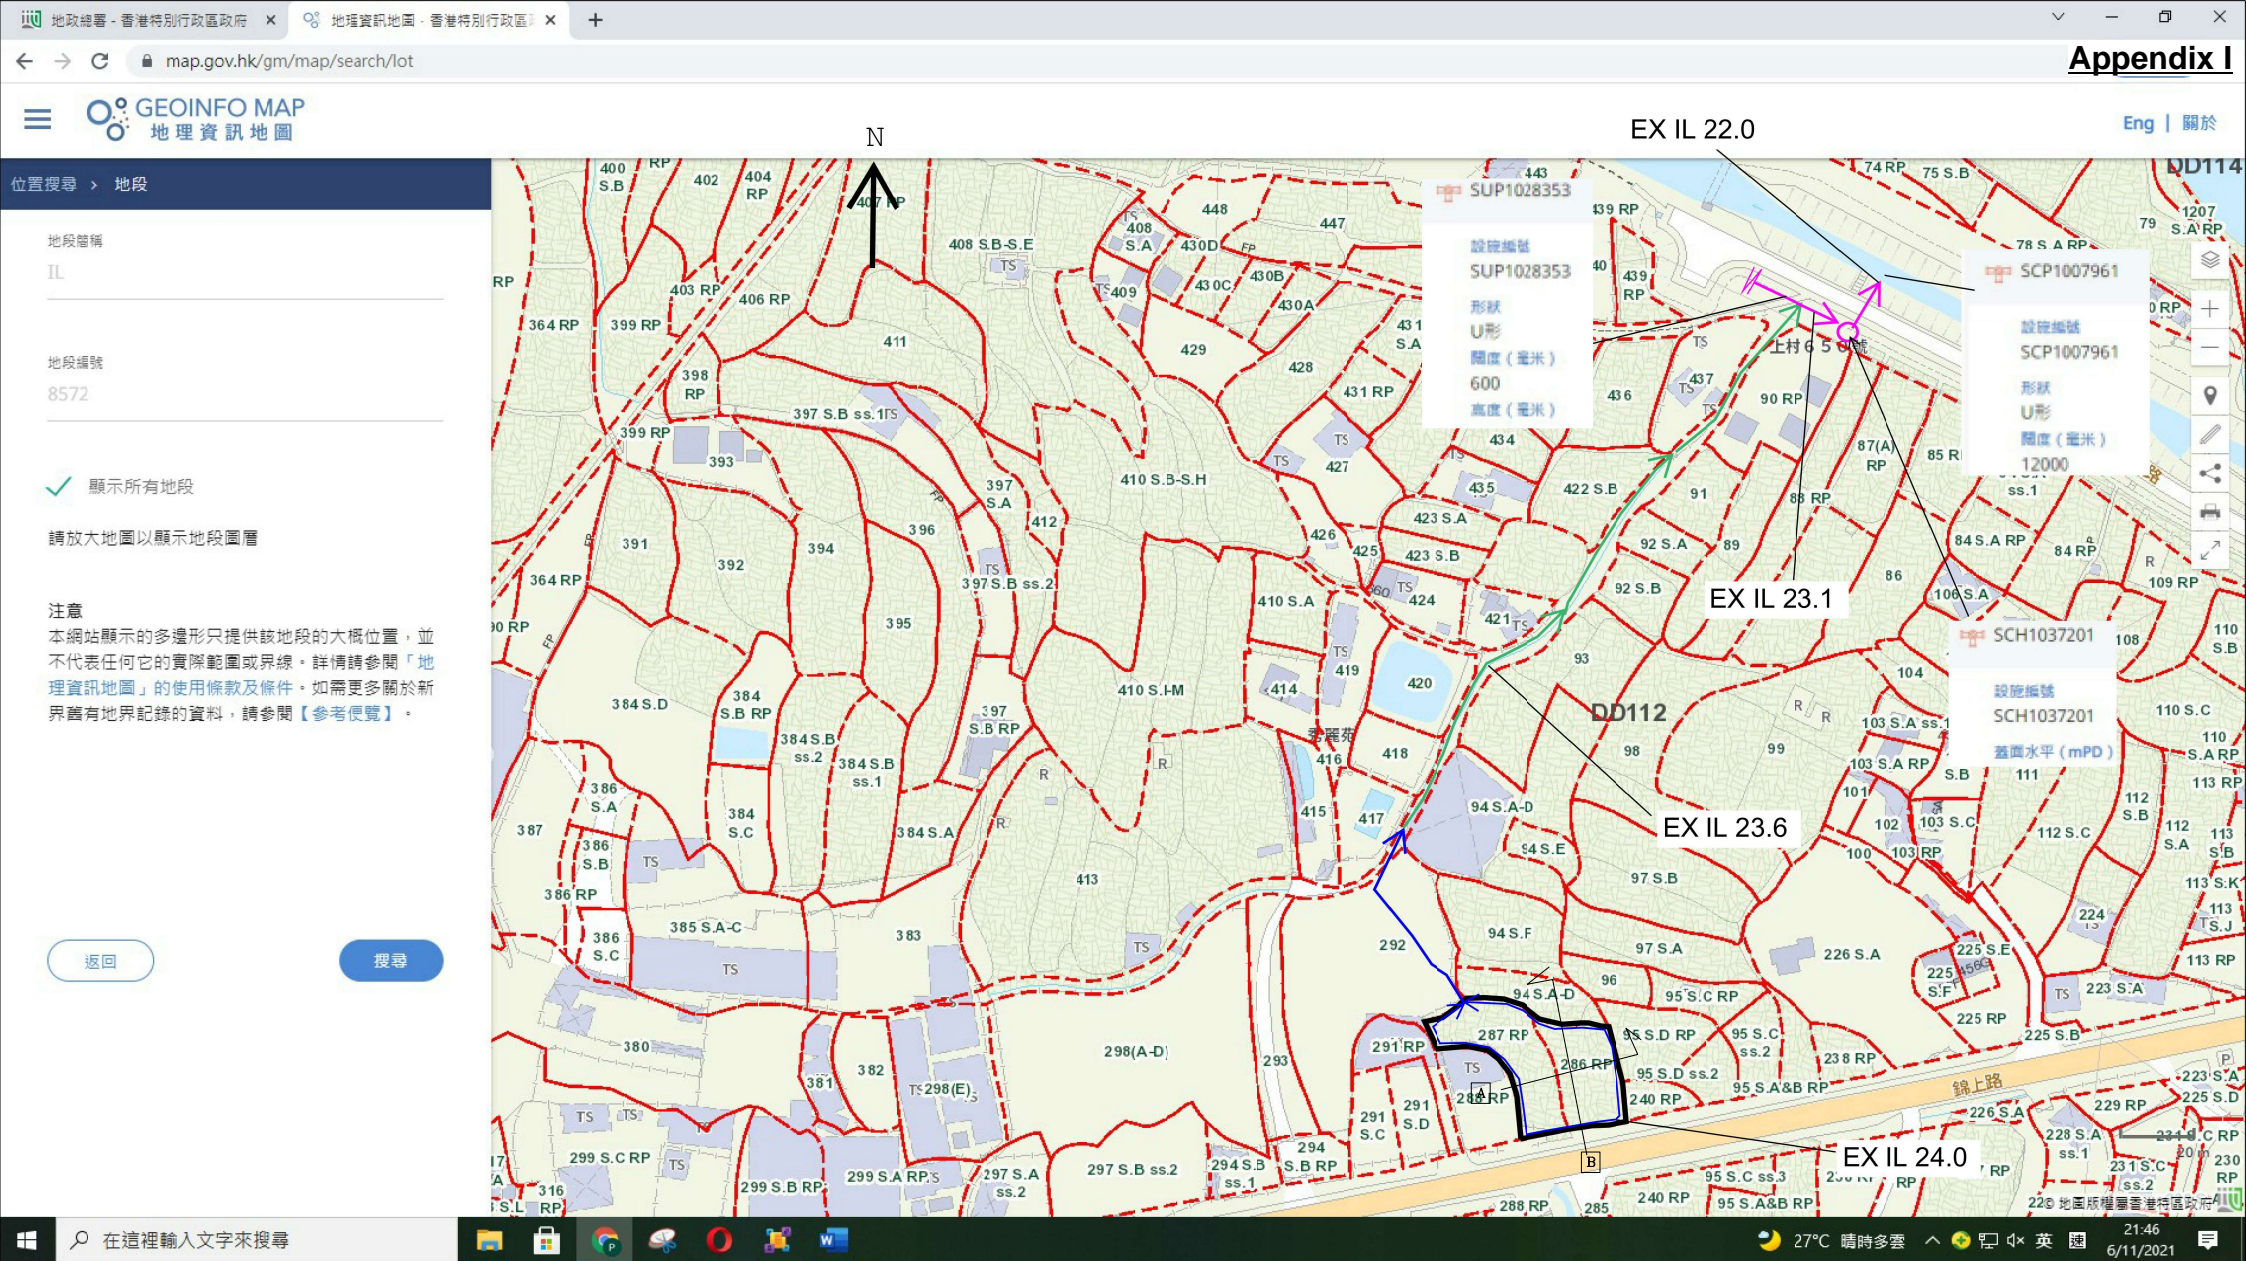

→ = EX 600UC (Concrete) & Fall

→ = EX 400UC (Concrete) & Fall

→ = EX 400UC (Soil) & Fall