

Urgent Return receipt Expand Group Restricted Prevent Copy

**Karry Ka Wong LAU/PLAND**

---

寄件者: Chong Hermose <[REDACTED]>  
寄件日期: 2026年05月06日星期三 10:52  
收件者: tpbpd/PLAND  
副本: Karry Ka Wong LAU/PLAND  
主旨: A/HSK/608 : 申請文件  
附件: A\_HSK\_608\_AsBuilt Drainage Plan.pdf; A\_HSK\_608\_Tree\_Preservation\_Plan.pdf  
類別: Internet Email

城規會/規劃處：


有關 規劃申請：A/HSK/608，現附上更改過的圖則。

另外，擬議用途的營業時間為星期一至星期六上午七時至下午十一時，星期日及公眾假期全日休業。

請查收。

謝謝。

Ms Chong  
( [REDACTED] )

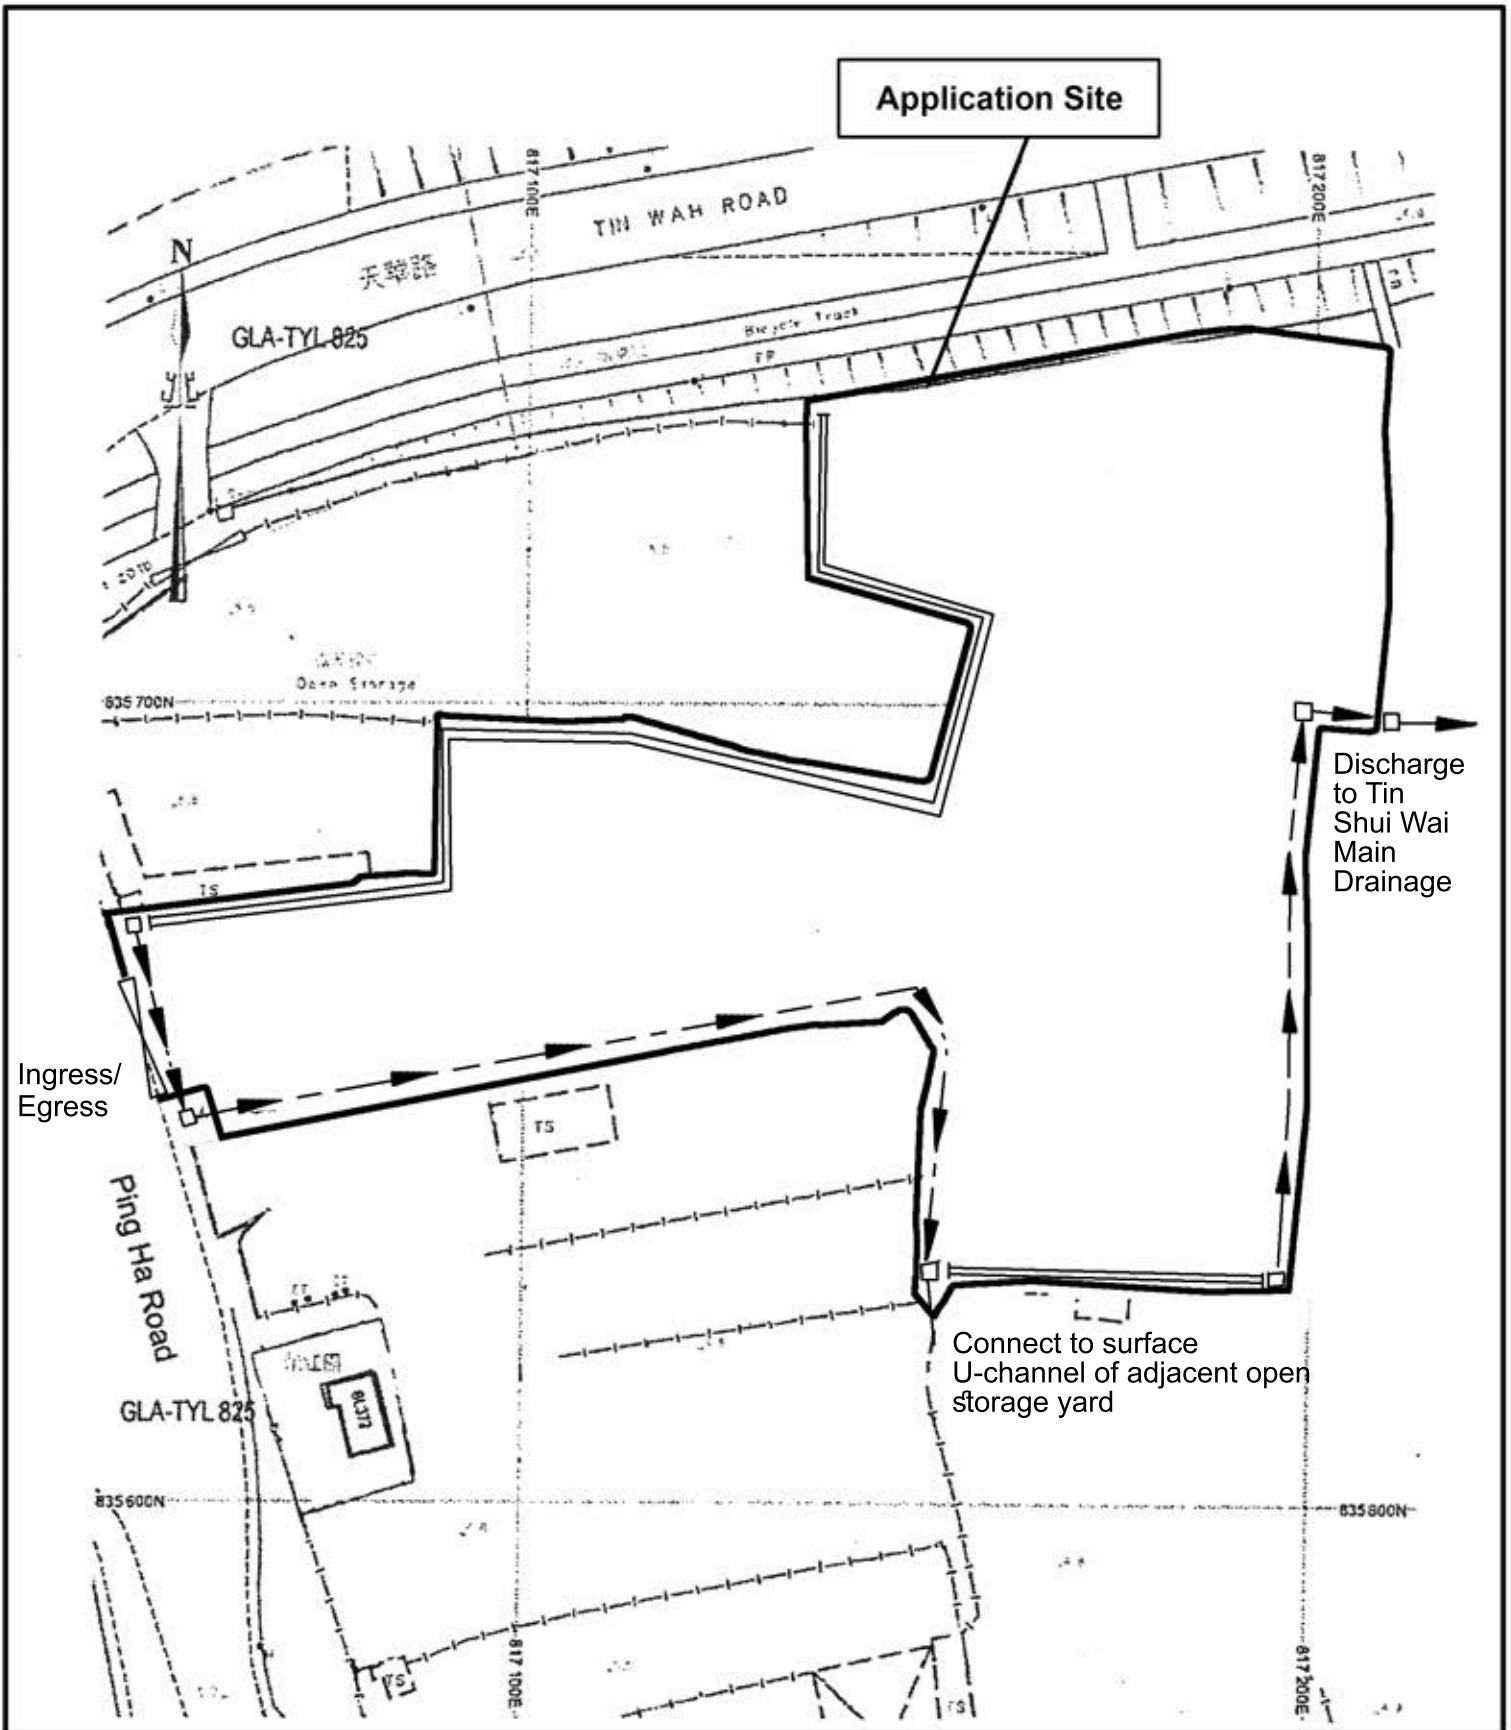

Project 項目名稱:

Proposed Temporary Logistics Centre and Ancillary Parking of Vehicle for a Period of 3 Years at Lots 3150 RP(Part), 3151 RP(Part), 3152 RP(Part), 3162 RP, 3163 RP(Part), 3164(Part), 3165, 3166, 3167 S.A(Part), 3168(Part), 3169(Part), 3177(Part), 3178(Part), 3179, 3180, 3181 S.A(Part), 3181 RP(Part), 3182, 3183(Part), 3184(Part), 3187 RP(Part) and 3188 RP(Part) in D.D. 129, & Adjoining Government Land, Ha Tsuen, Yuen Long, N.T.

Drawing Title 圖紙標題:

As-built Drainage Plan  
(Accepted for previous  
planning permission  
No. A/HSK/443 )

Drawing No. 圖號:


Remarks 備註:

- Existing 375mm surface U-channel
- Existing 12" high concrete kerb to prevent the flow of surface runoff from the site to adjacent area
- Catchpit

Scale 比例:



Tree	Approximate Height	Spacing	Quantity
Existing <i>Ficus microcarpa</i> (Chinese Banyan)	About 3m to 5m	About 3m	103
Existing <i>Melaleuca leucadendra</i>	About 3m to 4.5m	About 3m	14
Newly planted <i>Bauhinia blakeana</i>	About 2.75m	About 3m	29

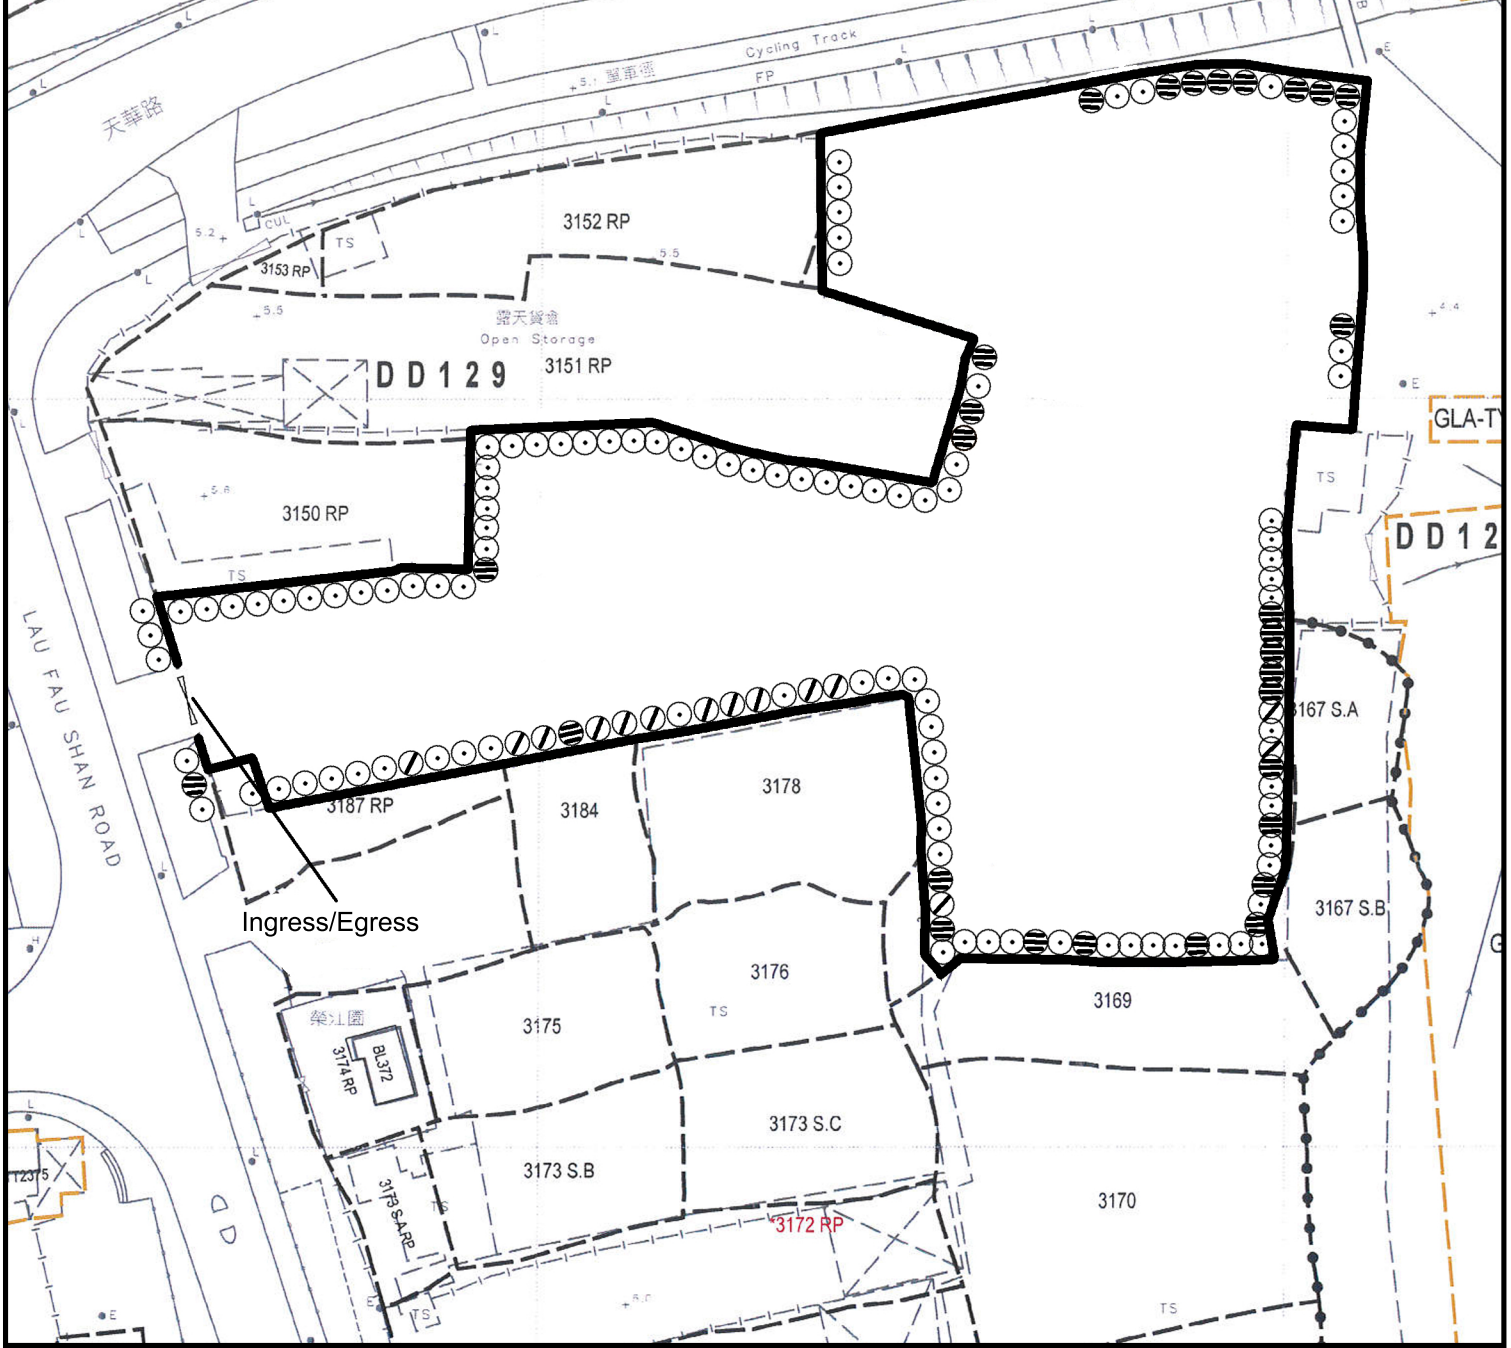

Project 項目名稱:

Application No. A/HSK/443  
 Temporary Logistics Centre and Ancillary  
 Parking of Vehicles For a Period of 3 Years

Drawing Title 圖紙標題:

Existing  
 Landscape &  
 Tree  
 Preservation  
 Plan



Remarks 備註:

Drawing No. 圖號:

Scale 比例: