



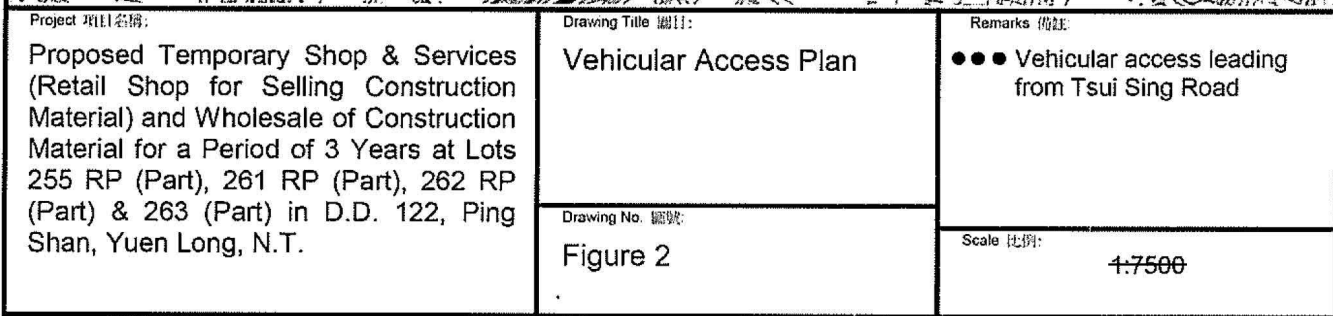

參考編號
REFERENCE No.
A/YL-PS/665

繪圖 DRAWING
A-1

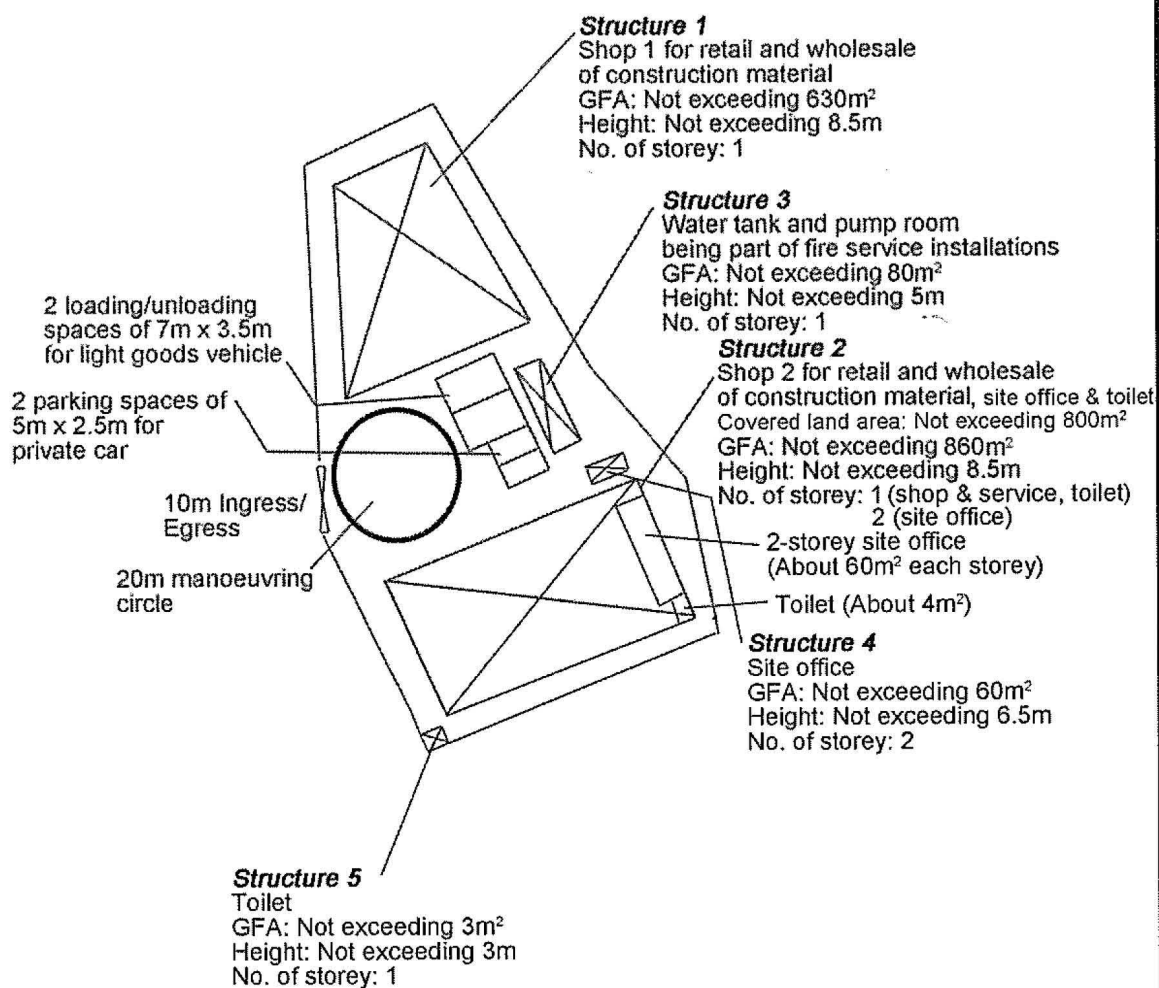


Project 項目名稱: Proposed Temporary Shop & Services (Retail Shop for Selling Construction Material) and Wholesale of Construction Material for a Period of 3 Years at Lots 255 RP (Part), 261 RP (Part), 262 RP (Part) & 263 (Part) in D.D. 122, Ping Shan, Yuen Long, N.T.	Drawing Title 圖目: Proposed Layout Plan Drawing No. 圖號: Figure 3	Remarks 備註: Scale 比例: 1:1000
--	---	---

(摘錄自申請人於 28. 7. 2022 呈交的申請書)
(Extract from Applicant's Submission of 28.7.2022)

參考編號
REFERENCE No.
A/YL-PS/665

繪圖 DRAWING
A-2

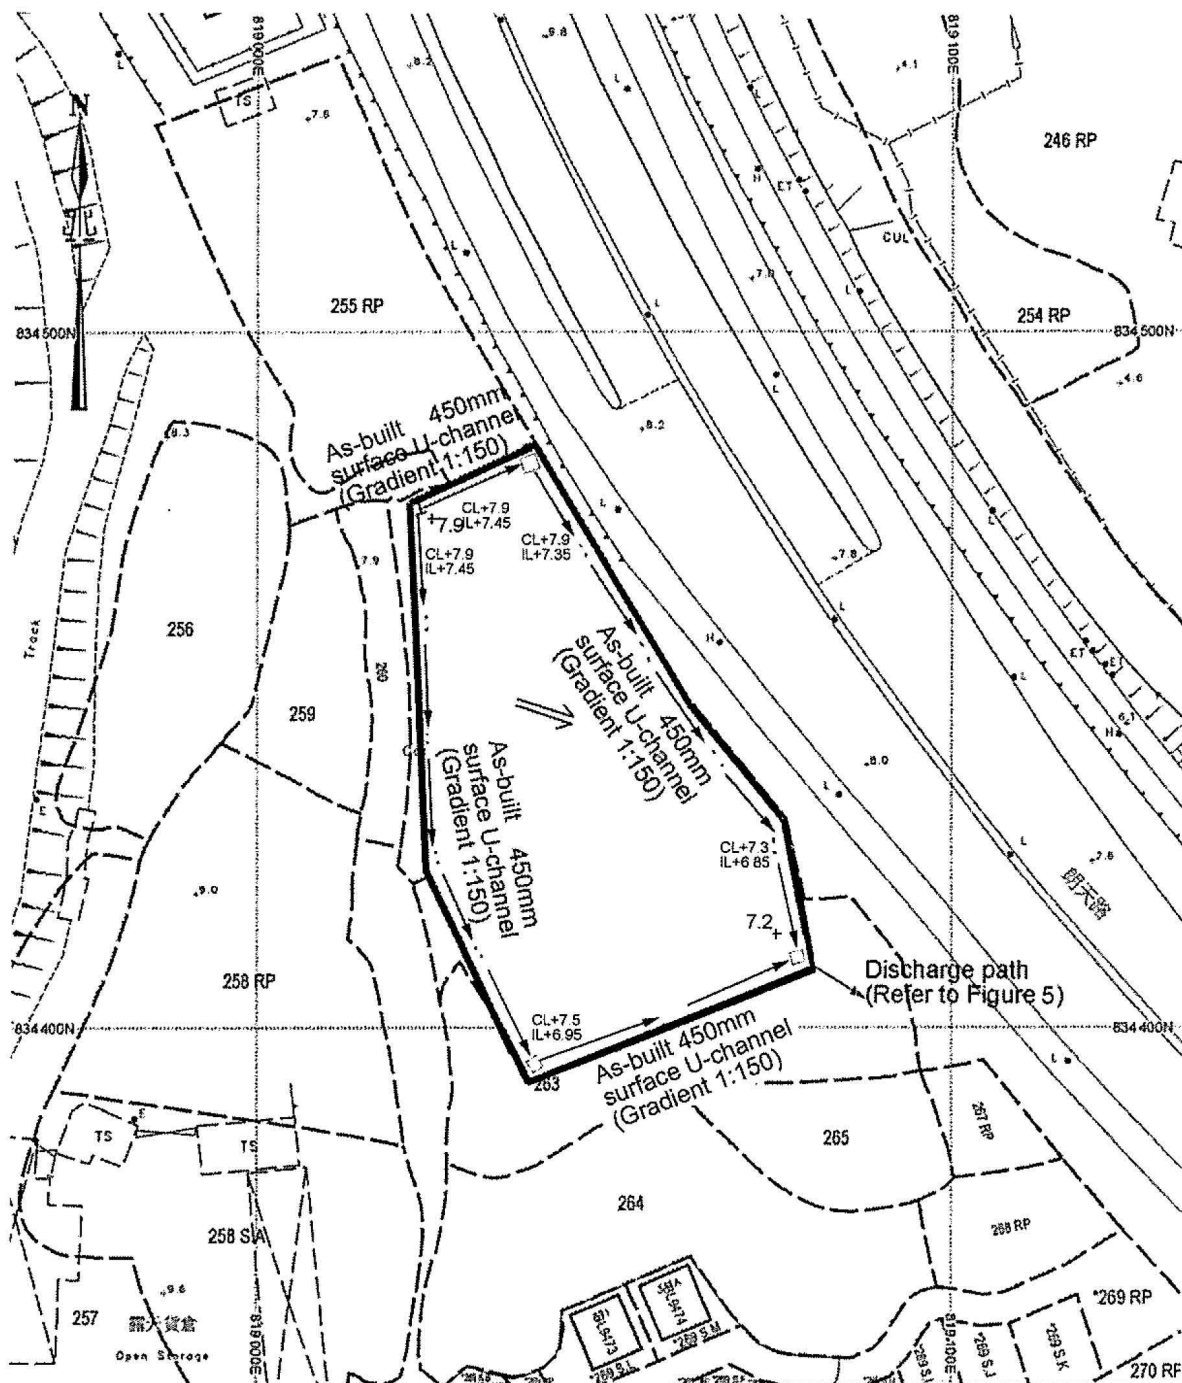

Project 項目名稱:

Proposed Temporary Shop & Services (Retail Shop for Selling Construction Material) and Wholesale of Construction Material for a Period of 3 Years at Lots 255 RP (Part), 261 RP (Part), 262 RP (Part) & 263 (Part) in D.D. 122, Ping Shan, Yuen Long, N.T.

Drawing Title 圖目:

As-built Drainage Plan

Drawing No. 圖號:

Figure 4

Remarks 備註:

- +7.9 Level (in mPD)
- ← Flow of surface runoff
- As-built catchpit
- As-built catchpit with sand trap


Scale 比例:

4:1000

(摘錄自申請人於 28.7.2022 呈交的申請書)
(Extract from Applicant's
Submission of 28.7.2022)

參考編號
REFERENCE No.
A/YL-PS/665

繪圖 DRAWING
A-3

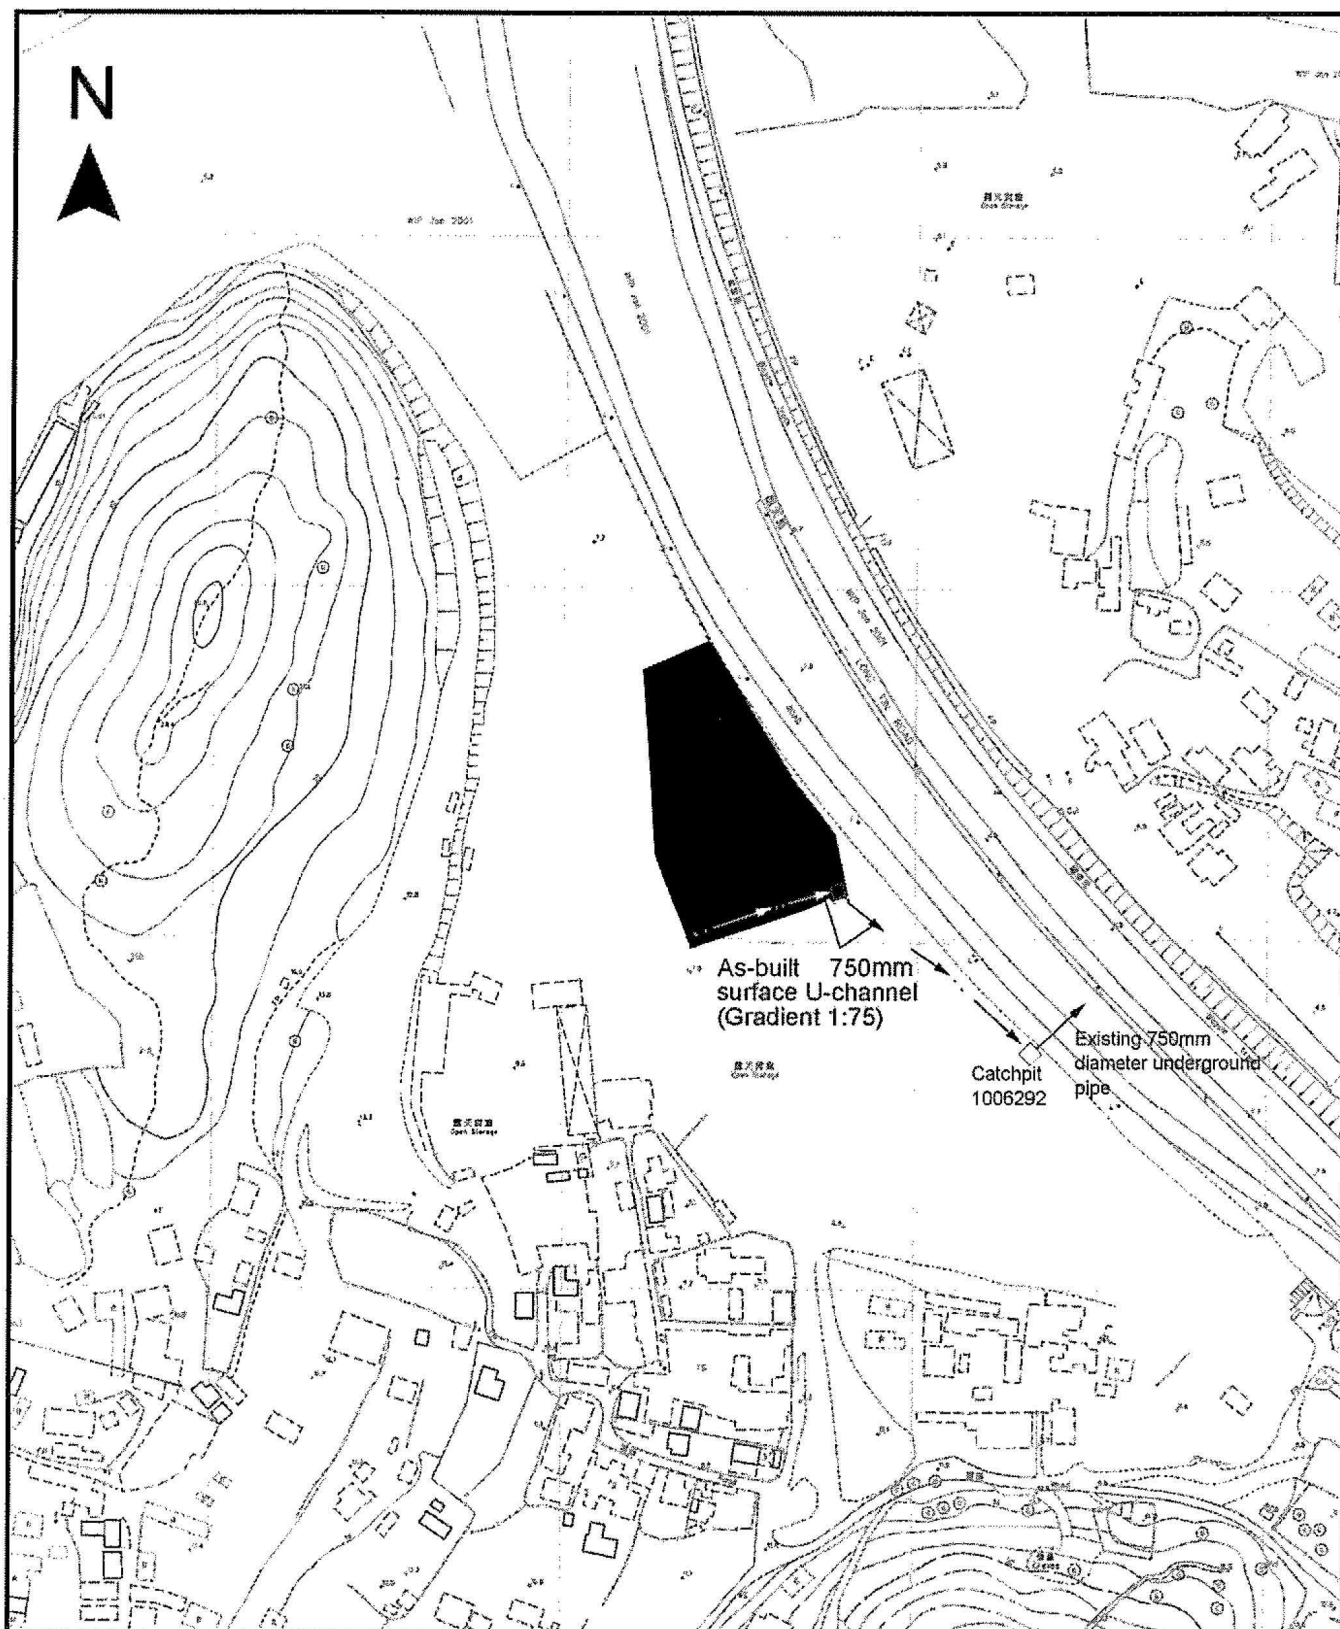

Project 項目名稱:

Proposed Temporary Shop & Services (Retail Shop for Selling Construction Material) and Wholesale of Construction Material for a Period of 3 Years at Lots 255 RP (Part), 261 RP (Part), 262 RP (Part) & 263 (Part) in D.D. 122, Ping Shan, Yuen Long, N.T.

Drawing Title 圖目:

Catchment Plan of the Southern Periphery Surface U-channel

Drawing No. 圖號:

Figure 5

Remarks 備註:

Application site


Scale 比例:

1:2000

(摘錄自申請人於 28. 7. 2022 呈交的申請書)
(Extract from Applicant's
Submission of 28.7.2022)

參考編號
REFERENCE No.
A/YL-PS/665

繪圖 DRAWING
A-4

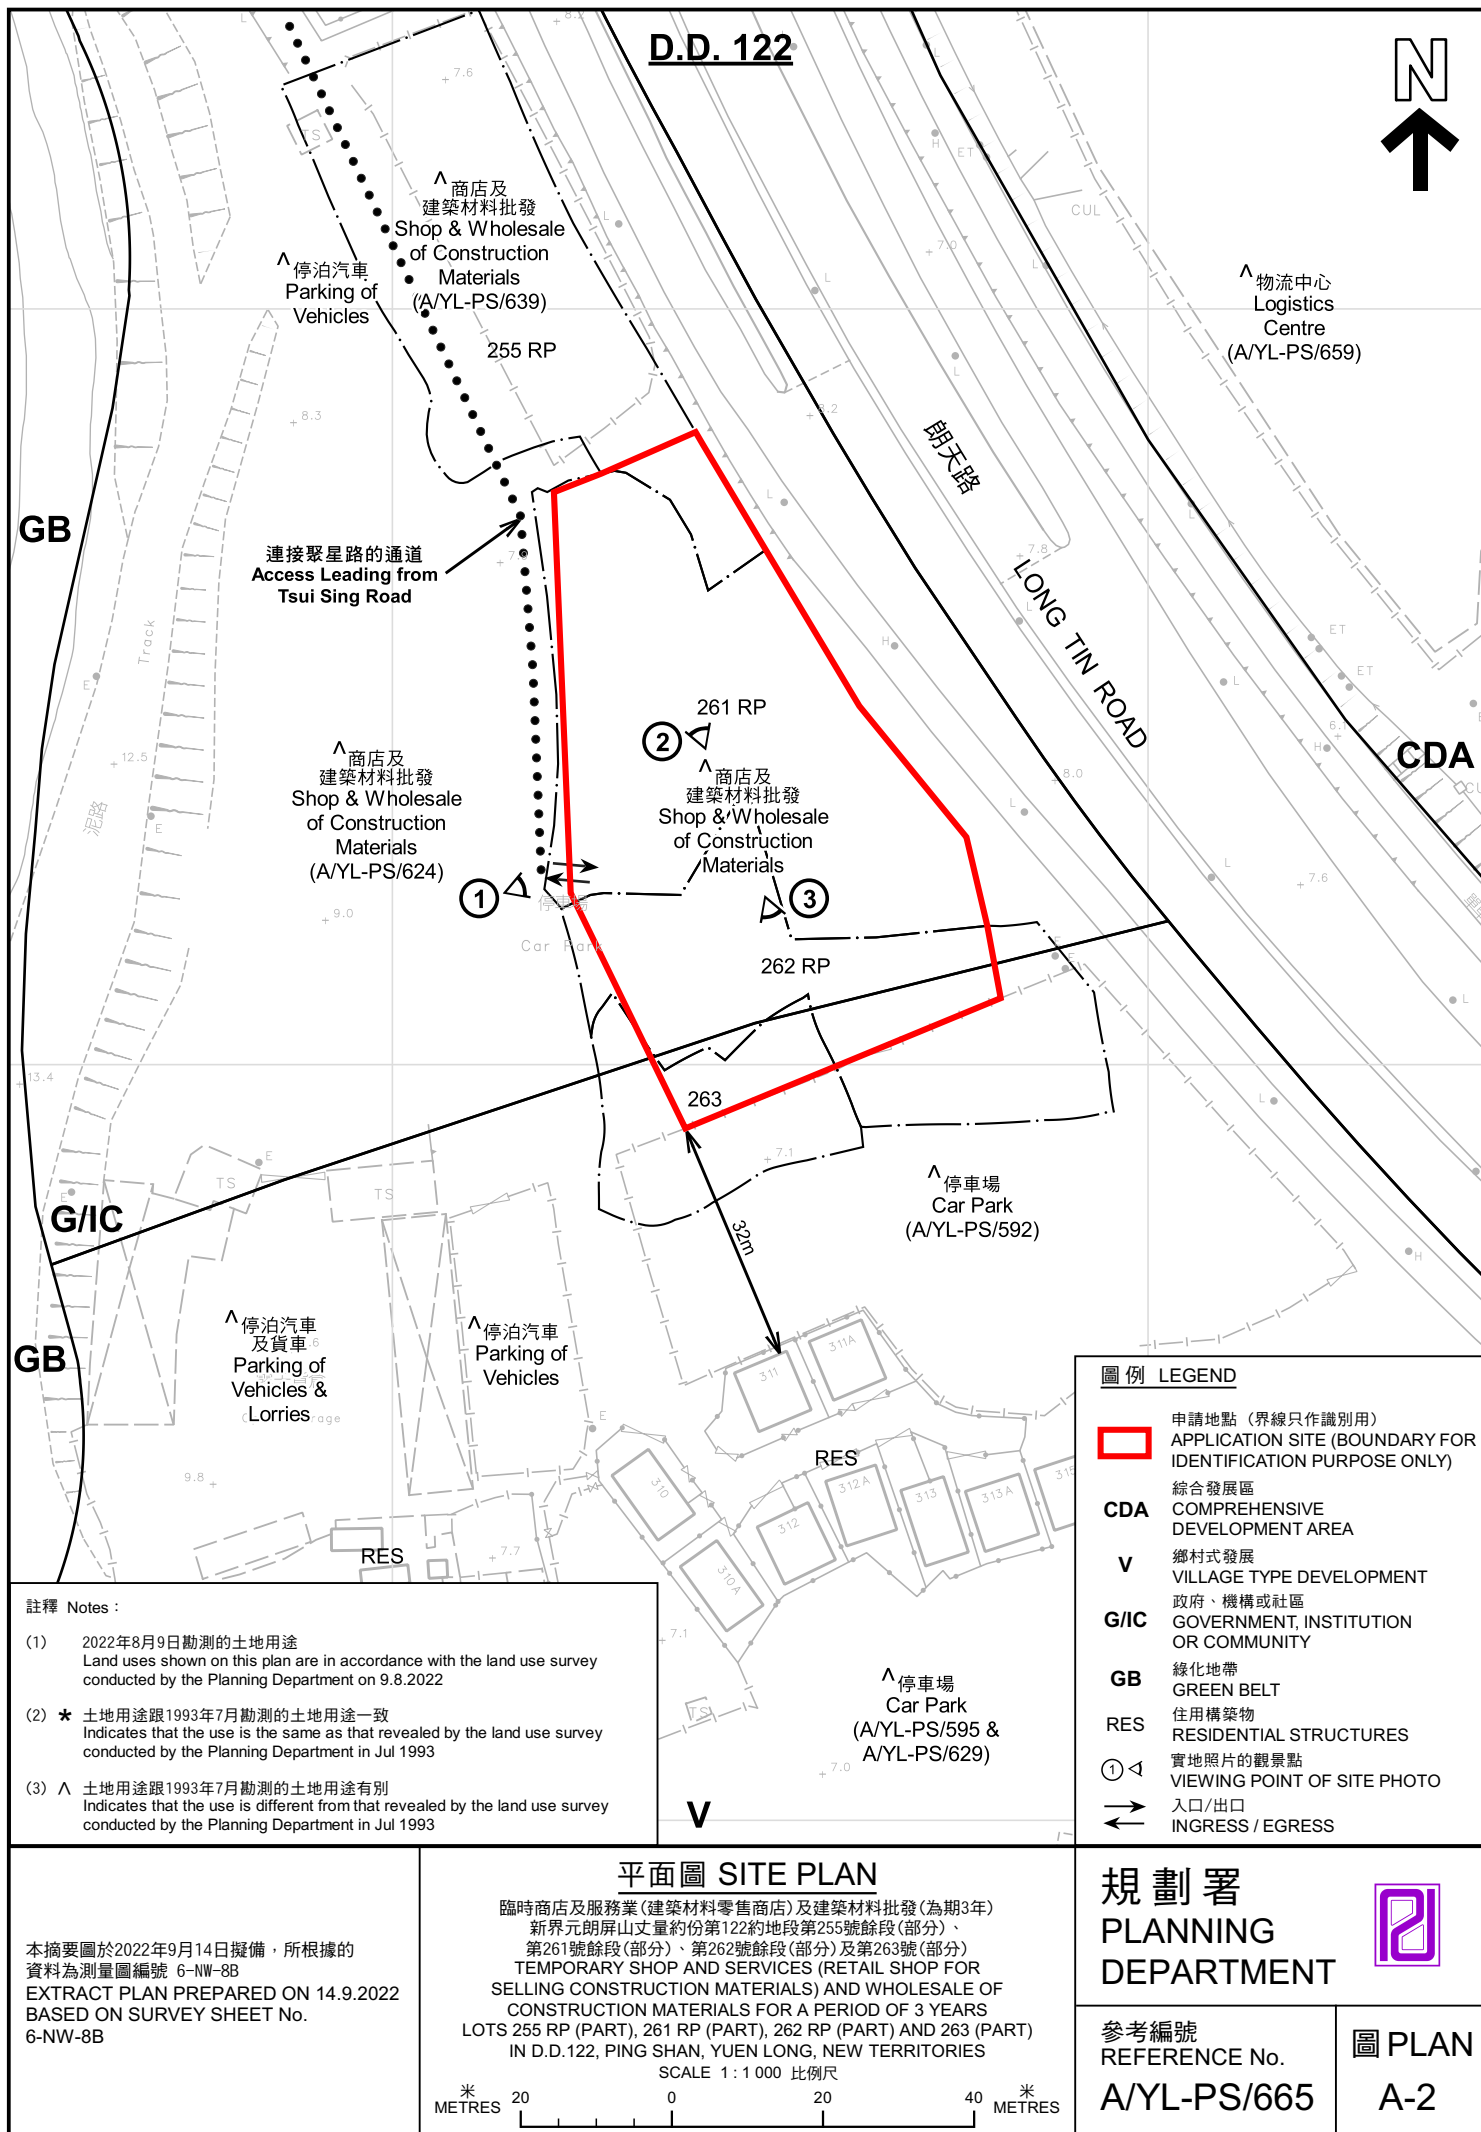



圖例 LEGEND



申請地點(界線只作識別用)
APPLICATION SITE
(BOUNDARY FOR IDENTIFICATION
PURPOSE ONLY)

本摘要圖於2022年8月23日擬備，所根據的資料為地政總署於2021年12月29日拍得的航攝照片編號 E144699C 及 E144700C
EXTRACT PLAN PREPARED ON 23.8.2022
BASED ON AERIAL PHOTOS No. E144699C & E144700C TAKEN ON 29.12.2021 BY LANDS DEPARTMENT

航攝照片 AERIAL PHOTO

臨時商店及服務業(建築材料零售商店)及建築材料批發(為期3年)
新界元朗屏山丈量約份第122約地段第255號餘段(部分)、
第261號餘段(部分)、第262號餘段(部分)及第263號(部分)
TEMPORARY SHOP AND SERVICES (RETAIL SHOP FOR
SELLING CONSTRUCTION MATERIALS) AND WHOLESALE OF
CONSTRUCTION MATERIALS FOR A PERIOD OF 3 YEARS
LOTS 255 RP (PART), 261 RP (PART), 262 RP (PART) AND 263 (PART)
IN D.D.122, PING SHAN, YUEN LONG, NEW TERRITORIES

規劃署
PLANNING
DEPARTMENT



參考編號
REFERENCE No.
A/YL-PS/665

圖 PLAN
A-3

申請地點
APPLICATION SITE



實地照片 SITE PHOTOS

臨時商店及服務業(建築材料零售商店)及建築材料批發(為期3年)
新界元朗屏山丈量約份第122約地段第255號餘段(部分)、
第261號餘段(部分)、第262號餘段(部分)及第263號(部分)
TEMPORARY SHOP AND SERVICES (RETAIL SHOP FOR
SELLING CONSTRUCTION MATERIALS) AND WHOLESALE OF
CONSTRUCTION MATERIALS FOR A PERIOD OF 3 YEARS
LOTS 255 RP (PART), 261 RP (PART), 262 RP (PART) AND 263 (PART)
IN D.D.122, PING SHAN, YUEN LONG, NEW TERRITORIES

規劃署
PLANNING
DEPARTMENT



參考編號
REFERENCE No.
A/YL-PS/665

圖 PLAN
A-4

本圖於2022年9月14日擬備，所根據的
資料為攝於2022年8月9日的實地照片
PLAN PREPARED ON 14.9.2022
BASED ON SITE PHOTOS
TAKEN ON 9.8.2022