


Application Site

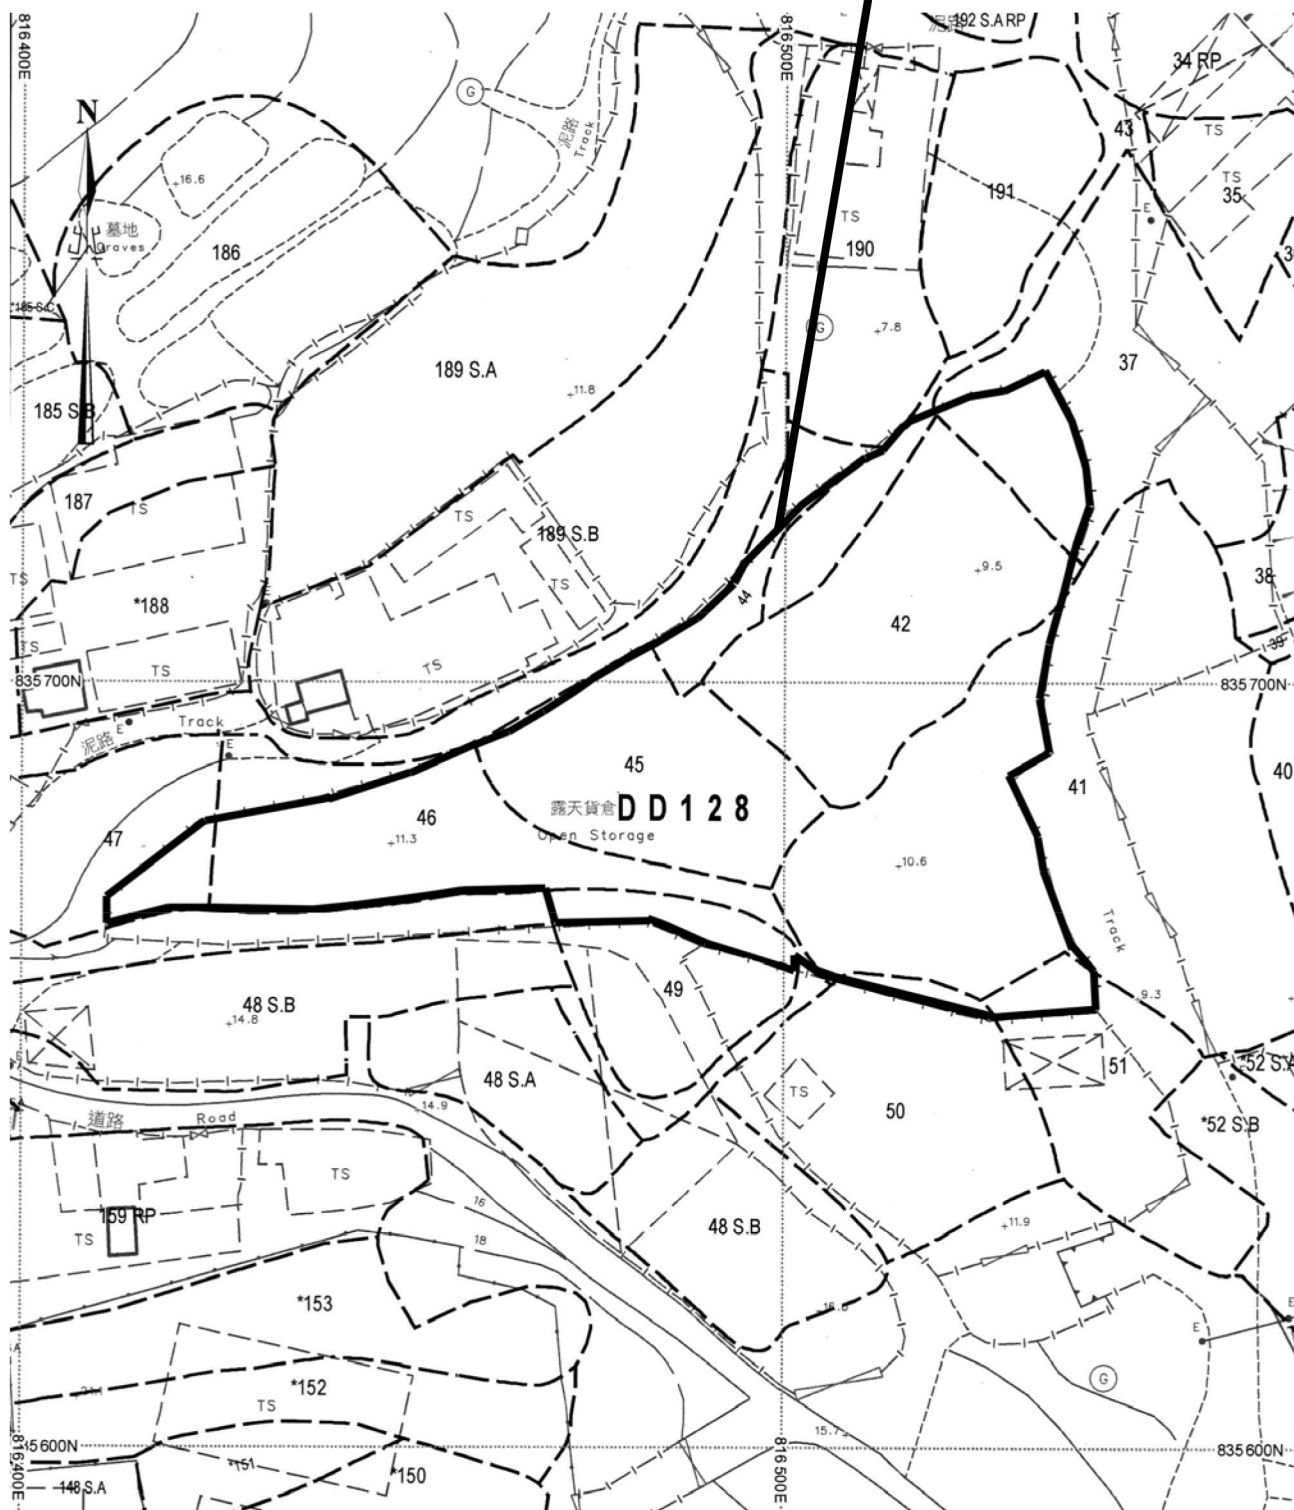

Project 項目名稱:

Proposed Temporary Open Storage of Rubbish Trucks, Rubbish Skips and Metal Ware with Ancillary Workshop for a Period of 3 Years at Lots 37 (Part), 41 (Part), 42 (Part), 43 (Part), 44 (Part), 45 (Part), 46 (Part), 47 (Part), 49 (Part), 50 (Part) & 51 (Part) in D.D. 128, Ha Tsuen, Yuen Long, N.T.

Drawing Title :

Site Plan


Drawing No. 圖號:

Figure 1

Remarks 備註:

Scale 比例:

1:1000

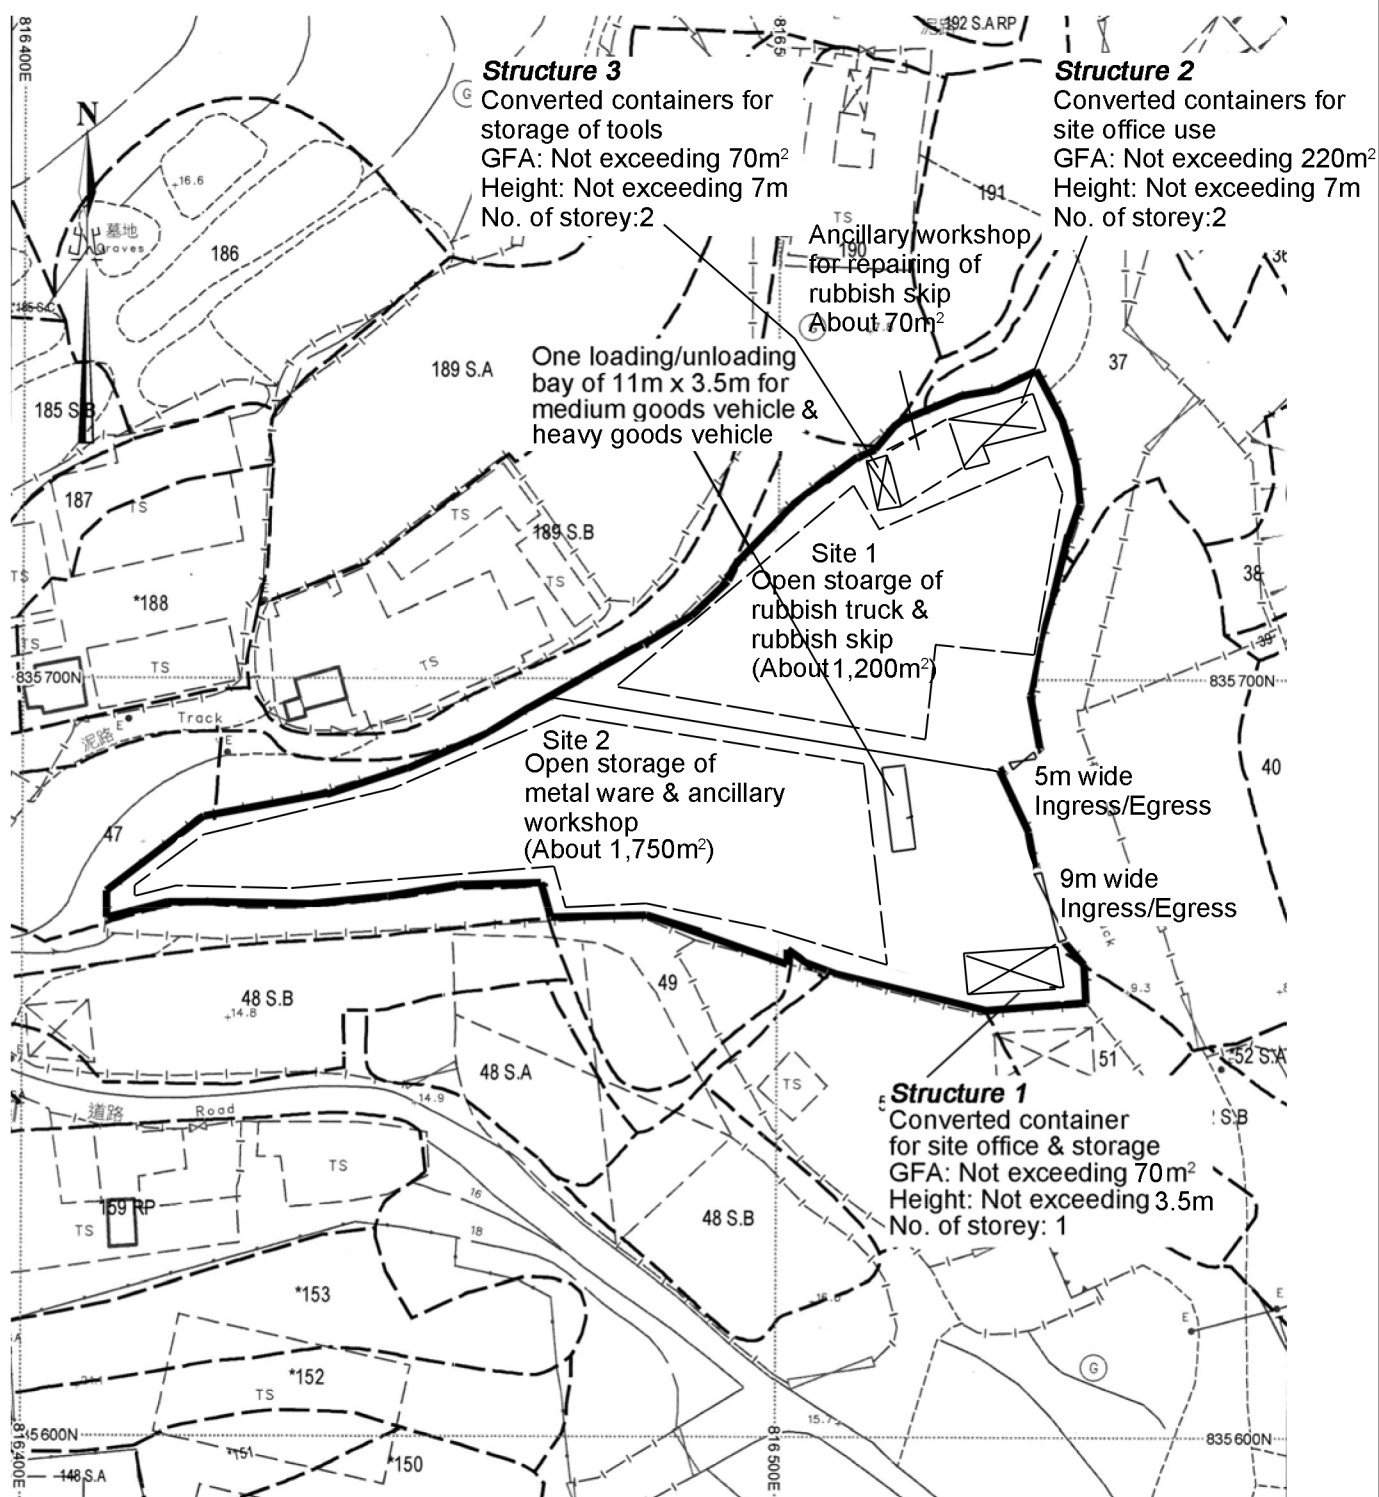

Project 項目名稱:

Proposed Temporary Open Storage of Rubbish Trucks, Rubbish Skips and Metal Ware with Ancillary Workshop for a Period of 3 Years at Lots 37 (Part), 41 (Part), 42 (Part), 43 (Part), 44 (Part), 45 (Part), 46 (Part), 47 (Part), 49 (Part), 50 (Part) & 51 (Part) in D.D. 128, Ha Tsuen, Yuen Long, N.T.

Drawing Title 圖目:

Proposed Layout Plan


Drawing No. 圖號:

Figure 3

Remarks 備註:

Scale 比例:

1:1000

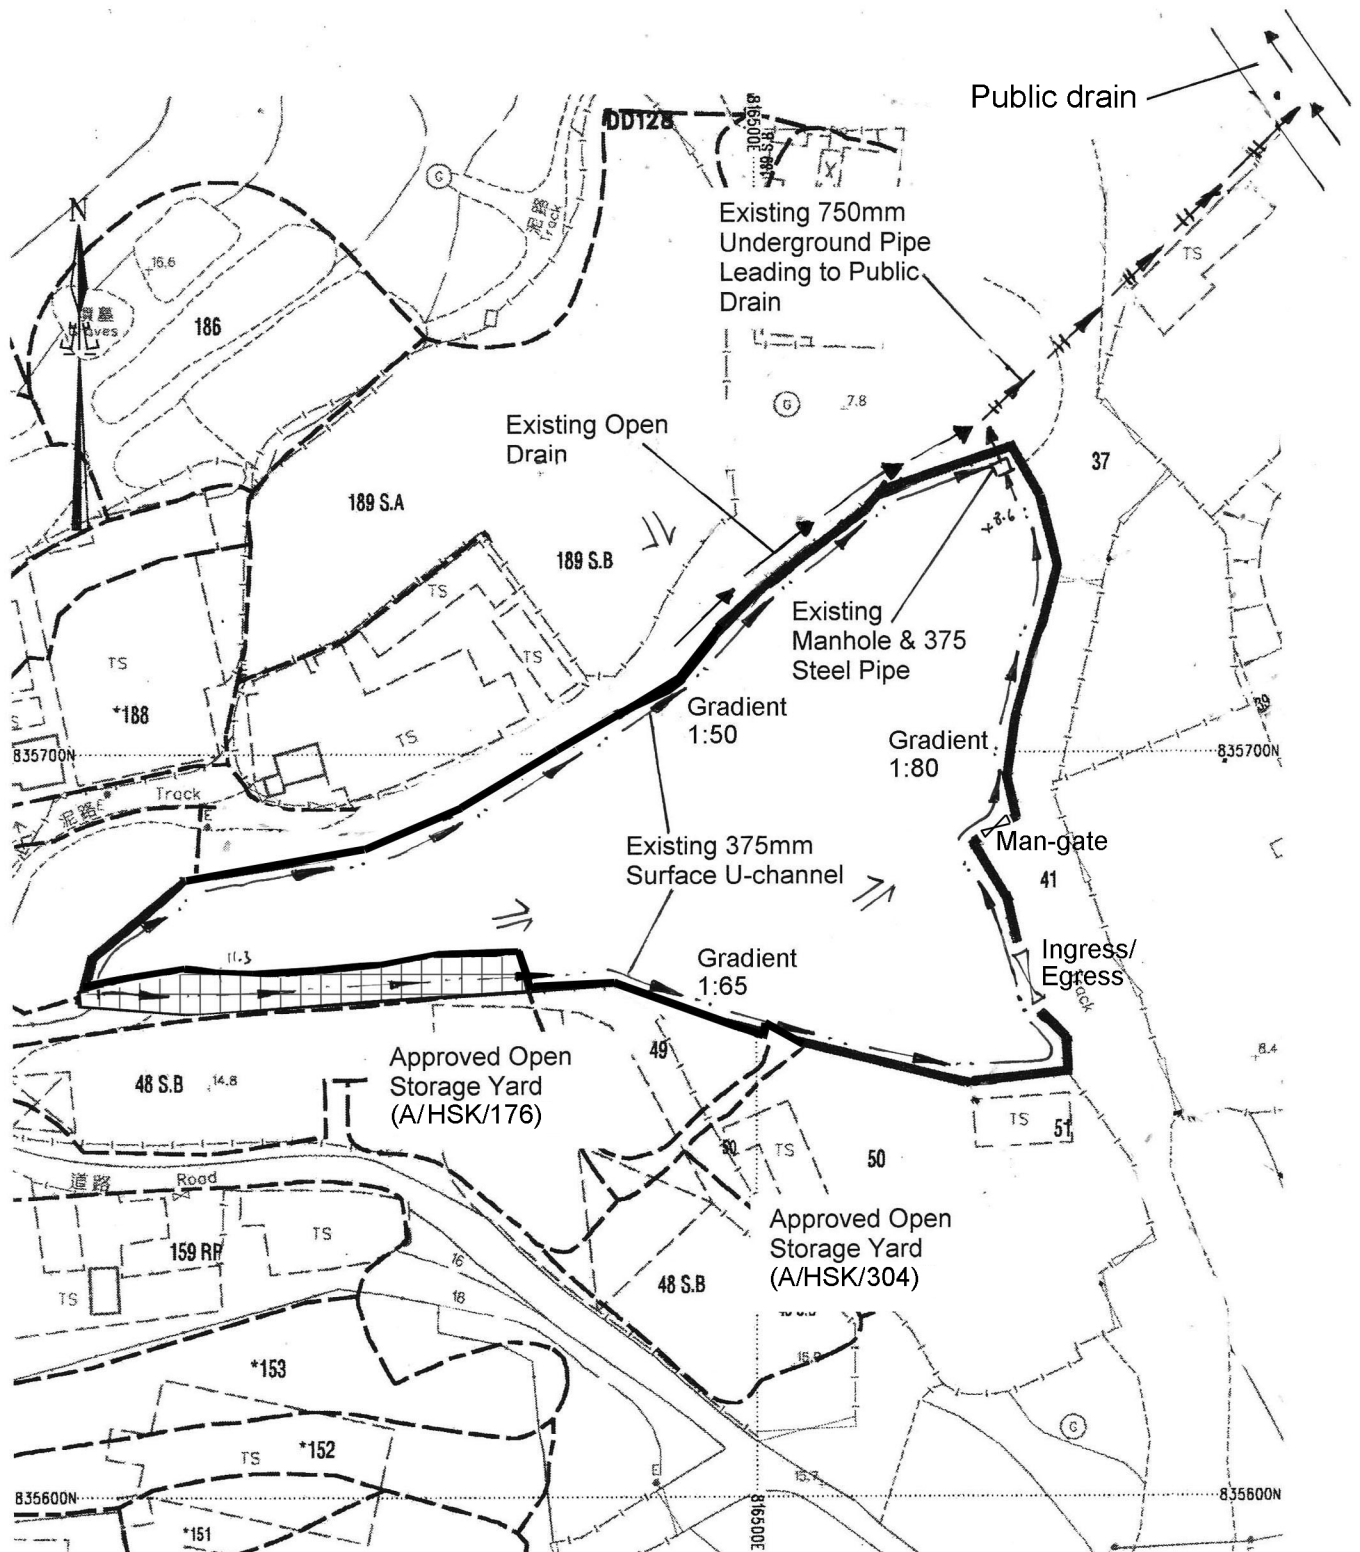

Project 項目名稱:

Proposed Temporary Open Storage of Rubbish Trucks, Rubbish Skips and Metal Ware with Ancillary Workshop for a Period of 3 Years at Lots 37 (Part), 41 (Part), 42 (Part), 43 (Part), 44 (Part), 45 (Part), 46 (Part), 47 (Part), 49 (Part), 50 (Part) & 51 (Part) in D.D. 128, Ha Tsuen, Yuen Long, N.T.

Drawing Title 圖目:

As-built Drainage Plan

Drawing No. 圖號:

Figure 4

Remarks 備註:



Flow of Surface Runoff



Level (in mPD)



Adjoining government land

Scale 比例:

1:1000