





Project 項目名稱:

Proposed Temporary Warehouse for Storage of Construction Machinery, Construction Material, Food and Electronic Goods for a Period of 3 Years at Lots 1835 (Part), 1840 (Part), 1841 S.B (Part), 1889 (Part), 1890 (Part), 1891 RP (Part), 1893 RP, 1894 (Part), 1895 RP (Part) & 1911 in D.D. 125 and Adjoining Government Land, Ha Tsuen, Yuen Long, N.T.

Drawing Title 圖目:

Location Plan

Drawing No. 圖號:


Figure 2

Remarks 備註:

●●● Vehicular access leading to Ping Ha Road

Scale 比例:

1:7500

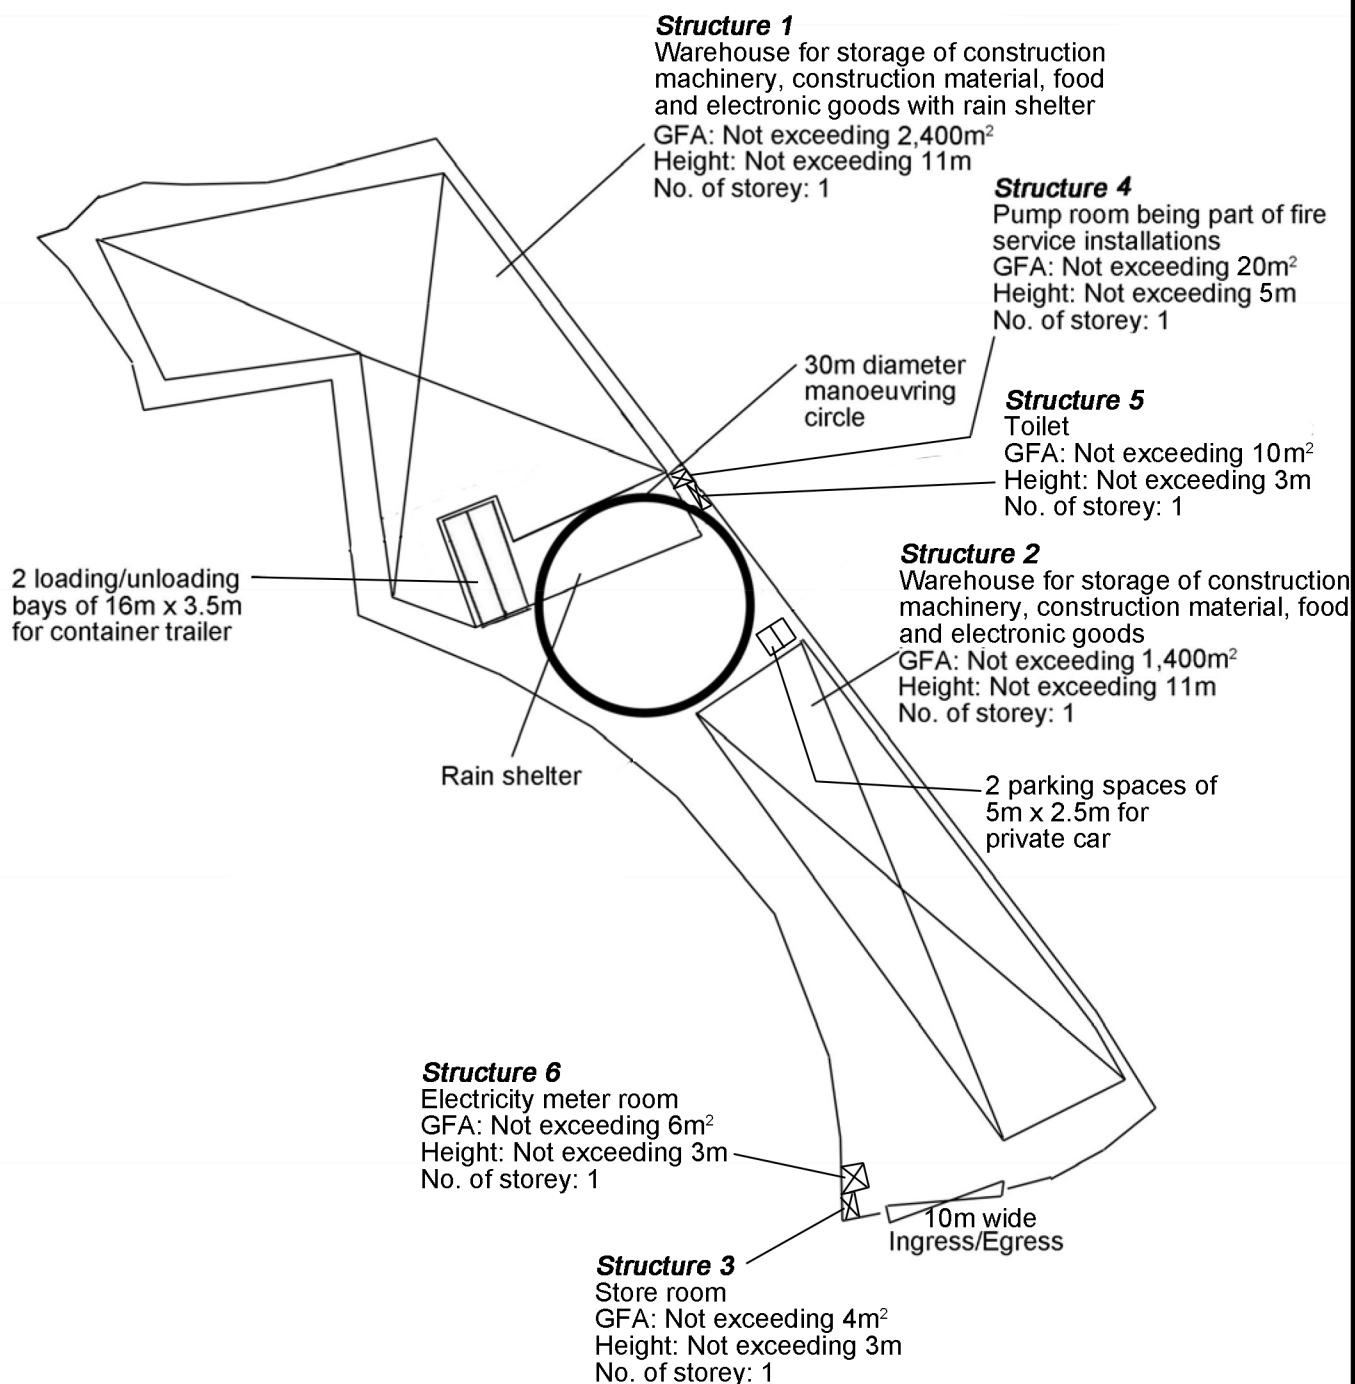

Project 項目名稱:

Proposed Temporary Warehouse for Storage of Construction Machinery, Construction Material, Food and Electronic Goods for a Period of 3 Years at Lots 1835 (Part), 1840 (Part), 1841 S.B (Part), 1889 (Part), 1890 (Part), 1891 RP (Part), 1893 RP, 1894 (Part), 1895 RP (Part) & 1911 in D.D. 125 and Adjoining Government Land, Ha Tsuen, Yuen Long, N.T.

Drawing Title 圖目:

Proposed Layout Plan


Drawing No. 圖號:

Figure 3

Remarks 備註:

Scale 比例:

1:1000

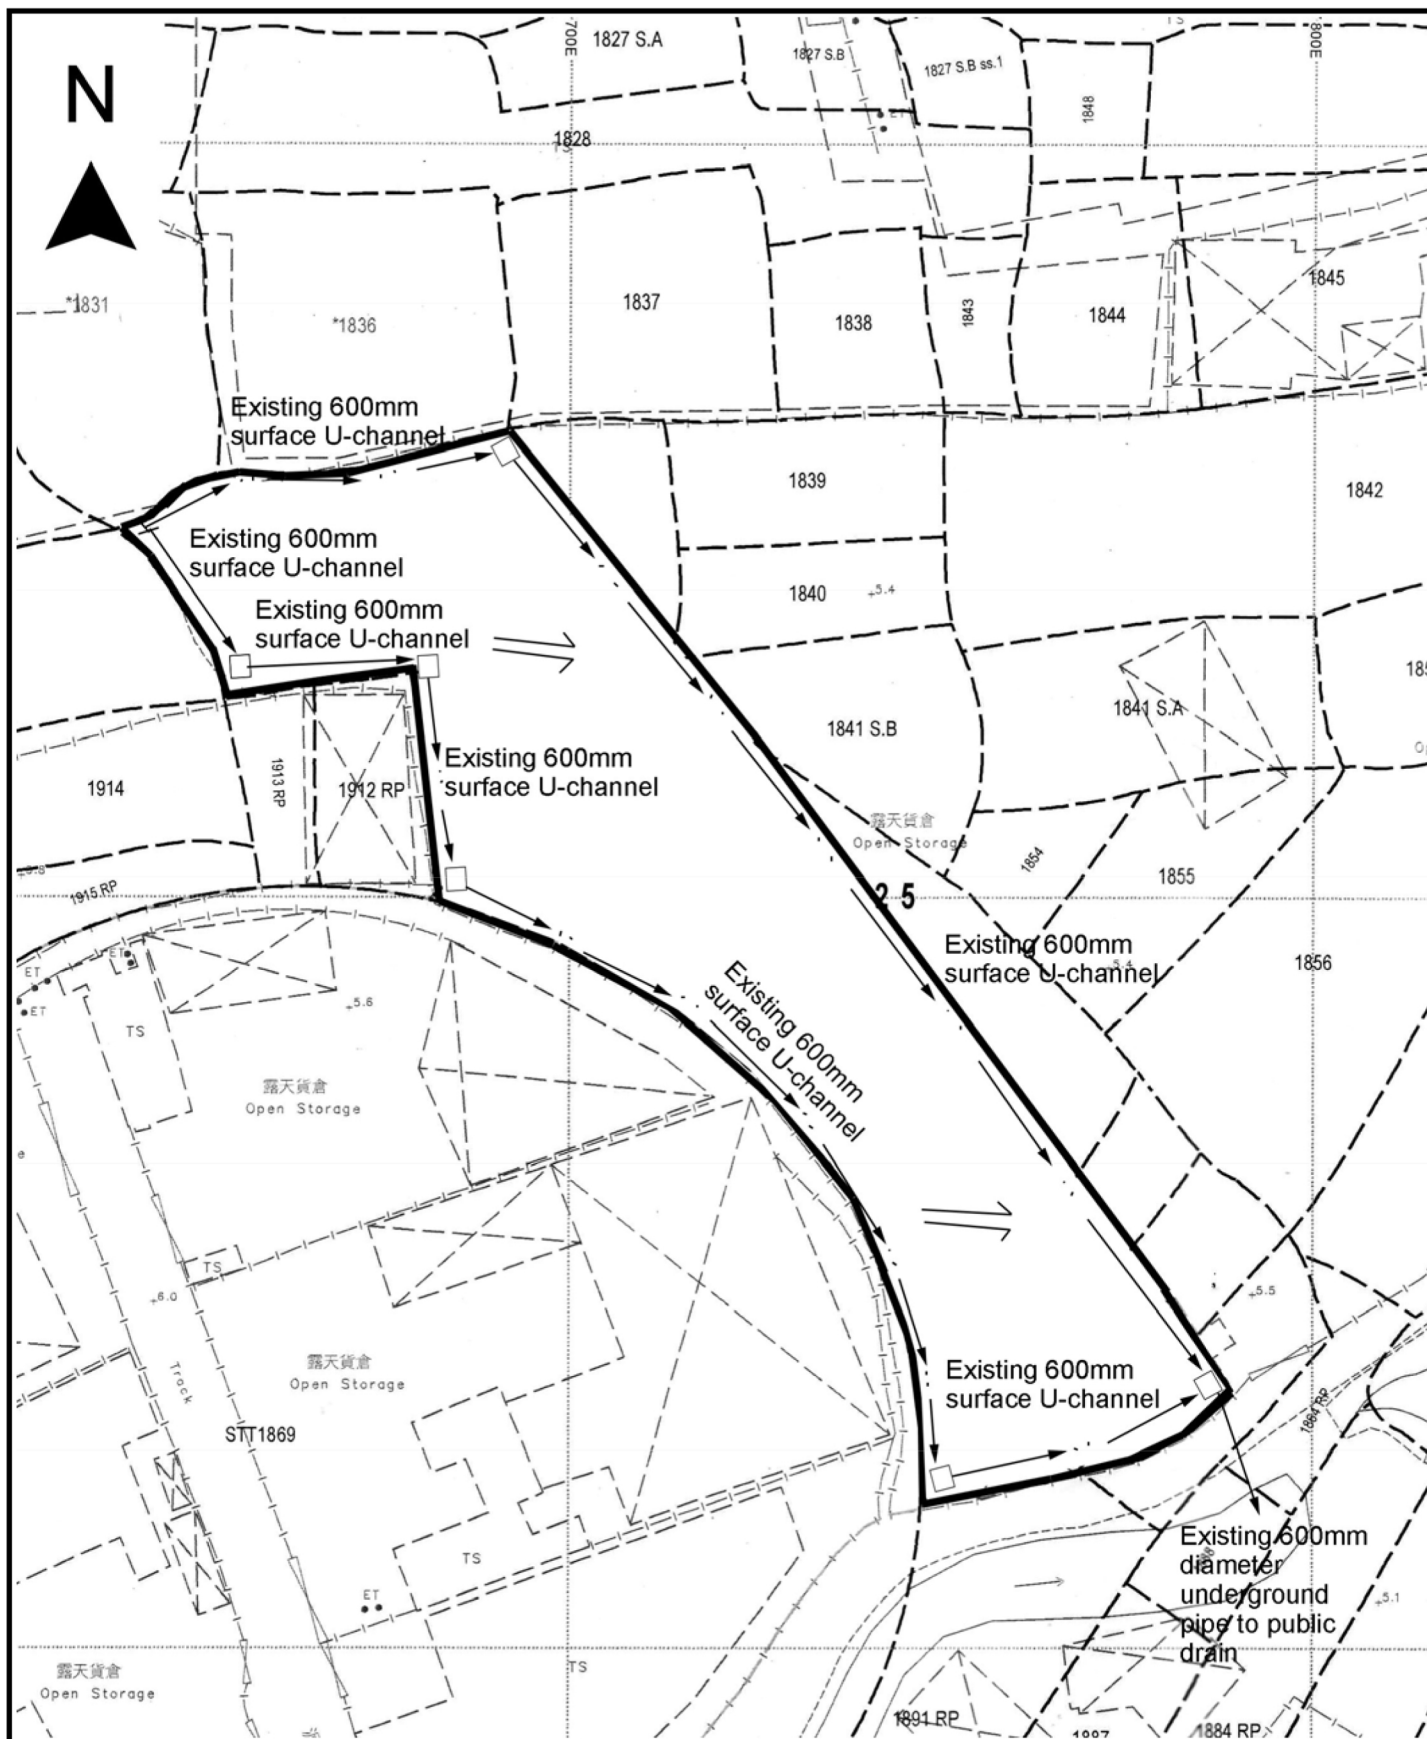

Project 項目名稱:

Proposed Temporary Warehouse for Storage of Construction Machinery, Construction Material, Food and Electronic Goods for a Period of 3 Years at Lots 1835 (Part), 1840 (Part), 1841 S.B (Part), 1889 (Part), 1890 (Part), 1891 RP (Part), 1893 RP, 1894 (Part), 1895 RP (Part) & 1911 in D.D. 125 and Adjoining Government Land, Ha Tsuen, Yuen Long, N.T.

Drawing Title 圖目:

As-built Drainage Plan

Drawing No. 圖號:

Figure 4

Remarks 備註:

⇐ Flow of surface runoff

□ catchpit

Scale 比例:

1:1000