


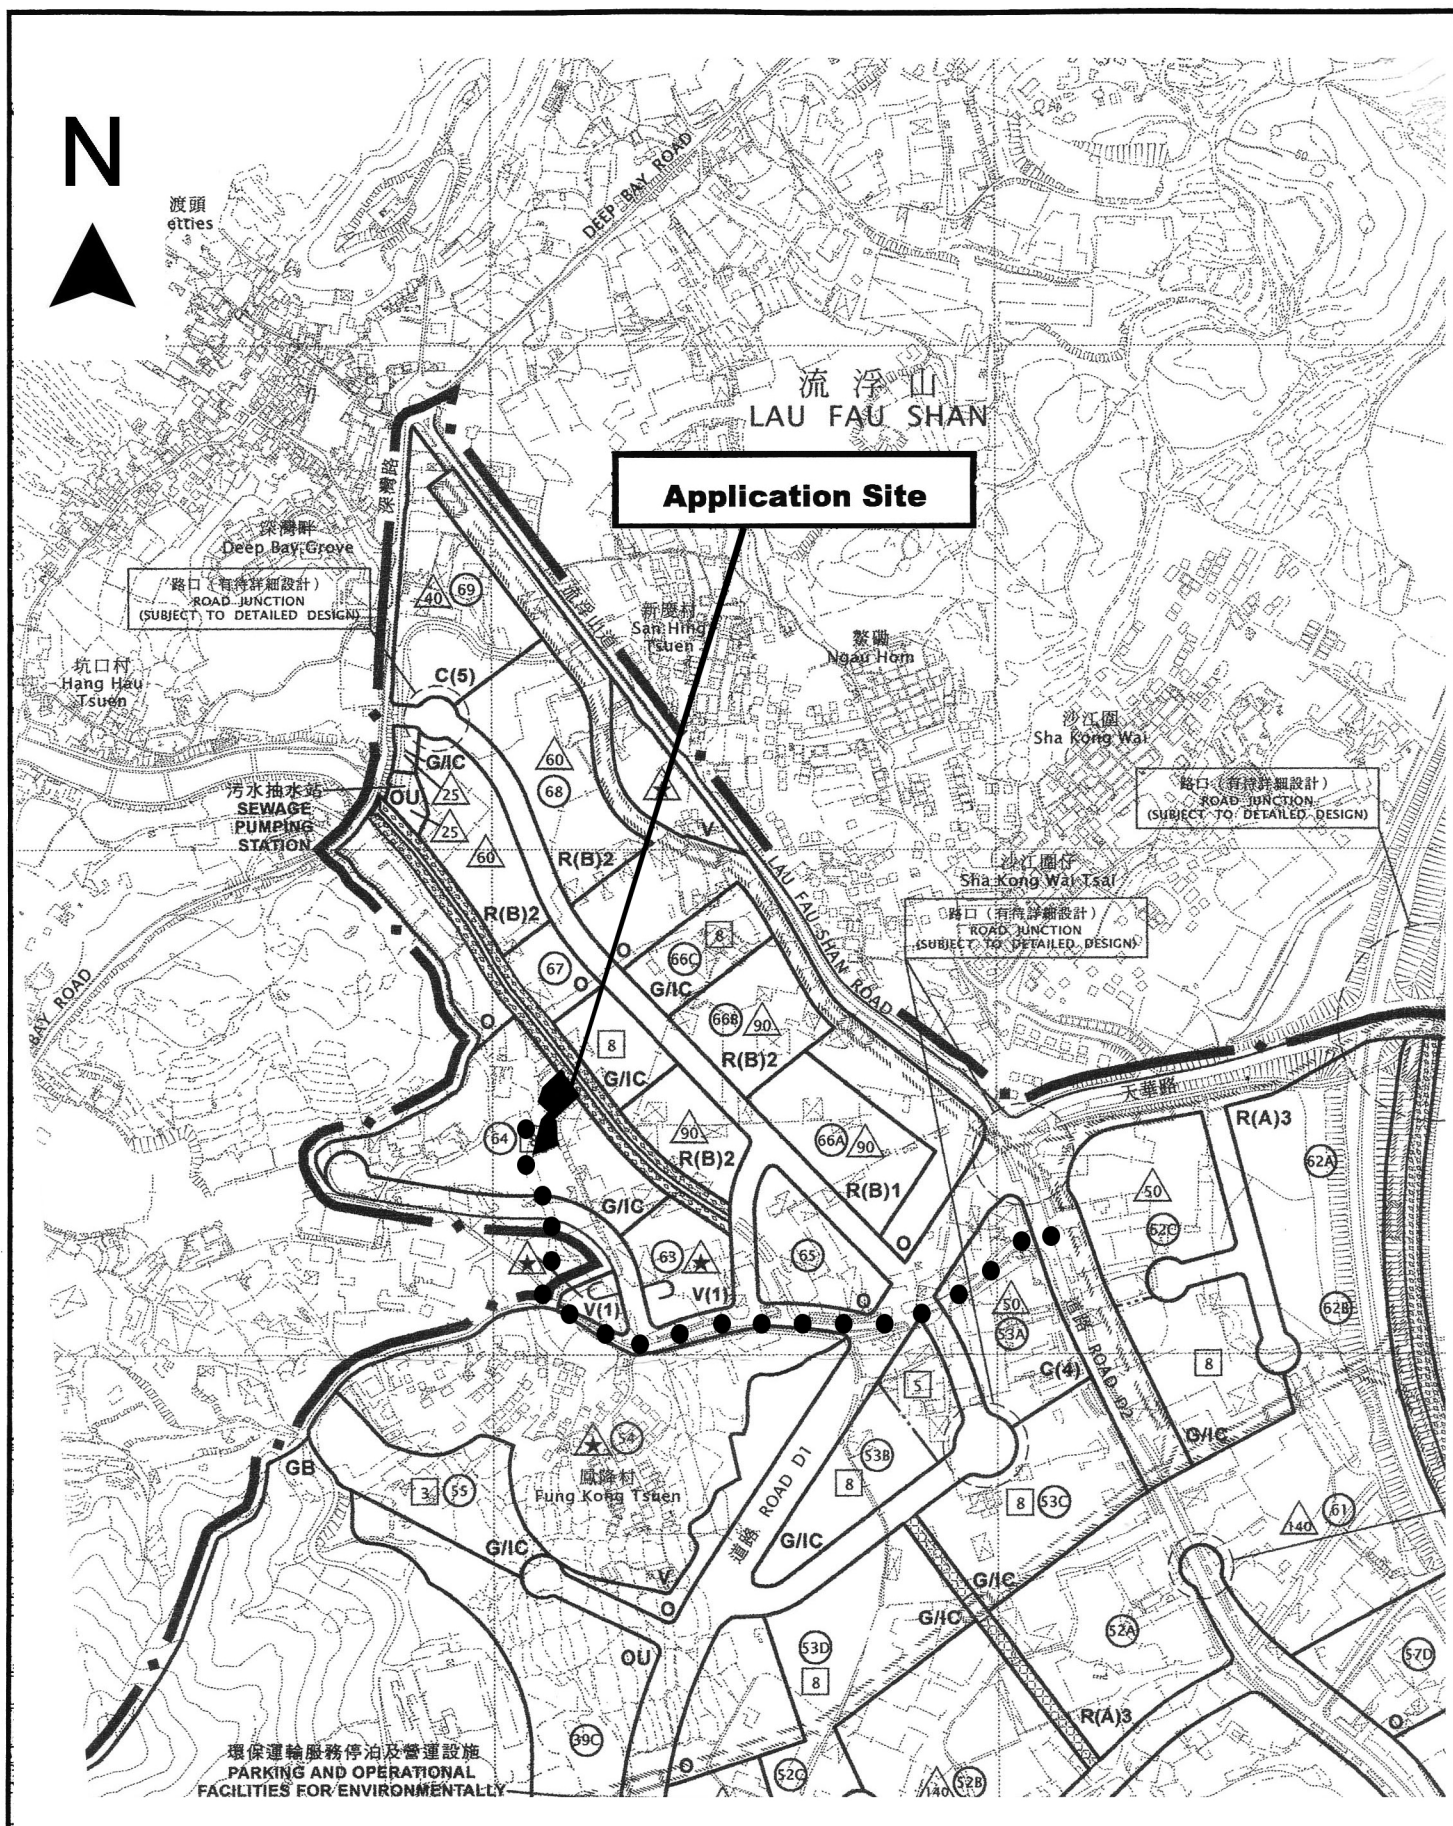

Project 項目名稱:

Proposed Temporary Open Storage of Construction Machinery and Construction Materials for a Period of 3 Years at Lots 35 (Part), 36 (Part), 37 (Part), 38 (Part), 39 (Part) & 41 (Part) in D.D. 128, Ha Tsuen, Yuen Long, N.T.

Drawing Title 圖目:

Location Plan

Drawing No. 圖號:

Figure 2

Remarks 備註:

●●● Vehicular Access Leading to Ping Ha Road

Scale 比例:

1:7500

N



Structure 1

Storage of construction material
GFA: Not exceeding 220m²
Height: Not exceeding 6.5m
No. of storey: 2
Covered Area: Not exceeding 140m²

Structure 2

Storage of construction material
GFA: Not exceeding 20m²
Height: Not exceeding 3m
No. of storey: 1
Covered Area: Not exceeding 20m²

Structure 3

Storage of construction material
GFA: Not exceeding 20m²
Height: Not exceeding 3m
No. of storey: 1
Covered Area: Not exceeding 20m²

Ingress/Egress
to vehicular track
leading to Fung
Kong Tsuen Road

SITE 2

Open storage of
construction material/machinery
with ancillary
workshop
(About
540m²)

SITE 1

Open storage
of construction
material/
machinery
(About 330m²)

Structure 4

Site office
GFA: Not exceeding 130m²
Height: Not exceeding 6.5m
No. of storey: 2
Covered Area: Not exceeding 65m²

Structure 5

Storage of construction material
GFA: Not exceeding 40m²
Height: Not exceeding 3m
No. of storey: 1
Covered Area: Not exceeding 40m²

Structure 6

Meter room
GFA: Not exceeding 10m²
Height: Not exceeding 3m
No. of storey: 1
Covered Area: Not exceeding 10m²

Structure 7

Storage of construction material
GFA: Not exceeding 120m²
Height: Not exceeding 6m
No. of storey: 2
Covered Area: Not exceeding 82.5m²

One loading/unloading
bay of 7m x 3.5m for
light goods vehicle

Two 5m x 2.5m parking
spaces for private car

Project 項目名稱:

Proposed Temporary Open Storage of
Construction Machinery and
Construction Materials for a Period of 3
Years at Lots 35 (Part), 36 (Part), 37
(Part), 38 S.A (Part), 39 (Part) & 41
(Part) in D.D. 128, Ha Tsuen, Yuen
Long, N.T.

Drawing Title 圖目:

Proposed Layout Plan


Drawing No. 圖號:

Figure 3

Remarks 備註:

Scale 比例:

1:500

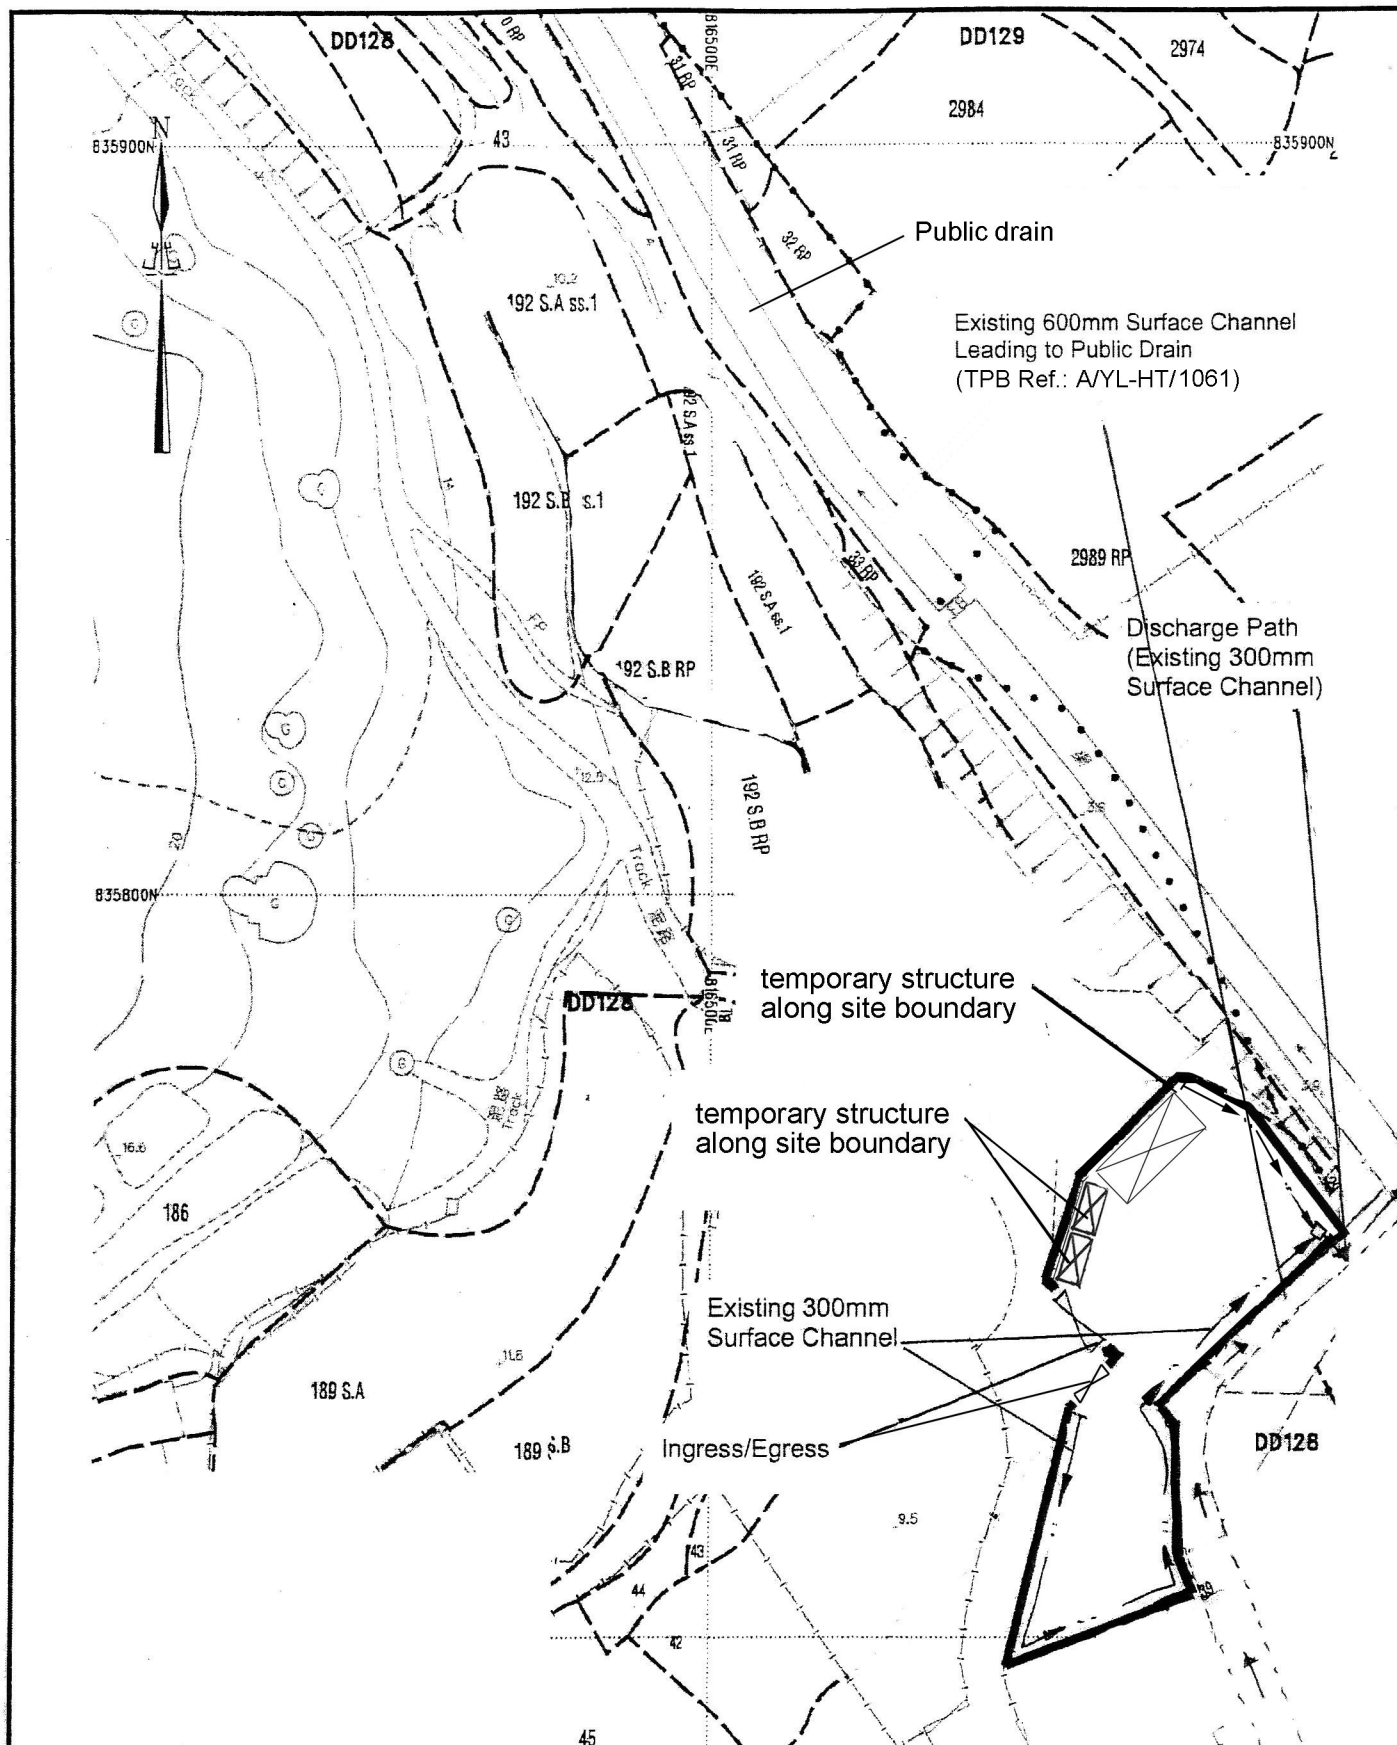

Project 項目名稱: Proposed Temporary Open Storage of Construction Machinery and Construction Materials for a Period of 3 Years at Lots 35 (Part), 36 (Part), 37 (Part), 38 S.A (Part), 39 (Part) & 41 (Part) in D.D. 128, Ha Tsuen, Yuen Long, N.T.	Drawing Title 圖目: As-built Drainage Plan Drawing No. 圖號: Figure 4	Remarks 備註: Scale 比例: 1:1000
---	---	---