


Subject Site

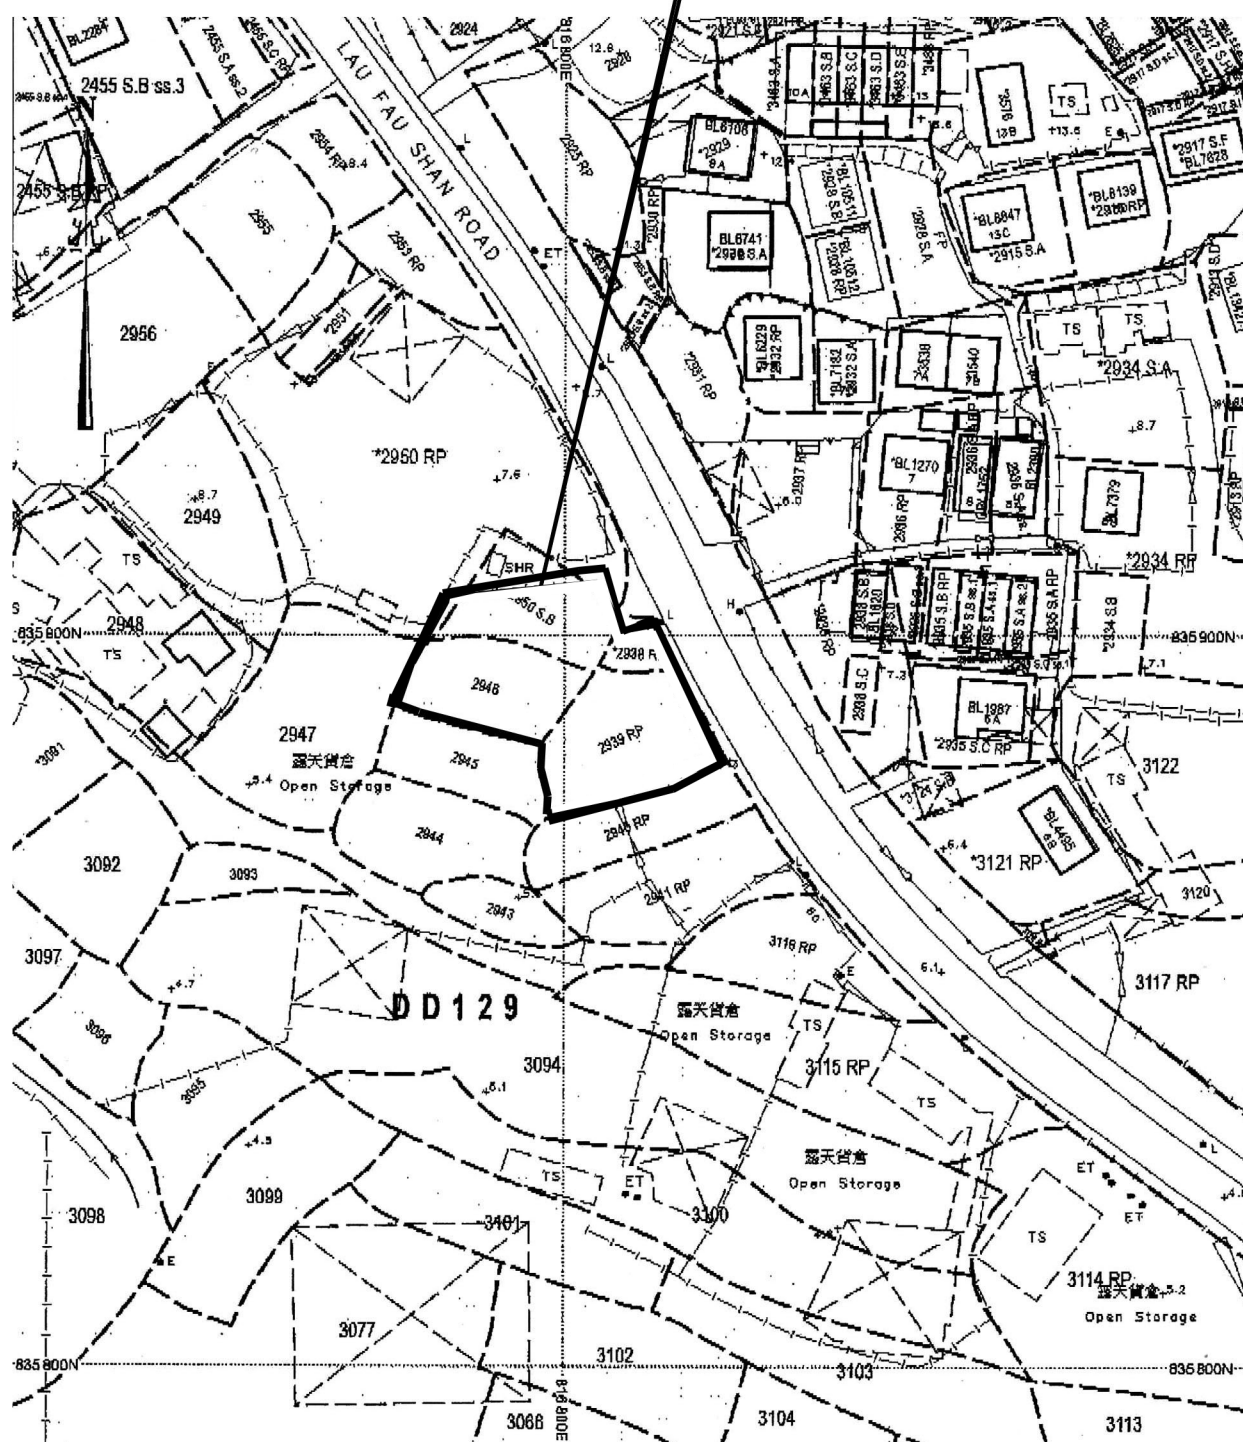


Proposed Temporary Open Storage of Scrap Metal for a Period of 3 Years at Lots 2938 RP (Part), 2939 RP, 2940 RP (Part), 2946, 2947 (Part), 2950 S.B (Part) & 2950 RP (Part) in D.D. 129, Ha Tsuen, Yuen Long, N.T.

Site Plan

Figure 1

Scale 比例:

1:1000

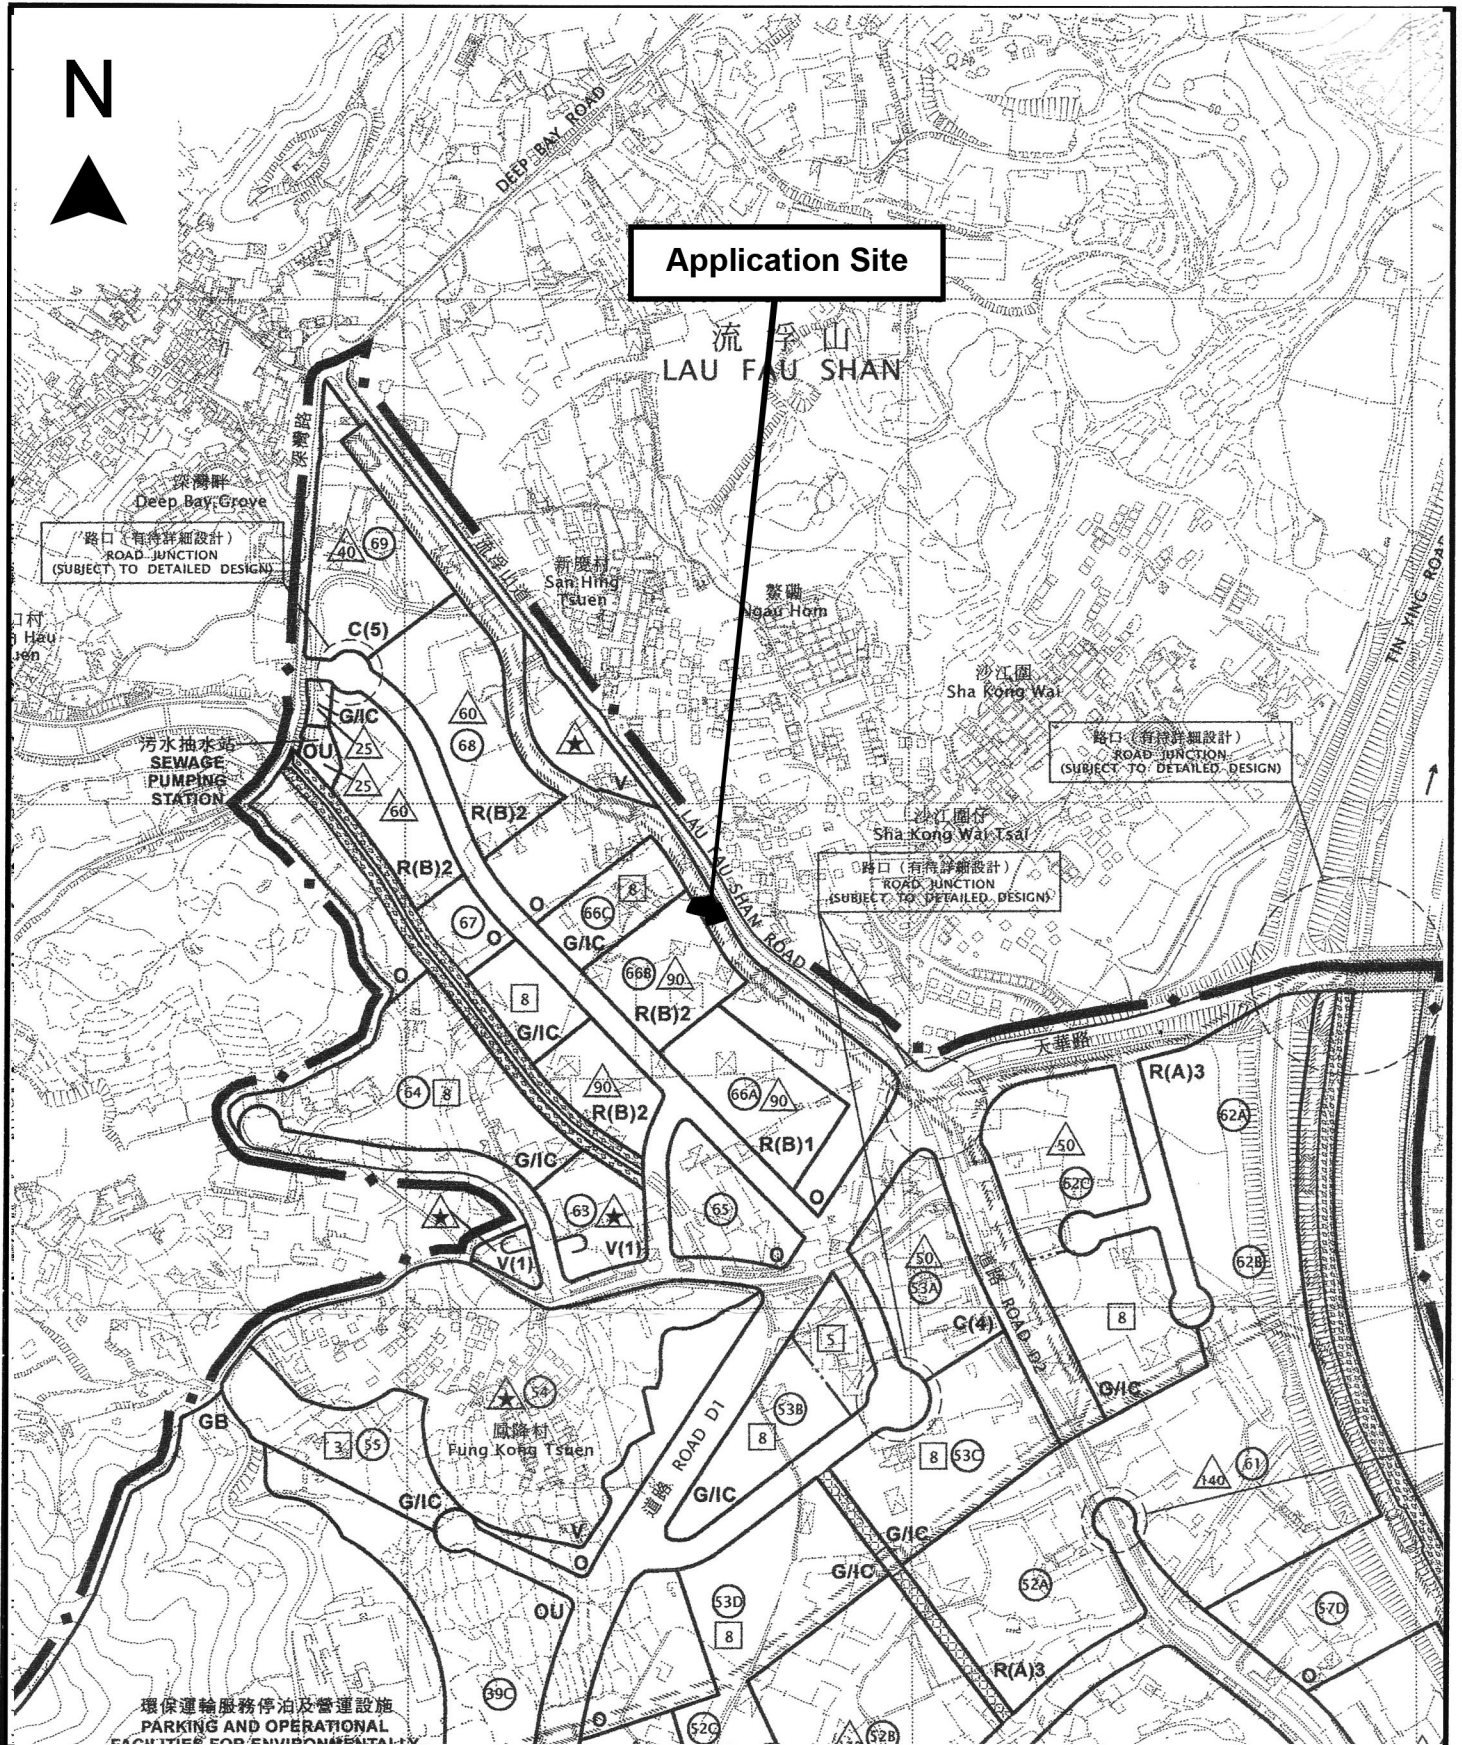

Project 項目名稱:

Proposed Temporary Open Storage of Scrap Metal for a Period of 3 Years at Lots 2938 RP (Part), 2939 RP, 2940 RP (Part), 2946, 2947 (Part), 2950 S.B (Part) & 2950 RP (Part) in D.D. 129, Ha Tsuen, Yuen Long, N.T.

Drawing Title 圖目:

Location Plan


Drawing No. 圖號:

Figure 2

Remarks 備註:

Scale 比例:

1:7500

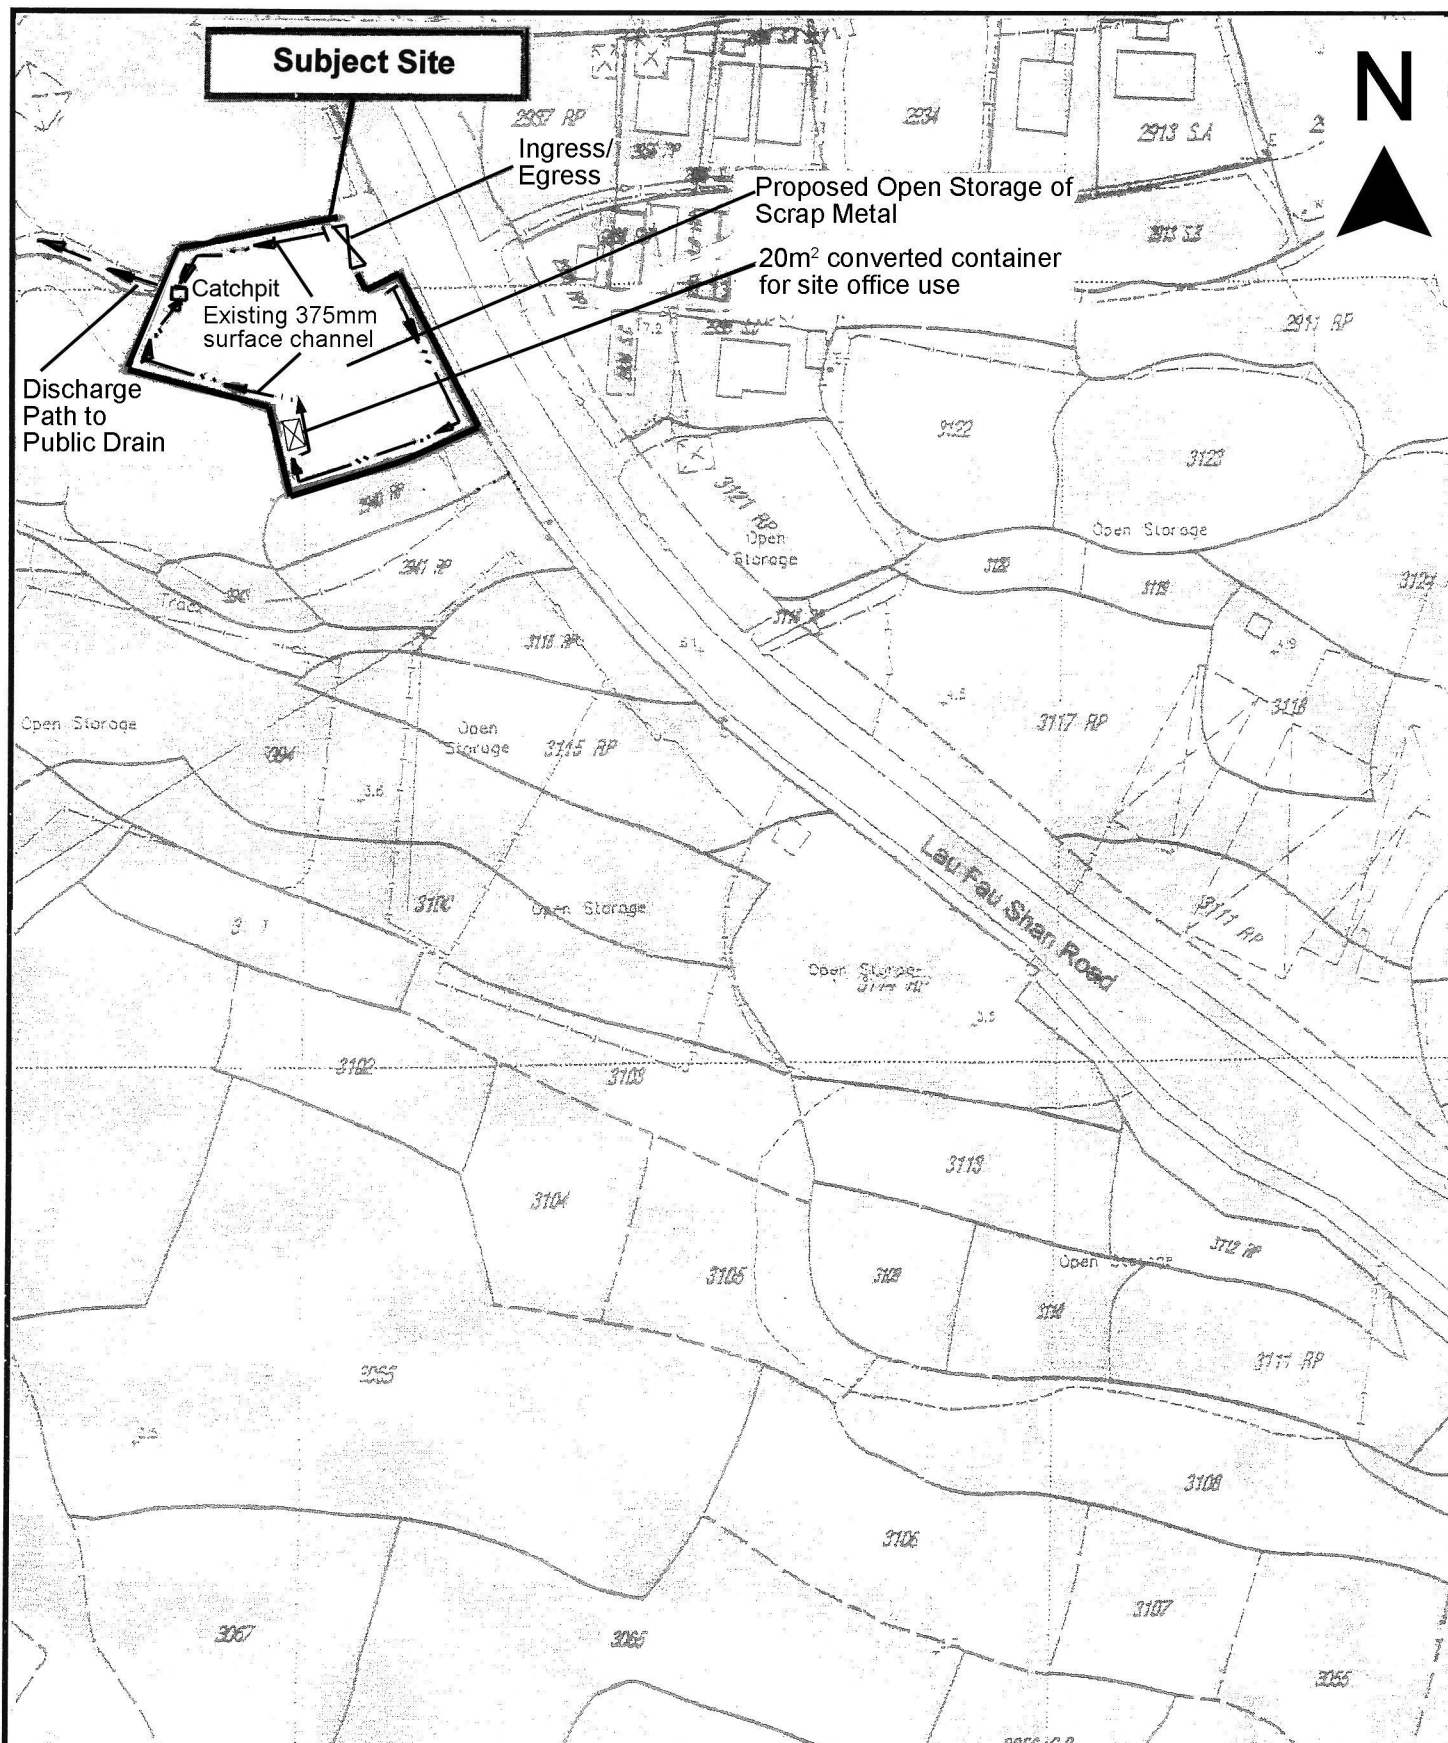

Project 項目名稱:

Proposed Temporary Open Storage of Scrap Metal for a Period of 3 Years at Lots 2938 RP (Part), 2939 RP, 2940 RP (Part), 2946, 2947 (Part), 2950 S.B (Part) & 2950 RP (Part) in D.D. 129, Ha Tsuen, Yuen Long, N.T.

Drawing Title 圖目:

As-built Drainage Plan

Remarks 備註:

Drawing No. 圖號:

Figure 4

Scale 比例:

1:1000