


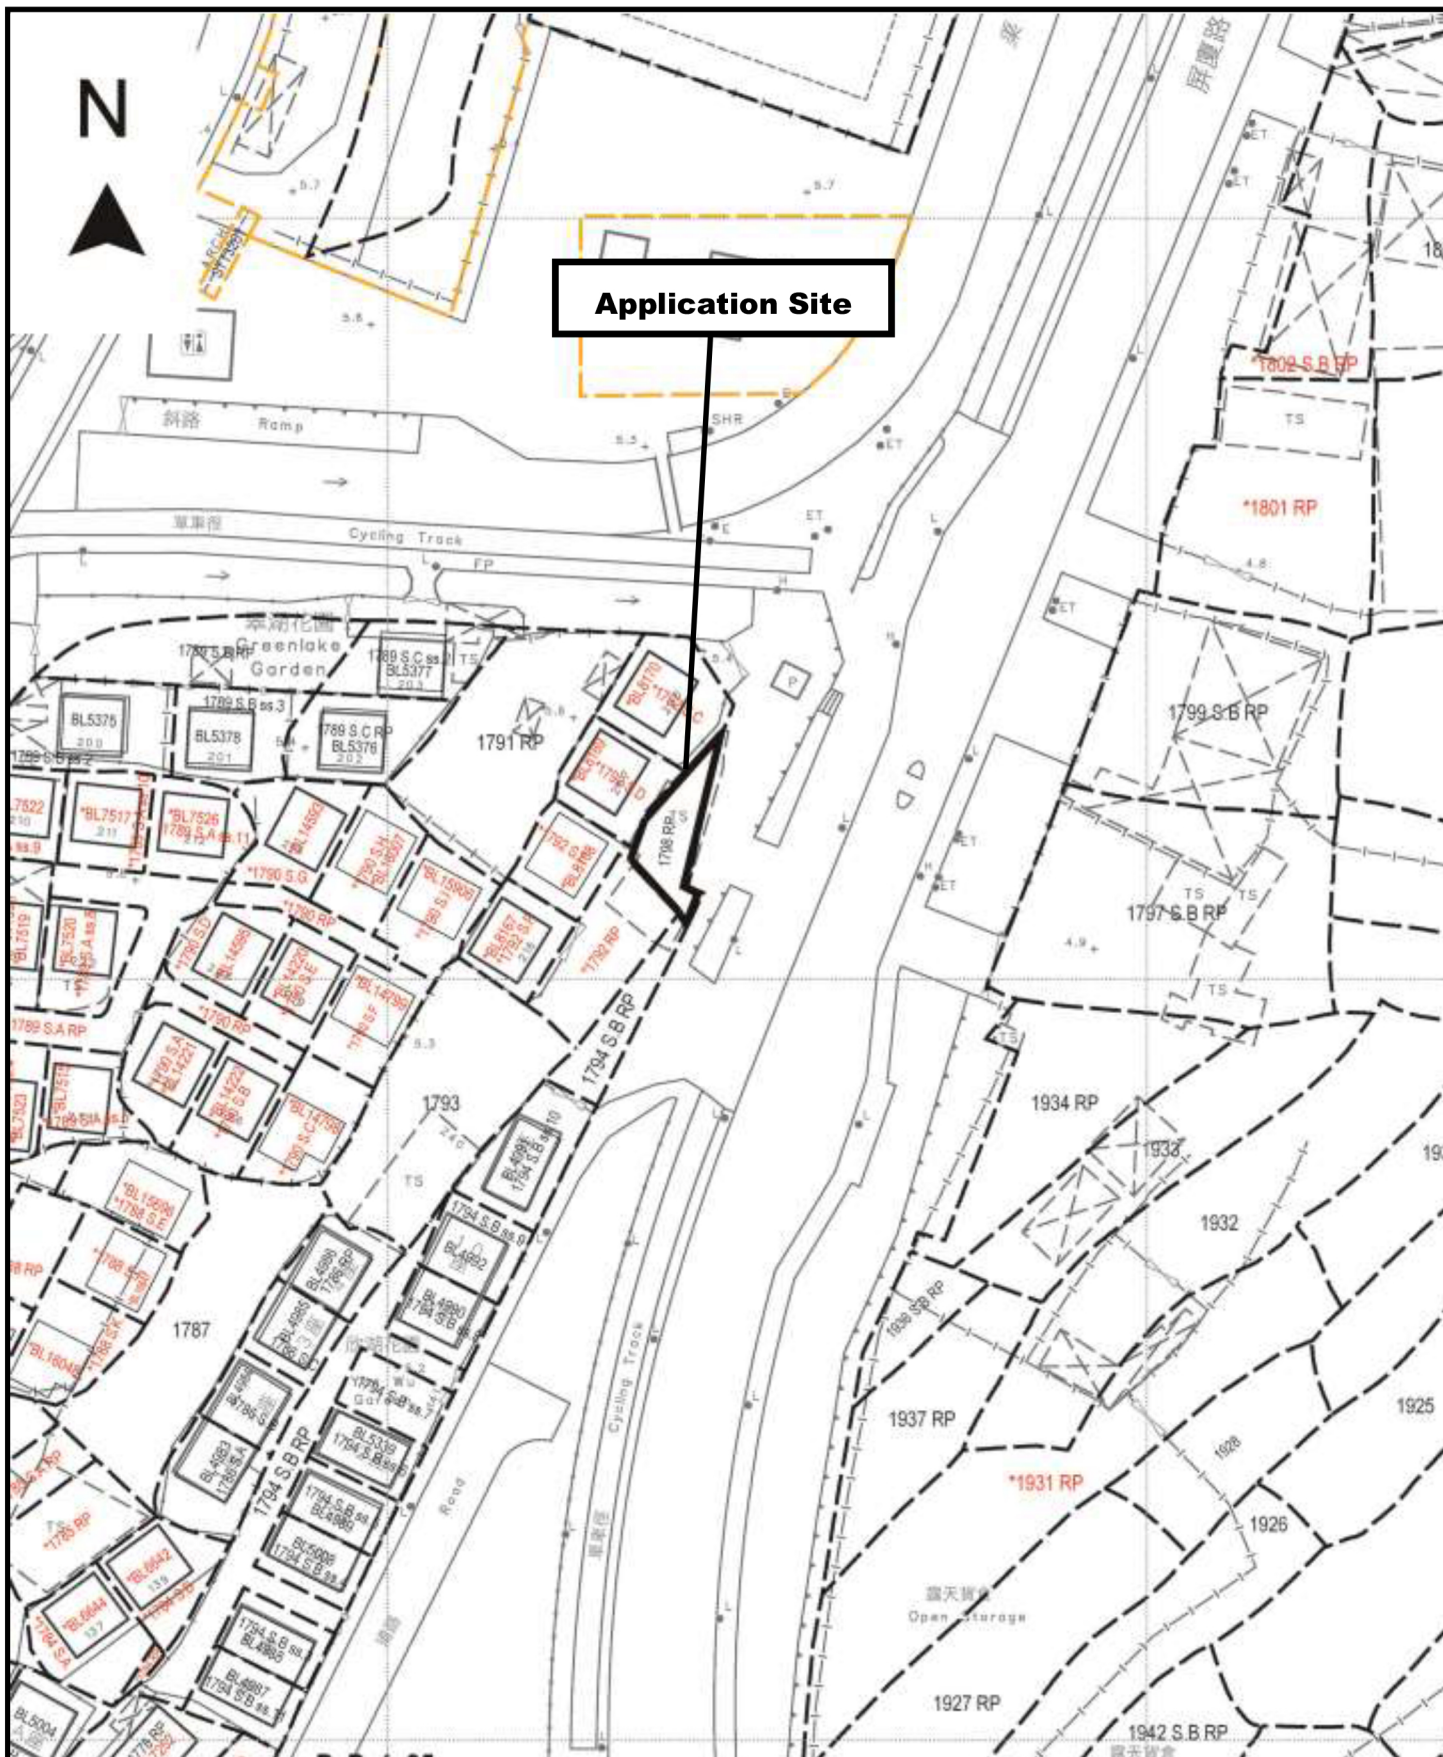

Project 項目名稱:

Temporary Eating Place for a Period of 3 Years at Lot 1798 RP in D.D. 125, Ha Tsuen, Yuen Long, N.T.

Drawing Title 圖目:

Application Site


Remarks 備註:

Drawing No. 圖號:

Figure 1

Scale 比例:

1:1000

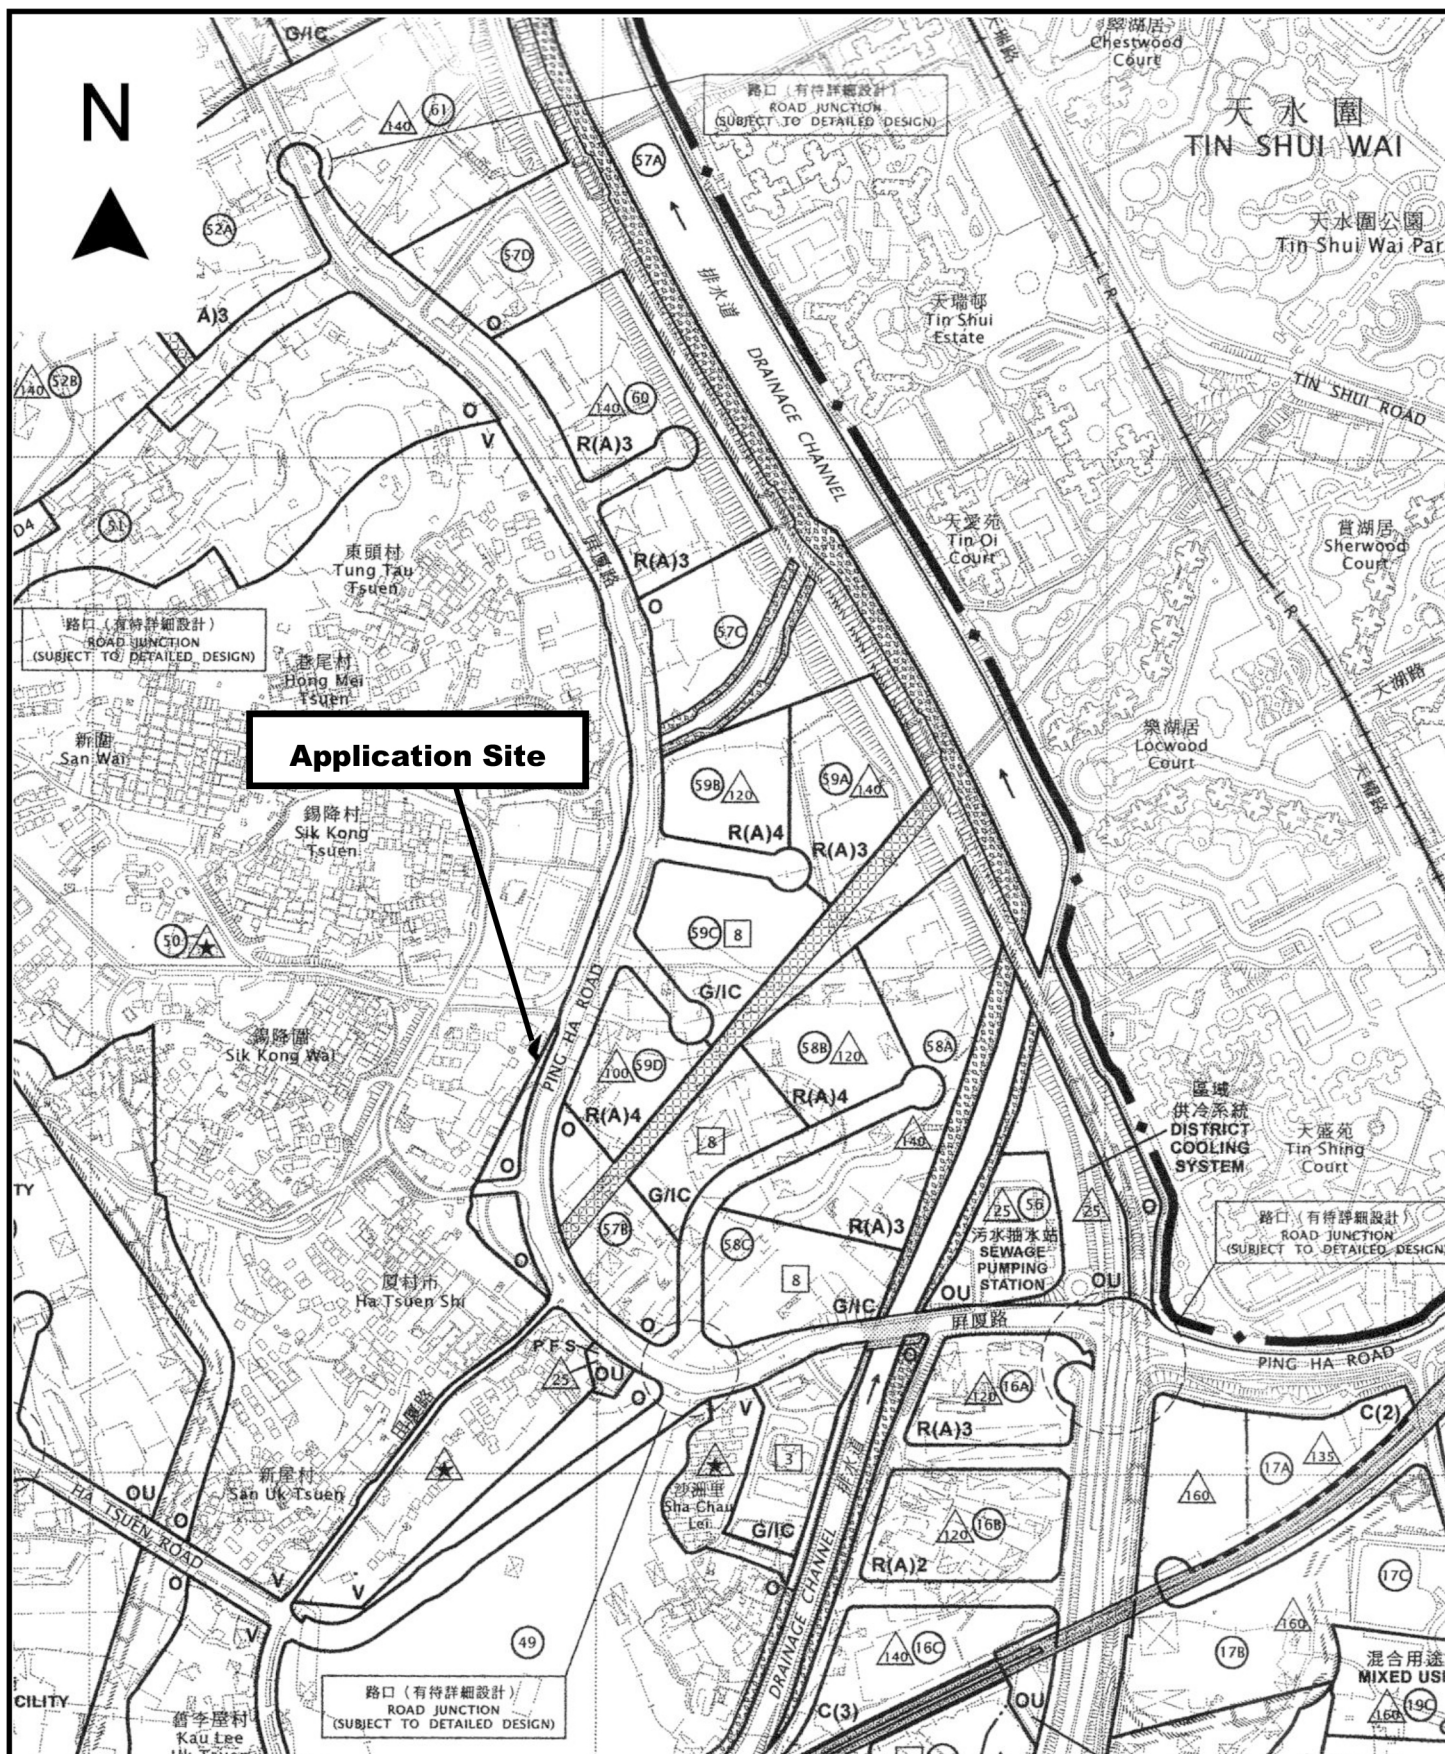

Project 項目名稱:

Temporary Eating Place for a Period of 3 Years at Lot 1798 RP in D.D. 125, Ha Tsuen, Yuen Long, N.T.

Drawing Title 圖目:

Location Plan


Remarks 備註:

Drawing No. 圖號:

Figure 2

Scale 比例:

1:7500

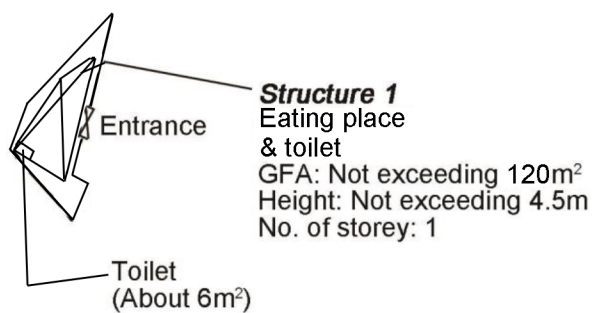

Project 項目名稱:

Temporary Eating Place for a Period of
3 Years at Lot 1798 RP in D.D. 125, Ha
Tsuen, Yuen Long, N.T.

Drawing Title 圖目:

Proposed Layout Plan


Remarks 備註:

Drawing No. 圖號:

Figure 3

Scale 比例:

1:1000

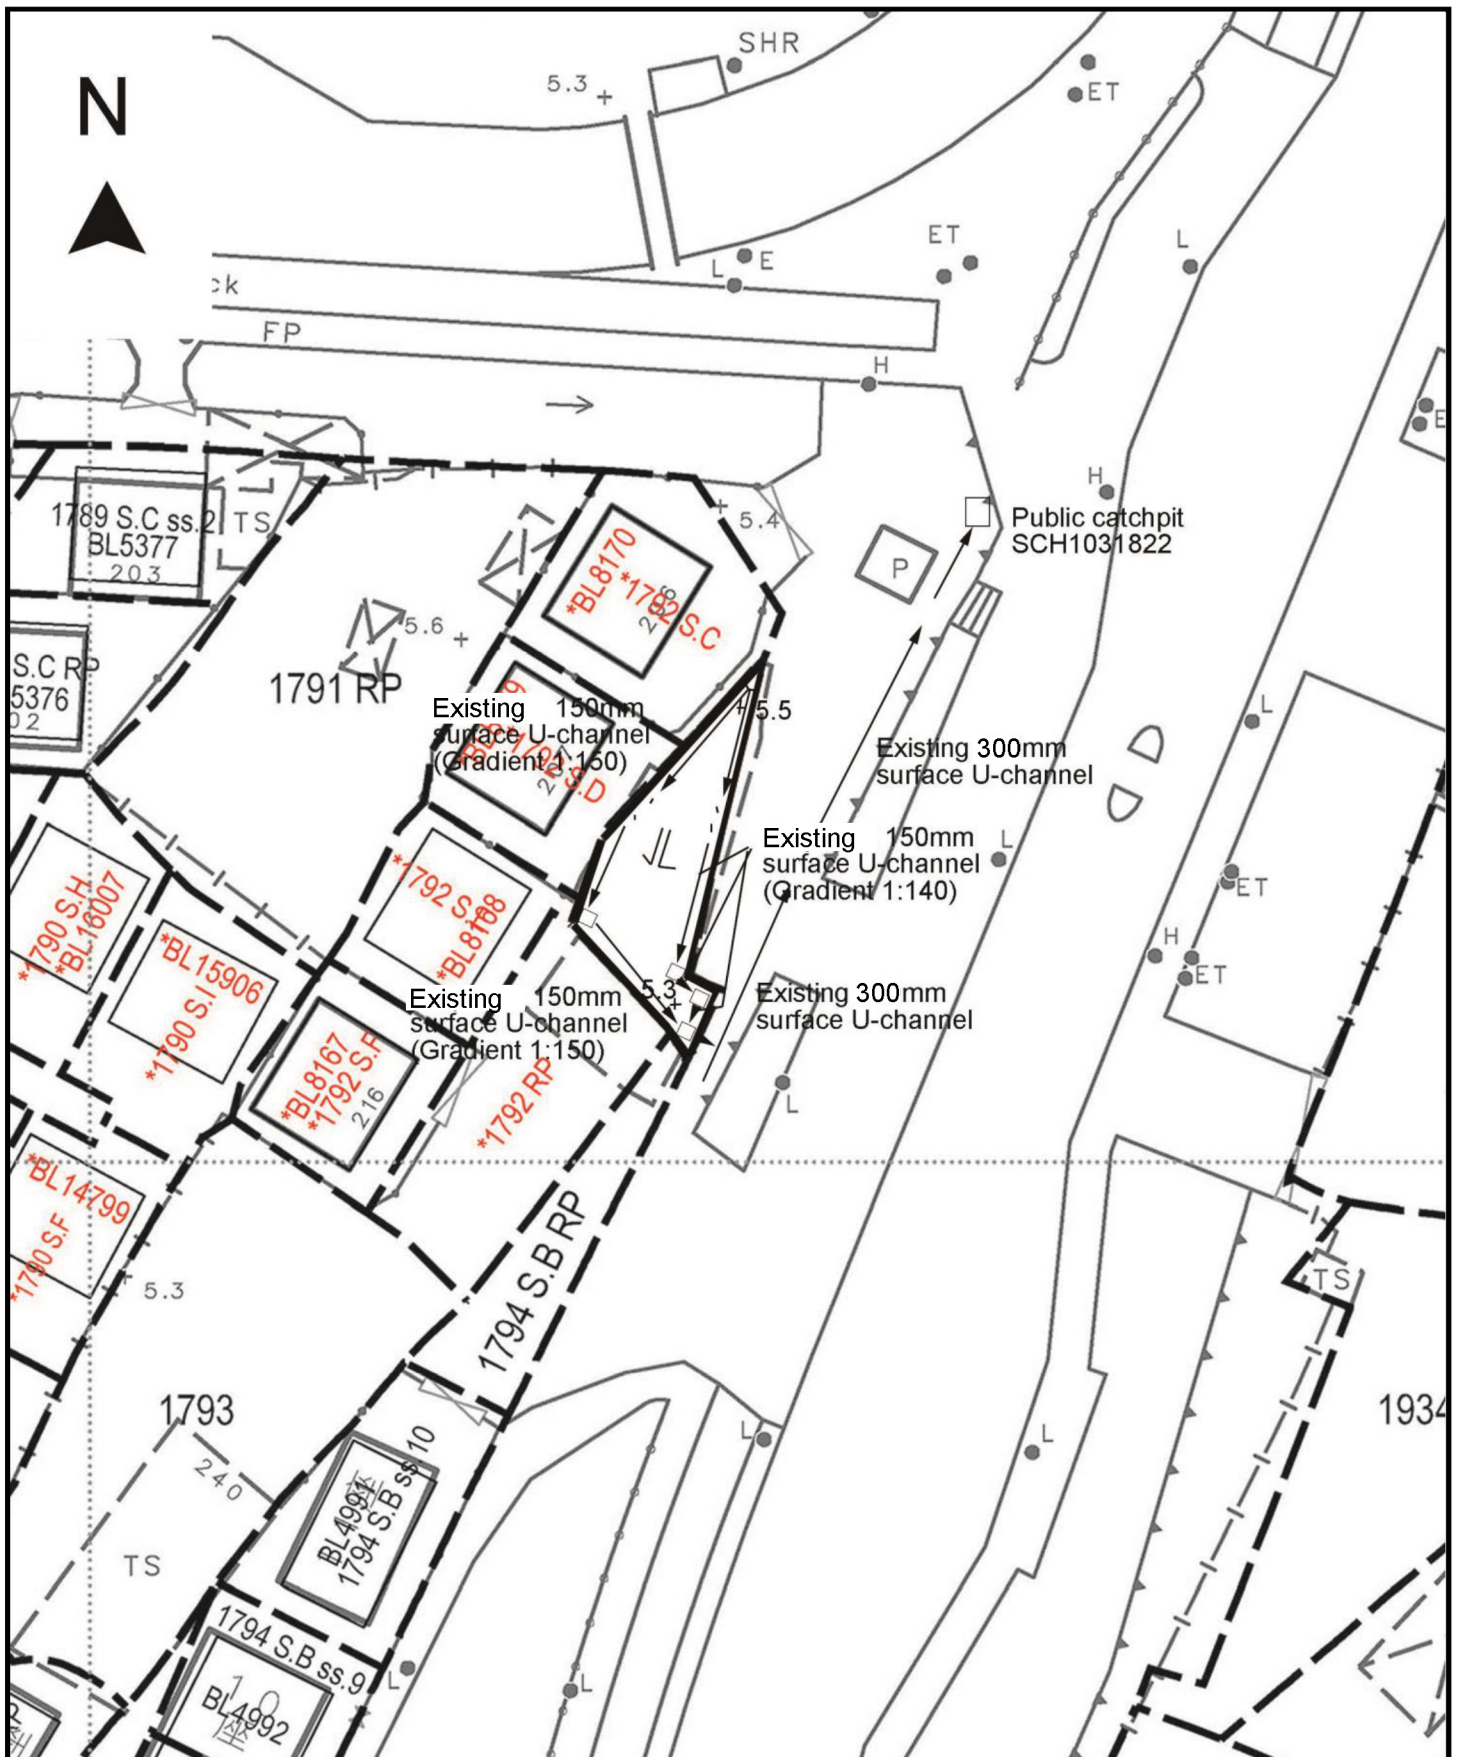

Project 項目名稱: Temporary Eating Place for a Period of 3 Years at Lot 1798 RP in D.D. 125, Ha Tsuen, Yuen Long, N.T.	Drawing Title 圖目: As-built Drainage Plan Drawing No. 圖號: Figure 4	Remarks 備註: □ Catchpit + 5.5 Level (mPD) ⇐ Flow of Surface Runoff Scale 比例: 1:500
--	---	---