

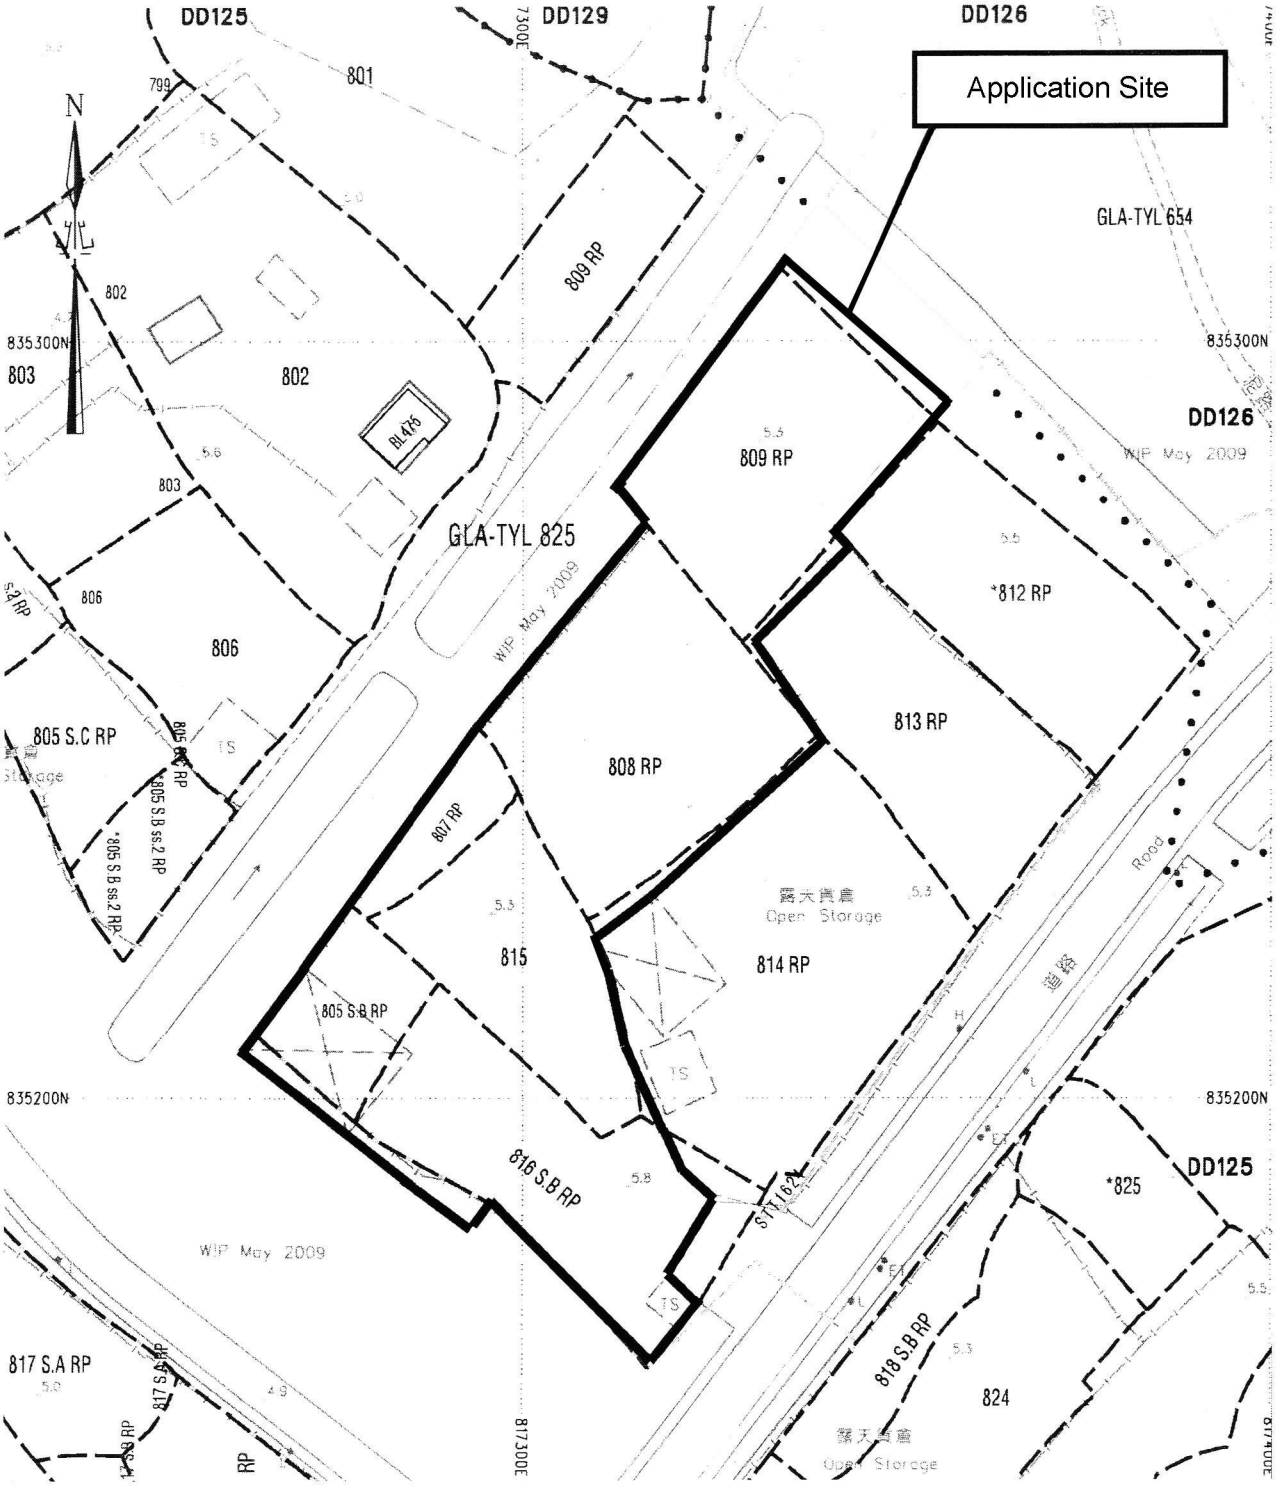



Project 項目名稱: Temporary Logistics Centre with Ancillary Site Office for a Period of 3 Years at Lots 805 S.B RP, 807 RP, 808 RP, 809 RP (Part), 813 RP (Part), 814 RP (Part), 815 (Part) & 816 S.B RP (Part) in D.D. 125 & Adjoining Government Land, Ha Tsuen, Yuen Long, N.T.	Drawing Title 圖目: Site Plan Drawing No. 圖號: Figure 1	Remarks 備註: Scale 比例: 1:1000

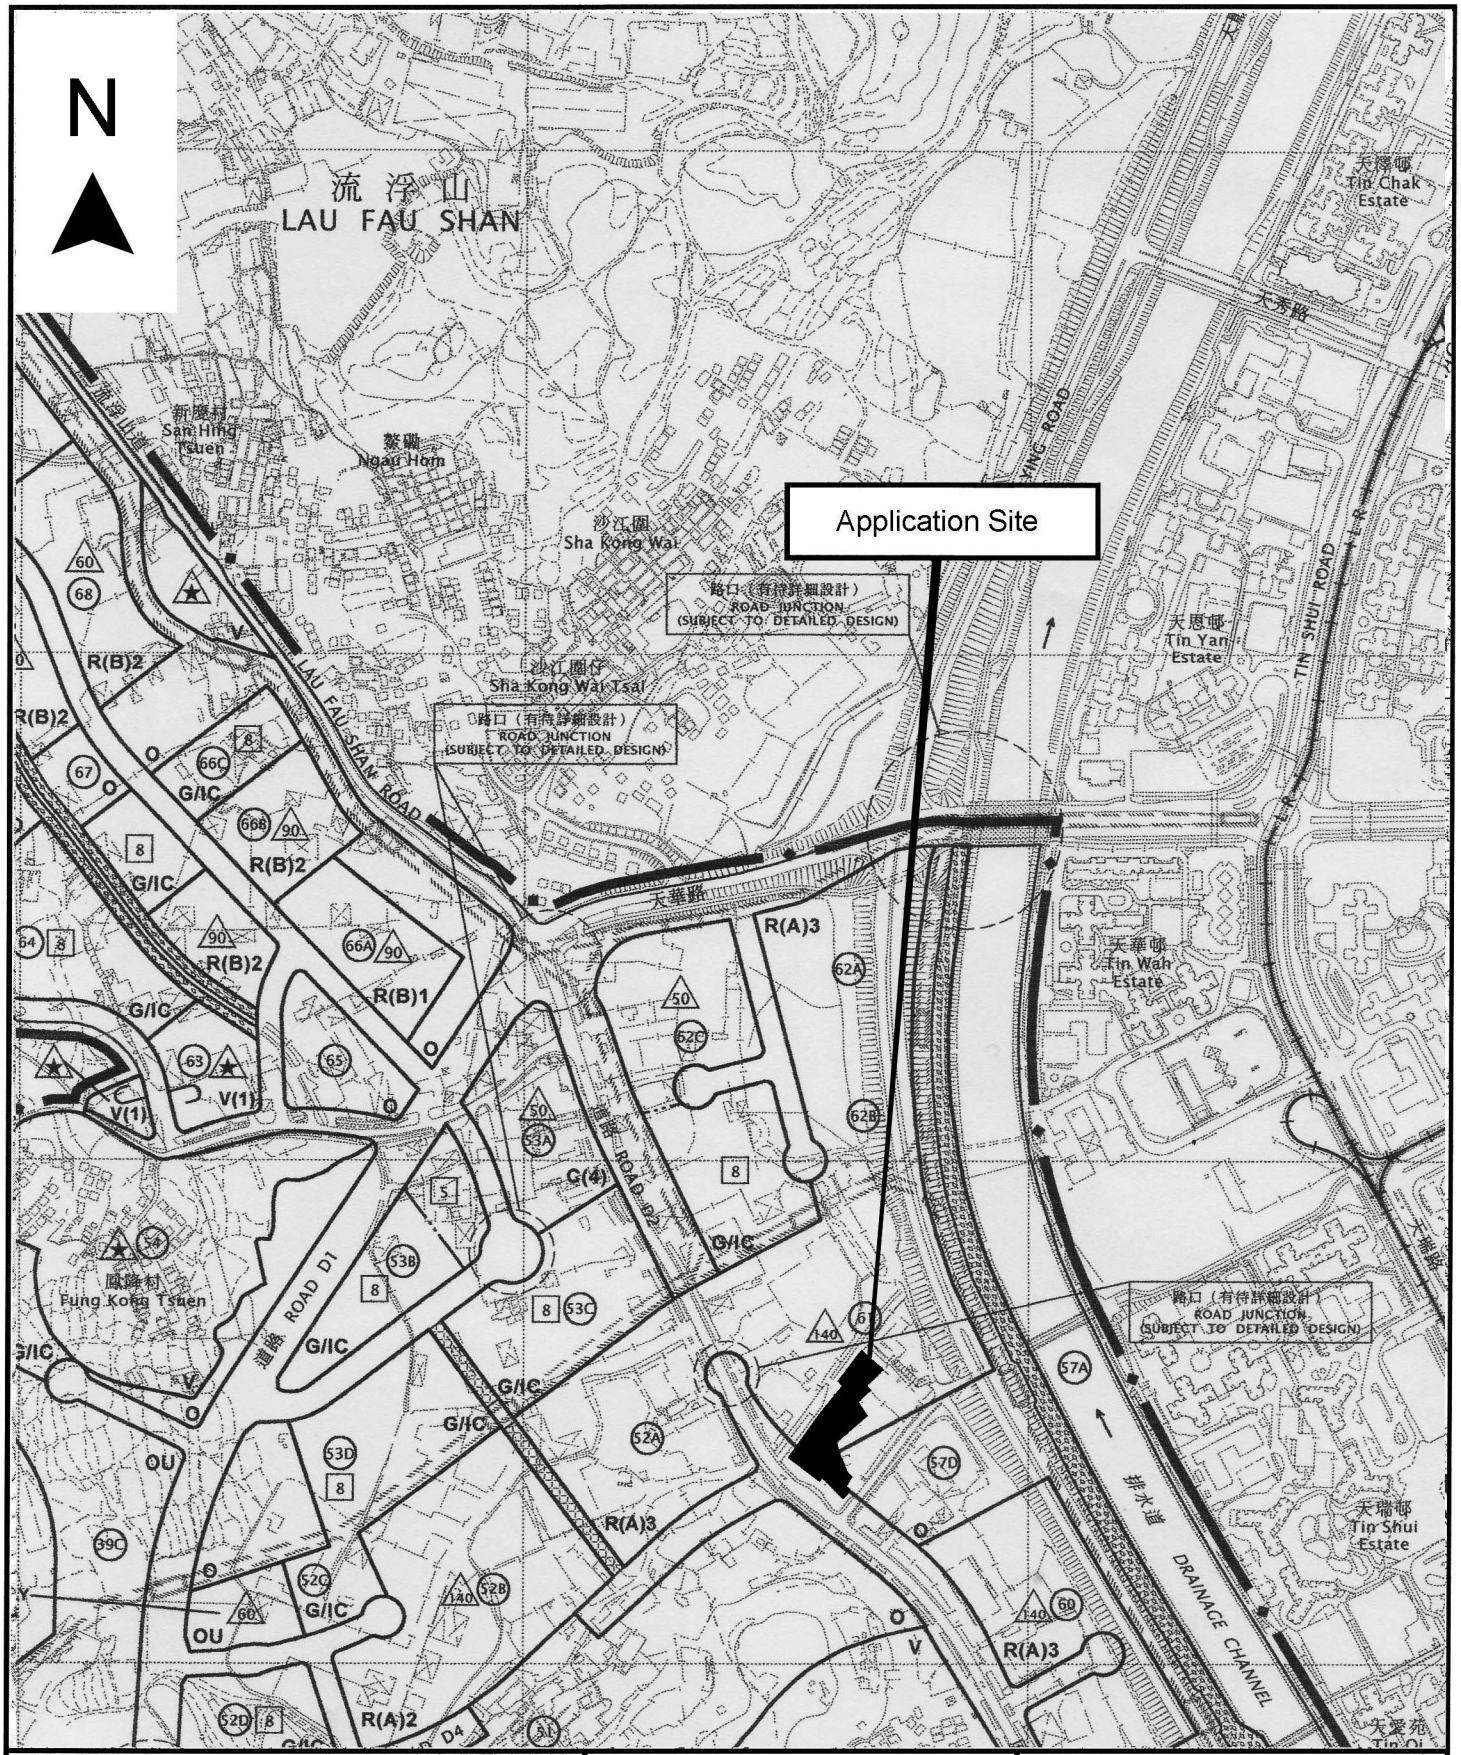

Project 項目名稱: Temporary Logistics Centre with Ancillary Site Office for a Period of 3 Years at Lots 805 S.B RP, 807 RP, 808 RP, 809 RP (Part), 813 RP (Part), 814 RP (Part), 815 (Part) & 816 S.B RP (Part) in D.D. 125 & Adjoining Government Land, Ha Tsuen, Yuen Long, N.T.	Drawing Title 圖目: Location Plan	Remarks 備註:
	Drawing No. 圖號: Figure 2	Scale 比例: 1:7500

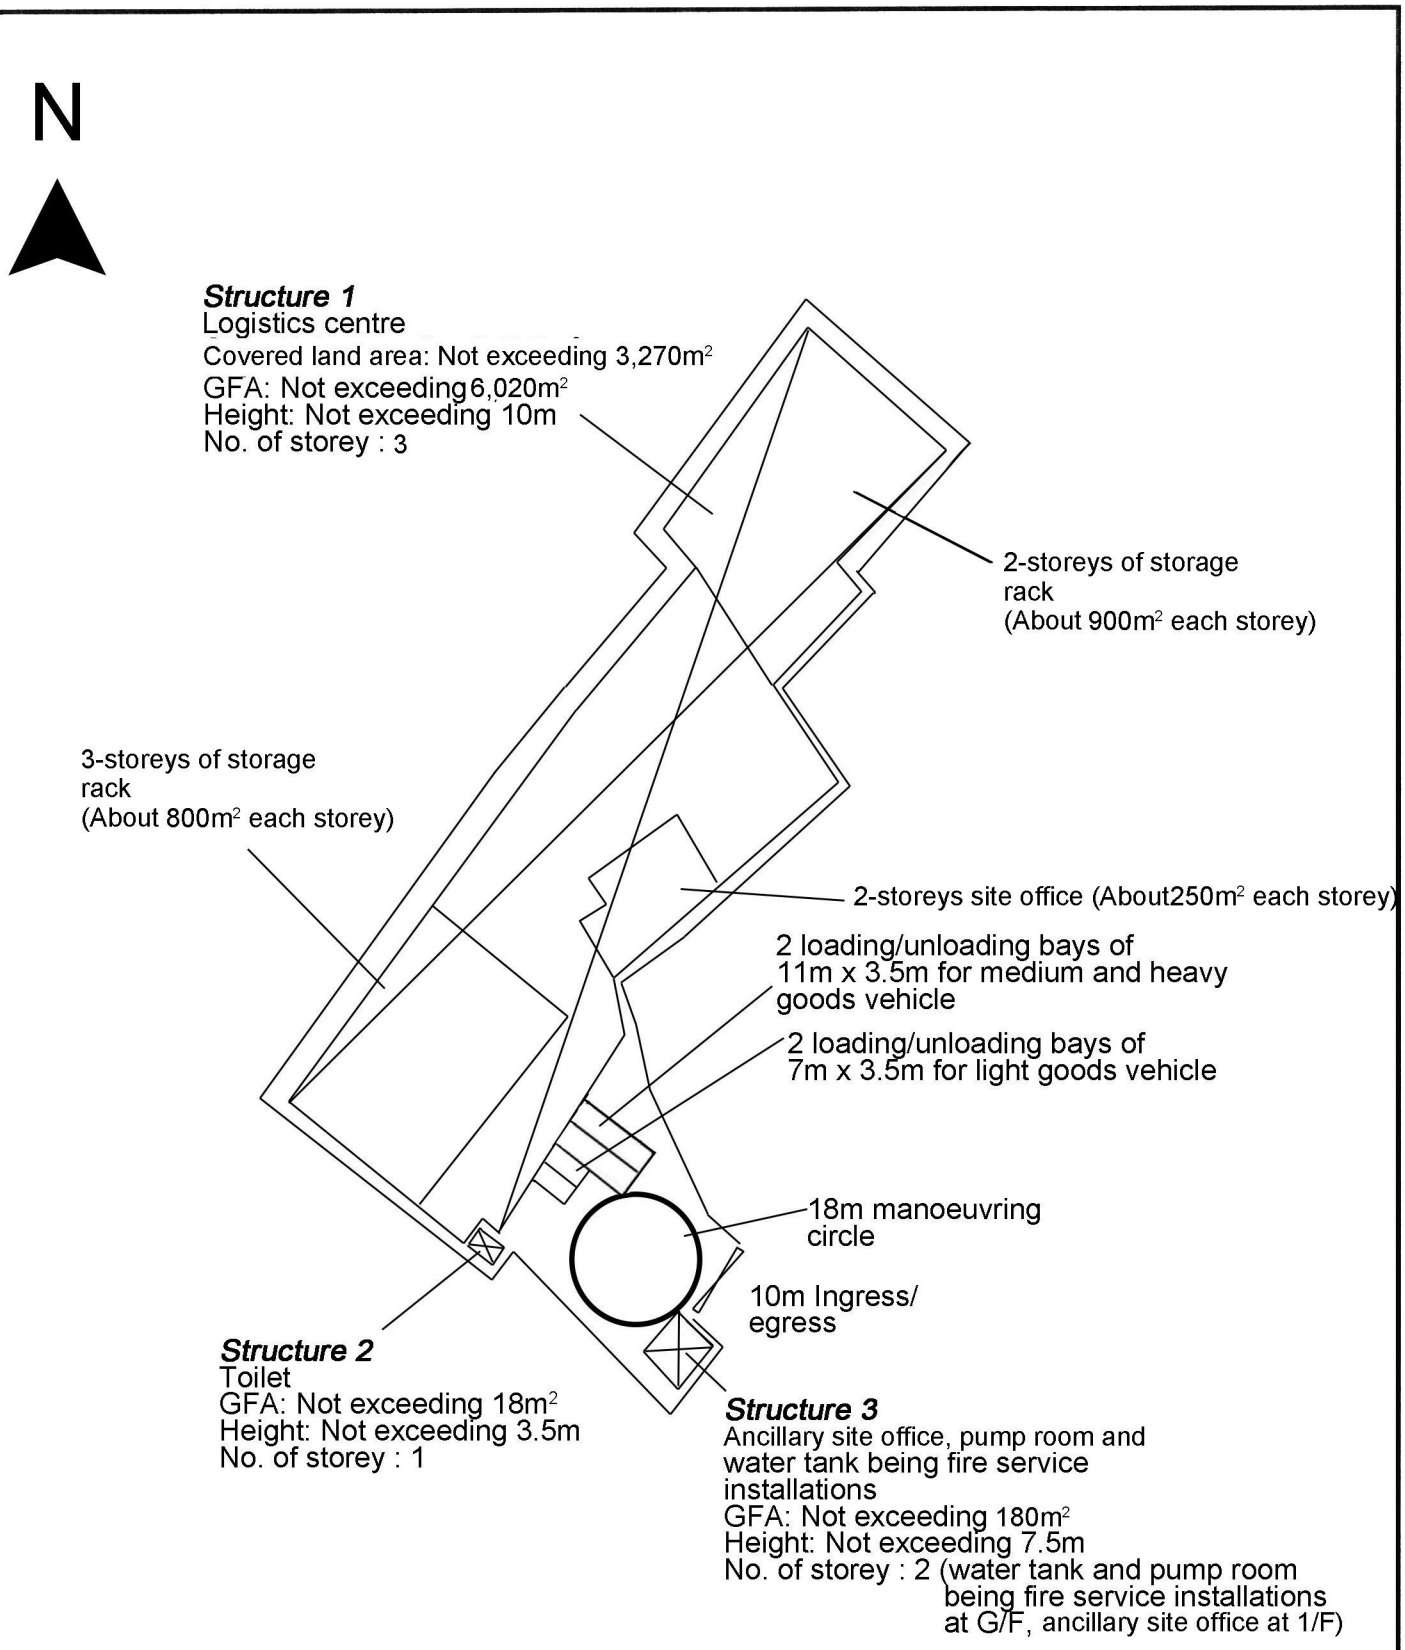

Project 項目名稱:	Drawing Title 圖目:	Remarks 備註:
Temporary Logistics Centre with Ancillary Site Office for a Period of 3 Years at Lots 805 S.B RP, 807 RP, 808 RP, 809 RP (Part), 813 RP (Part), 814 RP (Part), 815 (Part) & 816 S.B RP (Part) in D.D. 125 & Adjoining Government Land, Ha Tsuen, Yuen Long, N.T.	Proposed Layout Plan	
	Drawing No. 圖號: Figure 3	Scale 比例: 1:1000

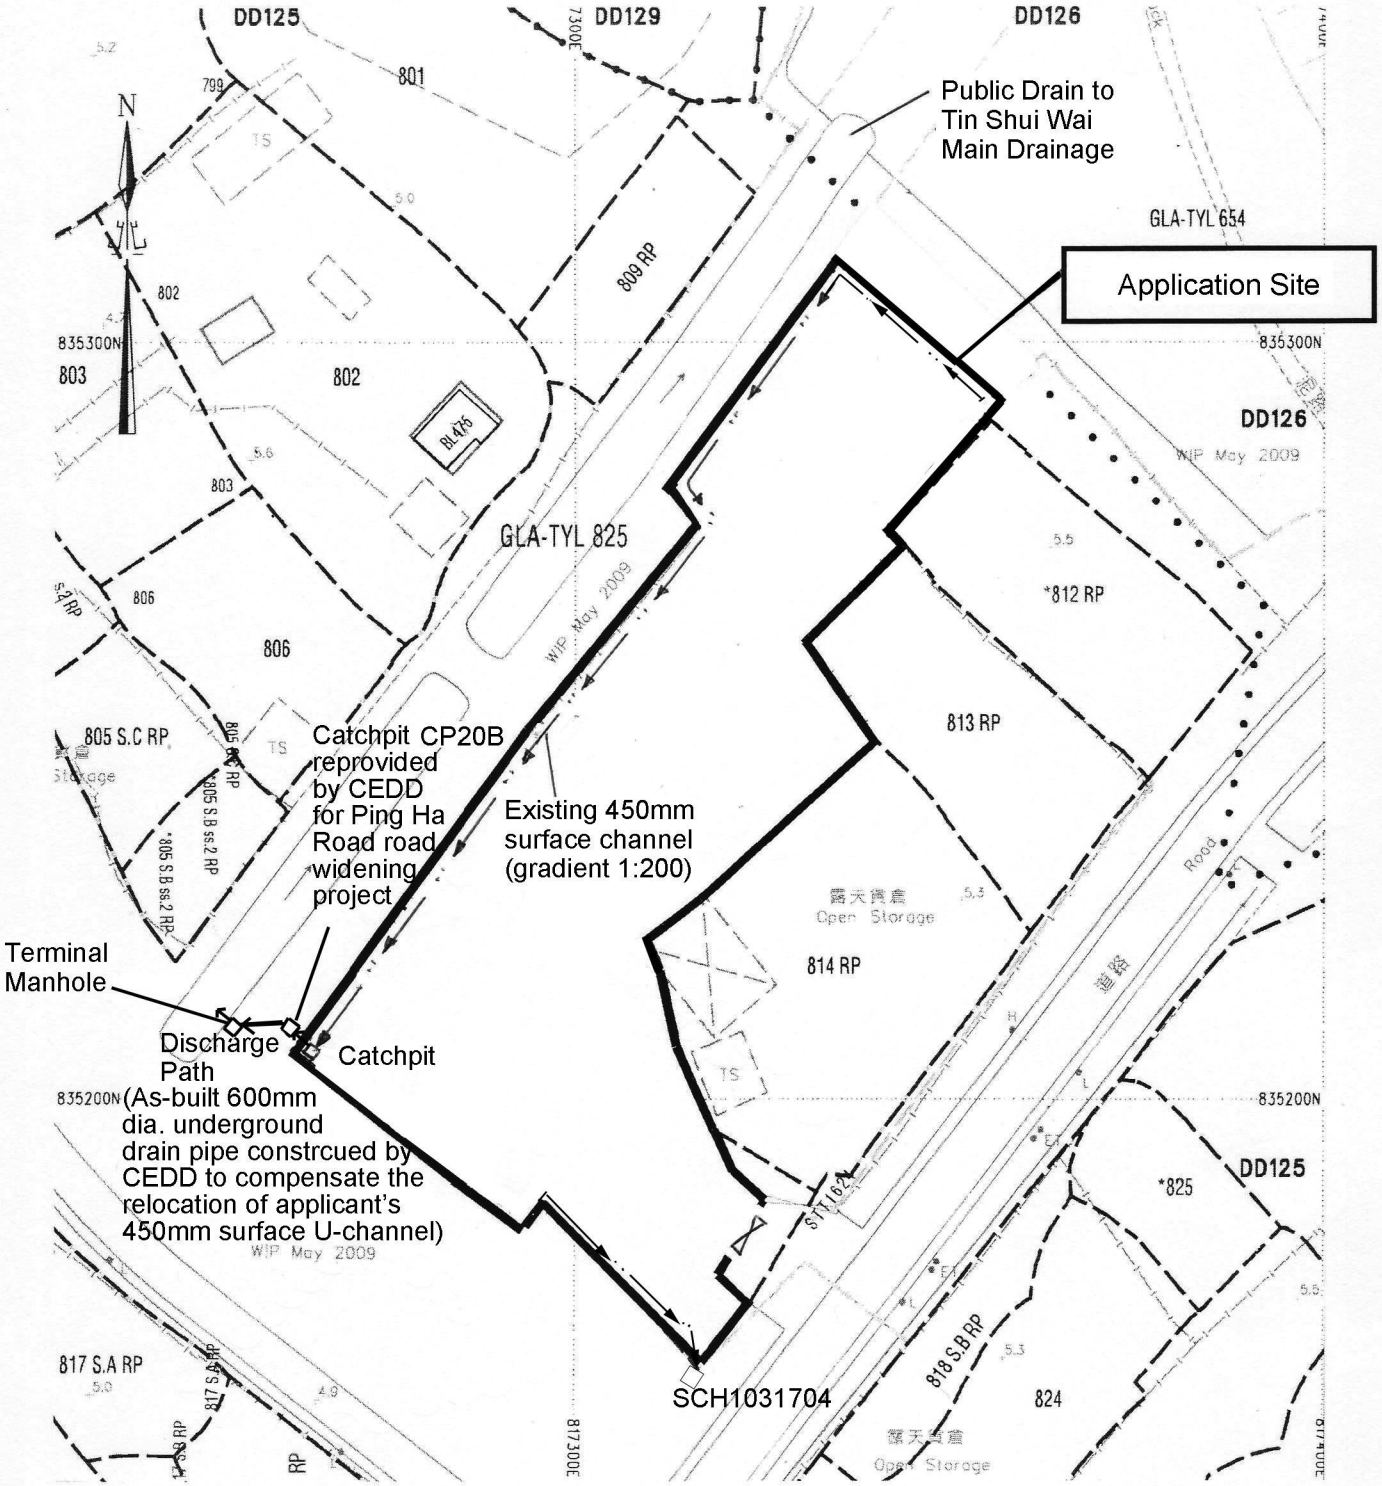

Project 項目名稱:	Drawing Title 圖目:	Remarks 備註:
Temporary Logistics Centre with Ancillary Site Office for a Period of 3 Years at Lots 805 S.B RP, 807 RP, 808 RP, 809 RP (Part), 813 RP (Part), 814 RP (Part), 815 (Part) & 816 S.B RP (Part) in D.D. 125 & Adjoining Government Land, Ha Tsuen, Yuen Long, N.T.	As-built Drainage Plan	
	Drawing No. 圖號: Figure 4	Scale 比例: 1:1000