

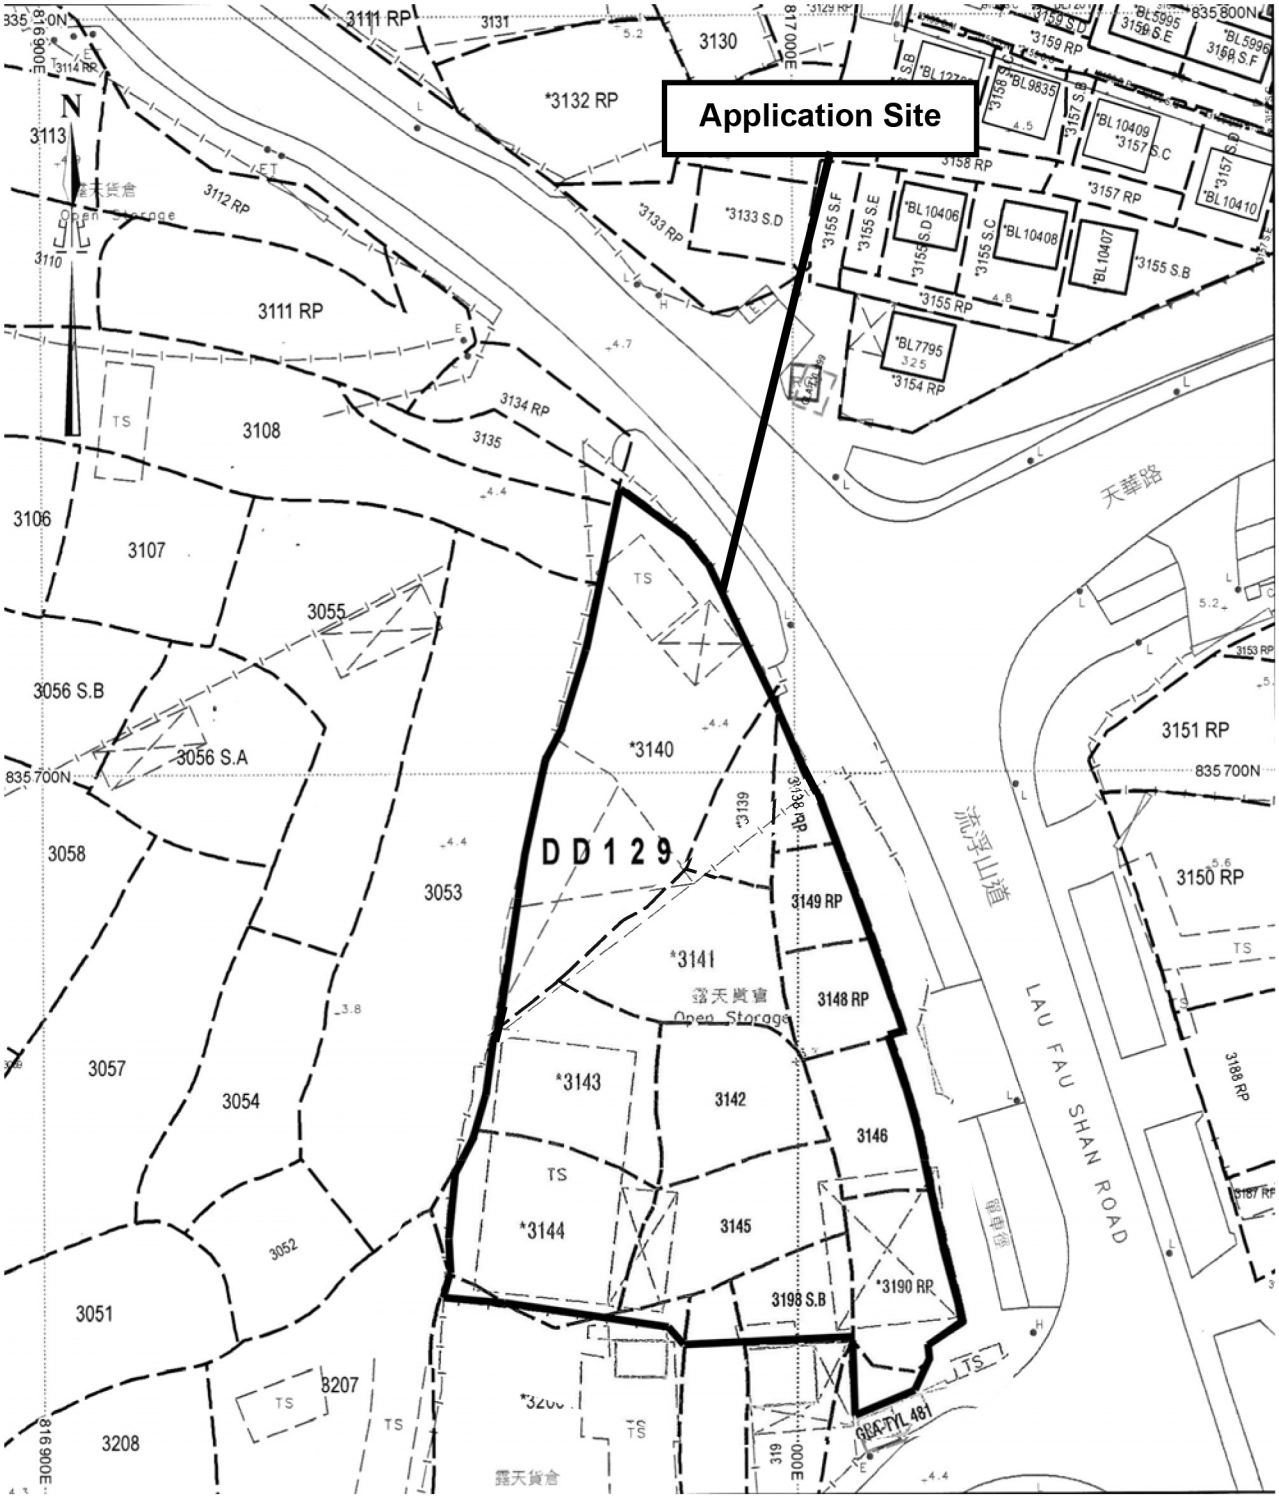



Project 項目名稱: Proposed Temporary Vehicle Service Centre for a Period of 3 Years at Lots 3138RP, 3139 (Part), 3140, 3141, 3142, 3143, 3144 (Part), 3145, 3146, 3148RP, 3149RP, 3190RP, 3198 S.B, 3200RP (Part) & Adjoining Government Land in D.D. 129, Ha Tsuen, Yuen Long, N.T.	Drawing Title 圖目: Site Plan Drawing No. 圖號: Figure 1	Remarks 備註: Scale 比例: 1:1000

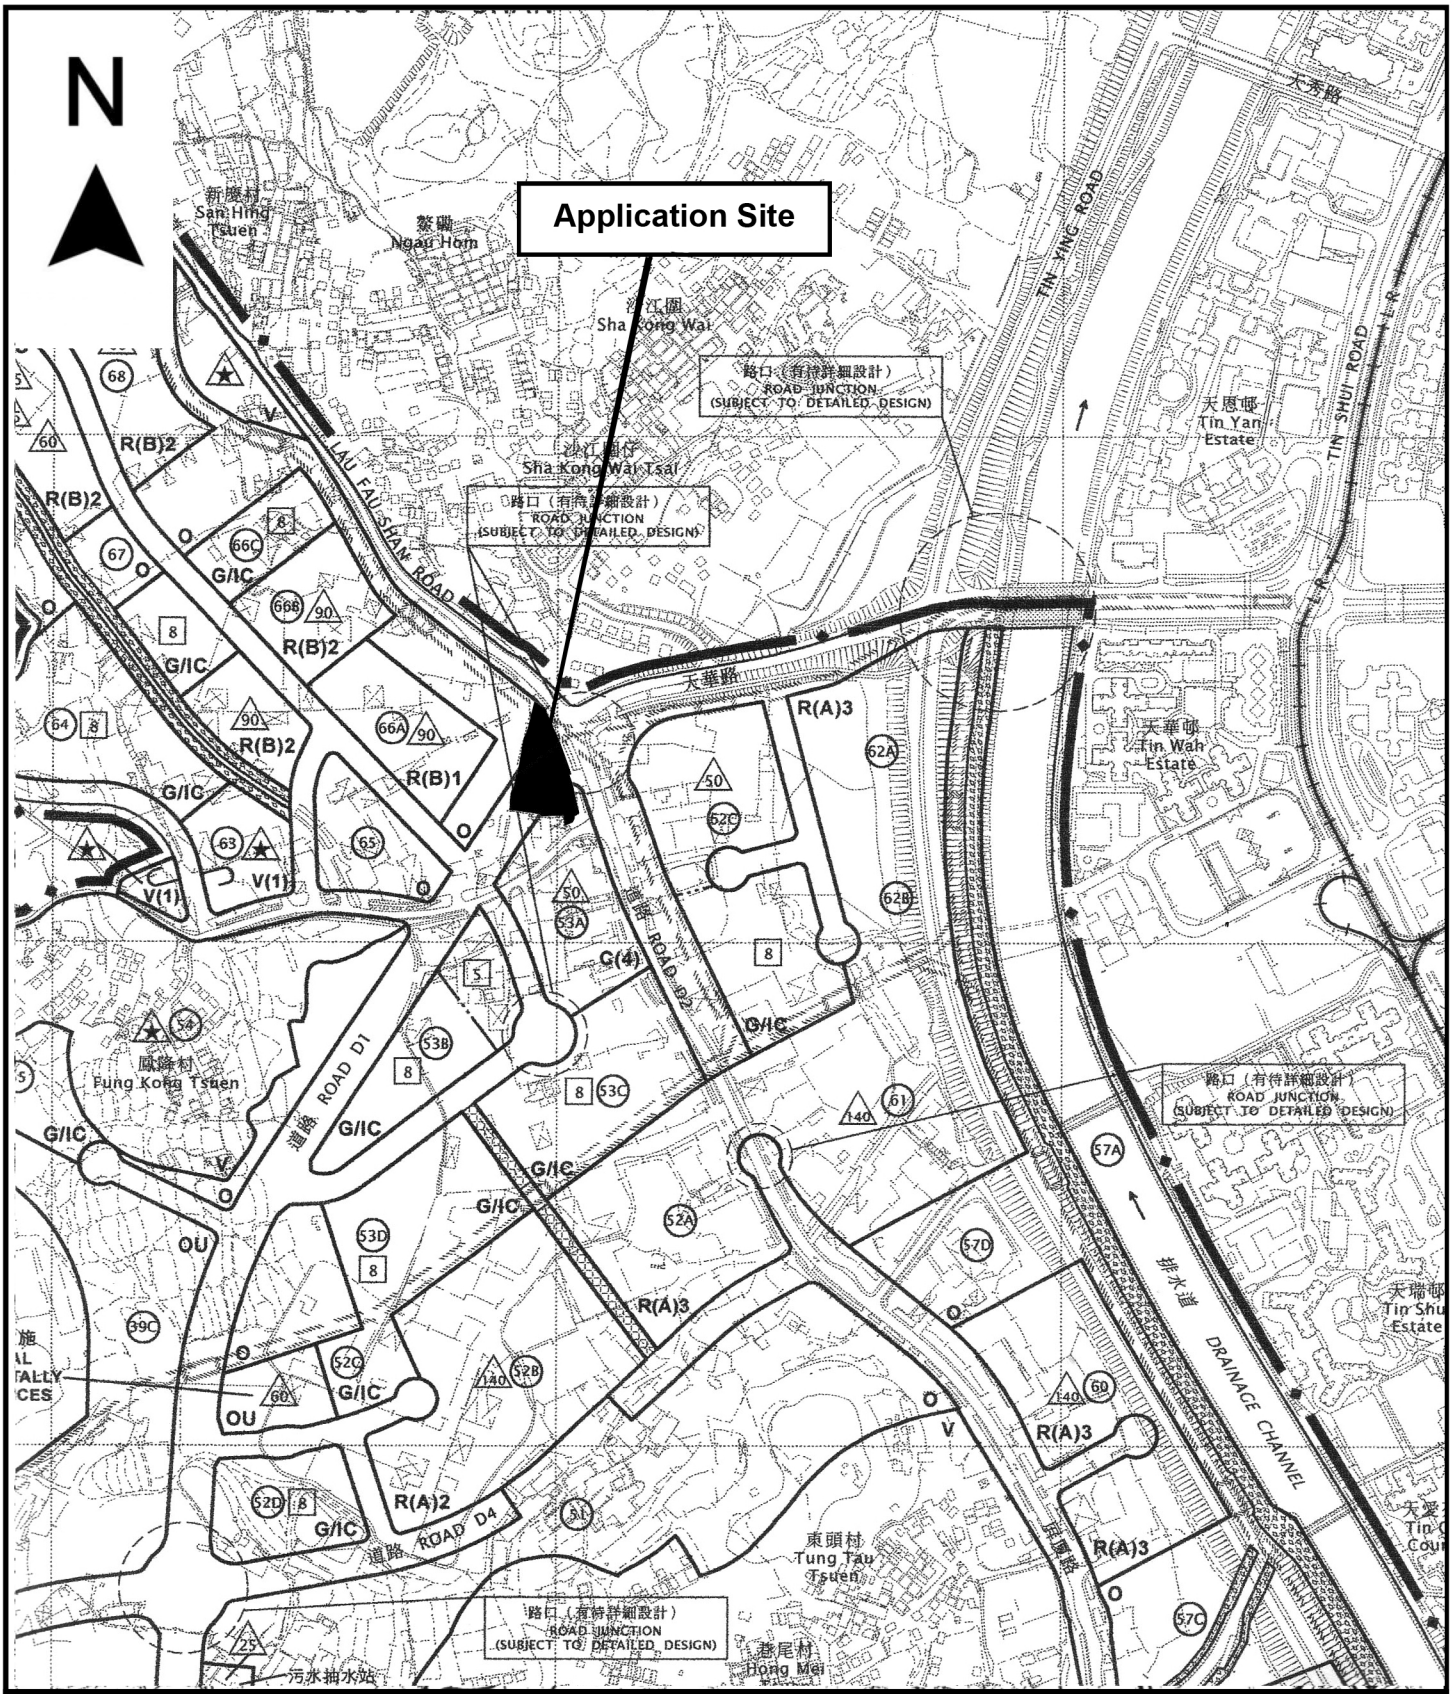

Project 項目名稱: Proposed Temporary Vehicle Service Centre for a Period of 3 Years at Lots 3138RP, 3139 (Part), 3140, 3141, 3142, 3143, 3144 (Part), 3145, 3146, 3148RP, 3149RP, 3190RP, 3198 S.B, 3200RP (Part) & Adjoining Government Land in D.D. 129, Ha Tsuen, Yuen Long, N.T.	Drawing Title 圖目: Location Plan Drawing No. 圖號: Figure 2	Remarks 備註: Scale 比例: 1:7500

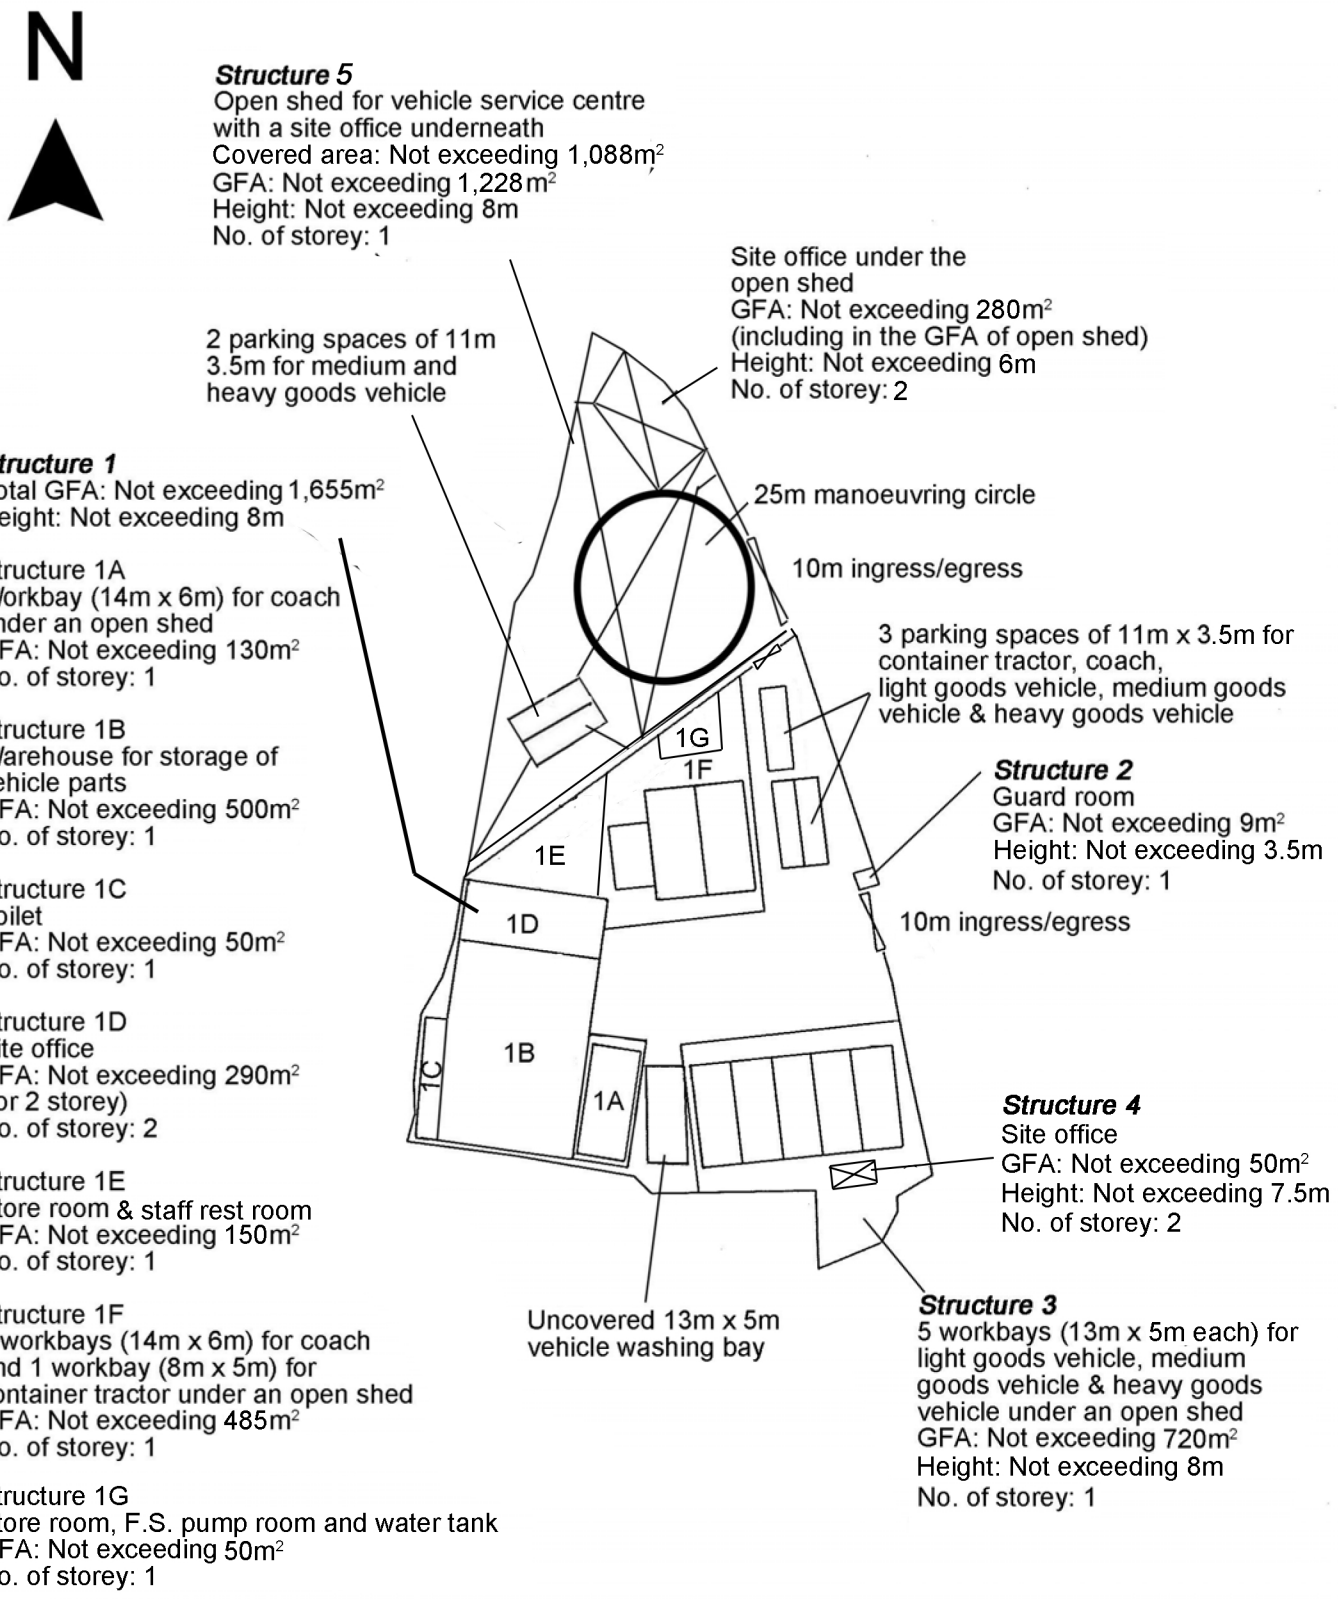

Project 項目名稱:	Drawing Title 圖目:	Remarks 備註:
Proposed Temporary Vehicle Service Centre for a Period of 3 Years at Lots 3138RP, 3139 (Part), 3140, 3141, 3142, 3143, 3144 (Part), 3145, 3146, 3148RP, 3149RP, 3190RP, 3198 S.B, 3200RP (Part) & Adjoining Government Land in D.D. 129, Ha Tsuen, Yuen Long, N.T.	Proposed Layout Plan	
	Drawing No. 圖號: Figure 3	Scale 比例: 1:1000

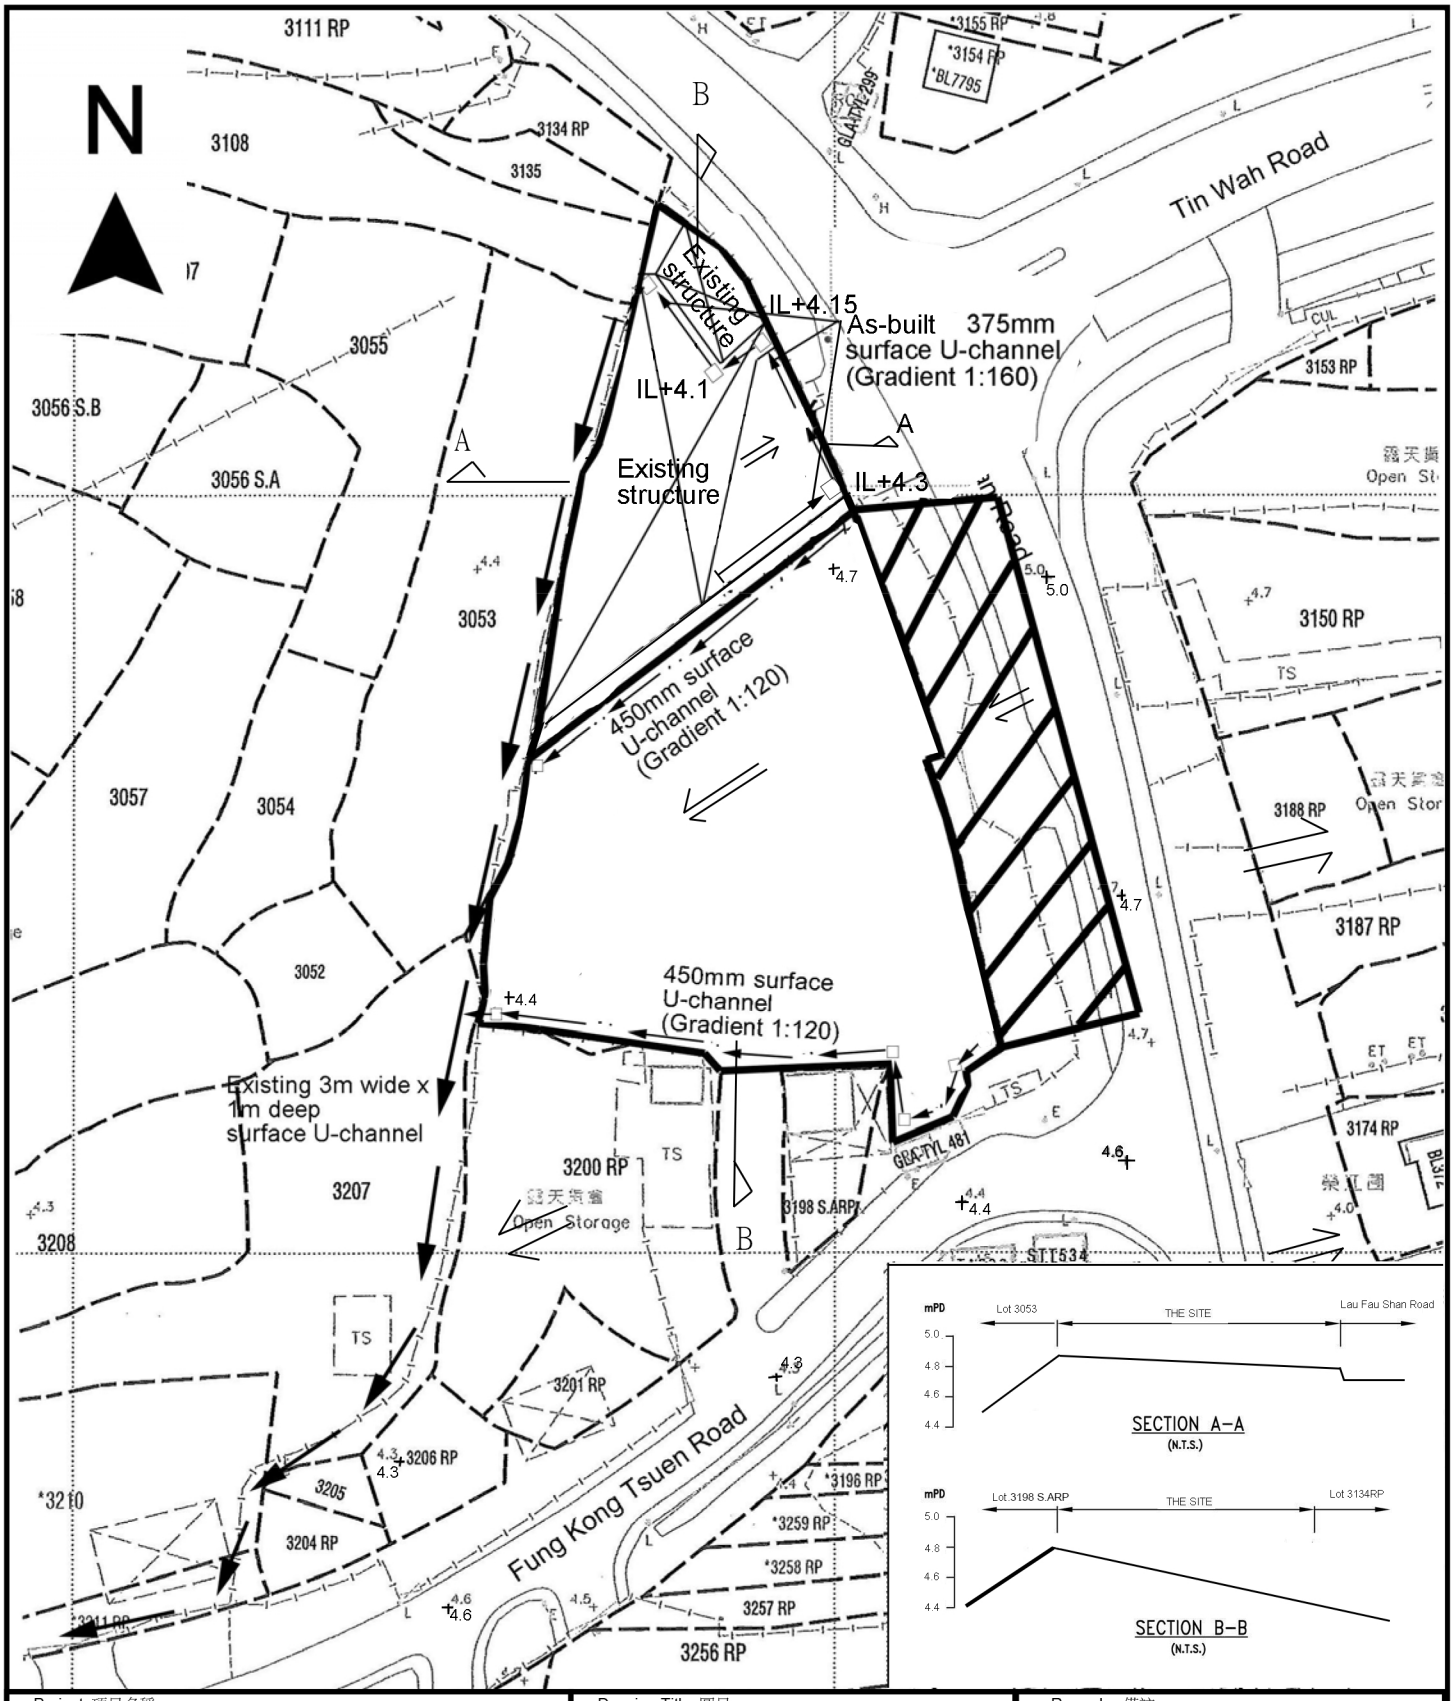

Project 項目名稱:

Proposed Temporary Vehicle Service Centre for a Period of 3 Years at Lots 3138RP, 3139 (Part), 3140, 3141, 3142, 3143, 3144 (Part), 3145, 3146, 3148RP, 3149RP, 3190RP, 3198 S.B, 3200RP (Part) & Adjoining Government Land in D.D. 129, Ha Tsuen, Yuen Long, N.T.

Drawing Title 圖目:

As-built Drainage Plan

Drawing No. 圖號:

Figure 4

Remarks 備註:

- □ Proposed catchpit
- ⇐ Flow of surface runoff
- $^{+}4.7$ Level (in mPD)
- External catchment

Scale 比例:

1:1000