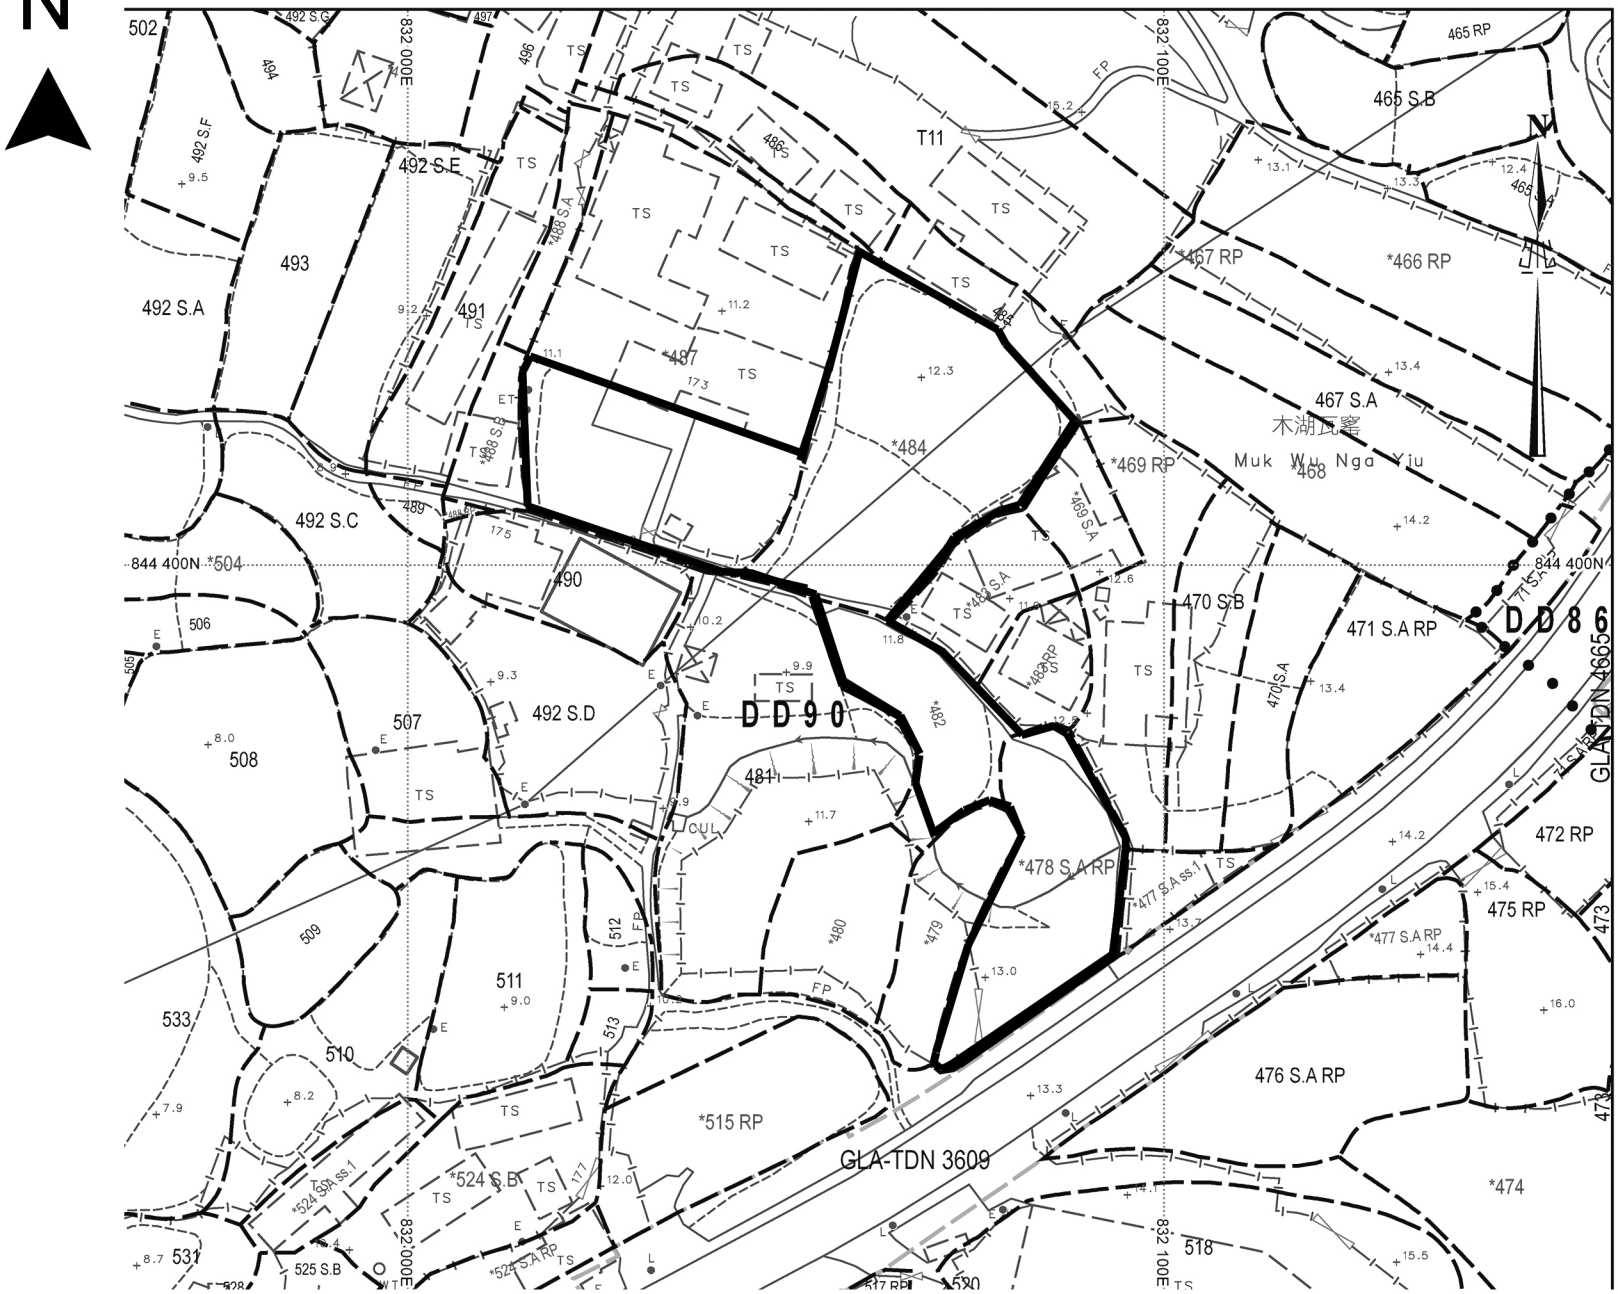


Drawing No.

Figure 1

Project

Temporary Warehouse for Storage of Food Provisions and Associated Filling of Land for a Period of 3 Years at Lots 478 S.A RP, 482 (Part), 484 & 487 RP (Part) in D.D.90, Lin Ma Hang Road, Ta Kwu Ling, N.T.

Drawing Title


Site Plan

Scale

1:1000

Remarks

N

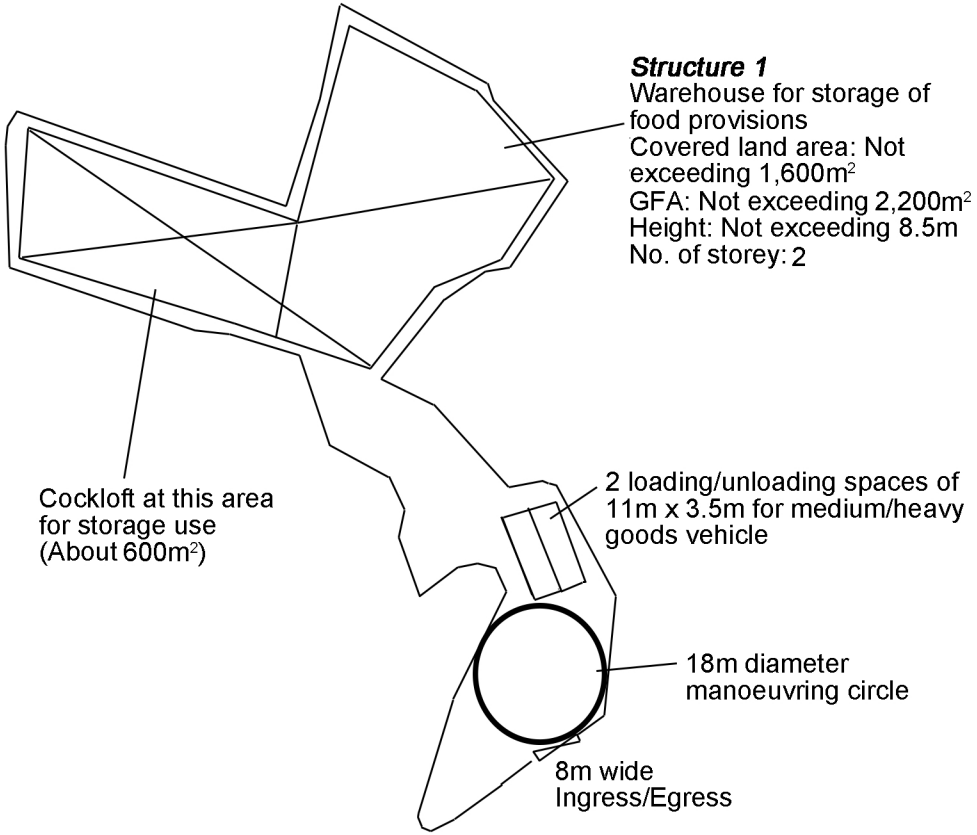

Drawing No.

Figure 2

Project

Temporary Warehouse for Storage of Food Provisions and Associated Filling of Land for a Period of 3 Years at Lots 478 S.A RP, 482 (Part), 484 & 487 RP (Part) in D.D.90, Lin Ma Hang Road, Ta Kwu Ling, N.T.

Drawing Title

Proposed Layout Plan

Scale

1:1000

Remarks

832020E 832040E 832060E 832080E 832100E

844440N 844420N 844400N

Lot 437

Lot 484

Lot 482

CP14
CL:10.94
IL:10.34

CP15
CL:10.90
IL:10.21

CP13
CL:11.57
IL:10.97

CP12
CL:11.81
IL:11.21

CP11
CL:12.46
IL:11.31

CP
CL:11.54
IL:10.94

CP16
CL:12.31
IL:11.06

CP10
CL:12.29
IL:11.69

CP9
CL:12.25
IL:11.65

10.32
10.25
10.21
10.37
10.46
10.66
10.56
10.75
10.70
11.15
11.39
11.53
11.74
11.90
11.83
11.60
11.64
11.61
11.61

U-Channel W: 0.525m

To existing drainage system

Notes:

1. All levels are in meters above P.D.
2. Grid lines are in H.K. 1980 Metric Grid.

Legend:

- 329.50 + Spot Level
- T1 Tree
- MH Manhole
- LP Lamp Post
- TP Telecom Post
- EP Electric Post
- SP Sign Pole
- Railing / Fence
- Wall
- Top / Toe Artificial Slope
- Slope Top
- Slope Toe
- Steps
- 0.30 U-C U-channel
- 0.30 C-C Covered channel
- 0.30 S-C Step channel
- Pipe Pipe Line
- Canopy
- TS Temporary Structure
- Building
- 75 / 70 Contour Line
- Gully
- Gate

Abbreviation:

BN	Bench
CA	Canopy
CO	Column
CP	Catch Pit
FB	Flower Bed
FP	Footpath
PL	Platform
SI	Steps

Figure 3A
As-built Drainage Plan
(Part 1)

Drawing Title:

Topographical Survey Plan

Lots no. 478 S.A RP, 482, 484 & 487

in D.D.90, North

(1 of 2)

Drawing No.: TOPO/484/DD90 Rev 00

Survey Date: 21 May 2026


Scale: Not to scale

C K Lau Surveyors Limited

Certified by :
LAU CHI KWONG
MSc, FHKIS, FRICS, RPS(LS)(PFM)
AUTHORIZED LAND SURVEYOR

Signature :

Date: 27 May 2026

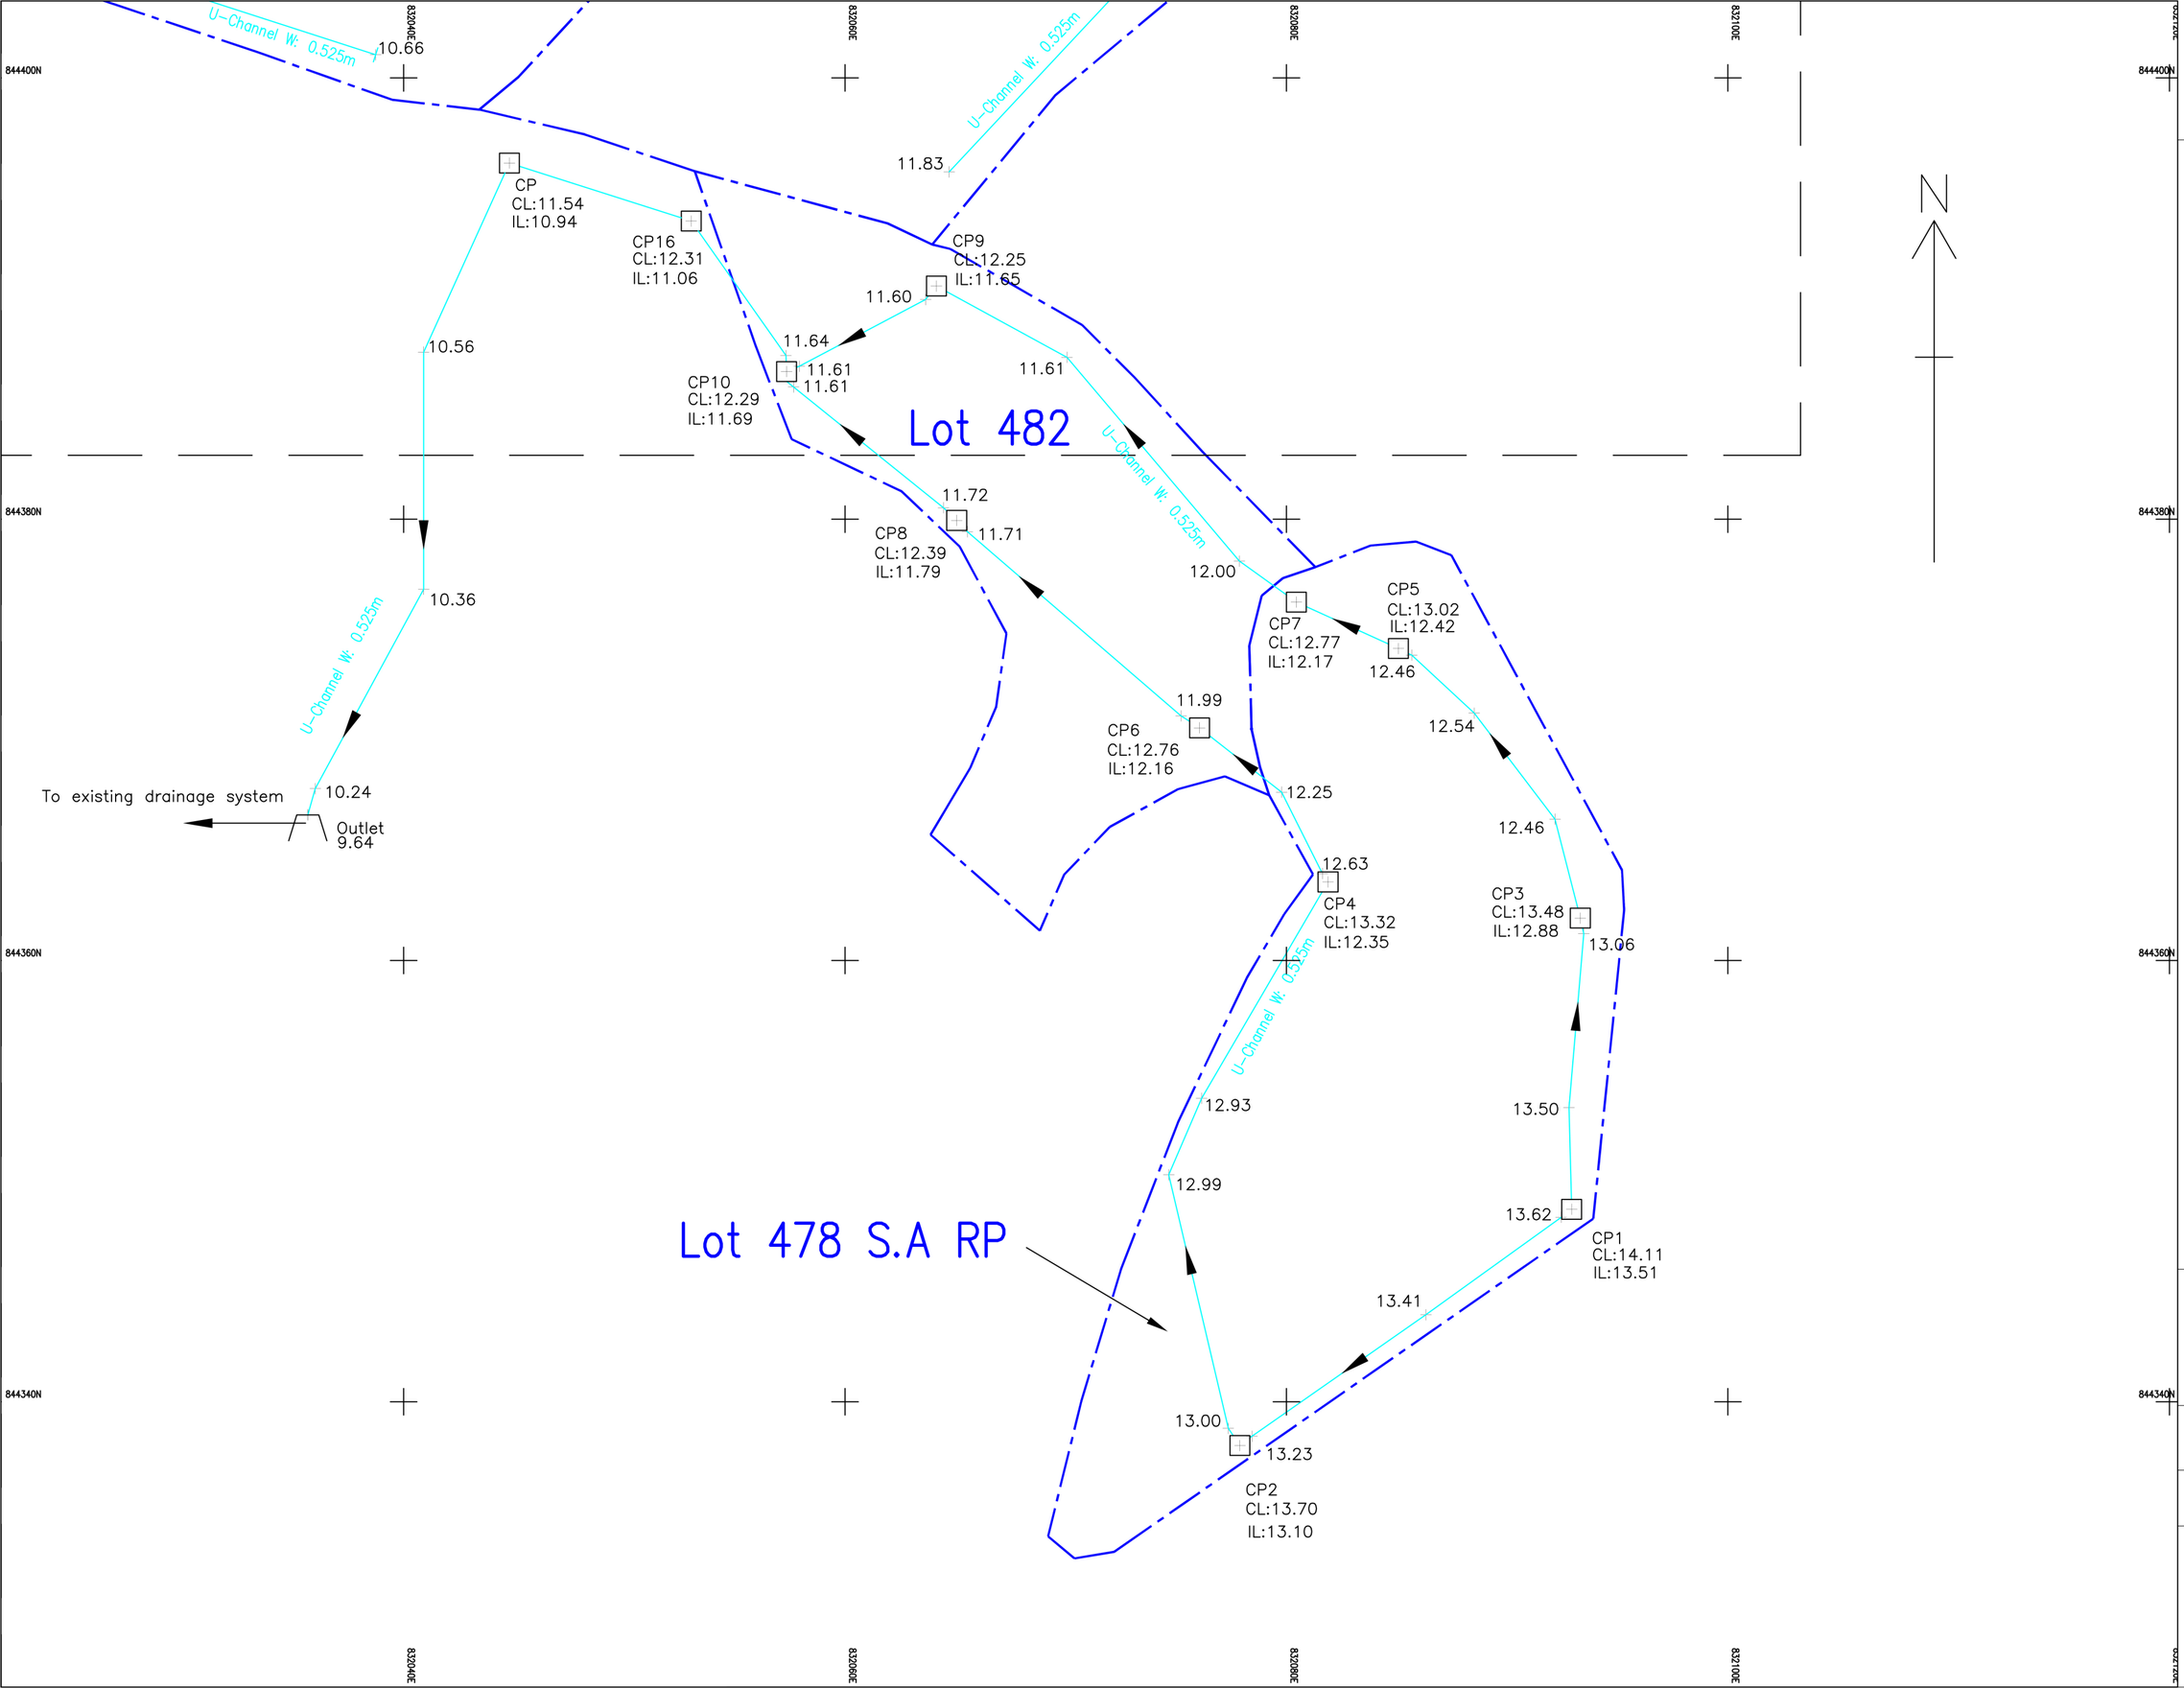

Notes:

1. All levels are in meters above P.D.
2. Grid lines are in H.K. 1980 Metric Grid.

Legend:

- Spot Level
- Tree
- Manhole
- Lamp Post
- Telecom Post
- Electric Post
- Sign Pole
- Railing / Fence
- Wall
- Artificial Slope
- Slope Top
- Slope Toe
- Steps
- U-channel
- Covered channel
- Step channel
- Pipe Line
- Canopy
- Temporary Structure
- Building
- Contour Line
- Gully
- Gate

Abbreviation:

BN	Bench
CA	Canopy
CO	Column
CP	Catch Pit
FB	Flower Bed
FP	Footpath
PL	Platform
SI	Steps

Figure 3B
As-built Drainage Plan (Part 2)

Drawing Title:

Topographical Survey Plan

Lots no. 478 S.A RP, 482, 484 & 487 in D.D.90, North

(2 of 2)

Drawing No.: TOPO/484/DD90 Rev 00


Survey Date: 21 May 2026

Scale: Not to scale

C K Lau Surveyors Limited

Certified by :
LAU CHI KWONG
MSc, FHKIS, FRICS, RPS(LS)(PFM)
AUTHORIZED LAND SURVEYOR
Signature :

Date: 27 May 2026

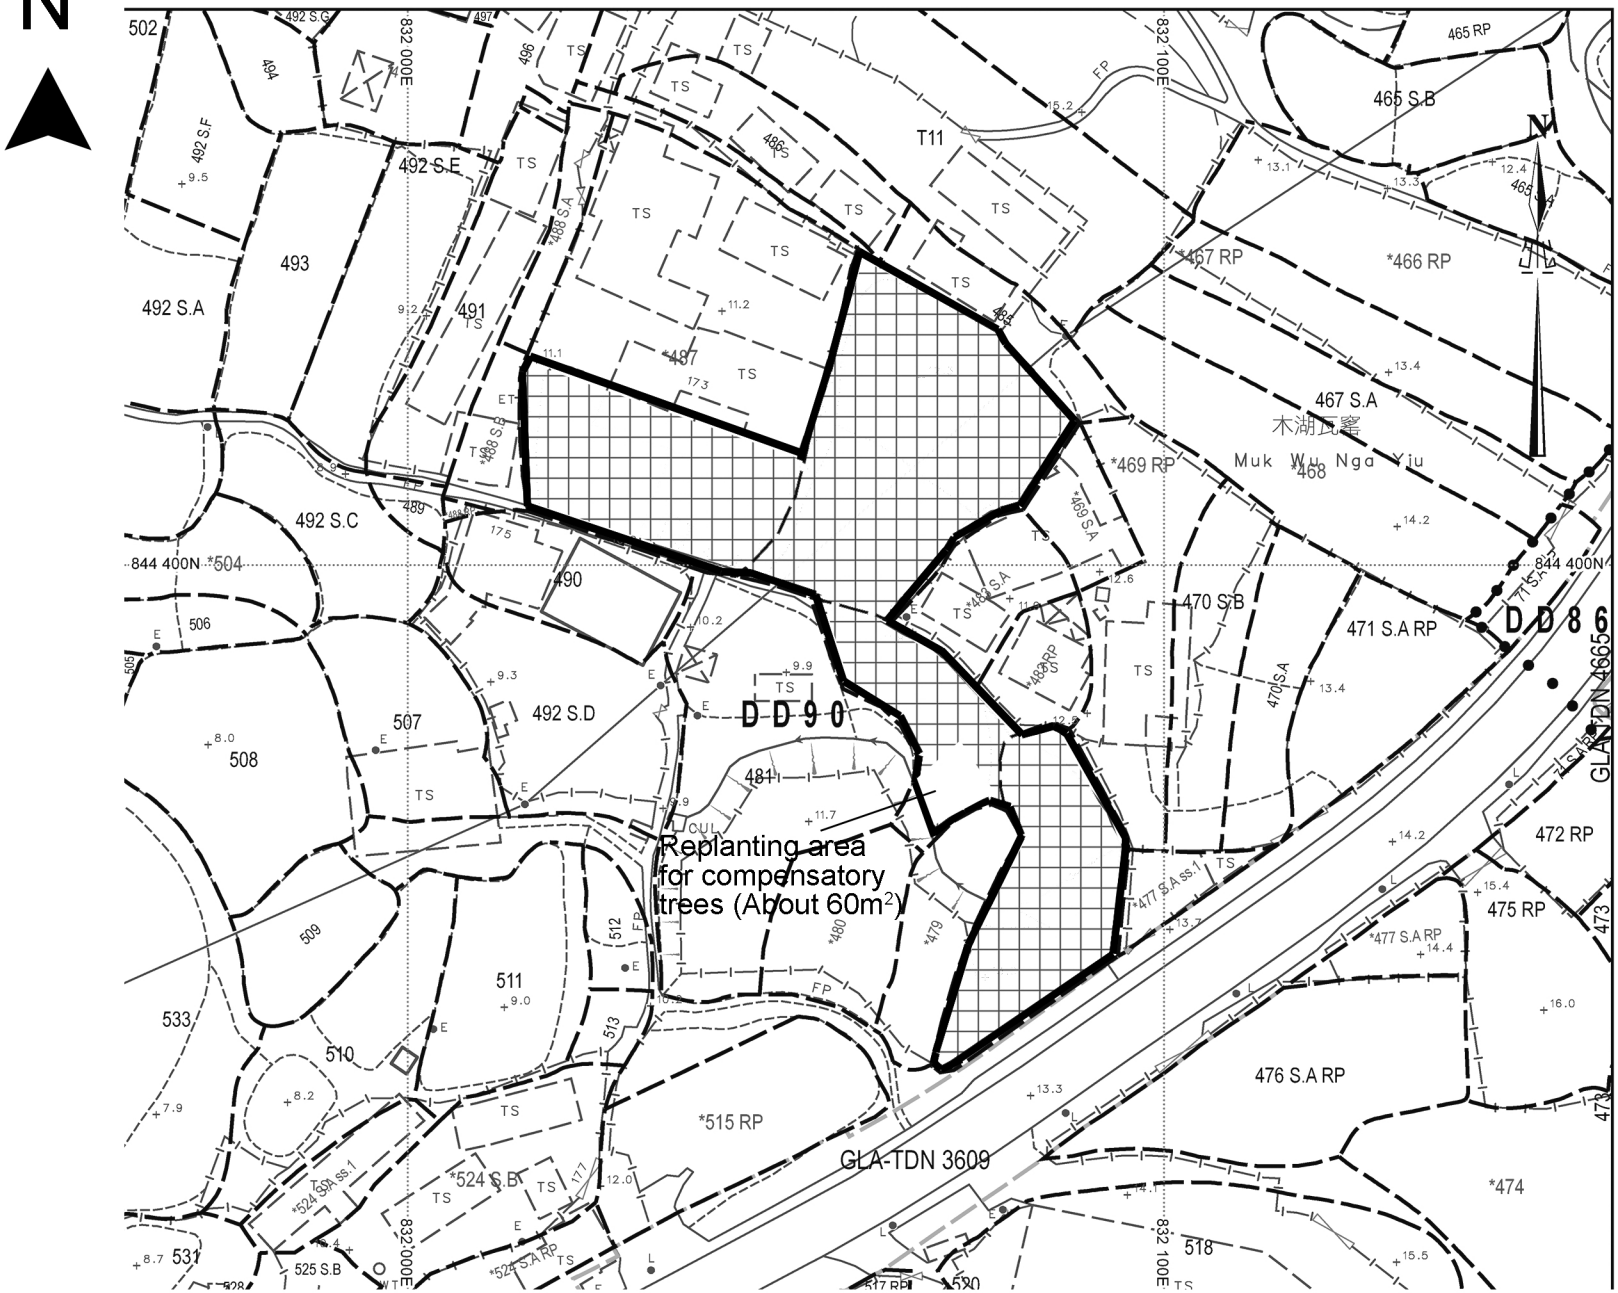

Drawing No.

Figure 4

Project

Temporary Warehouse for Storage of Food Provisions and Associated Filling of Land for a Period of 3 Years at Lots 478 S.A RP, 482 (Part), 484 & 487 RP (Part) in D.D.90, Lin Ma Hang Road, Ta Kwu Ling, N.T.

Drawing Title

Land Filling Plan

Scale

1:1000

Remarks

Regularization of filling of 0.2m thick concrete