


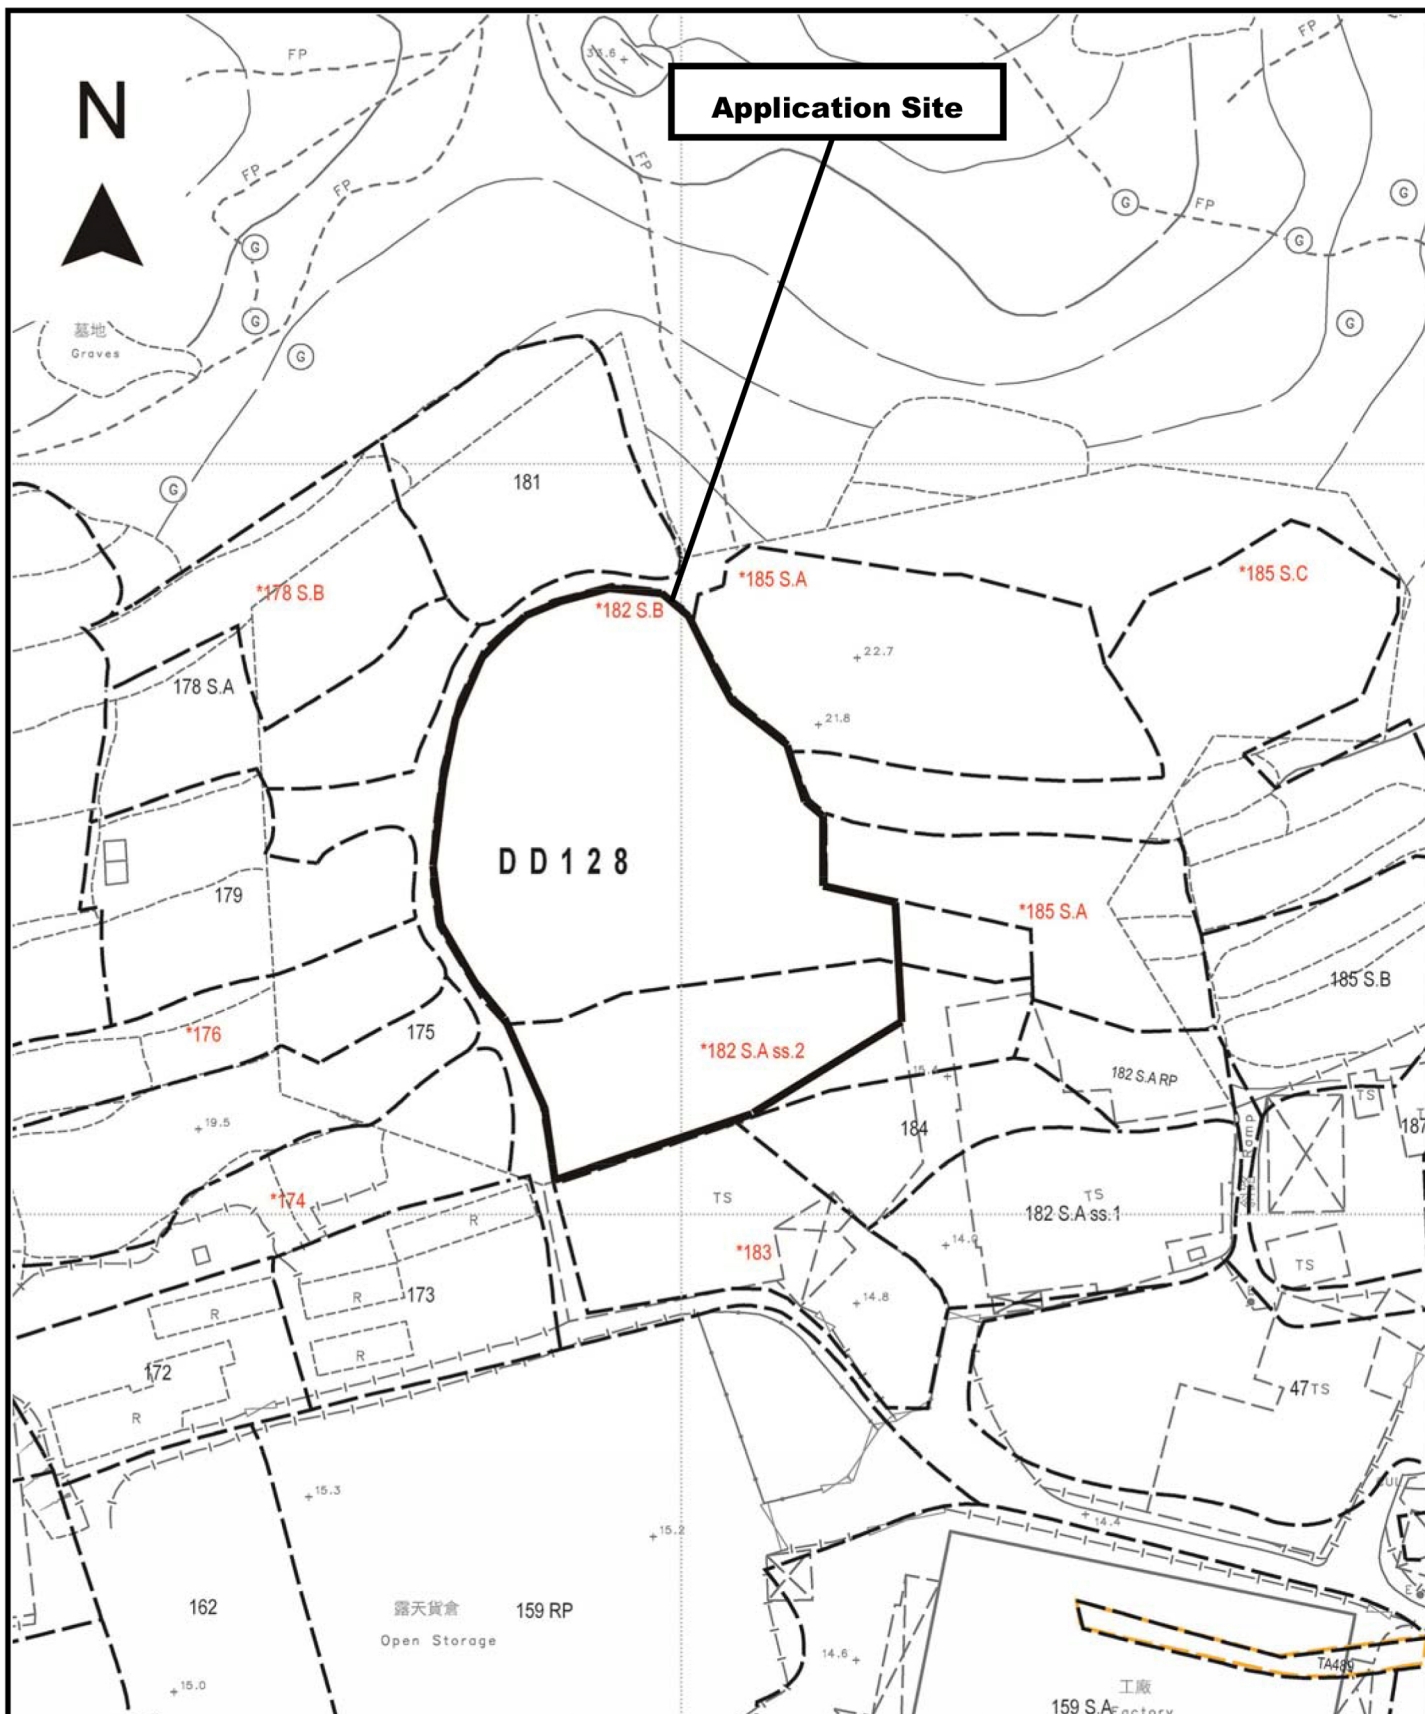

Project 項目名稱:

Proposed Temporary Open Storage of Construction Materials and Metal for a Period of 3 Years at Lots 182 S.A ss.2 (Part) & 182 S.B (Part) in D.D. 128, Ha Tsuen, Yuen Long, N.T.

Drawing Title 圖目:

Application Site


Remarks 備註:

Drawing No. 圖號:

Figure 1

Scale 比例:

1:1000

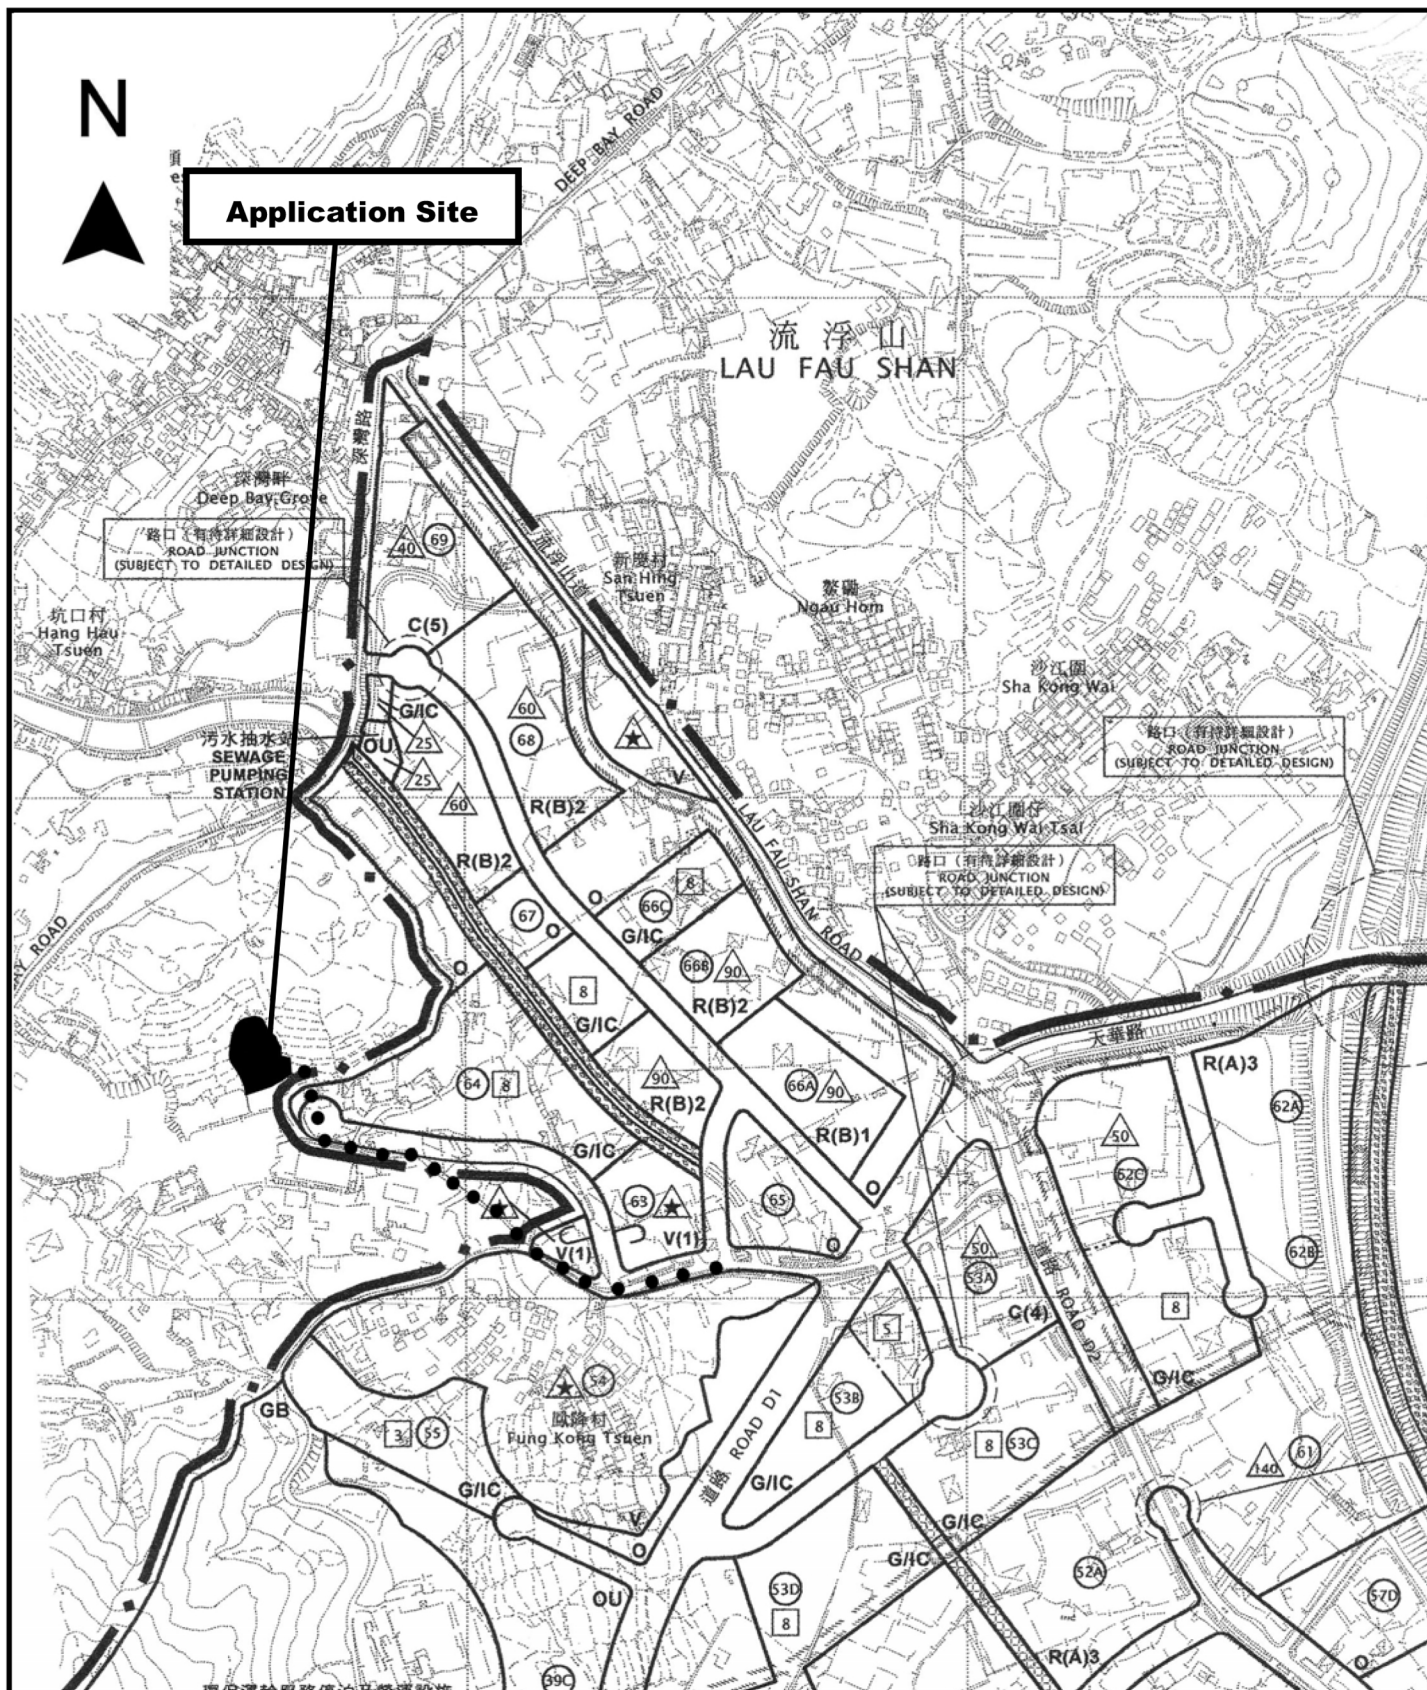

Project 項目名稱:

Proposed Temporary Open Storage of Construction Materials and Metal for a Period of 3 Years at Lots 182 S.A ss.2 (Part) & 182 S.B (Part) in D.D. 128, Ha Tsuen, Yuen Long, N.T.

Drawing Title 圖目:

Location Plan

Drawing No. 圖號:


Figure 2

Remarks 備註:

●●● Vehicular Access Leading from Fung Kong Tsuen Road

Scale 比例:

1:7500

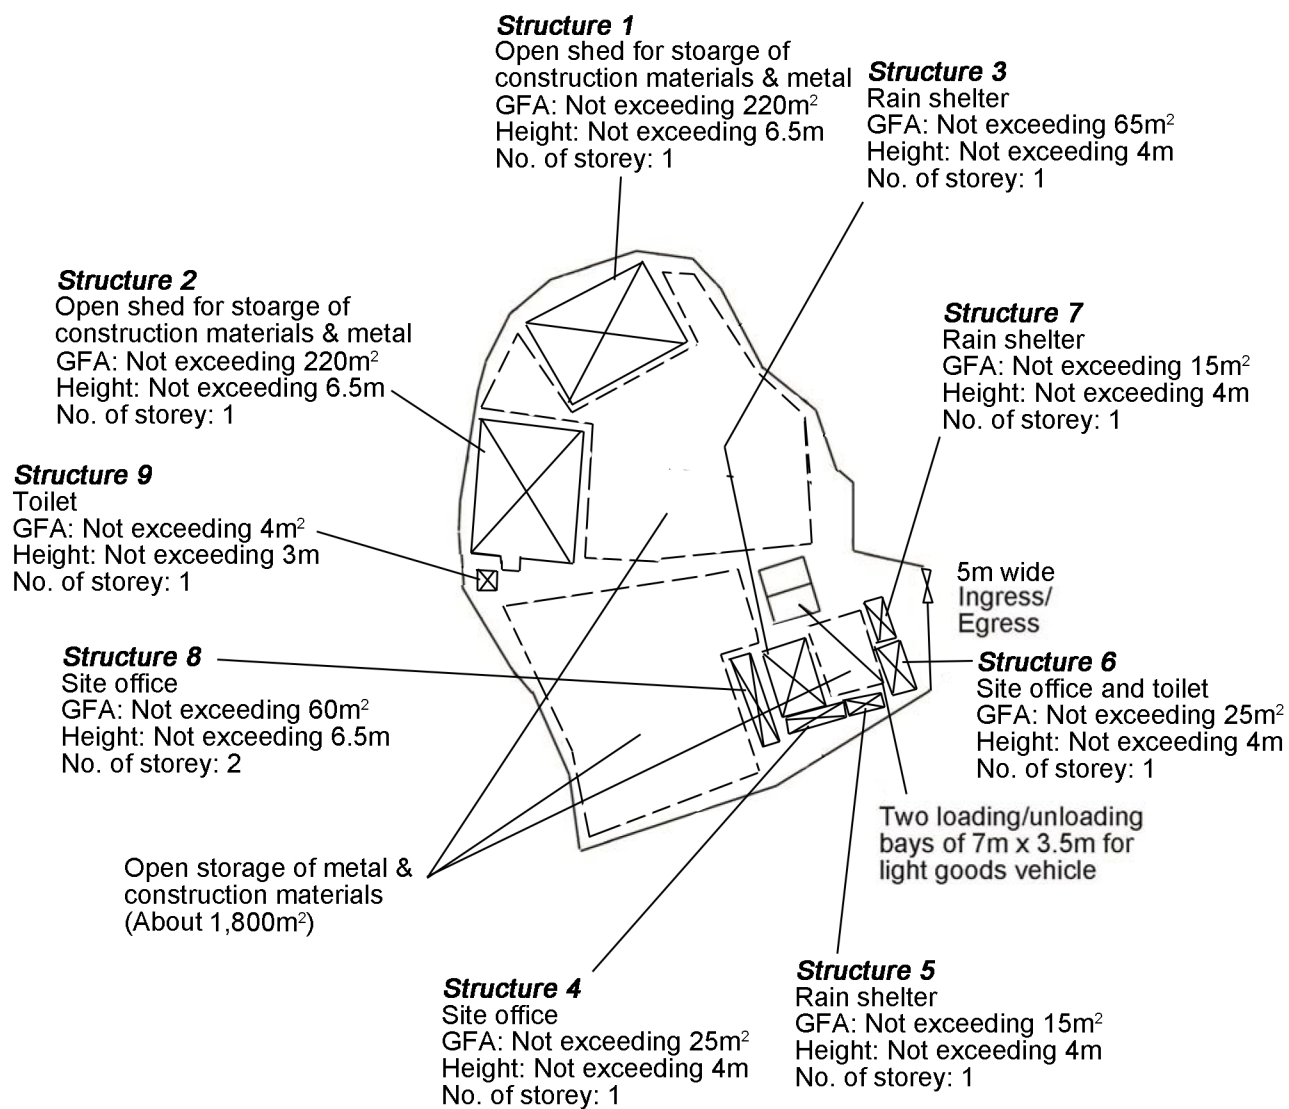

Project 項目名稱:

Proposed Temporary Open Storage of Construction Materials and Metal for a Period of 3 Years at Lots 182 S.A ss.2 (Part) & 182 S.B (Part) in D.D. 128, Ha Tsuen, Yuen Long, N.T.

Drawing Title 圖目:

Proposed Layout Plan

Remarks 備註:


Drawing No. 圖號:

Figure 3

Scale 比例:

1:1000



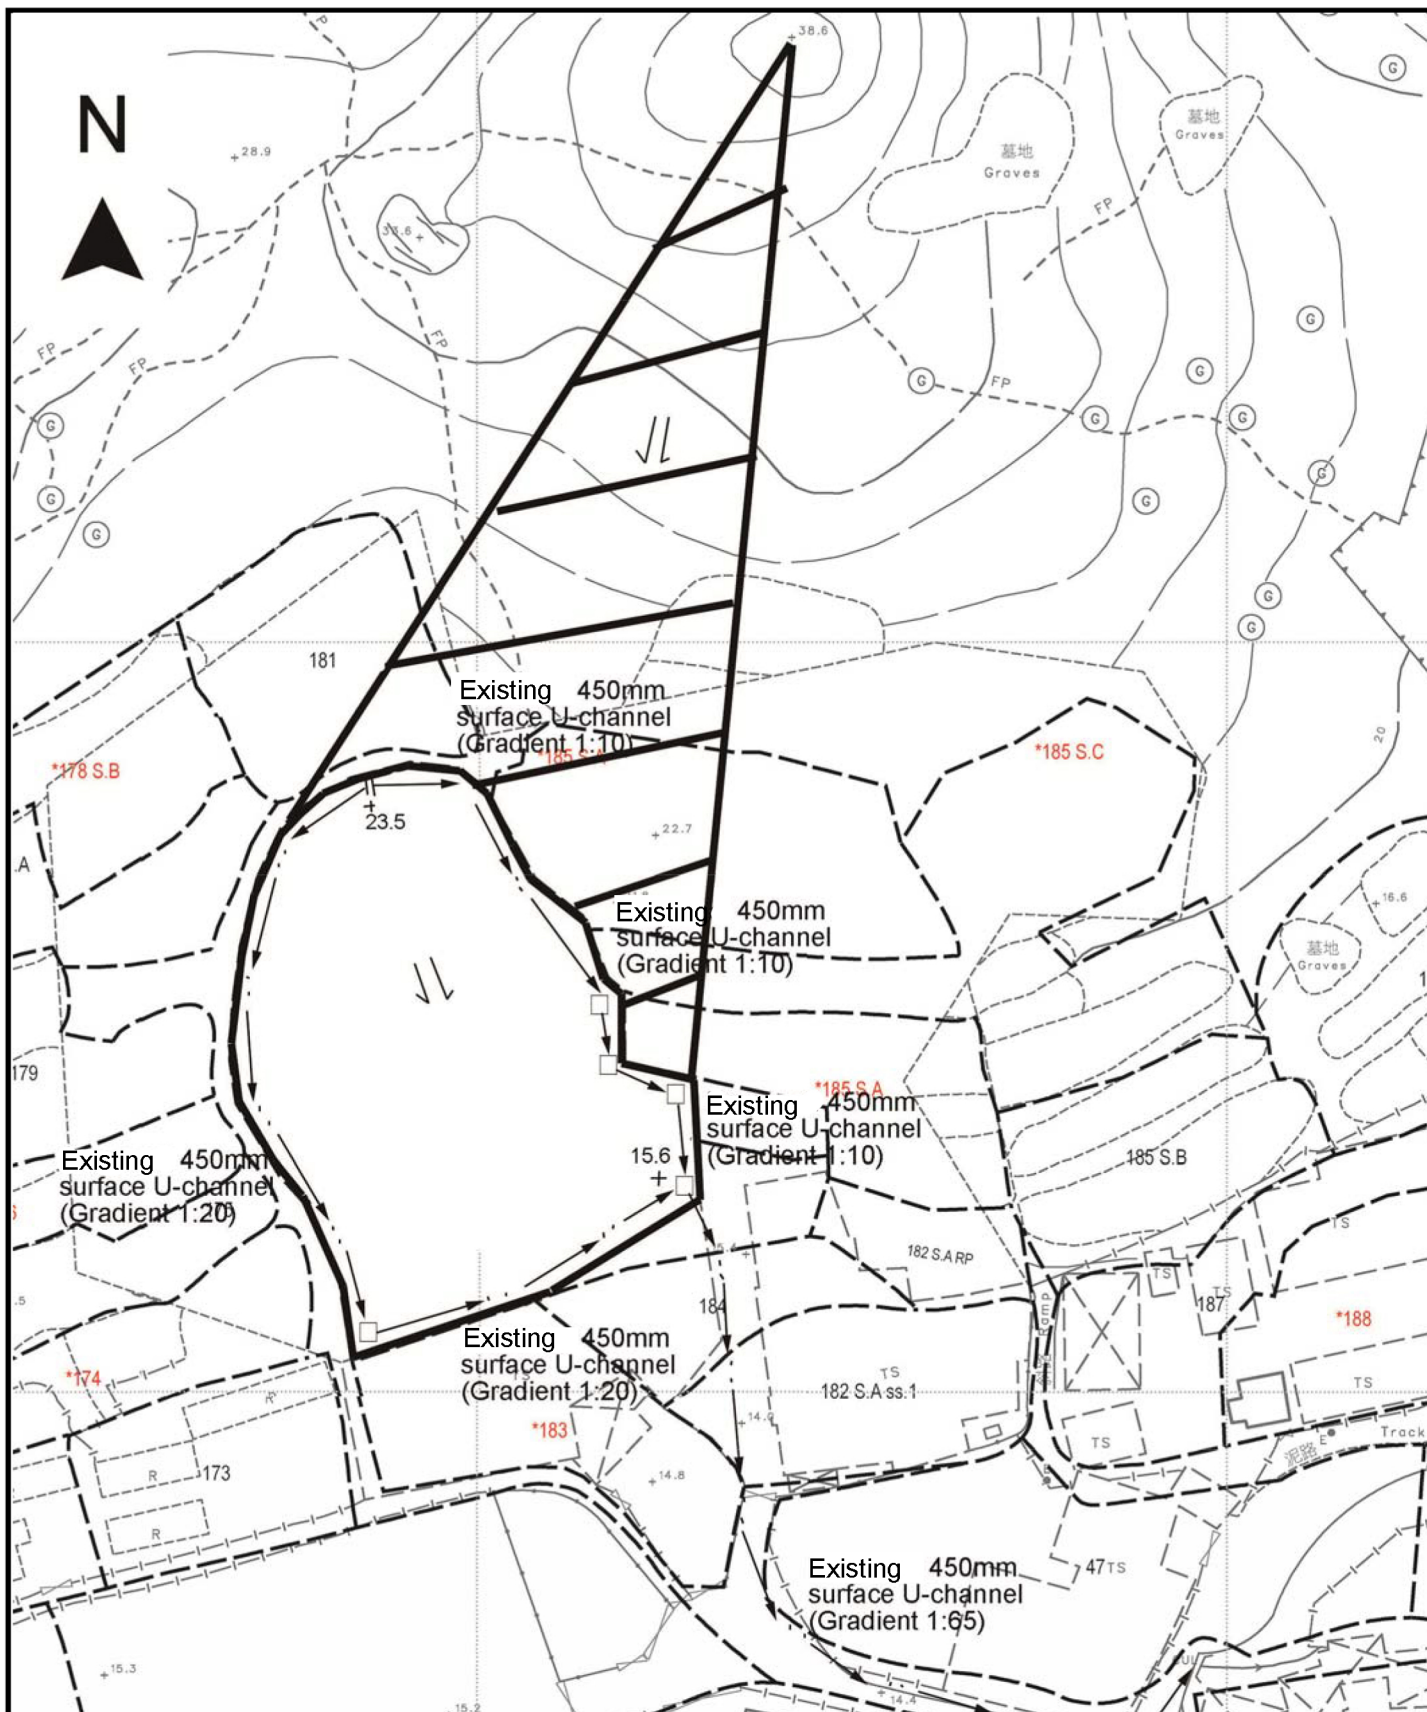

Project 項目名稱:

Proposed Temporary Open Storage of Construction Materials and Metal for a Period of 3 Years at Lots 182 S.A ss.2 (Part) & 182 S.B (Part) in D.D. 128, Ha Tsuen, Yuen Long, N.T.

Drawing Title 圖目:

As-built Drainage Plan

Drawing No. 圖號:

Figure 4

Remarks 備註:

+15.6 Level (in mPD)

□ Proposed Catchpit

⇐ Flow of Surface Runoff

▨ External catchment

Scale 比例:

1:1000