


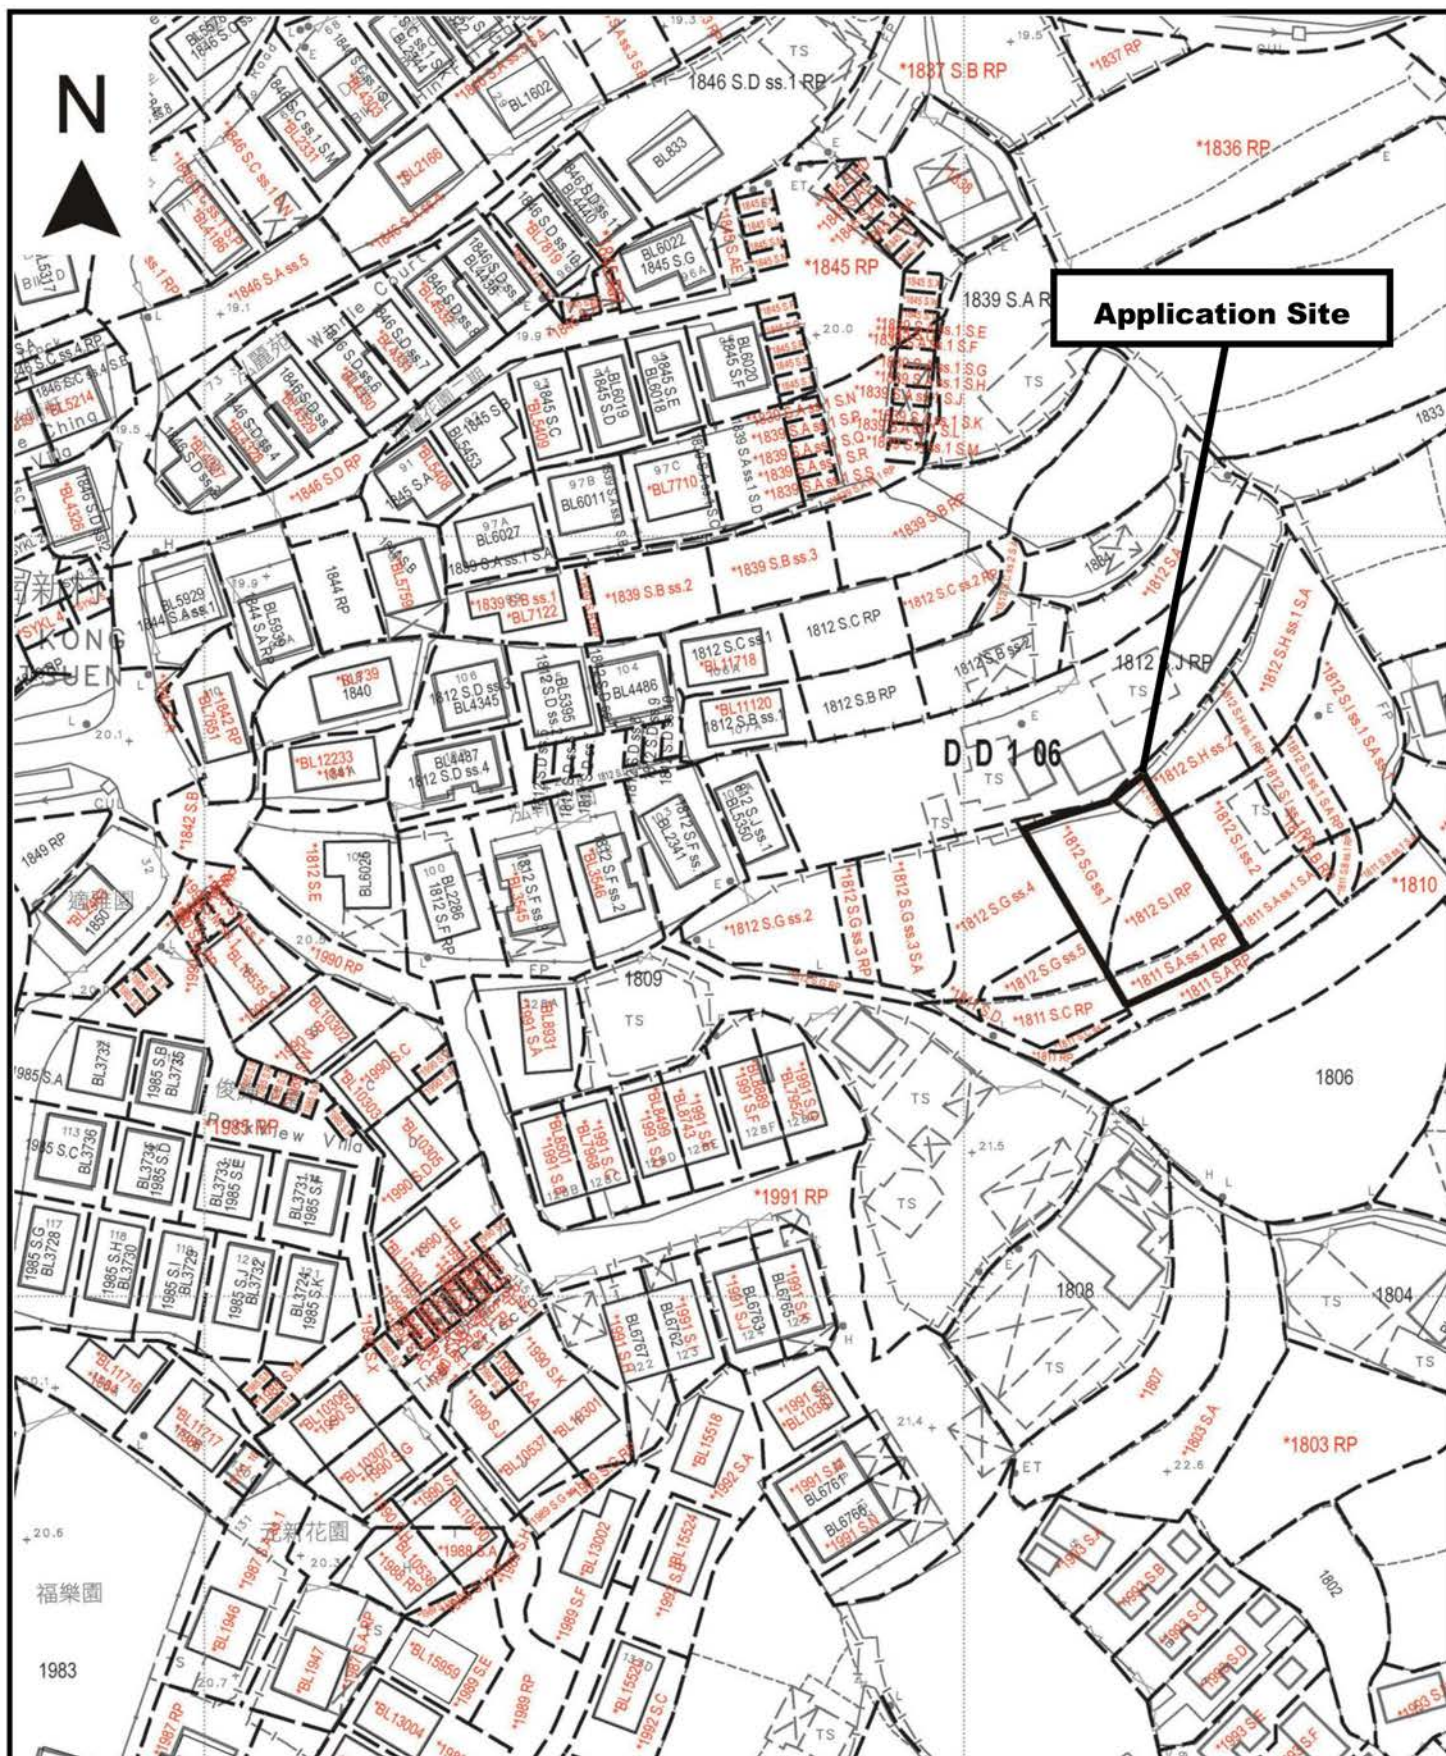

Project 項目名稱:

Renewal of Planning Approval for Temporary Animal Boarding Establishment (Cattery) for a Period of 3 Years and Filling of Land at Lots 1811 S.A ss.1 RP, 1812 S.G ss.1 (Part), 1812 S.H RP (Part) & 1812 S.I RP in D.D.106, Kam Tin, Yuen Long, N.T.

Drawing Title 圖目:

Application Site


Drawing No. 圖號:

Figure 1

Remarks 備註:

Scale 比例:

1:1000

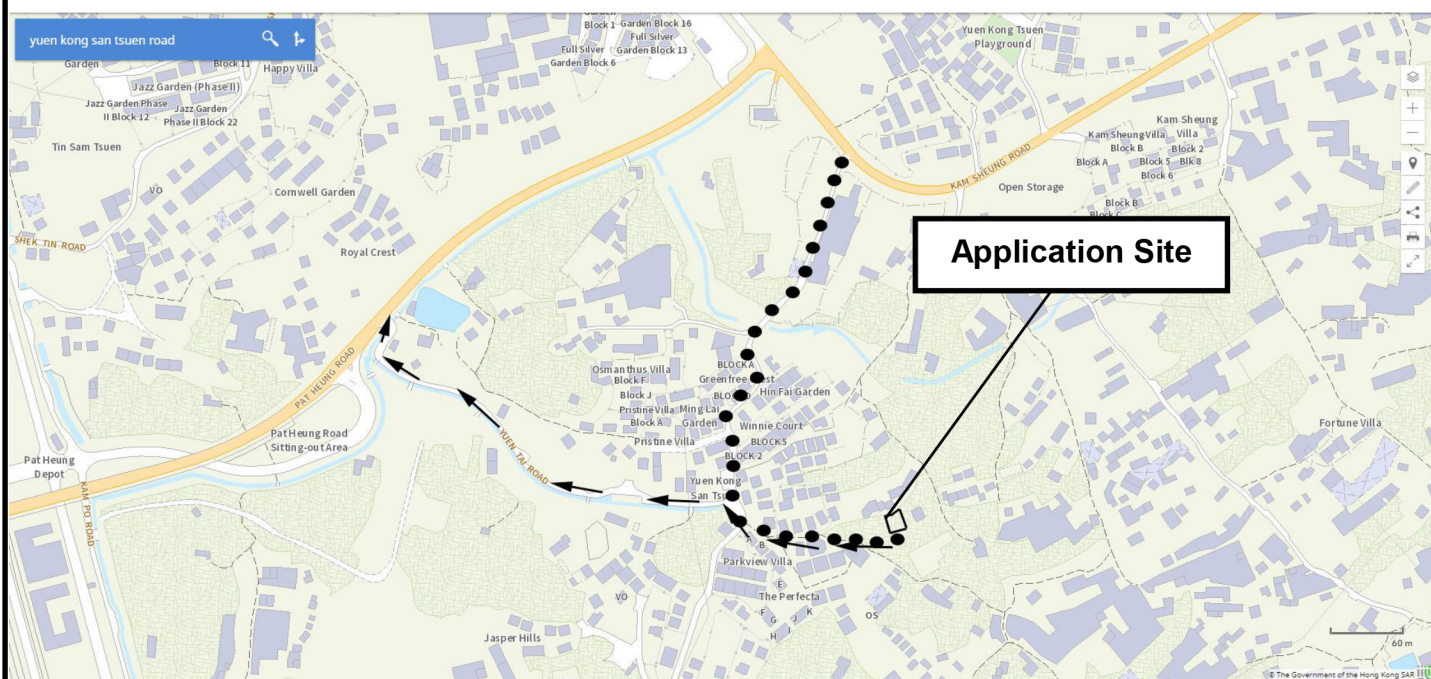




Structure 2

Site office (About 20m²)
and toilet (About 4m²)
GFA: Not exceeding 24m²
Height: Not exceeding 4m
No. of storey : 1

Structure 1

Cattery
GFA: Not exceeding 108m²
Height: Not exceeding 4m
No. of storey : 1

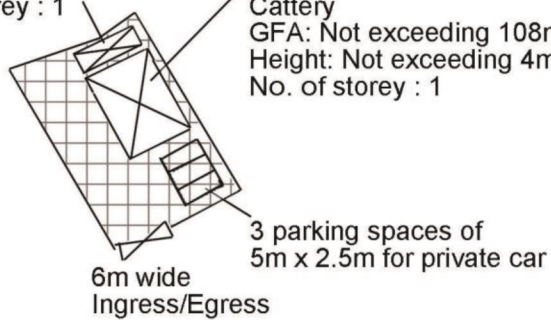

Project 項目名稱:

Renewal of Planning Approval for Temporary Animal Boarding Establishment (Cattery) for a Period of 3 Years and Filling of Land at Lots 1811 S.A ss.1 RP, 1812 S.G ss.1 (Part), 1812 S.H RP (Part) & 1812 S.I RP in D.D.106, Kam Tin, Yuen Long, N.T.

Drawing Title 圖目:

Proposed Layout Plan

Drawing No. 圖號:


Figure 3

Remarks 備註:

 Proposed land filling area (to be paved by 200mm thick concrete)

Scale 比例:

1:1000

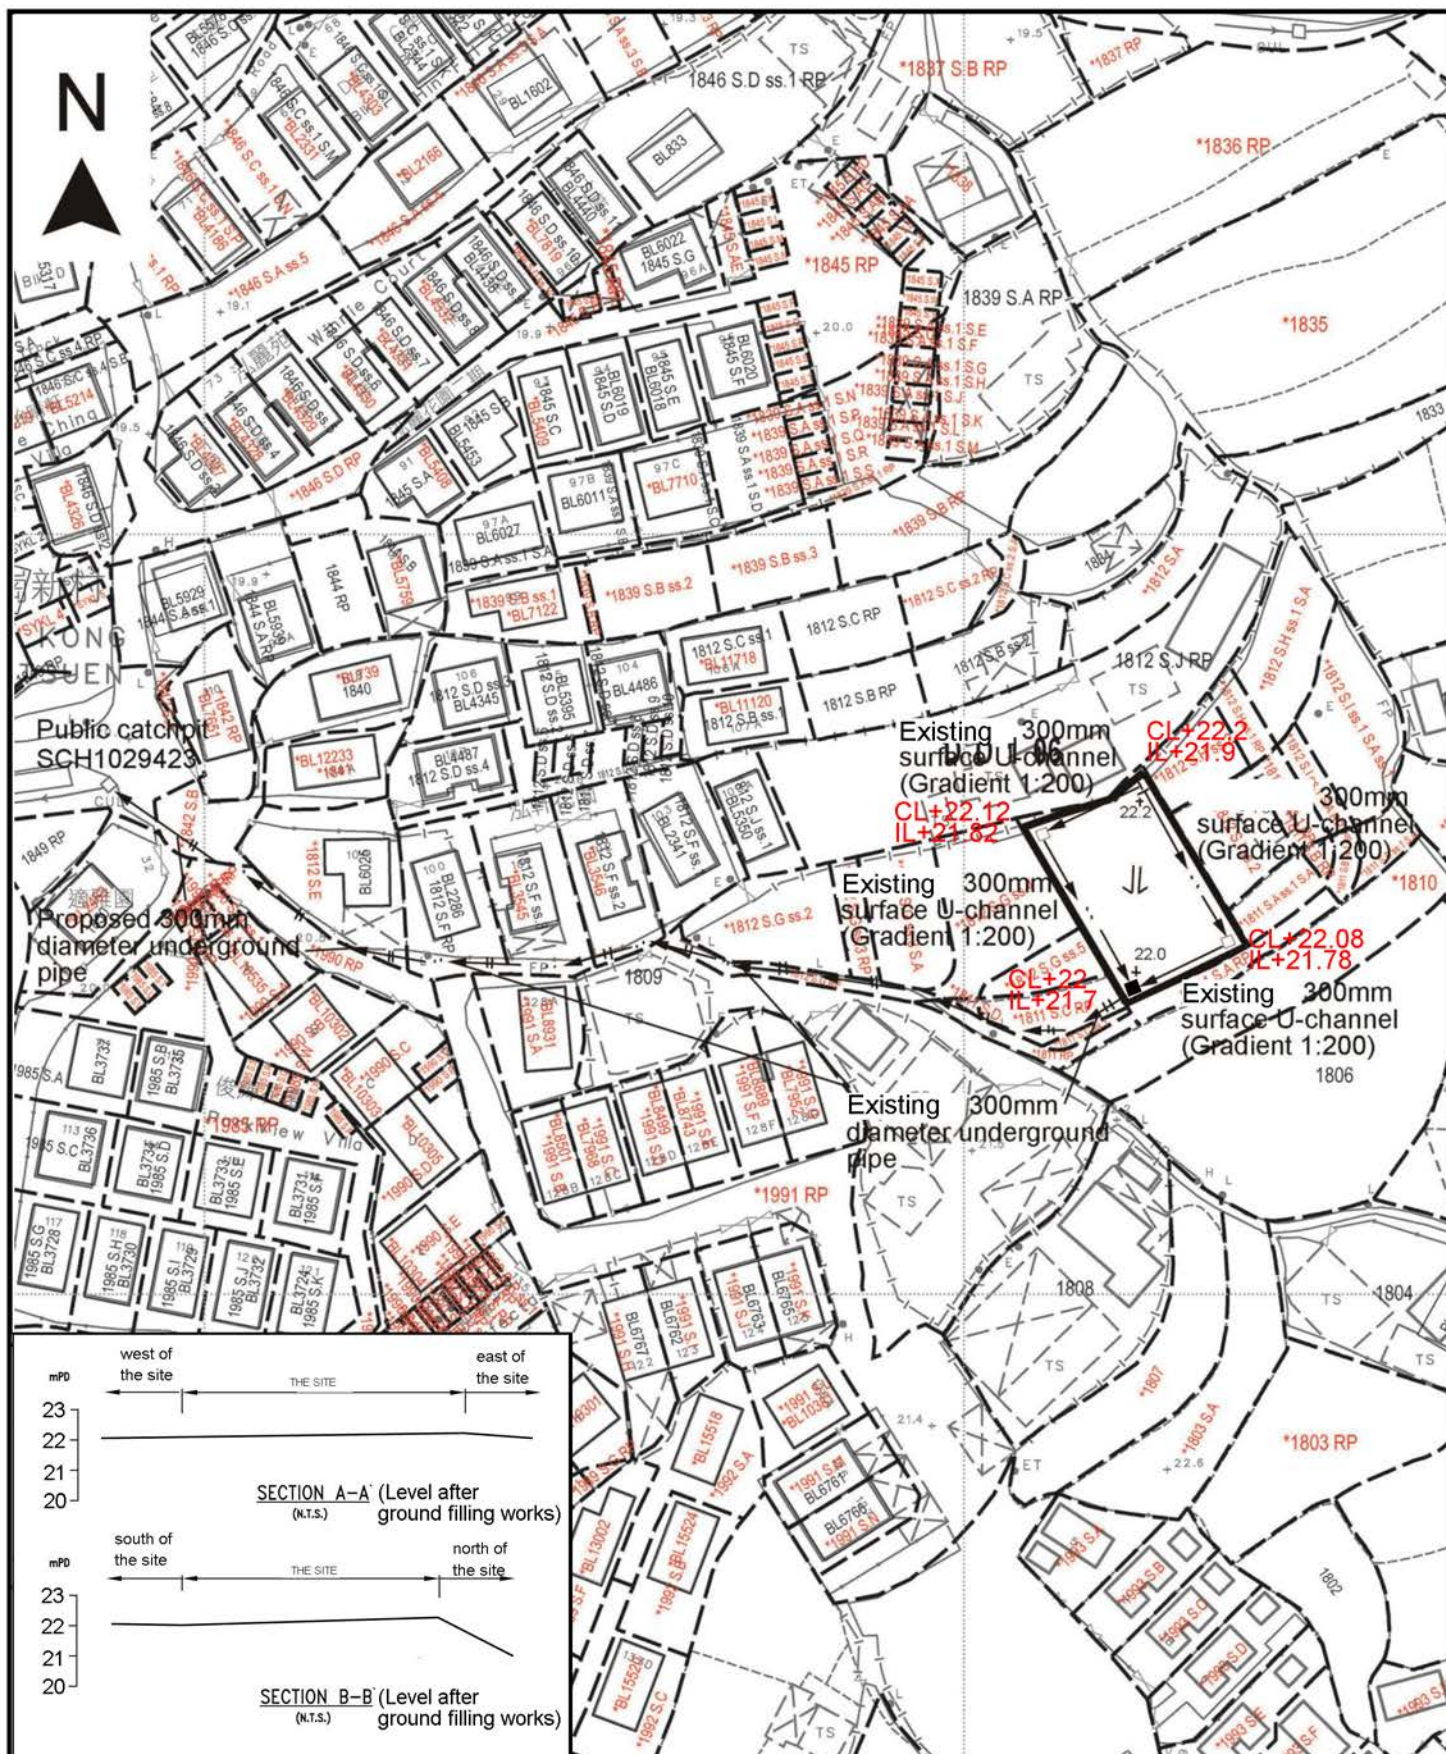

Project 項目名稱:

Renewal of Planning Approval for Temporary Animal Boarding Establishment (Cattery) for a Period of 3 Years and Filling of Land at Lots 1811 S.A ss.1 RP, 1812 S.G ss.1 (Part), 1812 S.H RP (Part) & 1812 S.I RP in D.D.106, Kam Tin, Yuen Long, N.T.

Drawing Title 圖目:

As-built Drainage Plan

Drawing No. 圖號:

Figure 4

Remarks 備註:

- +22.2 Level (in mPD)
- catchpit
- ⇐ Flow of surface runoff
- catchpit with sand trap

Scale 比例:

1:1000