


Application Site

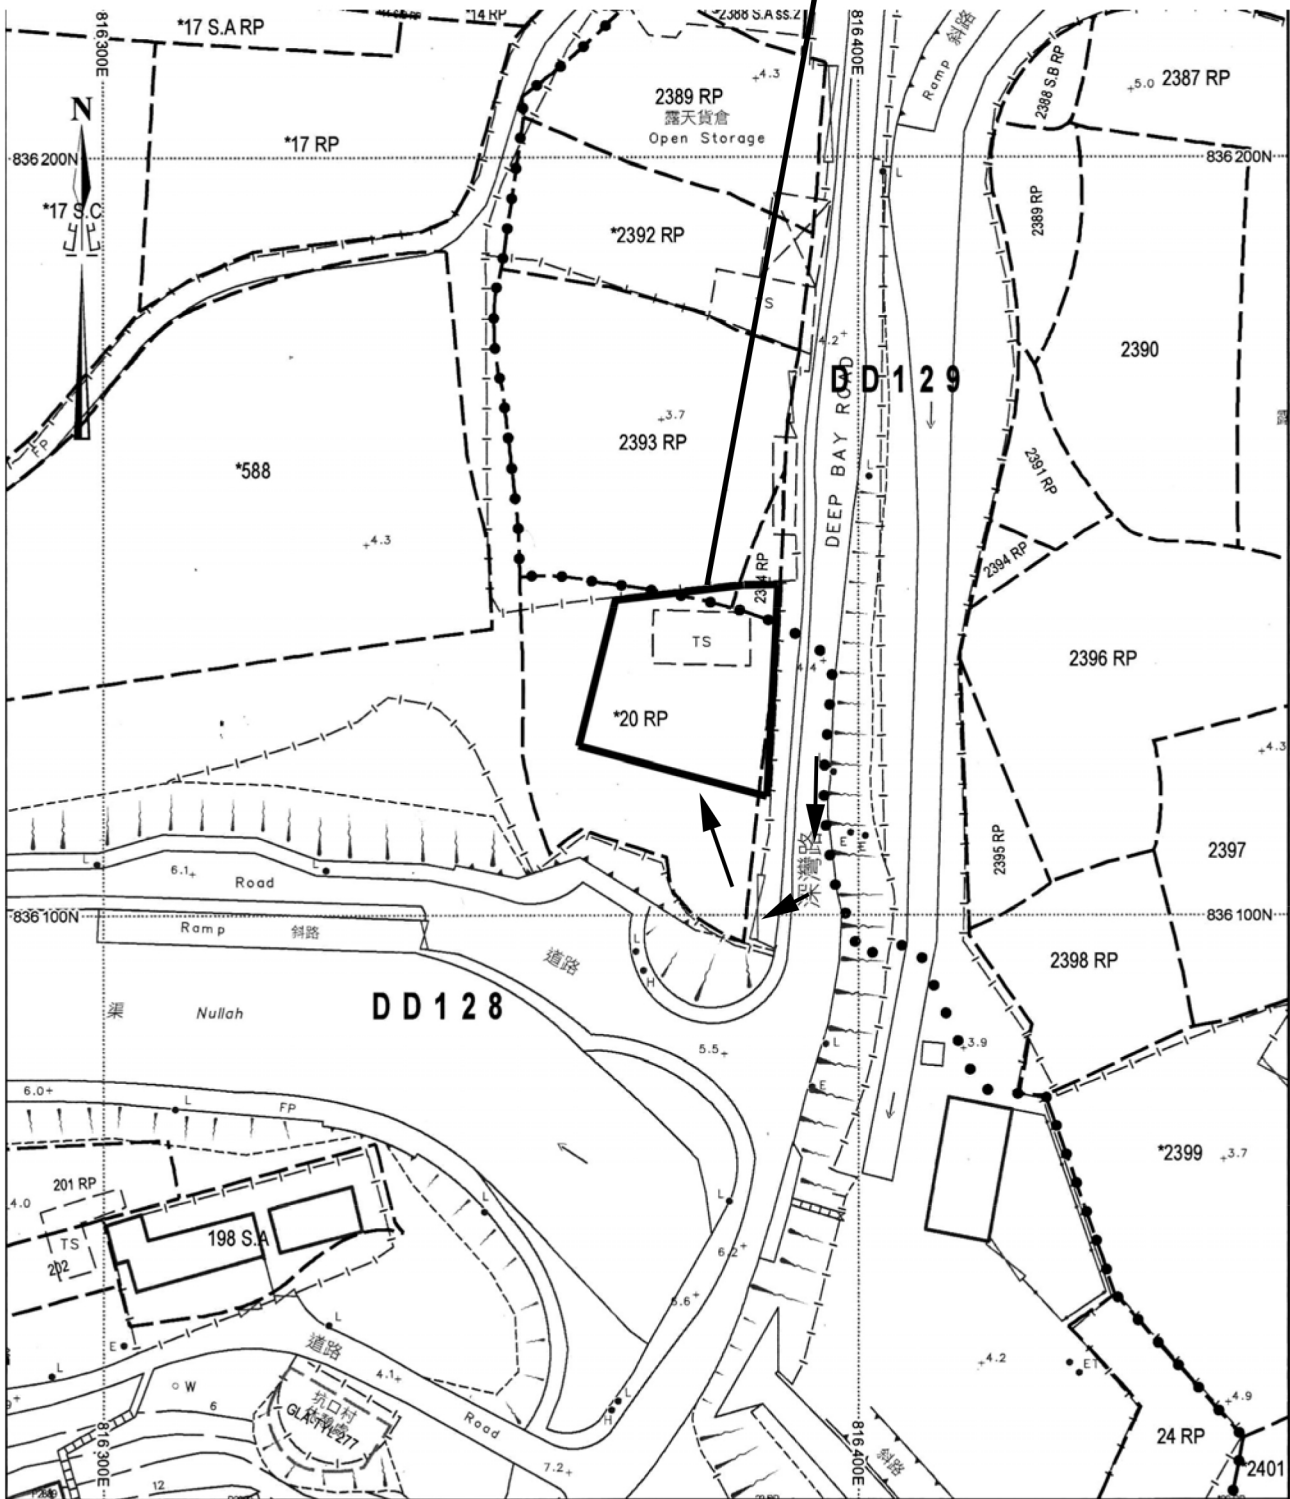

Project 項目名稱:

Proposed Temporary Shop and Services (Convenient Store) for a Period of 3 Years at Lot 20 RP (Part) in D.D. 128, Lots 2393 RP (Part) & 2394 RP (Part) in D.D.129 and adjoining Government Land, Lau Fau Shan, Yuen Long, N.T.

Drawing Title 圖目:

Application Site

Drawing No. 圖號:

Figure 1

Remarks 備註:

➡ Vehicular access leading from Deep Bay Road

Scale 比例:


1:1000



Application Site

修改

BOUNDARY OF PLANNING SCHEME AMENDED

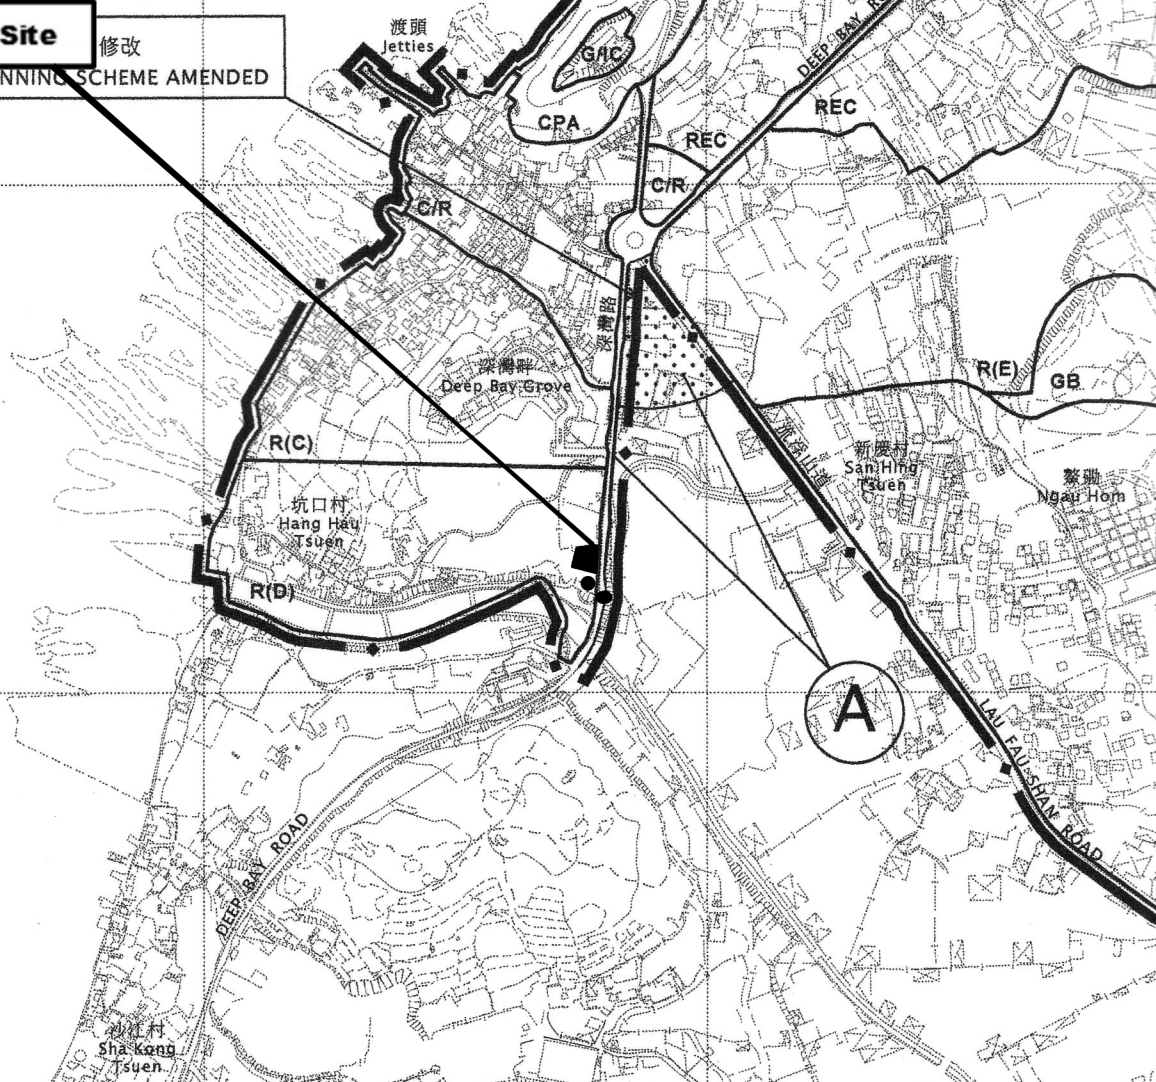

Project 項目名稱:

Proposed Temporary Shop and Services (Convenient Store) for a Period of 3 Years at Lot 20 RP (Part) in D.D. 128, Lots 2393 RP (Part) & 2394 RP (Part) in D.D.129 and adjoining Government Land, Lau Fau Shan, Yuen Long, N.T.

Drawing Title 圖目:

Location Plan

Drawing No. 圖號:


Figure 2

Remarks 備註:

●●● Vehicular access leading from Deep Bay Road

Scale 比例:

1:7500

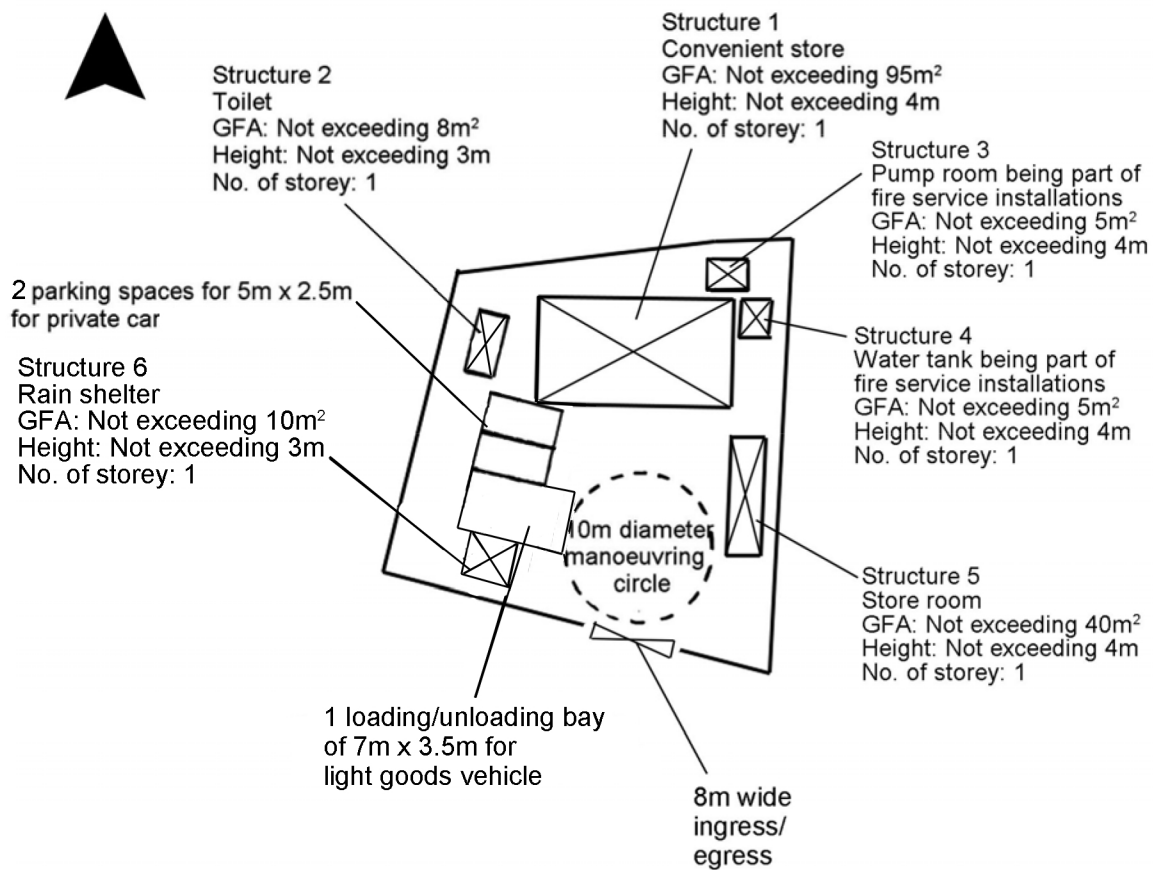

Project 項目名稱:

Proposed Temporary Shop and Services (Convenient Store) for a Period of 3 Years at Lot 20 RP (Part) in D.D. 128, Lots 2393 RP (Part) & 2394 RP (Part) in D.D.129 and adjoining Government Land, Lau Fau Shan, Yuen Long, N.T.

Drawing Title 圖目:

Proposed Layout Plan


Drawing No. 圖號:

Figure 3

Remarks 備註:

Scale 比例:

1:500

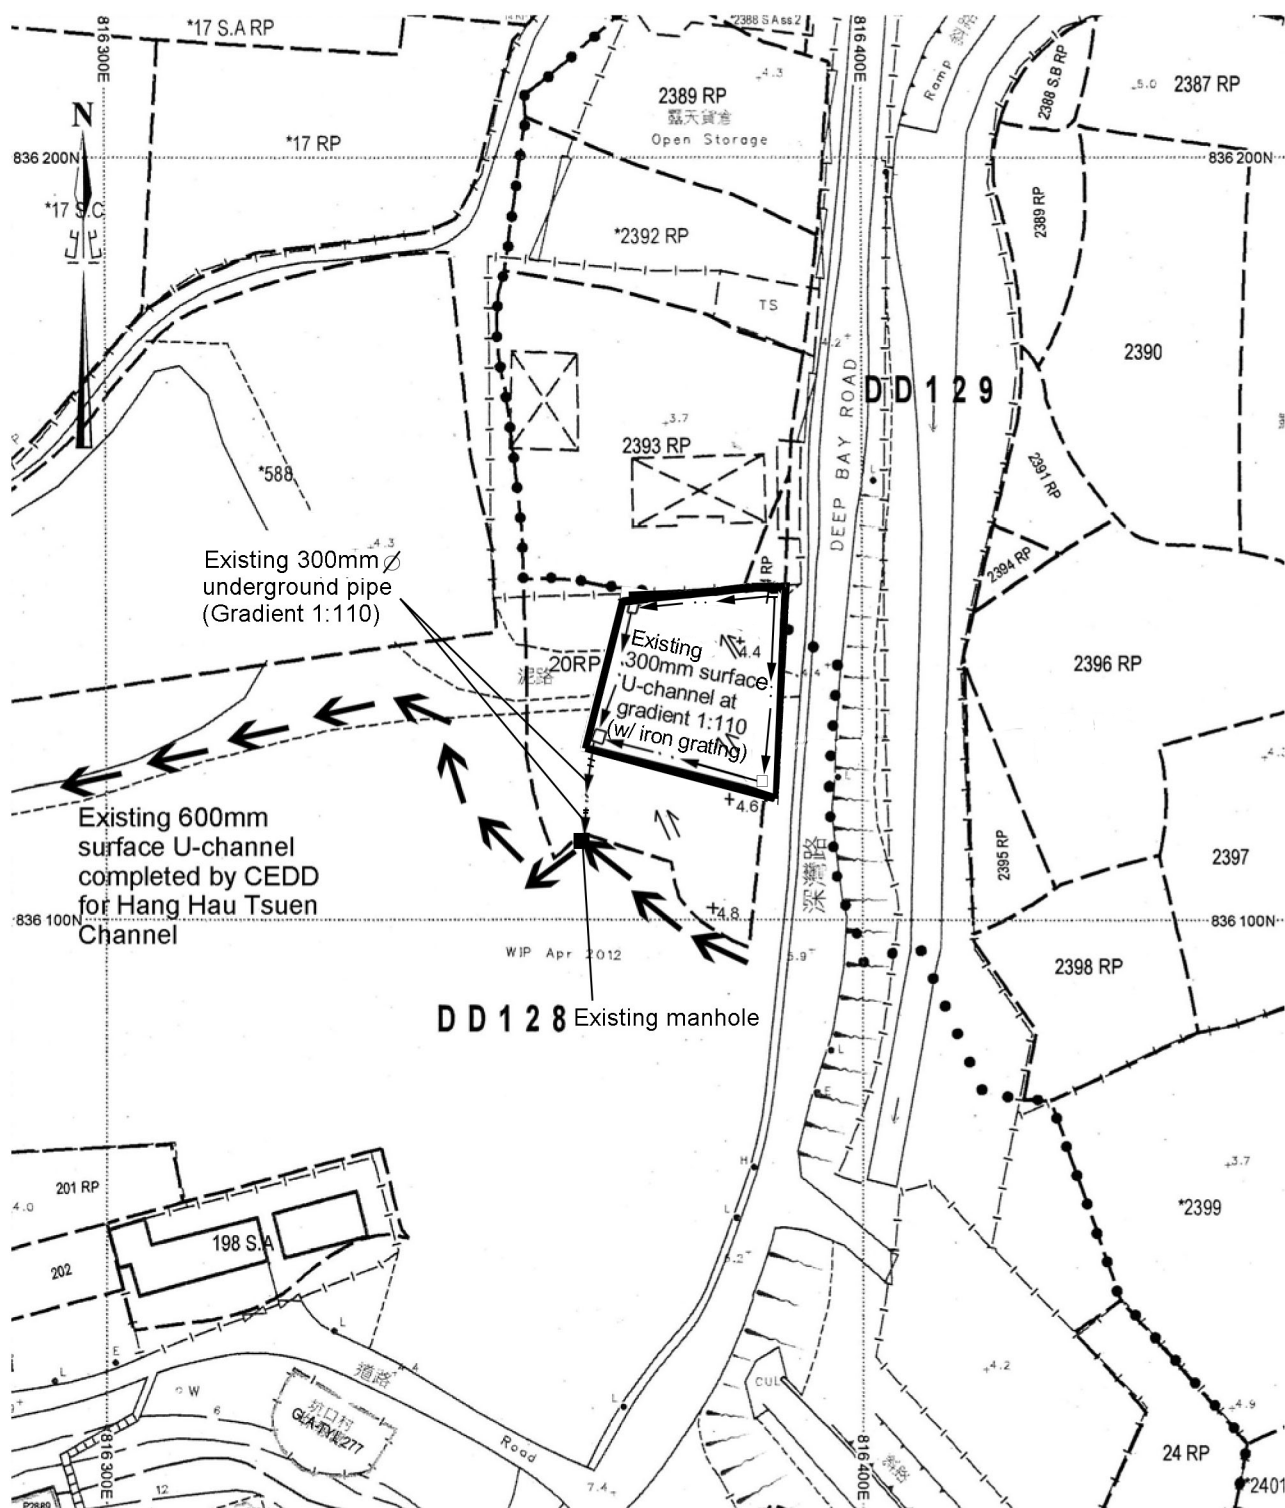

Project 項目名稱:

Proposed Temporary Shop and Services (Convenient Store) for a Period of 3 Years at Lot 20 RP (Part) in D.D. 128, Lots 2393 RP (Part) & 2394 RP (Part) in D.D.129 and adjoining Government Land, Lau Fau Shan, Yuen Long, N.T.

Drawing Title 圖目:

As-built Drainage Plan

Drawing No. 圖號:

Figure 4

Remarks 備註:

- ☐ Catchpit
- Flow of Surface Runoff
- +_{4.4} Level

Scale 比例:

1:1000