


本摘要圖於 2025 年 7 月 10 日 擬備，所  
根據的資料為測量圖編號  
2-SW-18A, 2-SW-18B

Extract Plan prepared on 10.7.2025 is based  
on Survey No.  
2-SW-18A, 2-SW-18B

### 位置圖 Location Plan

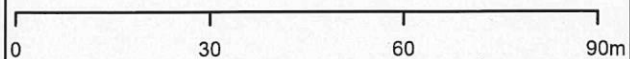


本摘要圖由城市規劃委員會  
法定規劃綜合網站 3 匯出。  
This Extract Plan was exported  
by the Town Planning Board  
Statutory Planning Portal 3.

參考編號  
REFERENCE No.


圖 PLAN



# 地段索引圖 LOT INDEX PLAN

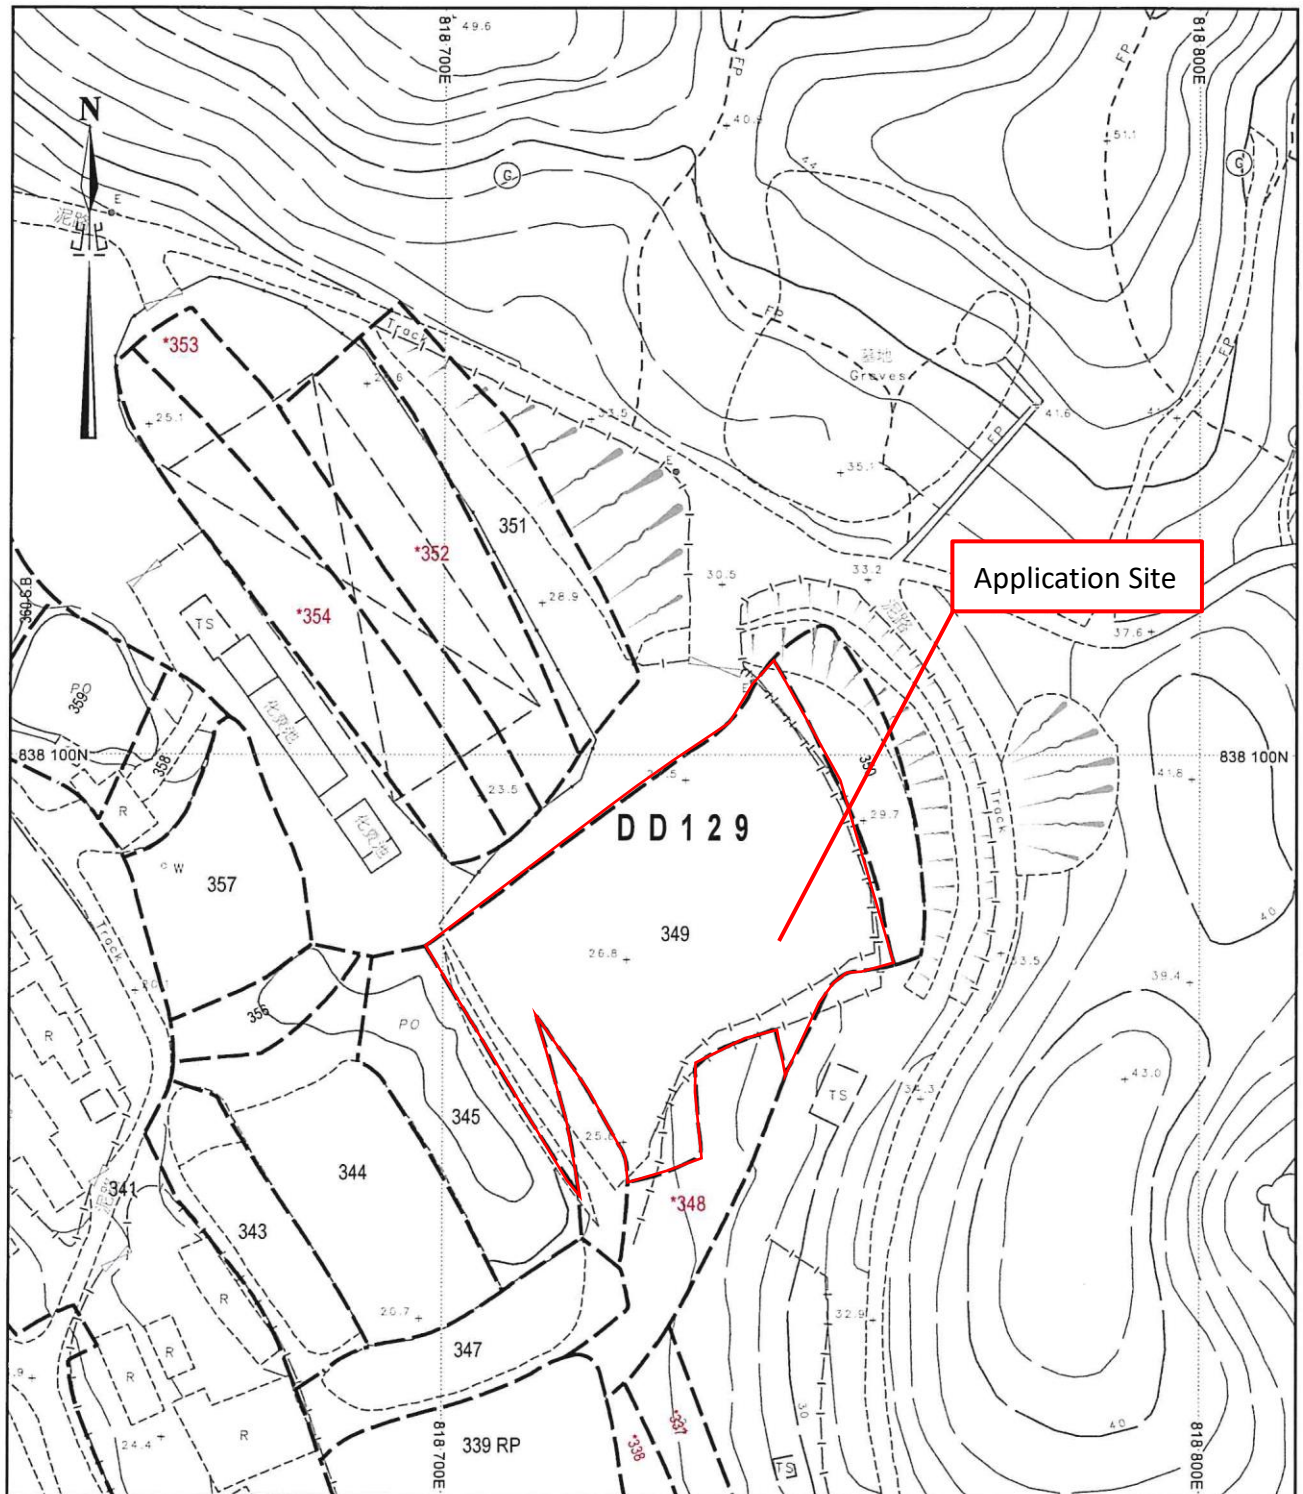



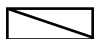

Proposed Structures Details					
	Structures	Gross Floor Area(GFA)	Height (Not Exceeding)	Storey	Proposed/ Existing
1	Ancillary Storage	About 12.19m x 2.44m = 77m <sup>2</sup>	3m	1	Proposed Structure
2	Ancillary Storage	About 12.19m x 2.44m = 77m <sup>2</sup>	3m	1	Proposed Structure
3	Ancillary Storage	About 12.19m x 2.44m = 77m <sup>2</sup>	3m	1	Proposed Structure
4	Animal Boarding Establishment	About 12.19m x 2.44m = 77m <sup>2</sup>	3m	1	Proposed Structure
5	Animal Boarding Establishment	About 12.19m x 2.44m = 77m <sup>2</sup>	3m	1	Proposed Structure
6	Animal Boarding Establishment	About 12.19m x 2.44m = 77m <sup>2</sup>	3m	1	Proposed Structure
7	Ancillary Clinic for Dog	About 12.19m x 2.44m = 77m <sup>2</sup>	3m	1	Proposed Structure
8	Ancillary Staff Lounge	About 12.19m x 2.44m = 77m <sup>2</sup>	3m	1	Proposed Structure
	Private Car Parking Space	5.5m x 2.5m	N/A	N/A	N/A
	LGV Parking Space	6m x 2.5m	N/A	N/A	N/A

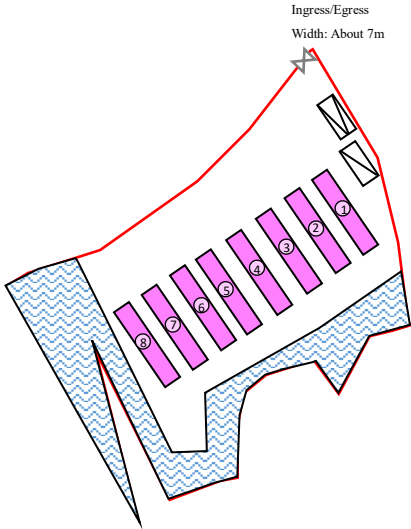

Project 項目名稱：  
臨時動物寄養所連附屬設施


Drawing Title 圖目：  
Proposed Layout Plan

Location：  
D.D. 129 Lot 349

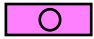- Legend:
-  Proposed Structure
  -  Private Car Parking Space
  -  LGV Parking Space
  -  Slope Area

Scale 比例：  
1:1000

# 地段索引圖 LOT INDEX PLAN

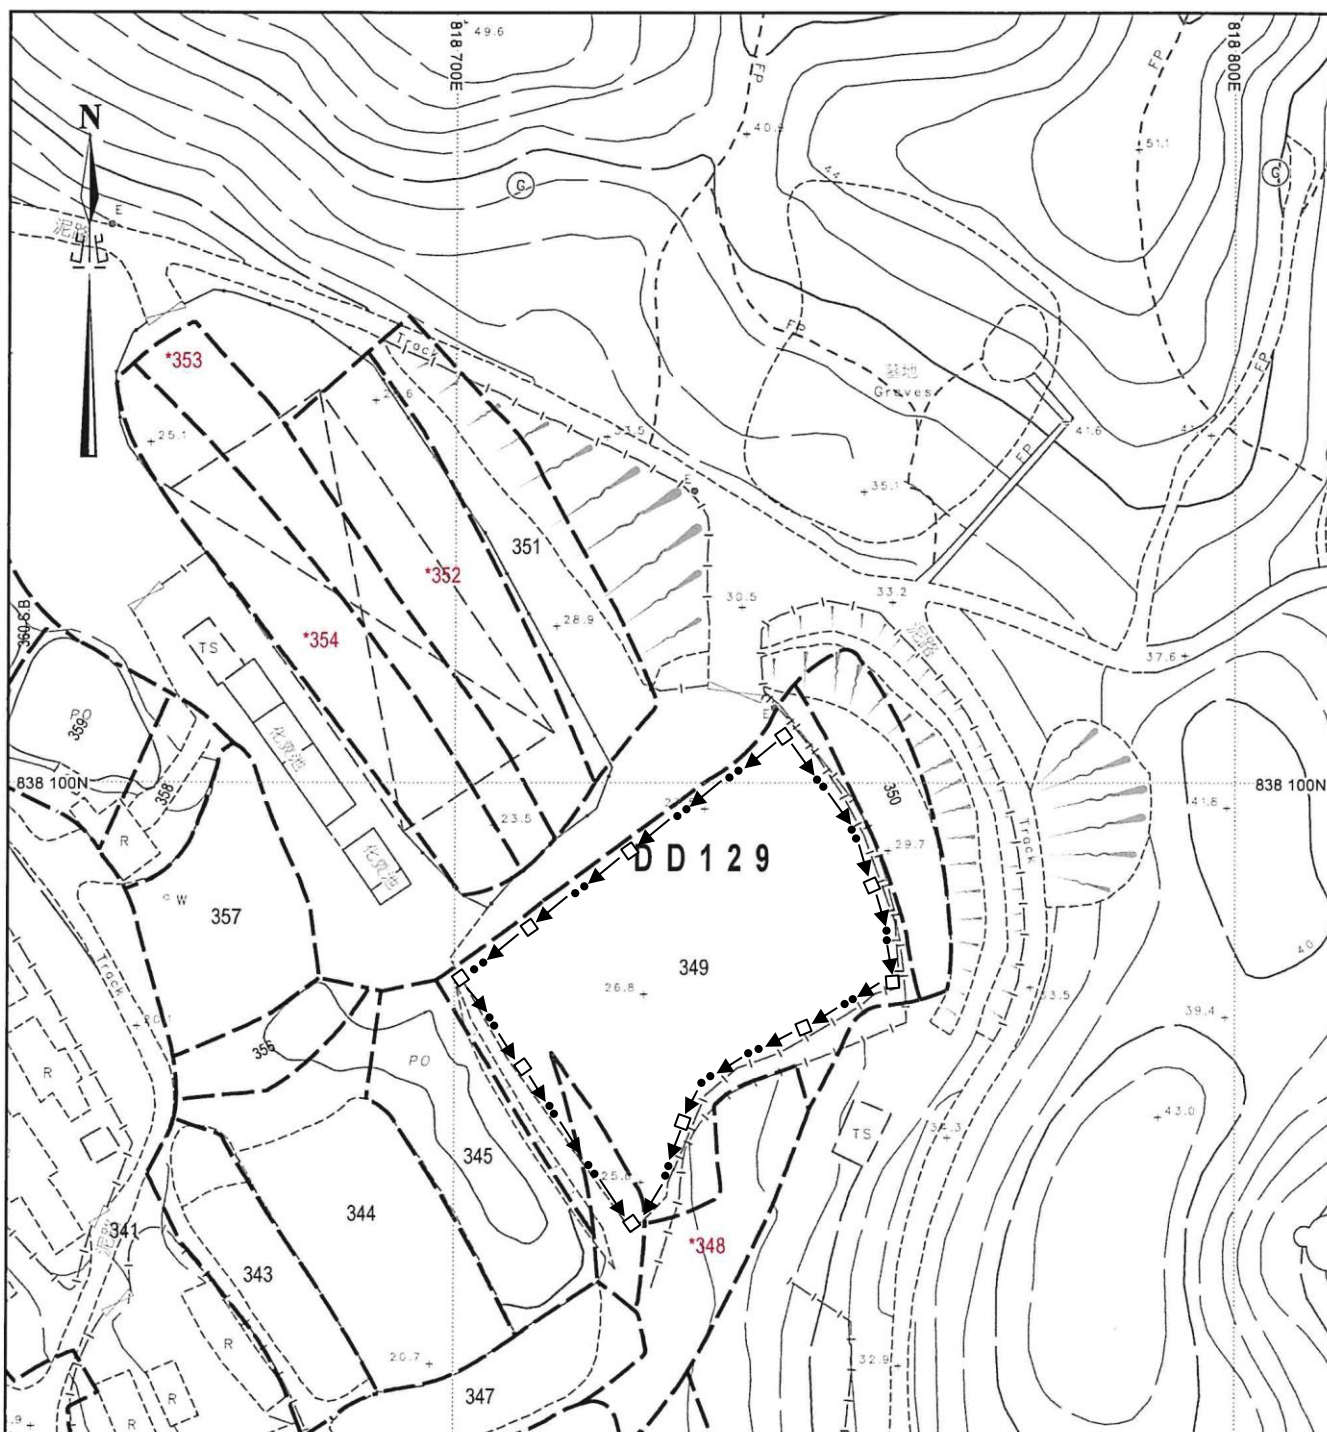

Project 項目名稱：  
臨時動物寄養所連附屬設施

Drawing Title 圖目：  
As-built Drainage Plan

Remarks 備註：  
☐ Existing catchpit  
 +25.8 Level (in mPD)  
 ← Flow of surface runoff

Drawing No 圖號：  
Figure 4

Scale 比例：  
1:1000