


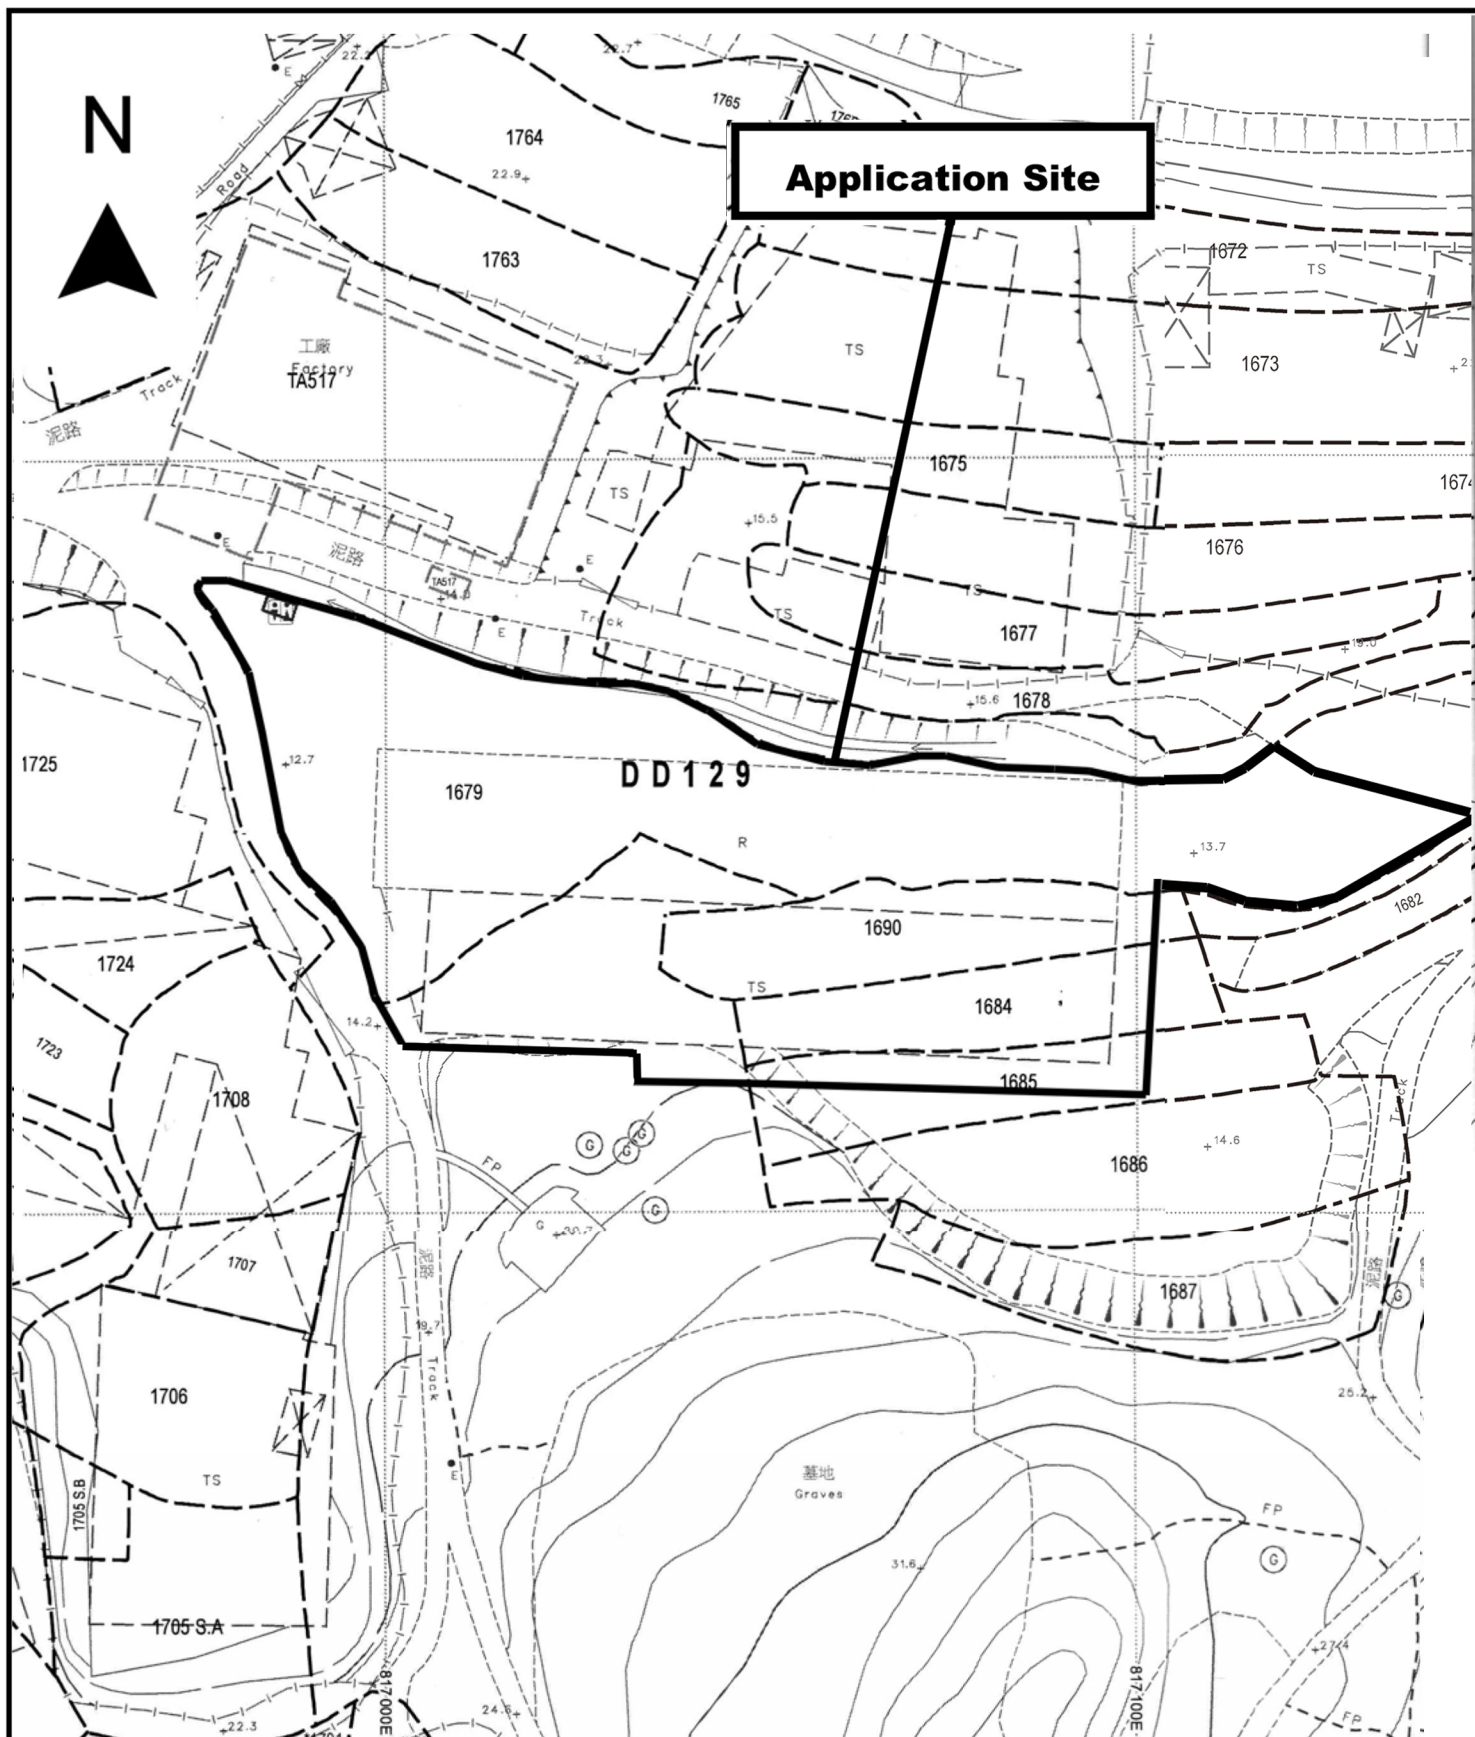

Project 項目名稱:


Drawing Title 圖目:

Application Site

Remarks 備註:


Drawing No. 圖號:

Figure 1

Scale 比例:

1:1000



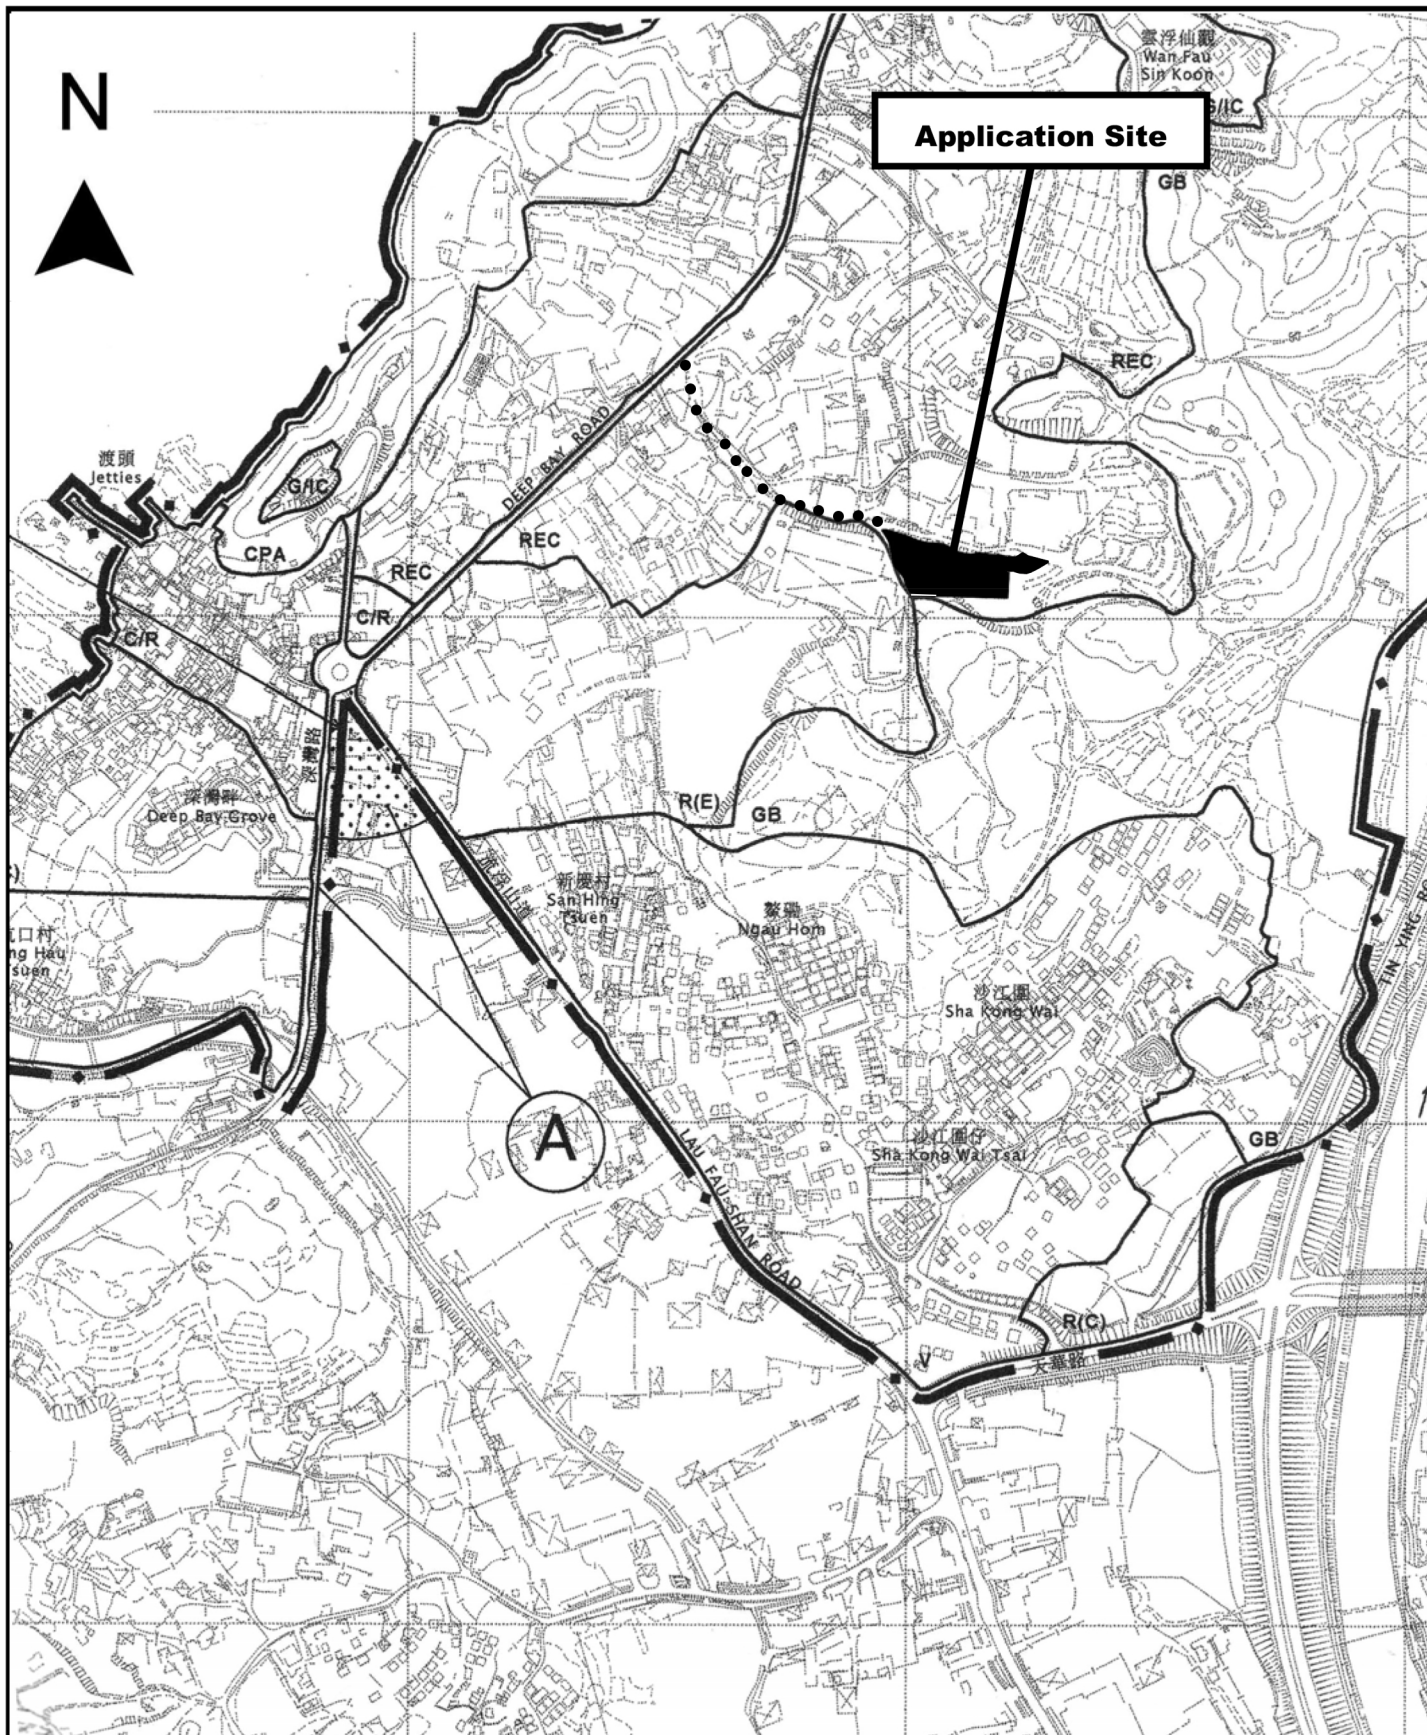

Project 項目名稱:

Proposed Temporary Warehouse for Storage of Water Pump and Motors for a Period of 3 Years at Lots 1679 (Part), 1684 (Part) 1685 (Part) & 1690 (Part) in D.D. 129 & Adjoining Government Land, Lau Fau Shan, Yuen Long, N.T.

Drawing Title 圖目:

Location Plan

Drawing No. 圖號:

Figure 2


Remarks 備註:

●●● Vehicular access leading from Deep Bay Road

Scale 比例:

1:7500

N

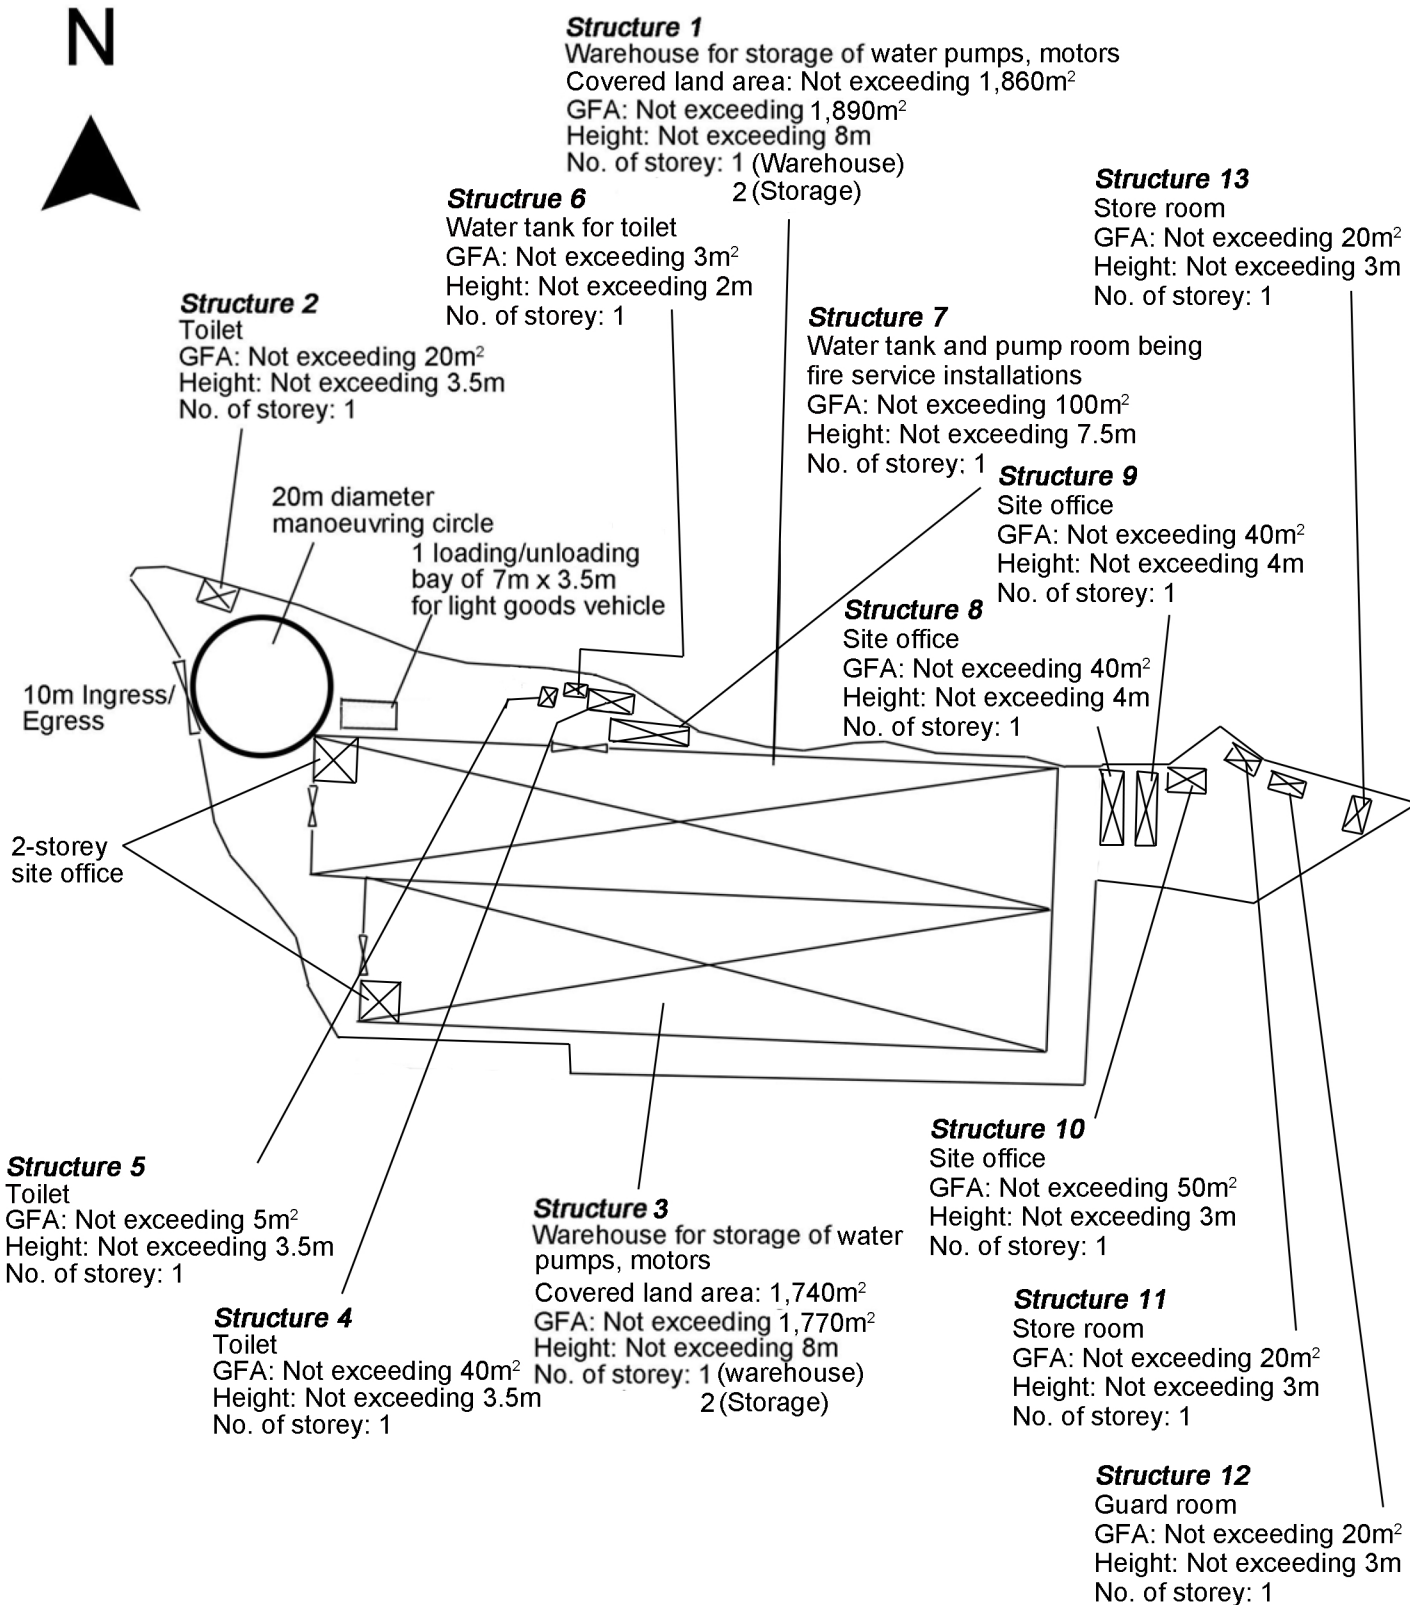

Project 項目名稱:

Proposed Temporary Warehouse for Storage of Water Pump and Motors for a Period of 3 Years at Lots 1679 (Part), 1684 (Part) 1685 (Part) & 1690 (Part) in D.D. 129 & Adjoining Government Land, Lau Fau Shan, Yuen Long, N.T.

Drawing Title 圖目:

Proposed Layout Plan

Drawing No. 圖號:


Figure 3

Remarks 備註:

Scale 比例:

1:1000



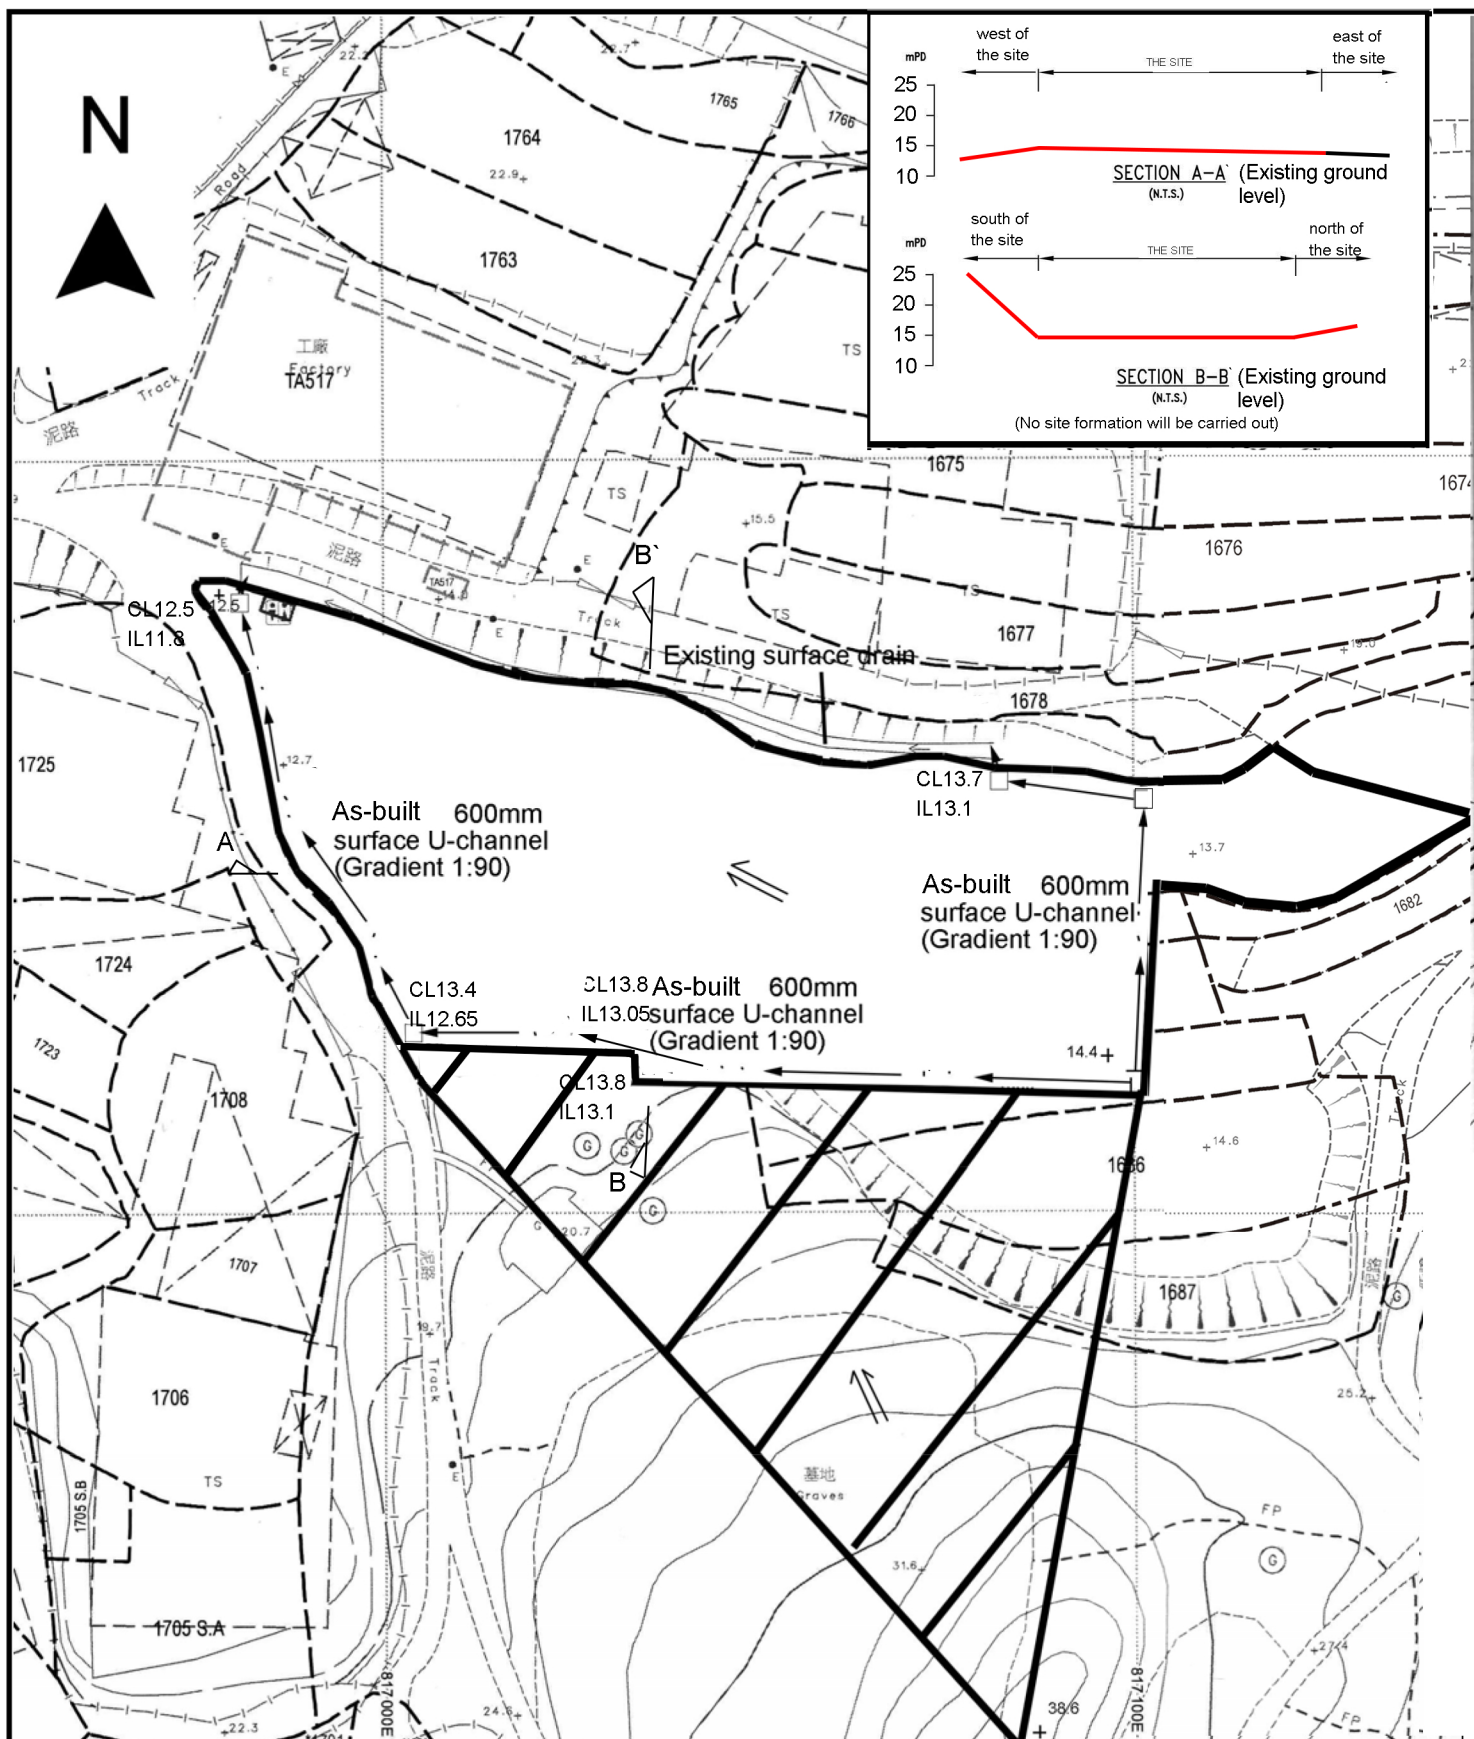

Project 項目名稱:

Proposed Temporary Warehouse for Storage of Water Pump and Motors for a Period of 3 Years at Lots 1679 (Part), 1684 (Part) 1685 (Part) & 1690 (Part) in D.D. 129 & Adjoining Government Land, Lau Fau Shan, Yuen Long, N.T.

Drawing Title 圖目:

As-built Drainage Plan

Drawing No. 圖號:

Figure 4

Remarks 備註:

- Proposed catchpit
- + 14.4 Level (mPD)
- ← Flow of Surface Runoff
- ▨ External catchment

Scale 比例:

1:1000