



Application Site

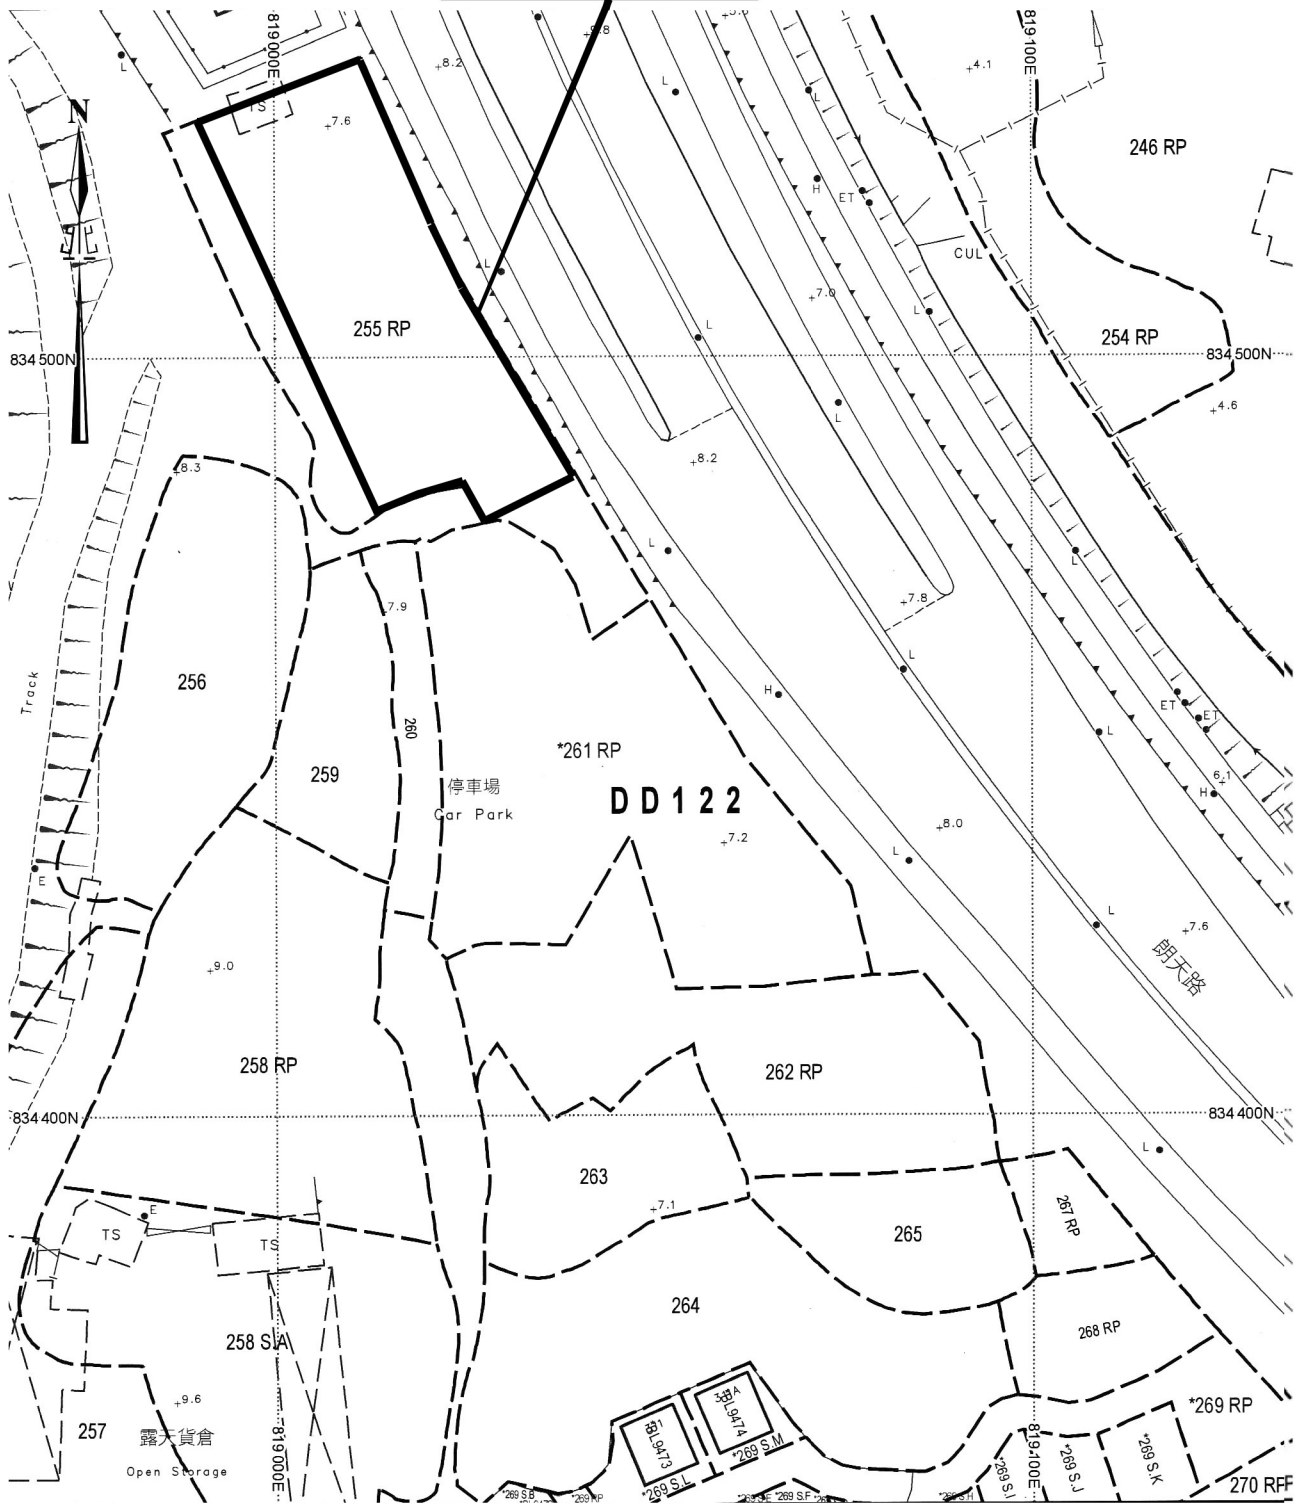

<p>Project 項目名稱: Proposed Temporary Shop & Services (Retail Shop for Selling Construction Material) and Wholesale of Construction Material for a Period of 3 Years at Lot 255 RP (Part) in D.D. 122, Ping Shan, Yuen Long, N.T.</p>	<p>Drawing Title 圖目: Site Plan</p>	<p>Remarks 備註:</p>
	<p>Drawing No. 圖號: Figure 1</p>	<p>Scale 比例: 1:1000</p>

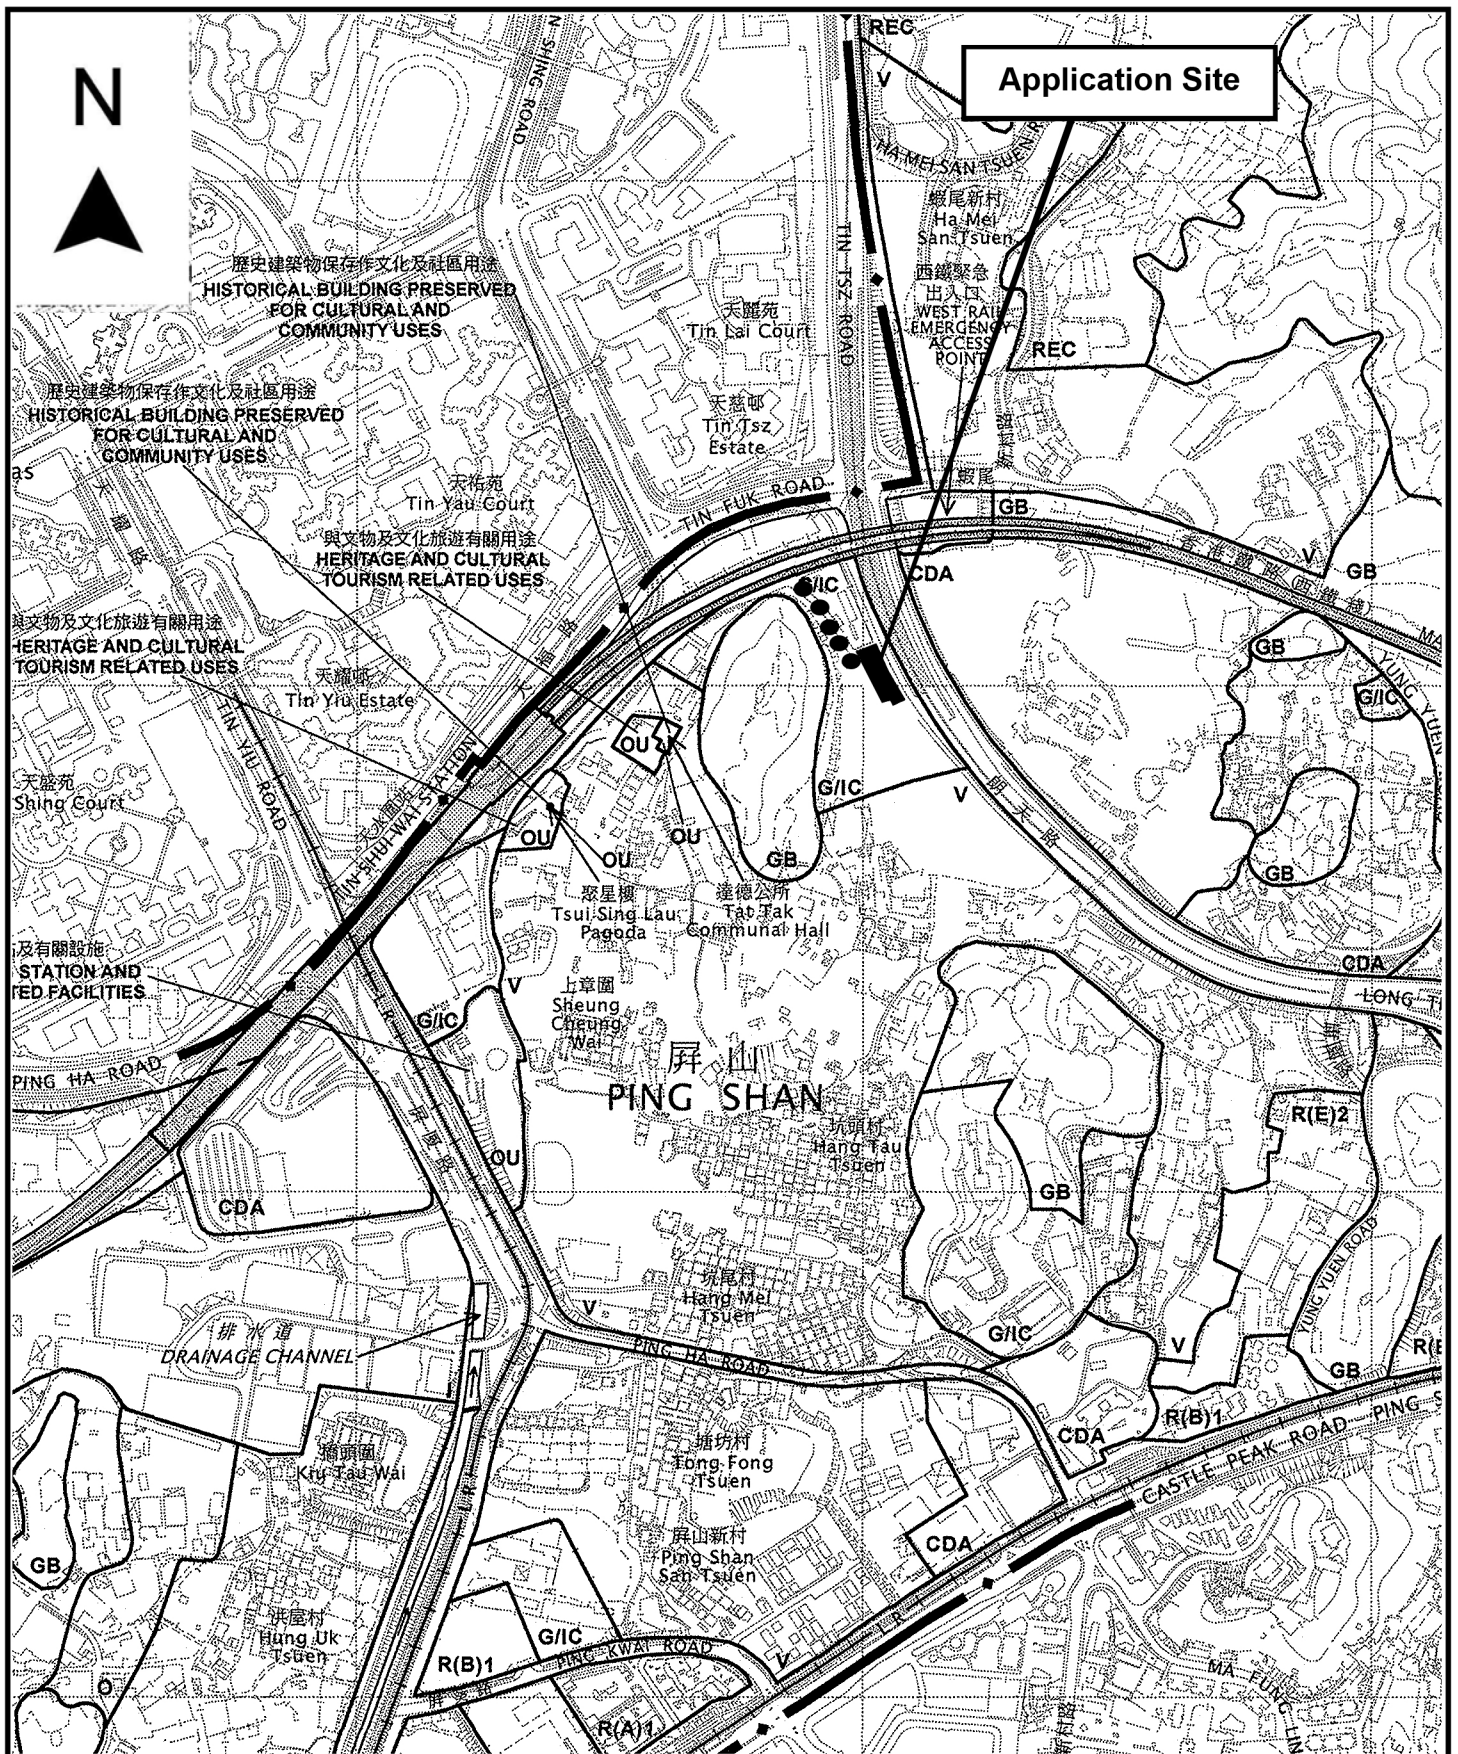


<p>Project 項目名稱: Proposed Temporary Shop & Services (Retail Shop for Selling Construction Material) and Wholesale of Construction Material for a Period of 3 Years at Lot 255 RP (Part) in D.D. 122, Ping Shan, Yuen Long, N.T.</p>	<p>Drawing Title 圖目: Vehicular Access Plan</p> <p>Drawing No. 圖號: Figure 2</p>	<p>Remarks 備註: ●●● Vehicular access leading from Tsui Sing Road</p> <p>Scale 比例: 1:7500</p>
--	--	---




Breakdown of GFA of Structure 1

	Shop 1	Shop 2	GFA Sub-total
Size of the shop	310m ²	290m ²	600m ²
Size of the rain shelter	320m ²	340m ²	660m ²
Office	20m ²	80m ² (2-storeys)	100m ²
Total			1,360m²

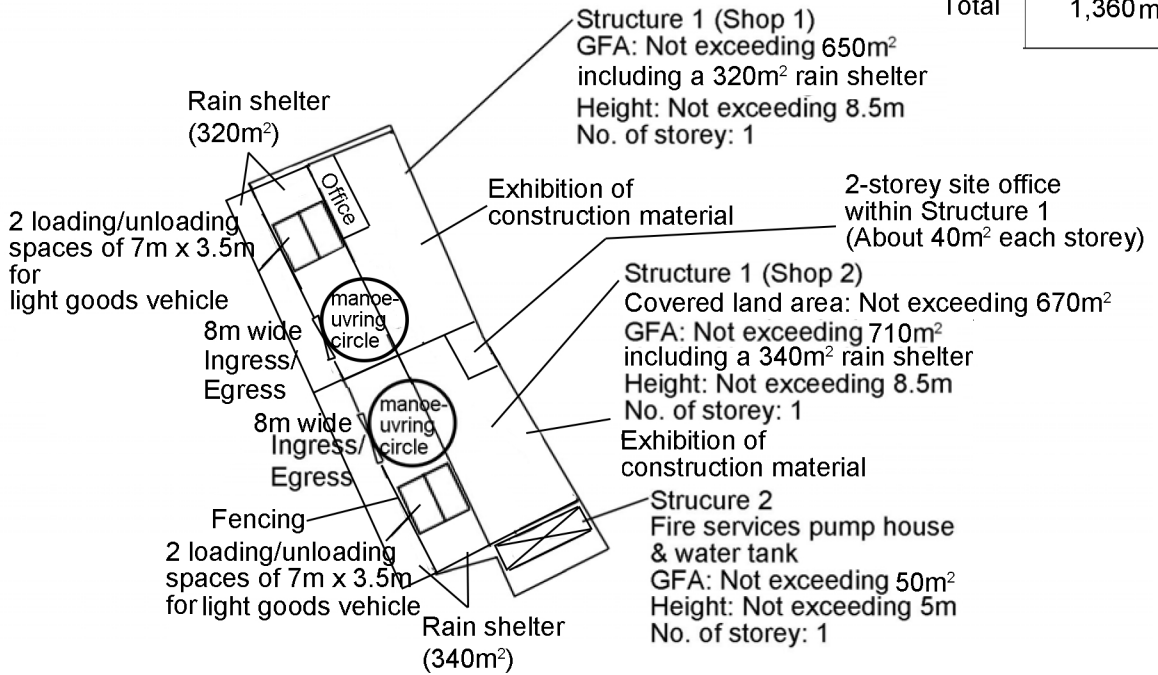

Project 項目名稱: Proposed Temporary Shop & Services (Retail Shop for Selling Construction Material) and Wholesale of Construction Material for a Period of 3 Years at Lot 255 RP (Part) in D.D. 122, Ping Shan, Yuen Long, N.T.	Drawing Title 圖目: Proposed Layout Plan	Remarks 備註: Scale 比例: 1:1000
	Drawing No. 圖號: Figure 3	

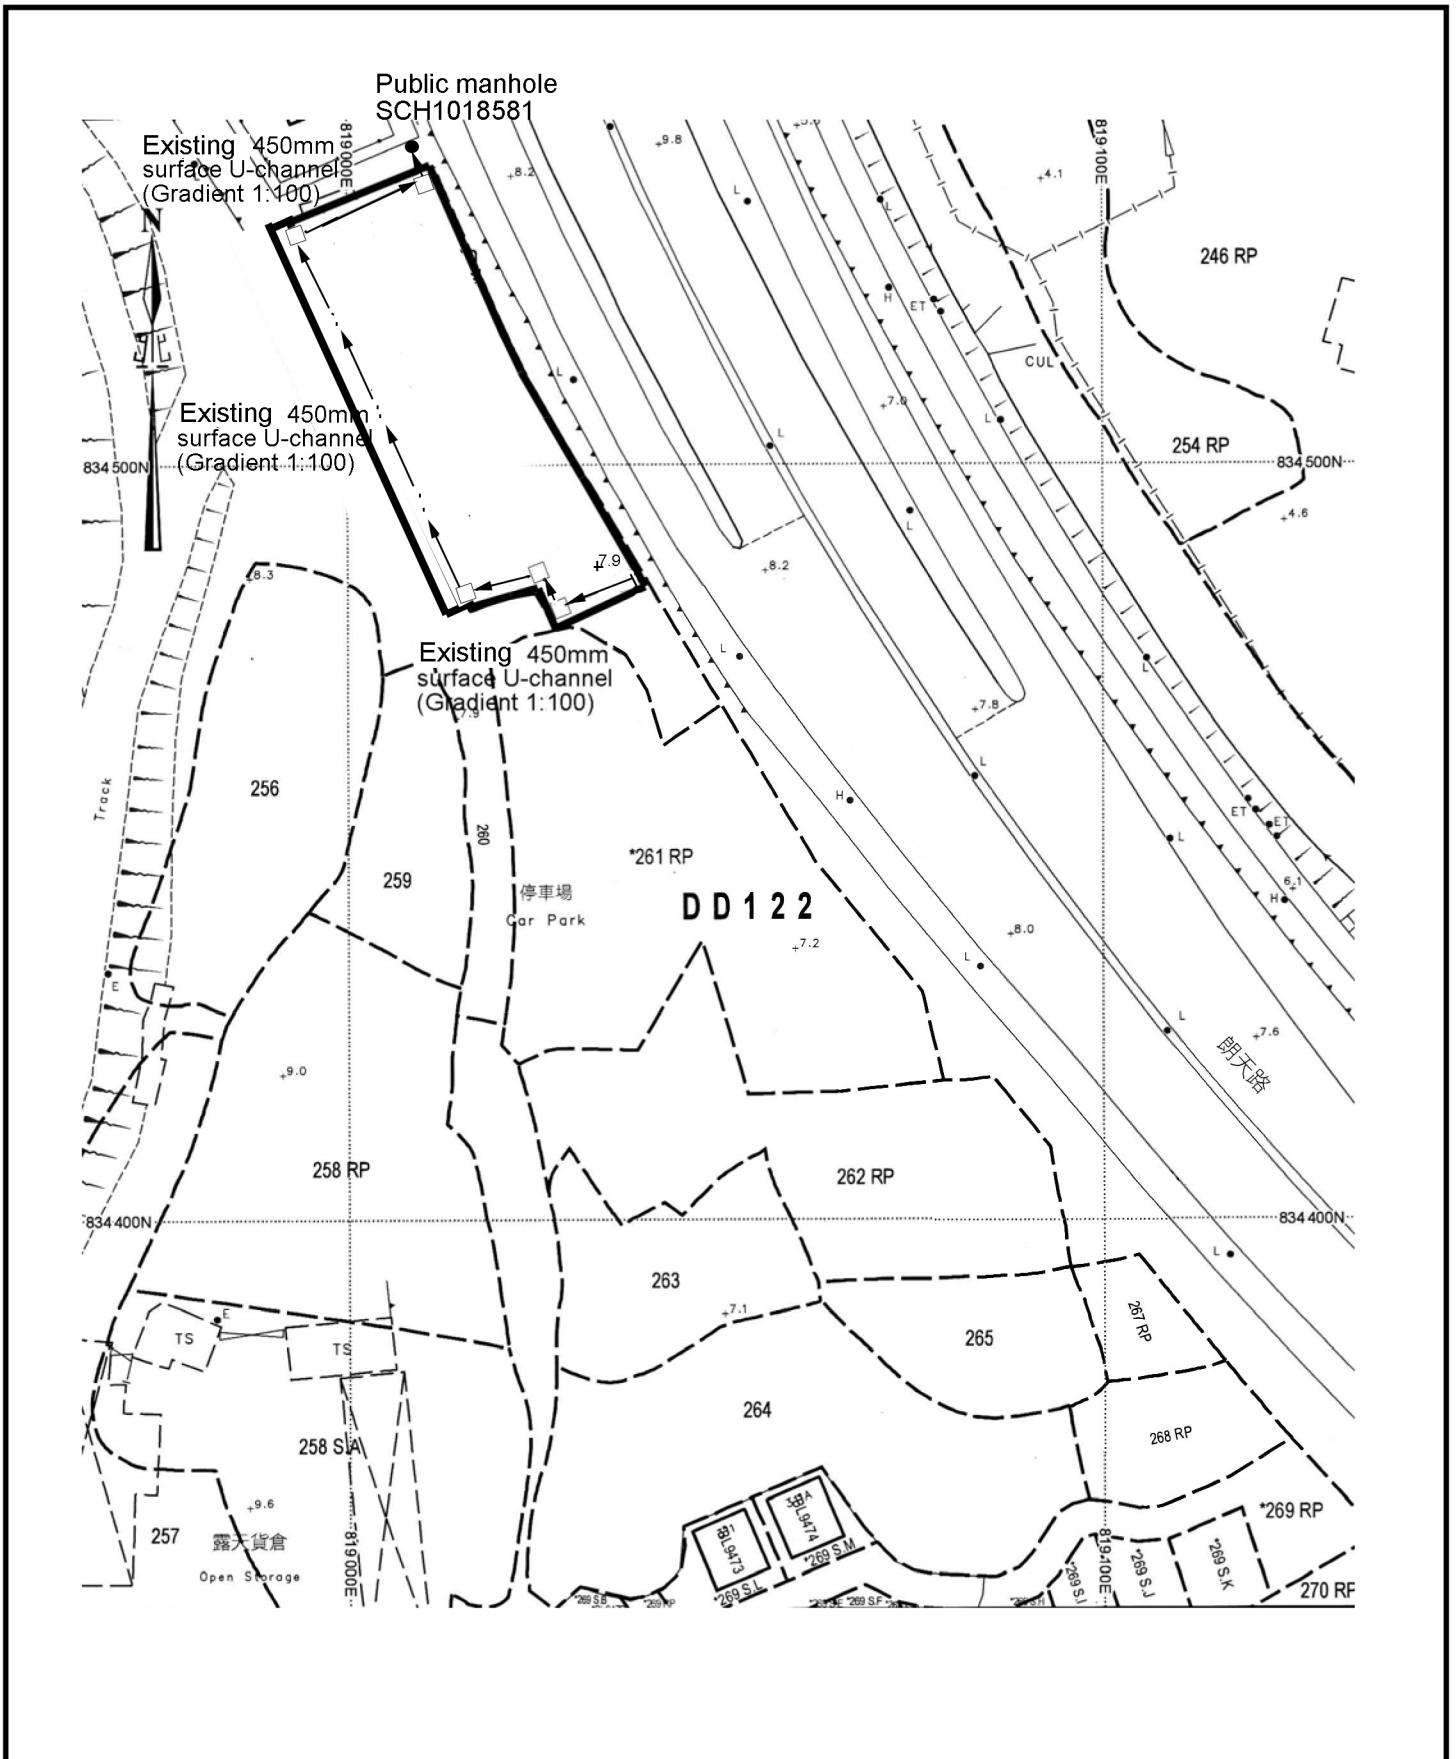

<p>Project 項目名稱: Proposed Temporary Shop & Services (Retail Shop for Selling Construction Material) and Wholesale of Construction Material for a Period of 3 Years at Lot 255 RP (Part) in D.D. 122, Ping Shan, Yuen Long, N.T.</p>	<p>Drawing Title 圖目: As-built Drainage Plan</p>	<p>Remarks 備註: +8.3 Level (in mPD) Flow of surface runoff Existing catchpit</p>
	<p>Drawing No. 圖號: Figure 4</p>	<p>Scale 比例: 1:1000</p>