

Total: 4 pages

Date: 14 May 2026

TPB Ref.: A/YL-PS/775

By Email

Town Planning Board
15/F, North Point Government Offices
333, Java Road
North Point
Hong Kong
(Attn: The Secretary)

Dear Sirs,

**Temporary Public Vehicle Park (Private Cars) for a Period of 3 Years
at Lots 390 (Part), 392 (Part), 403 RP (Part) and 404 (Part) in D.D.122
and Adjoining Government Land, Sheung Cheung Wai, Ping Shan,
Yuen Long, New Territories**

Please see the attached photos taken on 13.5.2026 to show the condition record of the existing drainage facilities within the captioned site. The photo viewpoint is shown in Figure 4.

Should you have any enquiries, please feel free to contact the undersigned at [REDACTED] at your convenience.

Yours faithfully,



Patrick Tsui



c.c. Tuen Mun and Yuen Long West District Planning Office (Attn: Mr. Max WONG) –
By Email

Photo 1

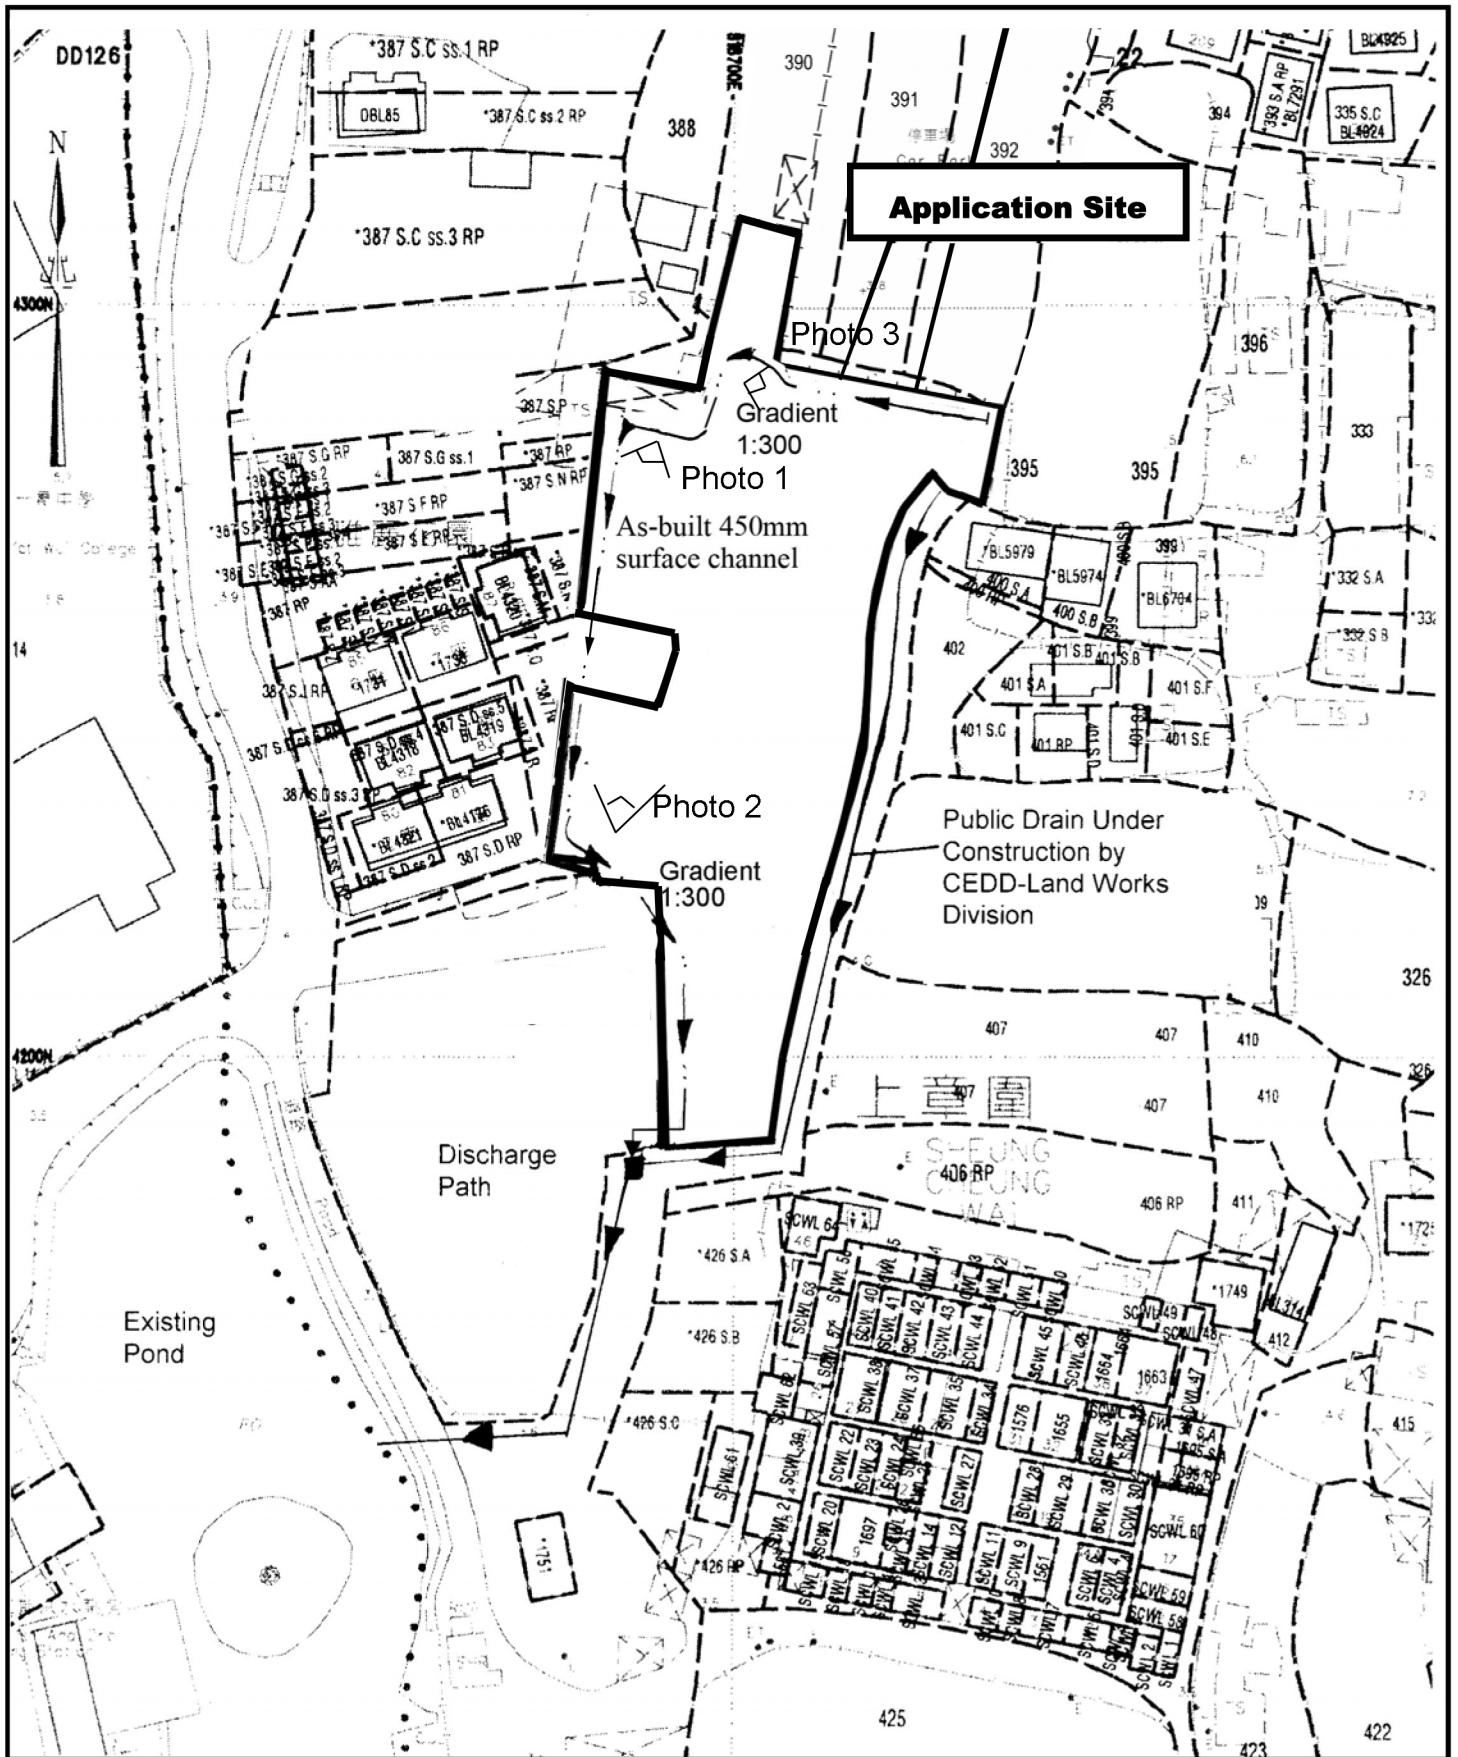


Photo 2



Photo 3





<p>Project 項目名稱:</p> <p>Proposed Temporary Public Vehicle Park for Private Car for a Period of 3 Years at Lots 390 (Part), 392 (Part), 403 RP (Part), 404 (Part) in D.D. 122 and Adjoining Government Land, Sheung Cheung Wai, Ping Shan, Yuen Long, N.T.</p>	<p>Drawing Title 圖目:</p> <p>As-built Drainage Plan</p> <p>Drawing No. 圖號:</p> <p>Figure 4</p>	<p>Remarks 備註:</p> <p>■ Existing Manhole</p> <p>The as-built drainage facilities have been accepted by DSD for previous planning permission No. A/YL-PS/259</p> <p>Scale 比例:</p> <p>1:1000</p>
---	---	--