



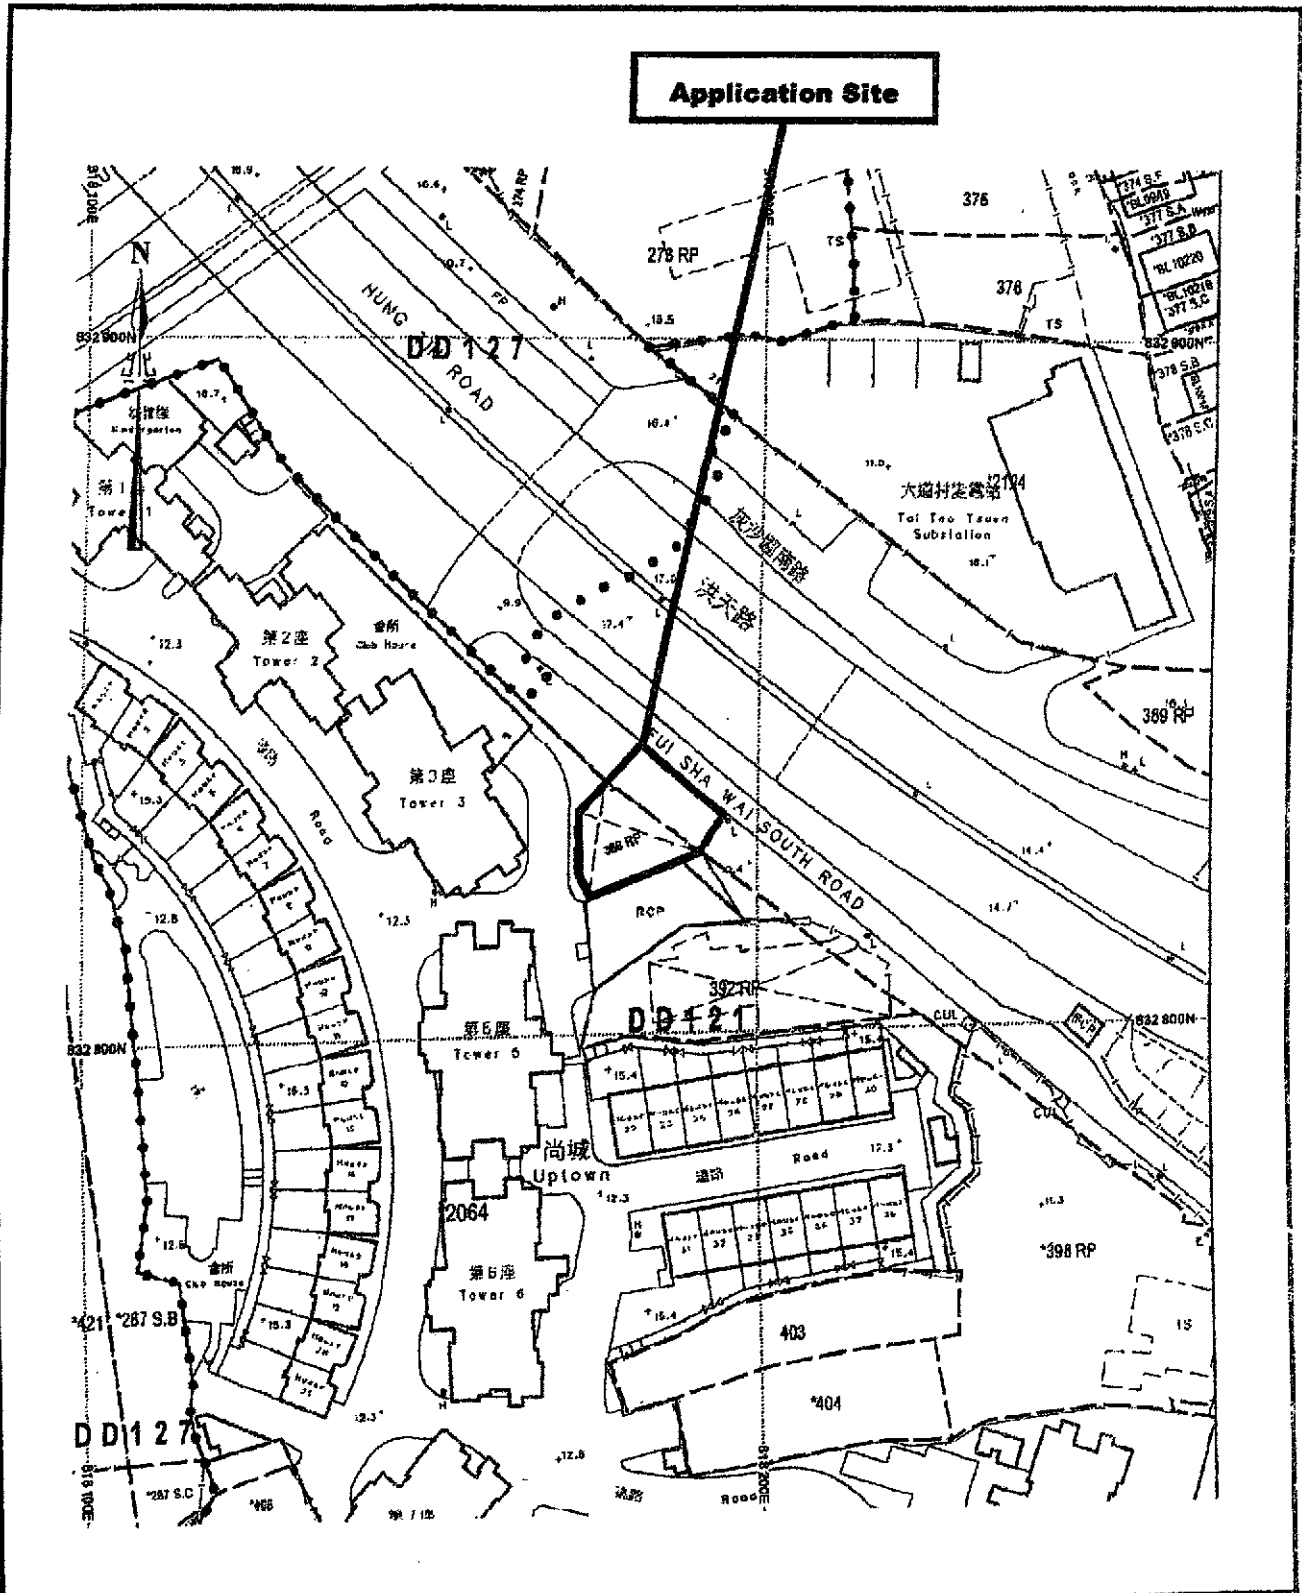

Project 項目名稱: 1 Temporary Shop and Services (Convenient Store) for a Period of 3 Years at Lot 388RP in D.D. 121 & Adjoining Government Land, Fui Sha Wai South Road, Yuen Long, N.T.	Drawing Title 圖目: Application Site Drawing No. 圖號: Figure 1	Remarks 備註: Scale 比例: 1:1000
--	---	---

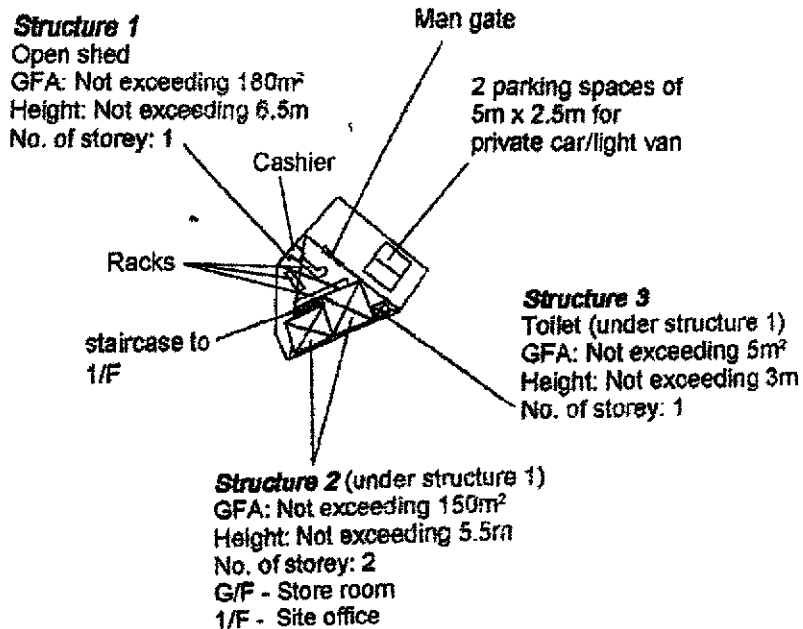

Project 項目名稱: Temporary Shop and Services (Convenient Store) for a Period of 3 Years at Lot 388RP in D.D. 121 & Adjoining Government Land, Fui Sha Wai South Road, Yuen Long, N.T.	Drawing Title 圖名: Proposed Layout Plan	Remarks 備註:
	Drawing No. 圖號: Figure 3	

Scale 比例: 1:1000

Tree	Approximate Height	Spacing
● Existing <i>Bauhinia blakeana</i>	2.75m	4m



Structure 1

Open shed

GFA: Not exceeding 180m²

Height: Not exceeding 6.5m

No. of storey: 1

Man gate

4 parking spaces of
5m x 2.5m for
private car/light van

staircase to
1/F

Structure 3

Toilet (under structure 1)

GFA: Not exceeding 5m²

Height: Not exceeding 3m

No. of storey: 1

Structure 2 (under structure 1)

GFA: Not exceeding 150m²

Height: Not exceeding 5.5m

No. of storey: 2

G/F - Store room

1/F - Site office

Project 项目名称:

On site
~~Proposed~~ Temporary Shop and
Services *Convenient Store* for a
Period of 3 Years at Lot 388K in D.D.
121 & Adjoining Government Land, Fui
Sha Wai South Road, Yuen Long, N.T.

Drawing Title 题目:

On site
~~Proposed~~ Landscape &
Tree Preservation Plan


Remarks 备注:

Drawing No. 图号:

Figure 4

Scale 比例:

1:1000

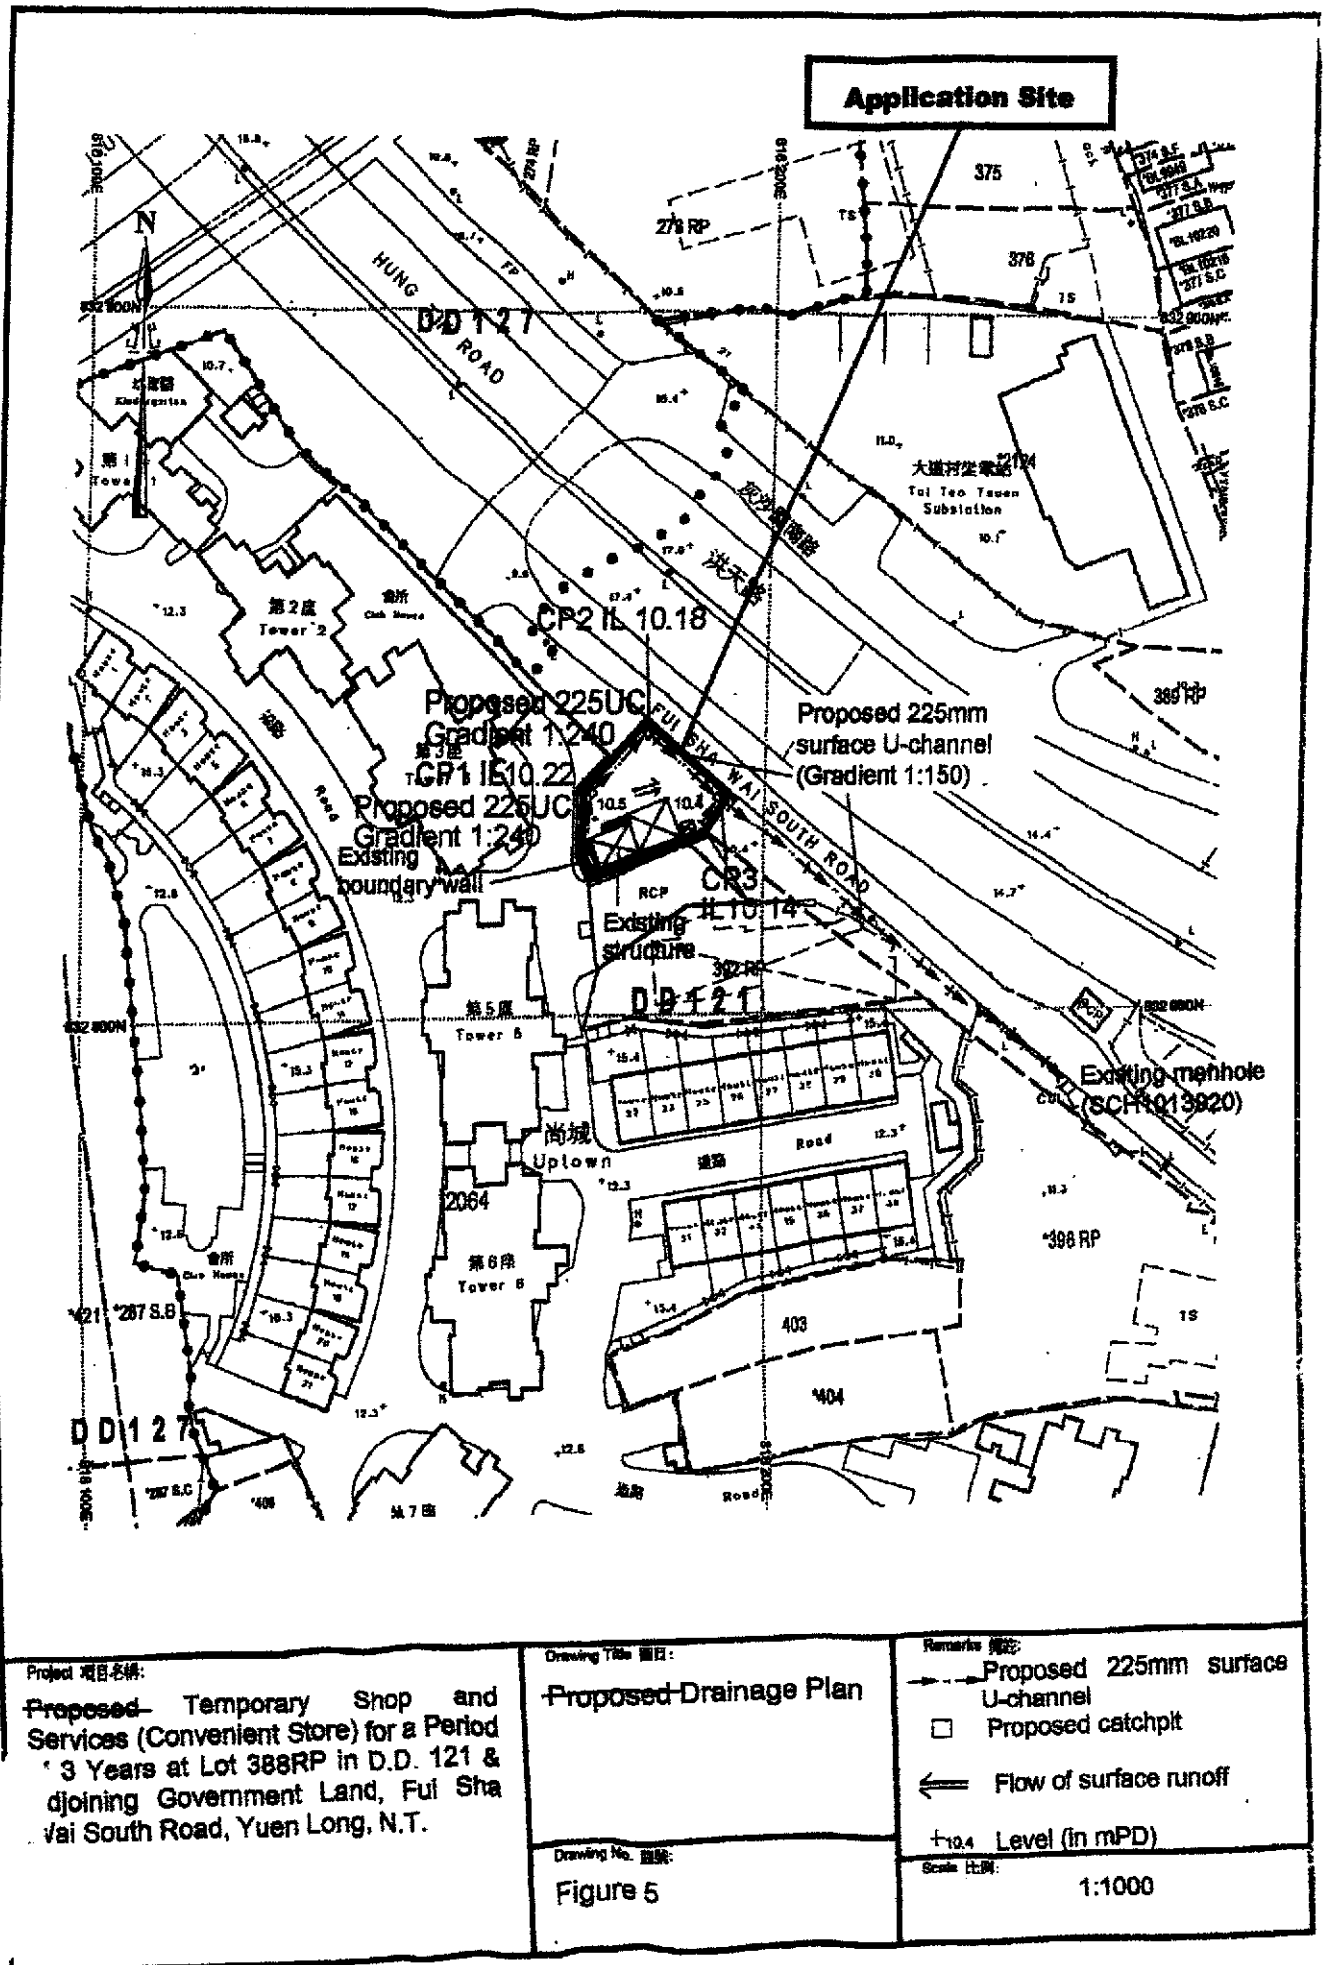



Structure 1

Open shed

GFA: Not exceeding 180m²

Height: Not exceeding 6.5m

No. of storey: 1

Proposed FSI: One 5kg carbon dioxide fire extinguisher

Man gate

4 parking spaces of
5m x 2.5m for
private car/light van

Cashier

Racks

staircase to
1/F

Structure 3

Toilet (under structure 1)

GFA: Not exceeding 5m²

Height: Not exceeding 3m

No. of storey: 1

Structure 2 (under structure 1)

GFA: Not exceeding 150m²

Height: Not exceeding 5.5m

No. of storey: 2

G/F - Store room (One 5kg carbon dioxide fire extinguisher)

1/F - Site office (One 5kg carbon dioxide fire extinguisher)

Project 223422:

Temporary Shop and
Services (Convenient Store) for a Period
of 3 Years at Lot 388RP in D.D. 121 &
Adjoining Government Land, Fui Sha
Wai South Road, Yuen Long, N.T.

Drawing Title 121:

Proposed Fire Service
Installations Plan

Drawing No. 121:


Figure 6

Remarks 121:


 5kg carbon dioxide
fire extinguisher

Scale 1:1000

1:1000

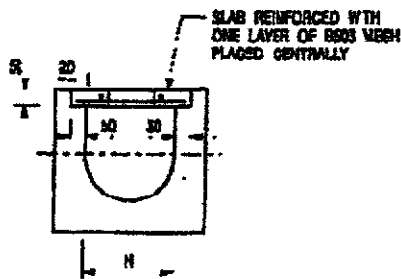


TYPICAL SECTION

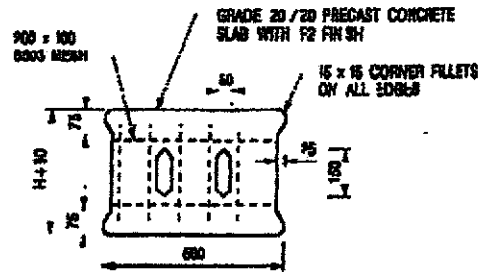

PLAN OF SLAB

U-CHANNELS WITH PRECAST CONCRETE SLABS

(UP TO H OF 525)

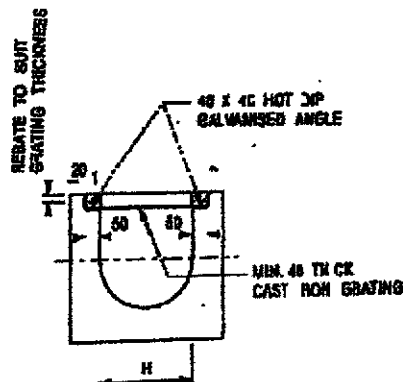


TYPICAL SECTION

(DIMENSIONS ARE FOR GUIDANCE ONLY. CONTRACTOR MAY SUBMIT EQUIVALENT TYPE)

U-CHANNEL WITH CAST IRON GRATING

(UP TO H OF 525)

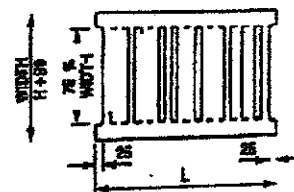

CAST IRON GRATING

NOTES:

1. ALL DIMENSIONS ARE IN MILLIMETRES.
2. H=NOYNA C-CHANNEL SLAB.
3. ALL CAST IRON FOR GRATINGS SHALL BE GRADE 152 TO BS 1452.
4. FOR COVERED CHANNELS TO BE HANDED OVER TO HIGHWAYS DEPARTMENT FOR MAINTENANCE, THE GRATING DETAILS SHALL FOLLOW THOSE AS SHOWN ON 1/40 STD. DRG. NO. 12233.

Project location:

Temporary Shop and Services (Convenient Store) for a Period of 3 Years at Lot 388RP in D.D. 121 & Adjoining Government Land, Fui Sha Wai South Road, Yuen Long, N.T.

Drawing title NO:

The Details of Gratings

Drawing No. (R/C):

Figure 7

Remarks (R/C):

Scale (R/C):

Not to scale