


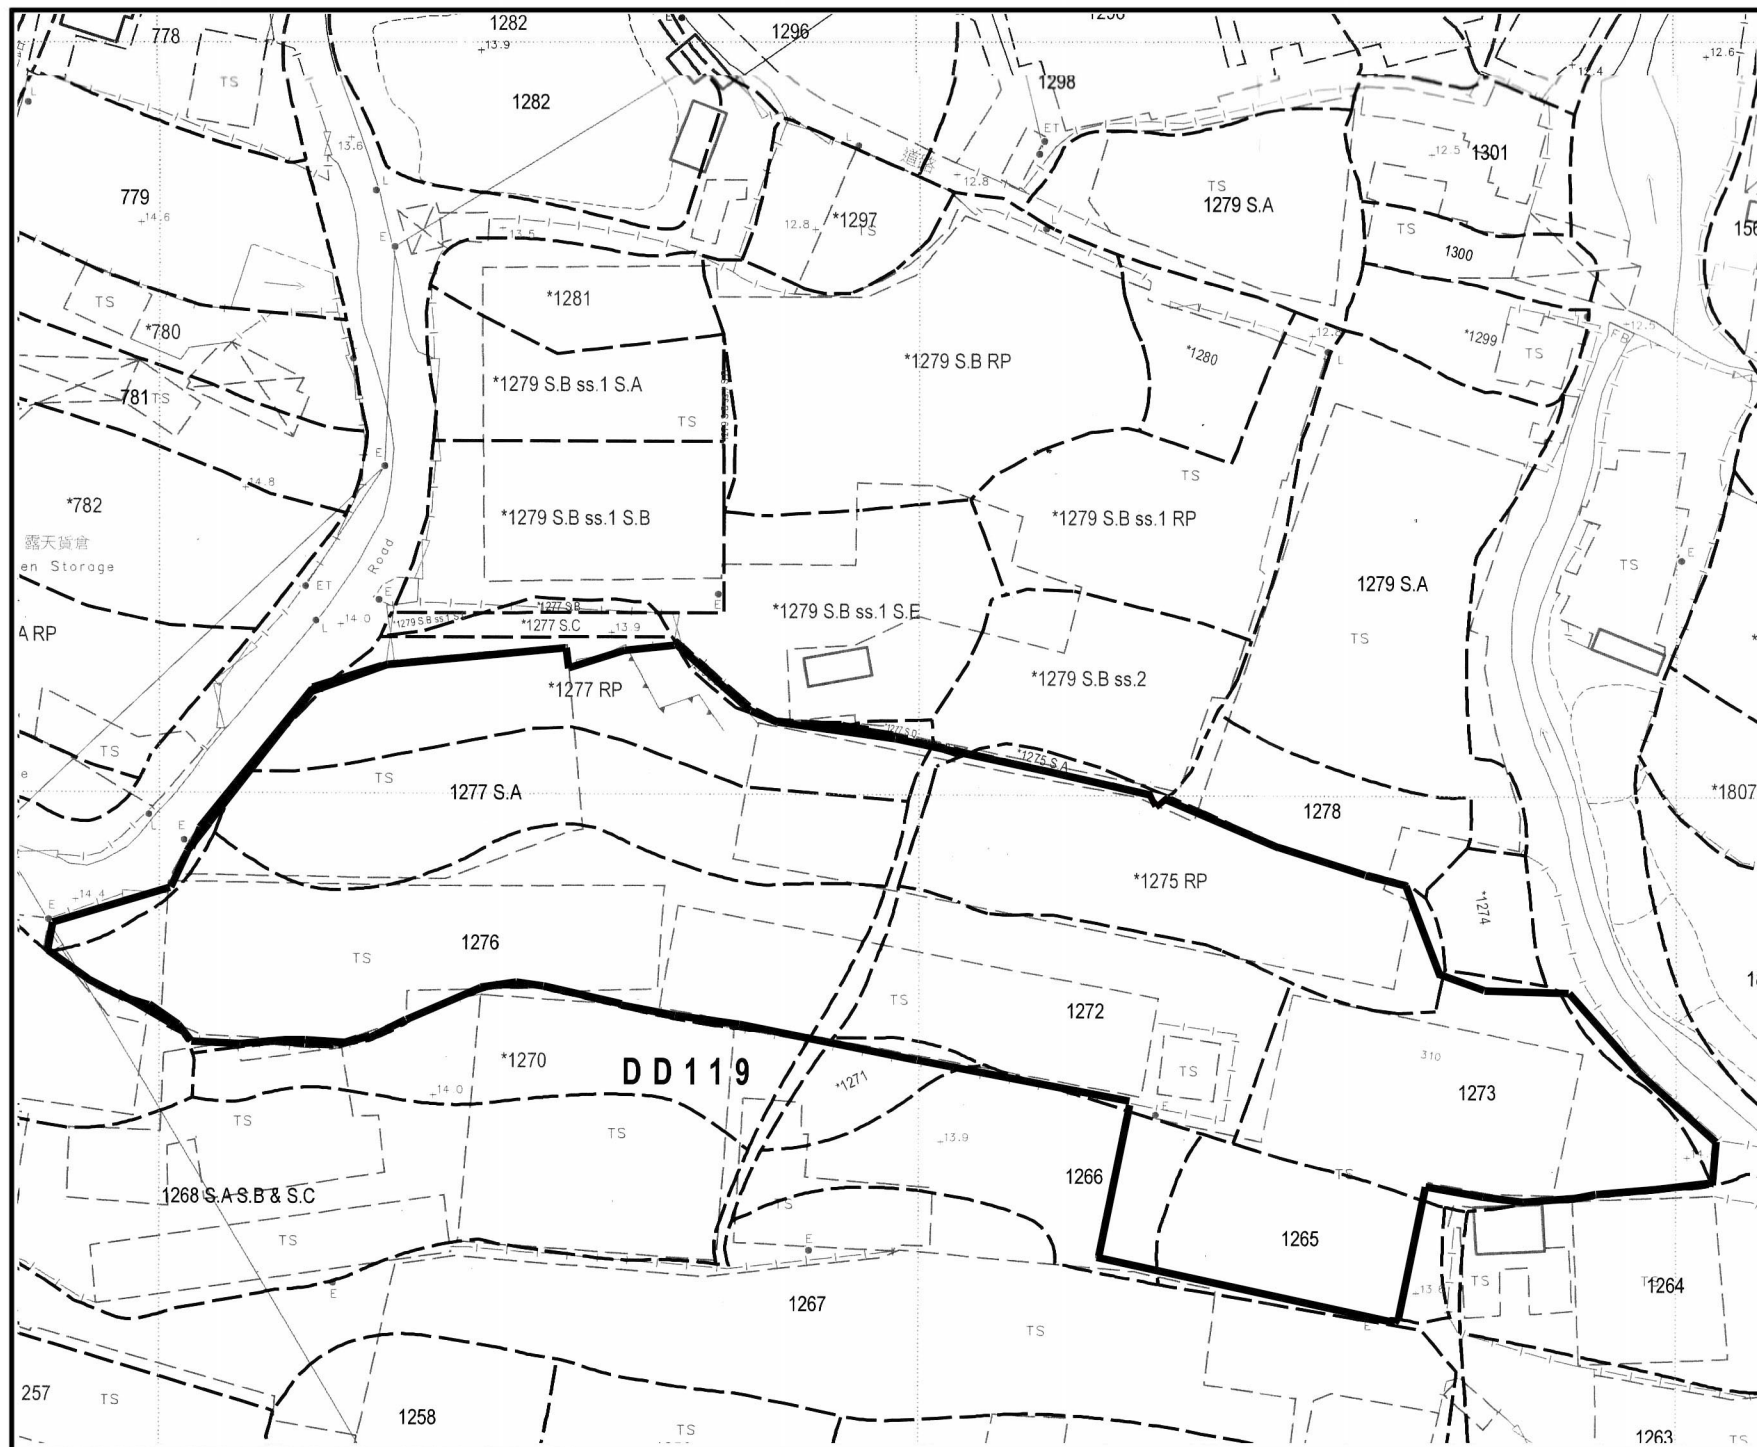

Drawing No.

Figure 1

Project

Temporary Warehouse for
Storage of Construction
Materials, Food Provisions,
Vehicles, Vehicle Parts
and Electronic Products
for a Period of 3 Years at
Lots 1265 (Part), 1266
(Part), 1269 (Part), 1270
(Part), 1271 (Part), 1272
(Part), 1273 (Part), 1275
RP (Part), 1276 (Part),
1277 S.A, 1277 RP (Part),
1279 S.B ss.1 S.F, 1279
S.B ss.2 (Part), 1279 S.B
ss.3 in D.D. 119 &
Adjoining Government
Land, Pak Sha Tsuen,
Yuen Long, N.T.


Drawing Title

Site Plan

Scale

1:1000

Remarks

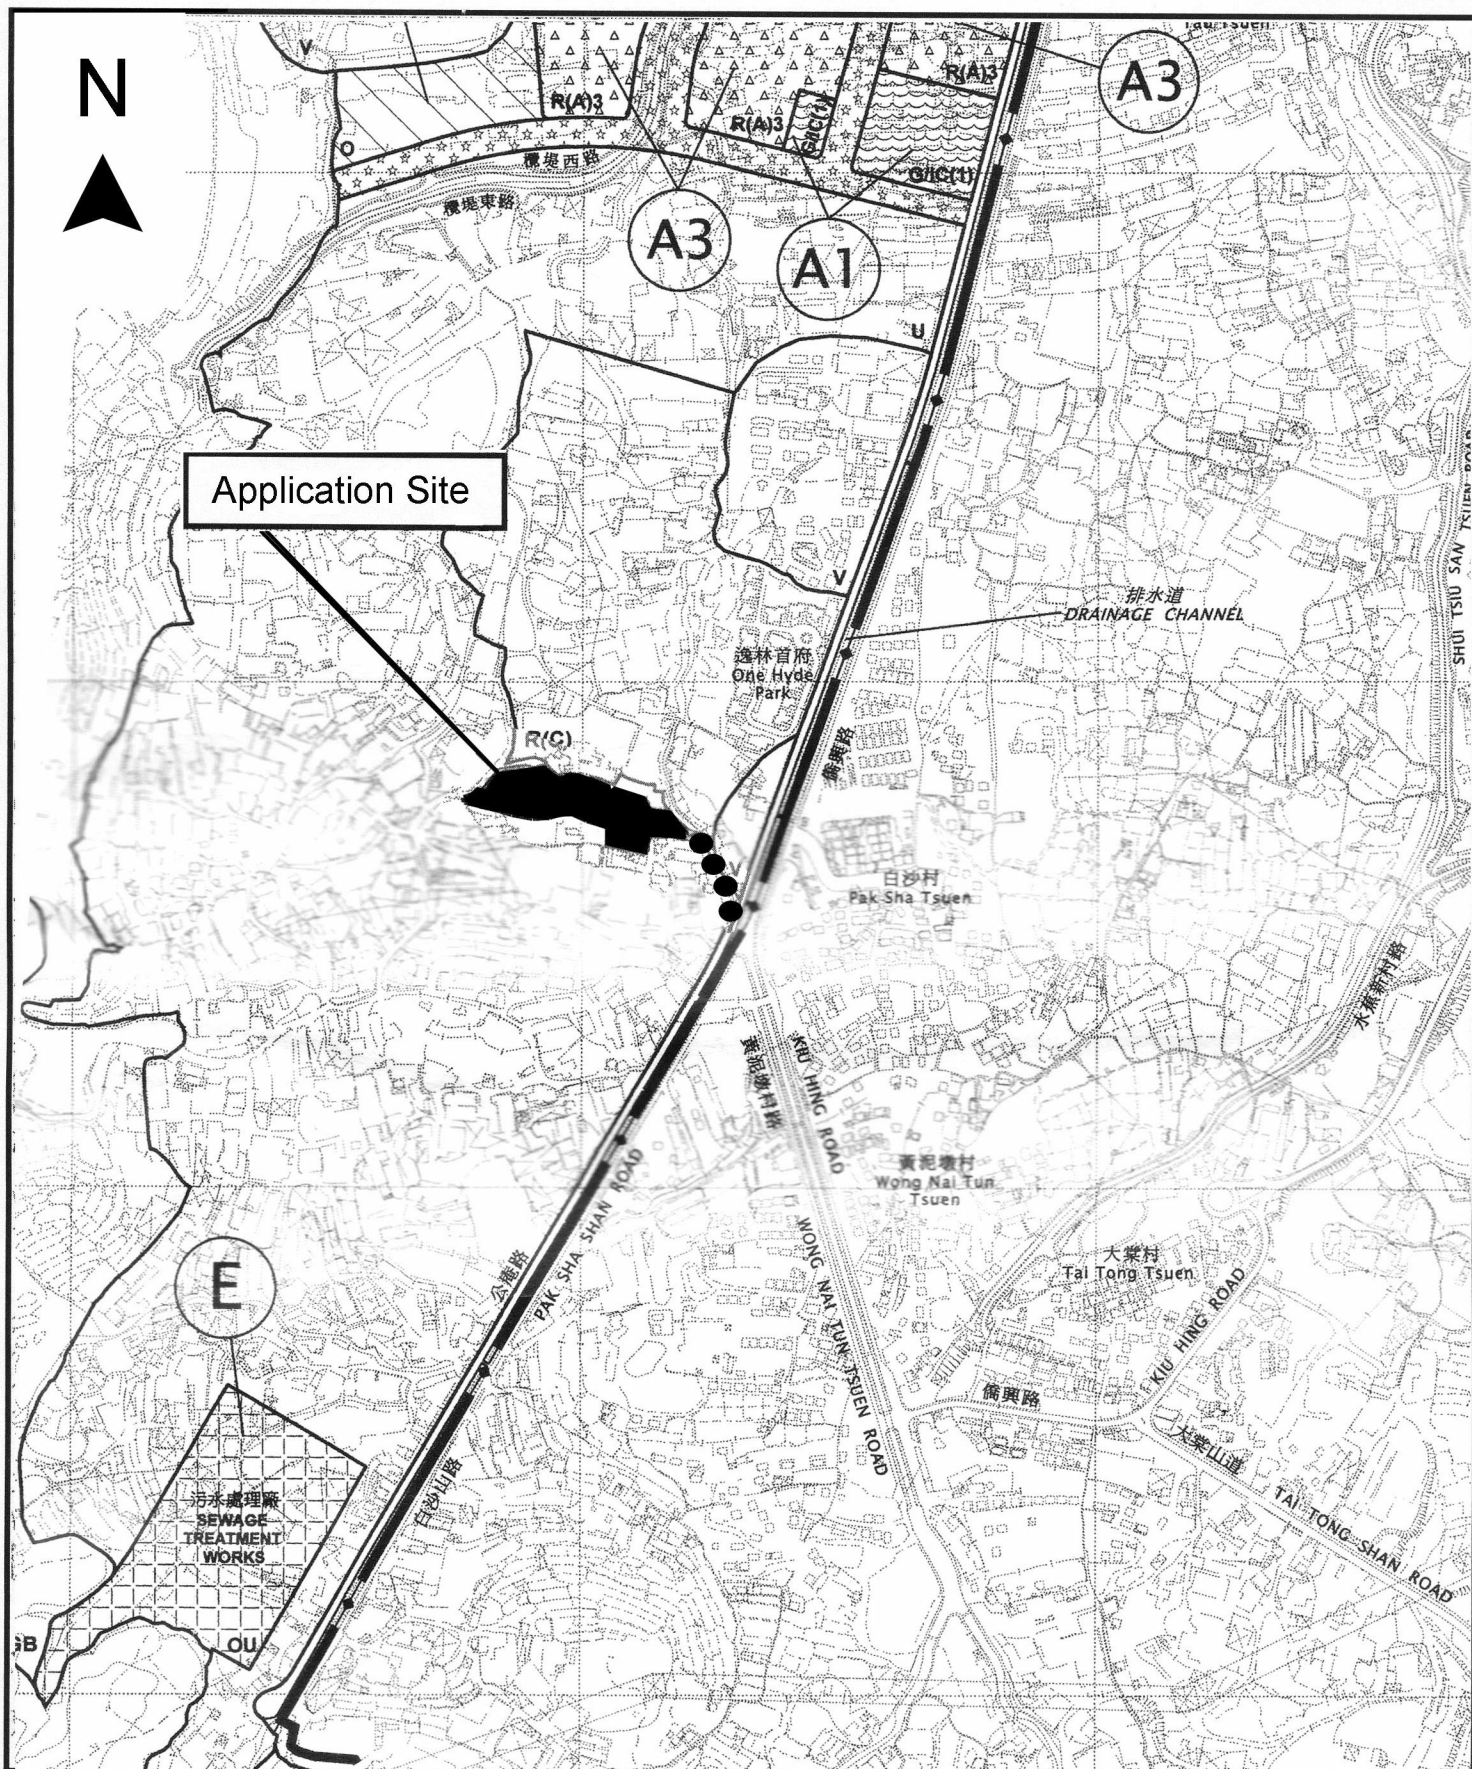

Project 項目名稱:

Temporary Warehouse for Storage of Construction Materials, Food Provisions, Vehicles, Vehicle Parts and Electronic Products for a Period of 3 Years at Lots 1265 (Part), 1266 (Part), 1269 (Part), 1270 (Part), 1271 (Part), 1272 (Part), 1273 (Part), 1275 RP (Part), 1276 (Part), 1277 S.A, 1277 RP (Part), 1279 S.B ss.1 S.F, 1279 S.B ss.2 (Part), 1279 S.B ss.3 in D.D. 119 & Adjoining Government Land, Pak Sha Tsuen, Yuen Long, N.T.

Drawing Title 圖目:

Location Plan

Drawing No. 圖號:

Figure 2


Remarks 備註:

●●● Vehicular Access Leading to Kung Um Road

Scale 比例:

1:7500

N

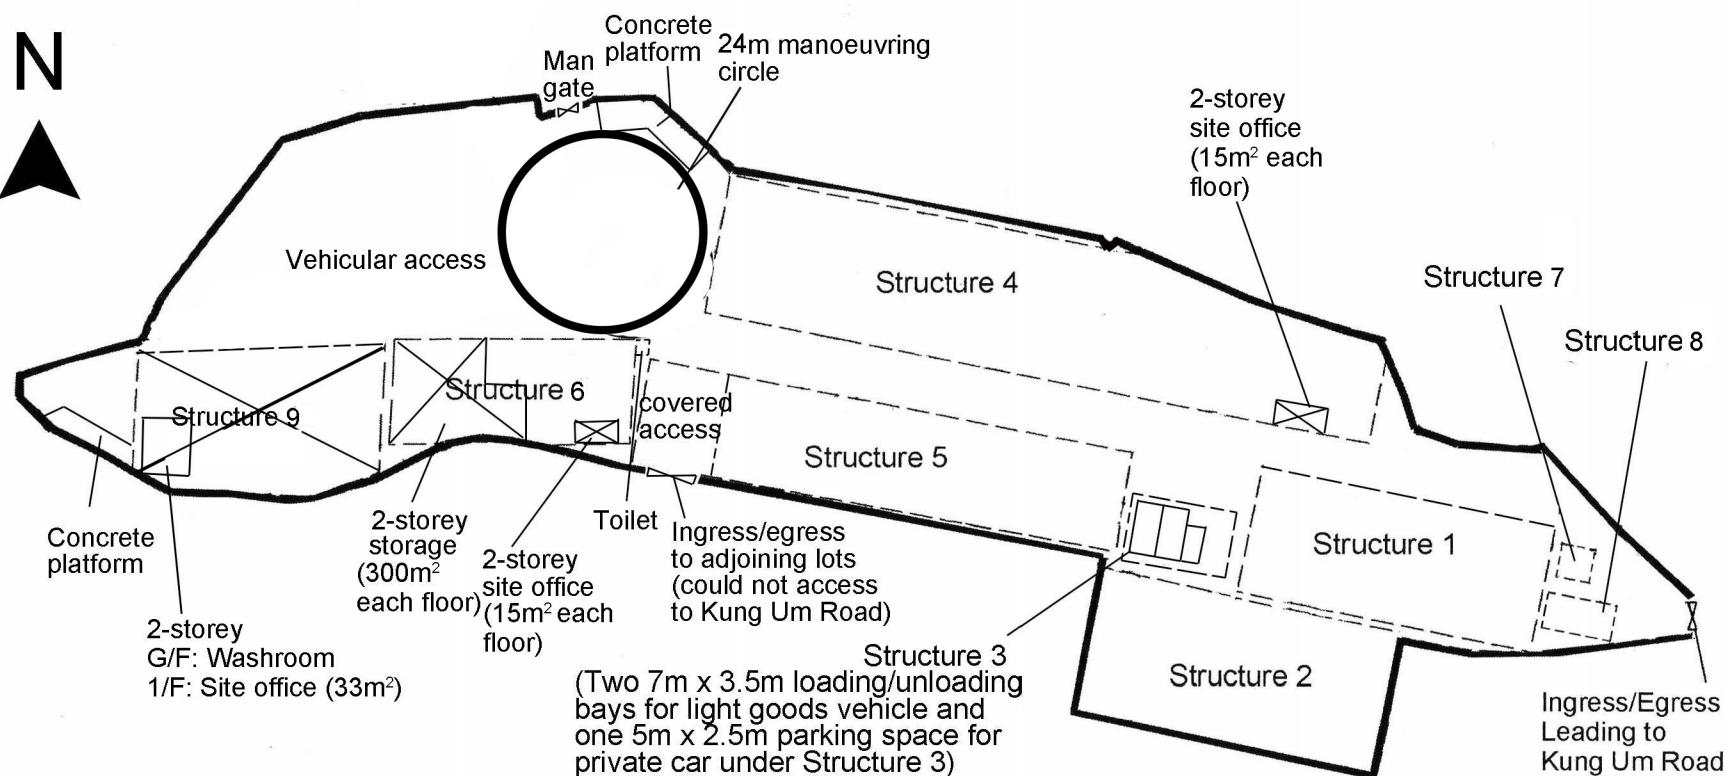

Structure No.	Proposed Use(s) of Temporary structure	Covered area	Non-domestic gross floor area (GFA)	Approximate height of temporary structure	No. of Storey
1	Warehouse for storage of electronic products	750m ²	750m ²	6.8m	1
2	Warehouse for storage of electronic products	835m ²	835m ²	6.8m	1
3	Open shed (rain shelter)	130m ²	130m ²	6m	1
4	Warehouse for storage of construction materials	1,308m ²	1,323 m ²	6.8m	2
5	Warehouse for storage of vehicle parts & covered access	928m ²	928m ²	6.8m	1
6	Warehouse for storage of construction materials and toilet	490m ²	805m ²	6.8m	2
7	Fire service installations (pump house)	20m ²	20m ²	3.5m	1
8	Fire service installations (water tank)	70m ²	70m ²	3.5m	1
9	Warehouse for storage of vehicle	630m ²	663m ²	6.8m	2

Drawing No.

Figure 3

Project

Temporary Warehouse for Storage of Construction Materials, Food Provisions, Vehicles, Vehicle Parts and Electronic Products for a Period of 3 Years at Lots 1265 (Part), 1266 (Part), 1269 (Part), 1270 (Part), 1271 (Part), 1272 (Part), 1273 (Part), 1275 RP (Part), 1276 (Part), 1277 S.A, 1277 RP (Part), 1279 S.B ss.1 S.F, 1279 S.B ss.2 (Part), 1279 S.B ss.3 in D.D. 119 & Adjoining Government Land, Pak Sha Tsuen, Yuen Long, N.T.


Drawing Title

Proposed Layout Plan

Scale

1:1000

Remarks

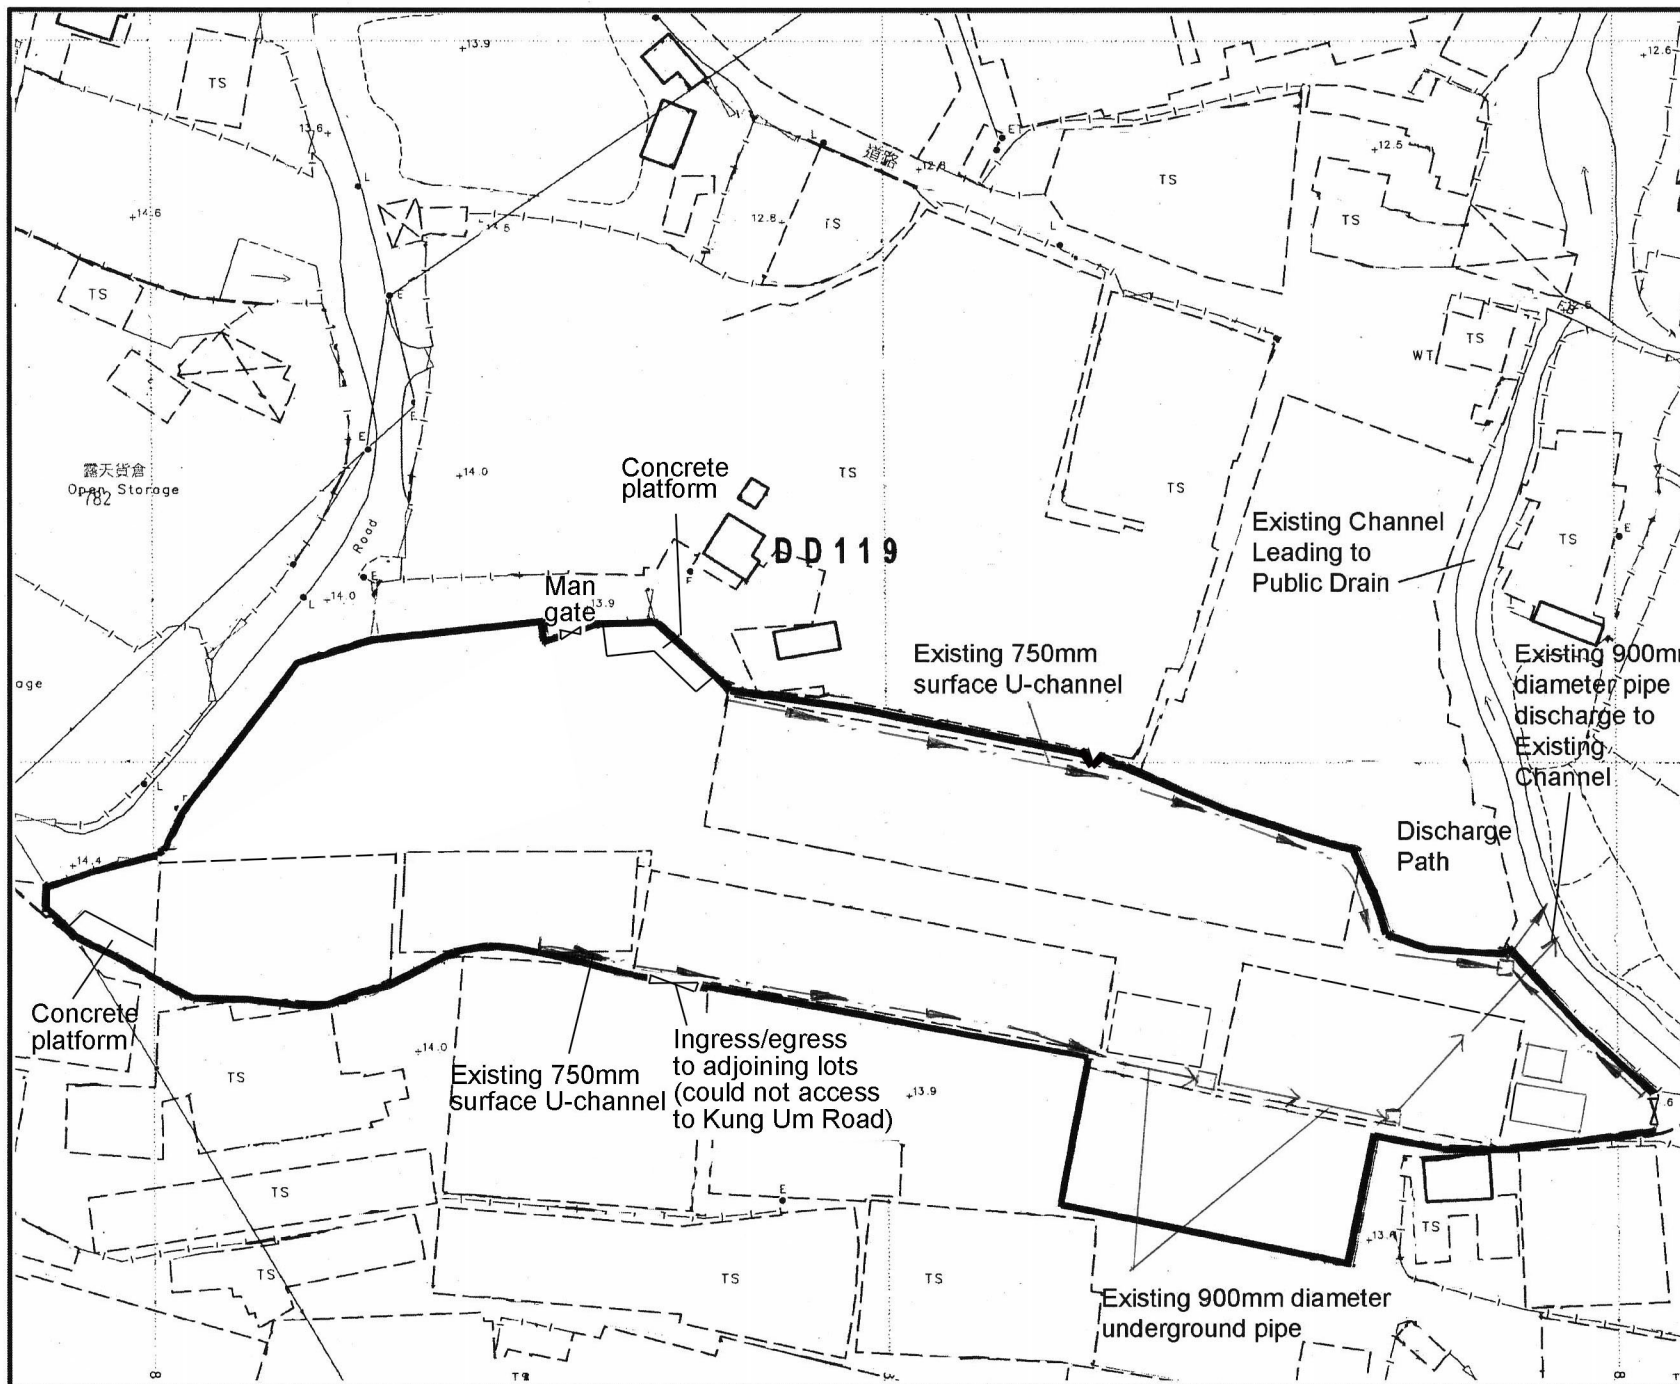

Drawing No.

Figure 4

Project

Temporary Warehouse for Storage of Construction Materials, Food Provisions, Vehicles, Vehicle Parts and Electronic Products for a Period of 3 Years at Lots 1265 (Part), 1266 (Part), 1269 (Part), 1270 (Part), 1271 (Part), 1272 (Part), 1273 (Part), 1275 RP (Part), 1276 (Part), 1277 S.A, 1277 RP (Part), 1279 S.B ss.1 S.F, 1279 S.B ss.2 (Part), 1279 S.B ss.3 in D.D. 119 & Adjoining Government Land, Pak Sha Tsuen, Yuen Long, N.T.

Drawing Title

As-built Drainage Plan

Scale

1:1000

Remarks

- Existing 750mm Surface U-channel
- Existing Manhole
- Existing 900mm diameter underground pipe
- ▭ Structure