

Table A

Responses-to-Comments (“R-to-C”) Table dated 12.5.2026

Application No. Y/YL-MP/11 Proposed Rezoning from “Residential (Group D)” to “Residential (Group C)2” Zone for Proposed Residential Development, Lot 4822 in D.D.104 and Adjoining Government Land, Mai Po, Yuen Long

Table A: Responses-to-Comments (12.5.2026)

Departmental Comments		Applicant’s Responses
A. Environmental Protection Department (“EPD”) (received on 16.4.2026)		
Air Quality		
1.	Table 2.2: The status of ASRs A12-A17 and A18 should be "Planned", please update.	Updated.
2.	Section 2.3.2: Please revise “minimize the adverse” in line 1 to “control the”. Same comment for line 6 of Section 4.2.3.	Revised.
3.	Section 2.3.5: For clarity, please revise “Kam Pok Road by >5m. There is also >5m building setback from” in lines 5-6 to “roads by more than 10m (buffer distance requirement for DD) including”.	Revised.
4.	Section 2.3.12: The separation distance should be measured from the proposed exhaust location of SPS to the ASRs. Please review and update the 2nd last sentence in lines 11-14. Figure 2.4 should also be updated as appropriate.	The separation distance measured between the ASR and the proposed exhaust location of the SPS is now stated in Section 2.3.12. The separation distance is also indicated in Figure 2.4, as well as Sections 2.3.12 and 2.3.13 accordingly.
5.	Section 4.2.3: Please correct the typo “programmer” in line 14.	Revised.
6.	Section 4.2.4: Please revise “adverse air quality” in line 1 to “potential air quality impact”.	Revised.

Application No. Y/YL-MP/11 Proposed Rezoning from “Residential (Group D)” to “Residential (Group C)2” Zone for Proposed Residential Development, Lot 4822 in D.D.104 and Adjoining Government Land, Mai Po, Yuen Long

Departmental Comments		Applicant’s Responses
7.	Figure 2.1: ASRs A01 to A11 should be the representative ASRs in construction phase and operation phase, please update the legend.	Legend in Figure 2.1 has been revised accordingly.
Land Contamination		
8.	RtC item 29 & Section – i) Please relocate Sections 5.1.2 & 5.1.3 under a separate sub-section titled "Land contamination". ii) Please confirm if it means no known potentially land contaminated activities in Section 5.1.3. If affirmative, please revise the second last sentence of section 5.1.3.	The sections have now been relocated to Section 5.4. It is confirmed that there is no known potential land contaminated activities conducted within the site. Section 5.4.2 has been revised.
SIA		
9.	RtC item 30 & Section 4.4 – i) Given that the planned sewerage arrangement under Planning Application Nos. Y/YL-NSW/7 and Y/YL-MP/10 are relevant and have been referenced in this SIA, please include the relevant information of such arrangements e.g. sewer alignment, manholes, invert level, pipe length etc. as an appendix of this SIA. ii) The initial estimation of 15,500 m ³ /day has accounted other developments in the same area.	i) Relevant information of the planned sewerage arrangements under Planning Application Nos. Y/YL-NSW/7 and Y/YL-MP/10, including sewer alignments, manhole details, invert levels, and pipe lengths, has been extracted and included in the new Appendix F of the revised SIA report for reference. ii) Section 4.4 is revised. The "estimated future average daily flow" of 15,500 m ³ /day has been adopted for the cumulative flow in

Application No. Y/YL-MP/11 Proposed Rezoning from “Residential (Group D)” to “Residential (Group C)2” Zone for Proposed Residential Development, Lot 4822 in D.D.104 and Adjoining Government Land, Mai Po, Yuen Long

Departmental Comments		Applicant’s Responses
	<p>Thus, please delete “, and Application Nos. Y/YL-MP/7 ...respectively”, “The estimated sewage ... in Appendix B.” and Appendix B. Please also adopt the “estimated future average daily flow” as 15,500 m³/day under Tables 4 to 6 as well as the hydraulic assessment.</p> <p>iii) Similar to Planning Application No. Y/YL-NSW/7, please state the proposed completion year of Planning Application No. Y/YL-MP/10.</p>	<p>Tables 4 to 8 and the updated hydraulic assessment in Appendix F.</p> <p>iii) The proposed completion year of Planning Application No. Y/YL-MP/10 (i.e., 2031) has been stated in Section 4.4 of the revised SIA report.</p>
10.	<p>RtC item 32 & Sections 7.3 & 7.4 –</p> <p>i) Please state the population intake year of Y/YL-MP/7, Y/YL-MP/8, which is not 2031.</p> <p>ii) Please revise the first sentence under Scenario 1 as "If this application is to be proceeded before all of the developments proposing the communal gravity sewer along Pok Wai Road South, the applicant will be responsible for the construction of the proposed PSL, subject to.....".</p> <p>iii) Please revise Scenario 2 as “ If Planning Application Nos. Y/YL-NSW7 and/or Y/YL-MP/10 are to be proceeded before this application, the hydraulic assessment in Appendix [X] indicates that the capacity of some sections of the communal</p>	<p>i) The population intake year in Section 7.3 is revised.</p> <p>ii) Scenario 1 and Scenario 2 in Section 7.4 have been revised according to the requested wordings to clarify the construction and upgrading responsibilities.</p> <p>iii) Section 7.4 is revised.</p>

Application No. Y/YL-MP/11 Proposed Rezoning from “Residential (Group D)” to “Residential (Group C)2” Zone for Proposed Residential Development, Lot 4822 in D.D.104 and Adjoining Government Land, Mai Po, Yuen Long

Departmental Comments	Applicant’s Responses
<p>gravity sewer are insufficient to accommodate the sewage flow. The applicant will be responsible for the upgrading works and liaising with the relevant developers proposing the communal gravity sewer on the construction responsibility before the commencement of construction.”</p> <p>iv) Scenarios 1 and 2 will suffice. Please delete Scenario 3.</p> <p>v) The hydraulic assessment for Scenario 1 should be consistent with the proposed sewers under Figure 3, i.e. from conversion chamber to FSH1001886 or from conversion chamber to manhole at Pok Wai West Road to FSH1001886. Please revise.</p> <p>vi) For hydraulic assessment for Scenario 2, please show the entire hydraulic assessment for this case of utilising proposed sewers under Y/YL-NSW7 and/or Y/YL-MP/10 with the sewer details provided under these planning applications. Please also conduct a hydraulic assessment proposing the upgrading works (if necessary) from the application site to FSH1001886 taking into account the sewage flow from other developments in the area.</p>	<p>iv) Scenario 2 & 3 in Section 7.4 is revised.</p> <p>v) Hydraulic assessment for Scenario 1 is revised.</p> <p>vi) Hydraulic assessment for Scenario 2 is revised.</p>

Application No. Y/YL-MP/11 Proposed Rezoning from “Residential (Group D)” to “Residential (Group C)2” Zone for Proposed Residential Development, Lot 4822 in D.D.104 and Adjoining Government Land, Mai Po, Yuen Long

Departmental Comments		Applicant’s Responses
11.	<p>RtC item 35 –</p> <p>i) Please provide reference for the population density of Elderly Activity Centre.</p> <p>ii) Please note that the UFF under Table T-2 of the GESF adopted for “Elderly Activity Centre” is applicable to employee. Please update the no. of population and relevant parts as appropriate considering it has included both elderly and staff in your response.</p>	<p>i) Table 2 is revised. A population density of 4 m²/person is adopted for the Elderly Activity Centre based on the Hong Kong Planning Standards and Guidelines (HKPSG) Chapter 3 regarding the Net Operating Floor Area (NOFA) requirements for elderly community centre.</p> <p>ii) The sewage flow estimation for the Elderly Activity Centre has been updated by separating the populations into staff and elderly guests, with respective Unit Flow Factors (UFF) applied as per the GESF to ensure the total flow accurately reflects both groups.</p>
12.	<p>Please note that the proposed development is covered under an EIA report approved (AEIAR-205/2017) and an Environmental Permit issued (EP-515/2017) under the EIAO. The Applicant should observe and ensure the proposed development will comply with the conditions in the EP and all statutory requirements under the EIAO.</p>	<p>Noted.</p>
<p>B. Water Supplies Department (“WSD”) (received on 20.4.2026)</p>		
1.	<p>The applicant has proposed sourcing water supply from the new DN300 freshwater main being laid for the approved application No. Y/YL-MP/10 near the junction of Kam Pok Road and Ha Chuk Yuen Road. However, to avoid interfacing problems and conflict due to programme mismatch between the two developers, we recommend that the subject applicant instead draw supply from the existing</p>	<p>The proposed development now proposes to draw water supply from existing DN300 freshwater main located along Castle Peak Road near Fairview Park Boulevard as per your recommendation. Accordingly, a 200mm dia. freshwater main is proposed to be constructed along Kam Pok Road and Ha San Wai Road to connect an existing 150mm diameter freshwater main, and the connection between existing 300mm diameter and 150mm diameter</p>

Application No. Y/YL-MP/11 Proposed Rezoning from “Residential (Group D)” to “Residential (Group C)2” Zone for Proposed Residential Development, Lot 4822 in D.D.104 and Adjoining Government Land, Mai Po, Yuen Long

Departmental Comments		Applicant’s Responses
	DN300 freshwater main located along Castle Peak Road, near Fairview Park Boulevard— to ensure greater certainty in service provision. This requires laying of a new DN200 FWM along Ha San Wai Road to connect the existing DN150 FWM near Lamp Post VG6564 and the connection of existing DN300 and DN150 FWMs near PH 11306.	freshwater main near the Fairview Park Boulevard. Please find attached revised WSIA.
C. Urban Design and Landscape Section, Planning Department (“UD&L, PlanD”) (received on 20.4.2026)		
<i>Landscape Perspective</i>		
1.	We have no adverse comments in principle on the application from landscape planning perspective. Our detailed comments are as follows:	
(i)	with reference to the aerial photo taken in 2025, the application site (the Site) is located in an area of miscellaneous rural fringe landscape character comprising village houses, ponds, river, temporary structures and scattered tree groups. The proposed development of eight building blocks with a maximum of 16 storeys will alter the existing landscape character of the area;	Noted.
(ii)	according to the Landscape Proposal, 247 existing trees of common species were surveyed within the Site. Among them, 80 trees will be retained, and 154 and 13 existing trees are proposed to be felled and transplanted respectively. To mitigate the landscape impacts, 437 new trees are proposed within the Site to achieve a compensation ratio of not less than 1:1 (154 felled trees: 437 new trees). Landscape treatment including landscape	Noted.

Application No. Y/YL-MP/11 Proposed Rezoning from “Residential (Group D)” to “Residential (Group C)2” Zone for Proposed Residential Development, Lot 4822 in D.D.104 and Adjoining Government Land, Mai Po, Yuen Long

Departmental Comments		Applicant’s Responses
	buUer areas, tree and shrub plantings, lawn, swimming pool and water features are proposed; and	
(iii)	notwithstanding the above, it is noted from the aerial photo taken in 2024 that a pond surrounded by trees and vegetation was found in the southern part 2 of the Site. However, as observed from the aerial photos taken in 2025, the pond could no longer be found and the Site has been largely formed.	Noted.
(iv)	Approval of the application does not imply approval of tree works such as pruning, transplanting and felling. The applicant is reminded to seek approval for any proposed tree works from relevant departments prior to commencement of the works.	Noted.
D. Transport Department (“TD”) (received on 24.4.2026)		
1.	RtC item 1 - Provided that the captioned s.12A application has been accepted by TPB, no s.16 planning application is required for the proposed use in the subject site. Please explain when is the "subsequent detailed design stage" in your response.	Please be advised that the detailed design of internal road layout including carpark design/drop-off layout/access arrangement will be formulated in real construction practice in the subsequent building plan submission which will be circulated by BD to relevant government departments (including TD) for comments. The “subsequent detailed design stage” means the Building Plan Submission stage.
2.	RtC item 2 and Para 2.3.3 - Considering the location of the site is in close proximity to the Fairview Park Boulevard, the proposed left turn ban will involve a major detour for vehicles entering the Fairview Park Interchange. As such,	Given that Fairview Park Boulevard is a private road, development traffic using it to access Fairview Park Interchange should be avoided. As such, a left-tun ban is proposed at the main access. To facilitate the proposed left-turn ban, the vehicular access design has been revised such that vehicles will be restricted by a physical island to turn left from the development access. A

Application No. Y/YL-MP/11 Proposed Rezoning from “Residential (Group D)” to “Residential (Group C)2” Zone for Proposed Residential Development, Lot 4822 in D.D.104 and Adjoining Government Land, Mai Po, Yuen Long

Departmental Comments		Applicant’s Responses
	the proposal to ban the left turn movement is highly undesirable from traffic engineering point of view.	‘No left-turn’ traffic sign will also be proposed at the opposite side of the main access. The revised access design is illustrated in Appendix A of TIA .
3.	Junction assessment at the site main entrance in Design Year is missing. Please supplement. Please include queue length assessment for this junction (i.e. queue length on eastbound and westbound of Kam Pok Road during peak hour). Necessary measures should be proposed and implemented to avoid vehicles queuing on public road.	<p>The junction at the site main entrance (J8) has been included in the junction assessments and queue length assessments. Please refer to Section 5 of the revised TIA.</p> <p>Kam Pok Road eastbound and westbound are major arms, which have continual priority over the traffic on the minor road. No potential traffic queue at major arms of Kam Pok Road is expected.</p>
4.	RtC item 2 - With the proposed left-turn ban at the development egress, vehicles leaving the site is likely to queue at the main entrance area (i.e. as this is the least priority movement in a priority junction). Please demonstrate how to prevent grid lock situation at the site main entrance during peak hour.	The internal road layout will be reviewed during the detailed design stage. The layout will be designed in such a way as to avoid queueing of vehicles and tailing back onto public roads. The relevant remark is indicated in the Appendix B1 - Traffic Plan of TIA
5.	RtC item 3 - Our comment has not been addressed. Please follow up and provide explanation on why the RCF is revised.	<p>Please note that the parameters adopted in the junction assessment have been reviewed and revised. The RCF was therefore revised under the previously submitted TIA.</p> <p>The total in/out flow at Fairview Park Interchange during PM peak has been reviewed and compared with the flows adopted in the traffic impact assessment under the recently approved application Y/YL-MP/10 nearby. The total flows and RCF are found to be similar, as summarized in the table below.</p>

Application No. Y/YL-MP/11 Proposed Rezoning from “Residential (Group D)” to “Residential (Group C)2” Zone for Proposed Residential Development, Lot 4822 in D.D.104 and Adjoining Government Land, Mai Po, Yuen Long

Departmental Comments		Applicant’s Responses														
			<table border="1"> <thead> <tr> <th></th> <th colspan="2">PM Peak</th> </tr> <tr> <th></th> <th>Total In/Out Observed Flows at Roundabout</th> <th>RFC</th> </tr> </thead> <tbody> <tr> <td>Latest TIA</td> <td>3980</td> <td>0.61</td> </tr> <tr> <td>TIA report under Y/YL-MP/10</td> <td>3880</td> <td>0.68</td> </tr> </tbody> </table>			PM Peak			Total In/Out Observed Flows at Roundabout	RFC	Latest TIA	3980	0.61	TIA report under Y/YL-MP/10	3880	0.68
	PM Peak															
	Total In/Out Observed Flows at Roundabout	RFC														
Latest TIA	3980	0.61														
TIA report under Y/YL-MP/10	3880	0.68														
6.	RtC item 4 - Please seek PlanD's comments/agreement on the key development parameters in Table E1. Please append the correspondence from PlanD for record purpose.	<p>Comments from PlanD have been sought as shown in Annex 1. The Table E1 has been revised and incorporated the comments from PlanD accordingly.</p> <p>For Item 14 (Ngau Tam Mei Area NDA), the “Integrated Hospital” in the last submitted TIA refers to integrated medical teaching and research hospital and third medical school. Both trip generations of third medical school and GIC facilities have already been considered in the traffic forecast.</p>														
7.	<p>RtC item 5 - Based on the "TIA Checklist for Development Project" (February 2026 Edition) - Study Aspects (i) Modelling Methodolgy (for medium and large scale developments), development shall fulfill all the criteria listed therein for not requiring two-tier transport model. Please note our follow up comments below:-</p> <p>(i) Criteria II: Instead of using the net flow difference between the approved scheme and proposed scheme, the estimated flows generated from the proposed development should be used to assess the flow on strategic roads. Please supplement.</p>	<p>(i) The development flows of the proposed scheme are presented in Appendix F of TIA. As shown in Appendix F of TIA, the estimated traffic flows generated from the proposed development on adjacent strategic road (San Tin Highway) is less than 100 pcu at the critical bound during peak hour.</p>														

Application No. Y/YL-MP/11 Proposed Rezoning from “Residential (Group D)” to “Residential (Group C)2” Zone for Proposed Residential Development, Lot 4822 in D.D.104 and Adjoining Government Land, Mai Po, Yuen Long

Departmental Comments		Applicant’s Responses
	(ii) Criteria III: Given the subject development propose road improvement on Fairview Park Interchange, i.e. involve slip roads to strategic road network, please explain why the captioned planning application fulfilled this criteria.	(ii) Please note that there is no change in the road configuration/lane width of the slip roads to San Tin Highway under the junction improvement works at Fairview Park Interchange. As such, the captioned planning application fulfilled this criteria III.
8.	RtC item 6 - The comment is not addressed. Please explain how the proposed drop-off area can accommodate expansion. Please review and revise the layout to ensure sufficient space remains for other vehicles to pass by safely when a bus/ shuttle bus is stopped at the pick up/ drop off location. Please demonstrate the above with swept path analysis.	<p>The proposed drop-off area under the scheme is intended for bus pick-up/drop-off only. No other vehicles will use this drop-off area.</p> <p>The layout and size of the drop-off area will be reviewed during the detailed design stage, taking into account the future bus service provided. The area will be of appropriate size and designed in such a way as to avoid queueing of vehicles and tailing back onto public roads. Also, should the drop-off area be changed to be used by other vehicles in subsequent detailed design stage, the design will ensure that sufficient space remains for other vehicles to pass safely when a bus/shuttle bus is stopped.</p>
9.	RtC item 13 - Noted only 2m wide footpath is reserved in the proposed PU/DO location. Please note that a minimum of 500mm horizontal clearance should be reserved from carriageways and therefore should not be counted as queuing area. Moreover, it is not justify to count the full width of footpath as the queuing area since there would be people using this footway to connect to other parts of the site. Please critically review the layout of PU/DO area and re-assess the LOS of queuing area.	<p>A 3.5m wide footpath is proposed to be reserved in the PU/DO area as indicated in Appendix B1 – Traffic Plan and Appendix B7 of TIA, which allows 1.5m for pedestrian bypassing and 2m for queueing area.</p> <p>The reserved queuing area is about 37m long and 2m wide (i.e. 1m effective width by assuming 0.5m lateral clearance on both sides). Based on the average pedestrian space of 0.6 m²/p under satisfactory LOS C, the queuing area could serve at capacity of 61 persons (i.e. 37m x 1m ÷ 0.6 m²/p), which should be sufficient to accommodate the anticipated passenger demand of about 21 passengers during peak hours.</p>

Application No. Y/YL-MP/11 Proposed Rezoning from “Residential (Group D)” to “Residential (Group C)2” Zone for Proposed Residential Development, Lot 4822 in D.D.104 and Adjoining Government Land, Mai Po, Yuen Long

Departmental Comments		Applicant’s Responses
10.	RtC item 14 - To support the statement of "The proposed drop-off area could accommodate 2 buses as illustrated in Appendix F of the revised TIA,...", please supplement the swept path analysis for bus boarding/alighting activities.	<p>The size of the drop-off area has been revised to allow 2 nos. buses driving out from the drop-off point independently, as indicated in Appendix B1 - Traffic Plan of TIA, and the relevant swept paths are indicated in Appendix B2 & B3 of TIA.</p> <p>The layout and size of the drop-off area will be further reviewed during the detailed design stage, taking into account the future bus service provided.</p>
11.	Para 2.3.1 - Please justify the reason for providing two vehicular access in the subject site. Please clearly state what kind of vehicles would use the second entrance on Ha Chuk Yuen Road and its frequency of the trips generation.	<p>The vehicular access arrangements in the current proposed scheme are basically permitted under the present government lease. The vehicular access at Kam Pok Road is the access for residential use and kindergarten. Whilst, the access at Ha Chuk Yuen Road is reserved for the proposed elderly activity centre (EAC) to separate its traffic from residential use.</p> <p>Considering the nature of the EAC and current vehicle restriction at Ha Chuk Yuen Road, it is expected that EAC will primarily be used by private cars, taxis, and light goods vehicles not exceeding 7 m in length. The EAC mainly serves the local community, its trip generation is thus expected to be limited. Also, the peak hour of EAC is not expected to coincide with commuting peak hour, it is estimated at about 20 pcu per hour (two-way) during the peak hour under assessment.</p>
12.	Table 3.3 - In accordance to TPDM Vol. 2 Ch. 3.11, a single track road with adequate passing places can accommodate 2-way flows of 100 vehicles per hour. Nonetheless, it should not be used as a design figure. Hence, please review	Currently the widths of Fung Chuk Road and Ha Chuk Yuen Road are min. 3.5m. Passing places are also provided along two roads. Additional passing places have also been proposed on both roads under this project as enhancement. It is considered that both roads are standard single track access roads with adequate passing place, and thus the design flow of 100

Application No. Y/YL-MP/11 Proposed Rezoning from “Residential (Group D)” to “Residential (Group C)2” Zone for Proposed Residential Development, Lot 4822 in D.D.104 and Adjoining Government Land, Mai Po, Yuen Long

Departmental Comments		Applicant’s Responses
	the road link capacity of L4 and L5 based on the actual road geometry and configuration.	vehicles/hr in 2-way for single track road, as stipulated in TPD, is considered appropriate to be adopted in the link flow assessments.
13.	In view of the existing single track access road of Fung Chuk Road and your proposed secondary access, please consider providing passing bay on Fung Chuk Road as road improvement measures.	An additional passing place at Fung Chuk Road is proposed under this project as enhancement. The improvement layout at Fung Chuk Road is illustrated in Drawing 5.7 of TIA
14.	For vehicle leaving the site from the second vehicular access, motorists very likely would use the most direct route (i.e. Ha Chuk Yuen Road) to connect to Castle Peak Road - Tam Mi. In view of the single track access road nature of Ha Chuk Yuen Road, please consider provide passing bay as road improvement measures, in particular near the junction between Kam Pok Road/ Ha Chuk Yuen Road.	The junction Kam Pok Road/Ha Chuk Yuen Road (J5) is proposed to be minor widened to allow 7m vehicles to turn from Kam Pok Road onto Ha Chuk Yuen Road without being obstructed by the vehicle waiting to exit, and to provide placing place. Please refer to Drawing 5.6 of TIA .
15.	Drawing No. 3.1 - The proposed ingress routing using Castle Peak Road - Tam Mi and Kam Pok Road is much longer than the route on Fairview Park Boulevard. Please justify the proposed routing and recommend necessary traffic measures to ensure motorists would follow the proposed ingress routing.	Please be advised that the ingress routing will not be via Fairview Park Boulevard, as right turn is prohibited from Fairview Park Boulevard westbound onto Kam Pok Road northbound. The major ingress route will be via Castle Peak Road – Tam Mi and Kam Pok Road.
16.	Para 4.2.1 - Please elaborate what adjustment has been applied into the traffic forecast to reflect the situation of Toll Plans Changes for Tai Lam Tunnel.	Due to the limited information/planning assumption available in public domain, manual assignment was carried out to picture the traffic impact for the revised toll of Tai Lam Tunnel with reference to “Preliminary Traffic Assessment” as detailed in LegCo Paper No. CB(1)976/2024(05).

Application No. Y/YL-MP/11 Proposed Rezoning from “Residential (Group D)” to “Residential (Group C)2” Zone for Proposed Residential Development, Lot 4822 in D.D.104 and Adjoining Government Land, Mai Po, Yuen Long

Departmental Comments		Applicant’s Responses
		As presented in the LegCo paper, traffic volumes of Tolo Highway (Tai Po Kau section) and Tuen Mun Road are expected to decrease after the toll change. The estimated v/c ratio will be lowered from 1.05 to 1.02 for Tolo Highway and from 1.2 to 1.15 for Tuen Mun Road. Based on the above findings, it is anticipated that some traffic trips on San Tin Highway originally via Tuen Mun Road and Tolo Highway would be diverted via Tai Lam Tunnel to/from urban areas. The resulting impact on San Tin Highway (particularly the section adjacent to the application site) is considered limited after the toll change.
17.	Para 4.2.2 - Please elaborate what is the impact of NOL on BDTM.	The NOL will offer a faster and more sustainable alternative to current road-based transit for residents and commuters in the Northern New Territories. Upon the commissioning of NOL, a modal shift from road-based transport to the railway network is expected. This shift will help relieve traffic loadings on major northern traffic corridors, such as San Tin Highway.
18.	Year 2034 Traffic Forecast: Assuming one-tier modelling approach is accepted, please elaborate how to forecast the traffic in Year 2034 by simply using BDTM. Please supplement the associated methodology and assumption been made in the traffic forecast.	The methodology and assumption of the traffic forecast have been further elaborated. Please refer to Section 4.2 for details.
19.	Para 5.1.18 - Please seek LandsD's agreement the proposed junction improvement work could be covered in the land transaction.	The planning application has been circulated to LandsD under same submission, and no specific adverse comment on the application has been received. Liaisons with LandsD on the proposed junction improvement works will be conducted during subsequent land transaction process.

Application No. Y/YL-MP/11 Proposed Rezoning from “Residential (Group D)” to “Residential (Group C)2” Zone for Proposed Residential Development, Lot 4822 in D.D.104 and Adjoining Government Land, Mai Po, Yuen Long

Departmental Comments		Applicant’s Responses
20.	Plan 5.5 - It appears that the proposed junction improvement works encroaches upon the 新田區居民協會康樂中心 . Please critically review the feasibility of the improvement works. If the existing buildings/ structures are affected, please confirm with relevant departments on the reprovisioning arrangement, as appropriate.	The proposed junction improvement works has been revised to avoid encroaching onto the 新田區居民協會康樂中心. Please refer to the revised Drawing 5.6 of TIA.
21.	Please provide the routing for vehicles from main entrance to basement car park.	The routing for vehicles from main entrance to basement car park has been indicated in Appendix B1 – Traffic Plan of TIA.
22.	<p>Appendix A:</p> <p>(i) Please specify the vehicle speed adopted for each case of the analysis;</p> <p>(ii) The swept path only present 7m vehicle at internal road. Please confirm there would be no vehicle longer than 7m would use the internal road;</p> <p>(iii) Based on the results of the swept path, please revise the width of driveway at the bend.</p> <p>(iv) Please advise whether there would be any designated loading/unloading spaces proposed in this area. Please supplement swept path analysis for the scenario that there are vehicles parked there.</p>	<p>(i) The vehicle speed adopted in the swept path analysis at internal roads is 8 km/hr.</p> <p>(ii) The L/UL bays for HGV (coloured orange) are proposed along the main driveway on ground floor plan as shown in Appendix B1 – Traffic Plan of TIA, and 11m HGV would use the internal road. The width of driveway at the bend has been revised to allow smooth manoeuvring as indicated in the Appendix B1 – Traffic Plan of TIA. Swept path analysis for 11m HGV and a 7m vehicle is presented in Appendix B5 & B6 of TIA.</p> <p>(iii) Please refer to our response in above (ii)</p> <p>(iv) No designated loading/unloading space is needed and proposed on the access road connecting to the access at Ha Chuk Yuen Road. As shown in swept path analysis at the access (Appendix B4 of TIA),</p>

Application No. Y/YL-MP/11 Proposed Rezoning from “Residential (Group D)” to “Residential (Group C)2” Zone for Proposed Residential Development, Lot 4822 in D.D.104 and Adjoining Government Land, Mai Po, Yuen Long

Departmental Comments		Applicant’s Responses
		<p>the 7m vehicle can perform smooth manoeuvring into and out from site, even if there are any other vehicles on the road.</p> <p>The design of the access road will be reviewed in the detailed design stage. The road area will be of appropriate size and designed in such a way as to avoid queuing of vehicles and tailing back onto public roads. The relevant remark has also been indicted in Appendix B1 – Traffic Plan of TIA.</p>
23.	<p>Master Layout Plan:</p> <p>(i) There is a ramp connecting to the basement car park at the eastern portion of the main entrance area. The sightline for vehicle ramping up from the basement is inadequate. Please review the layout holistically.</p> <p>(ii) Please advise whether drop bar would be proposed at the main entrance. If yes, please advise the location of drop bar and make sure there would be sufficient area for vehicle to queue without disturbing the traffic on public road.</p> <p>(iii) Apart from bus/ shuttle bus, please advise what other kinds of vehicle, i.e. taxi/ private car, is allowed to use the proposed PU/DO area at the main entrance (i.e. next to the landscape area). Please review the layout holistically.</p>	<p>(i) Noted. The design of the ramp and road location will be reviewed in the detailed design stage. Detailed design of the ramp will ensure that adequate sightline are provided for vehicles going up from the car ramp. The relevant remark is indicated in the Appendix B1 - Traffic Plan of TIA.</p> <p>(ii) Please be advised that there is no intention to provide a drop bar at the main entrance at this planning stage. Should a drop bar be proposed during the subsequent detailed design stage, sufficient area will be provided for vehicle to queue without affecting the traffic on public road.</p> <p>(iii) Please refer to our reply in above Item (8).</p>

Application No. Y/YL-MP/11 Proposed Rezoning from “Residential (Group D)” to “Residential (Group C)2” Zone for Proposed Residential Development, Lot 4822 in D.D.104 and Adjoining Government Land, Mai Po, Yuen Long

Departmental Comments		Applicant’s Responses
	<p>(iv) The proposed layby for kindergarten does not consider the PU/DO activities. Please review the layout.</p> <p>(v) Based on the current layout, there are many conflicting points at the main entrance area, including but not limited to vehicle entering and leaving the site, vehicle entering and leaving PU/DO location, vehicle entering and leaving the basement car park. Please provide drawings showing the associated traffic aids at the concerned area to demonstrate the above-mentioned conflicting traffic could be properly managed.</p>	<p>(iv) Please be advised that a buffer area as highlighted in Appendix B1 – Traffic plan of TIA has been reserved for school bus pick-up/drop-off. The design of the kindergarten carpark will be reviewed in the detailed design stage, and the detailed design will ensure that sufficient area will be provided for kindergarten pick-up/drop-off.</p> <p>(v) Appropriate traffic aids will be provided at the main entrance area to manage the traffic conflicts. The indicative road markings at the main entrance area, demonstrating that the conflicting traffic could be properly managed, are indicated in Appendix B1 – Traffic Plan of TIA.</p>
24.	Please supplement the calculation of queue length assessment for comment.	Noted and will be included in Appendix I of TIA .
25.	Drawing 5.4 - Please elaborate the proposed improvement works on San Tin Highway southbound slip road to Fairview Park Interchange, i.e. whether it is an exclusive left-turn lane. Should it be the case, please supplement swept path analysis for 16m long vehicle.	Under the junction improvement works at Fairview Park Interchange, an exclusive left-turn lane is provided at San Tin Highway Slip Road southbound. Swept path analysis for 16m long vehicle has been conducted and shown in Appendix G of TIA . Sufficient turning area has been provided at the proposed exclusive lane.

Application No. Y/YL-MP/11 Proposed Rezoning from “Residential (Group D)” to “Residential (Group C)2” Zone for Proposed Residential Development, Lot 4822 in D.D.104 and Adjoining Government Land, Mai Po, Yuen Long

Departmental Comments		Applicant’s Responses
E. Drainage Services Department (“DSD”) (received on 4.5.2026)		
<i>Comments on the revised Sewerage Impact Assessment (SIA)</i>		
Specific Comments		
1.	Figure 4: The applicant should clarify discrepancy of number of gravity sewers (after the proposed upgrading works) shown on the proposed sewerage plan and legend. Capacity of sewers at the downstream shall not be less than that at the upstream.	Figure 4 and the hydraulic calculations in Appendix F have been revised. The applicant has rectified the discrepancy between the sewerage plan and the legend to accurately reflect the extent of the proposed upgrading works.
2.	The applicant should seek SIG/EPD's confirmation whether the capacity reserved in the proposed communal sewers can be increased from 15,500m ³ /day to around 20,000m ³ /day. If positive and depend on the quoted scenario, the applicant should be responsible for the liaisons and communications with the relevant other project proponents in the area to agree on the updated design and to ensure the proposed communal sewers will be constructed up to the updated design (i.e. to avoid subsequent further construction for upgrading).	The applicant has consulted EPD/SIG. EPD confirmed that the initial estimation of 15,500 m ³ /day has already accounted for the sewage flow from all proposed developments in the surrounding area.
General Comments		
3.	The existing public sewerage system should not be affected unless a diversion proposal has been submitted and designed to the satisfaction of DSD and such agreed diversion works should be carried out by the applicant at the cost of his project.	Noted.

Application No. Y/YL-MP/11 Proposed Rezoning from “Residential (Group D)” to “Residential (Group C)2” Zone for Proposed Residential Development, Lot 4822 in D.D.104 and Adjoining Government Land, Mai Po, Yuen Long

Departmental Comments		Applicant’s Responses
4.	This Department will only take over those public drainage facilities constructed on government land and located downstream of the terminal manhole. When the proposed gravity sewers are exclusively used by the proposed development, those sewers shall be maintained by the applicant at his/her own cost. If the proposed sewers become public sewers that serve multiple users, the applicant shall hand over the sewer on government land to DSD for maintenance.	Generally as per your comment, the Applicant would be responsible for maintaining and managing exclusive use of the sewer. However, since the new pipe required by DSD is designed to serve more than the subject development, it is a new pipe that will design, construction and function as a public sewer. The proposed arrangement remains flexible at this stage, and the final design and construction of the new pipe will be determined during the detailed design phase, including maintenance and management requirements, to meet DSD’s approval.
5.	Section 7.4: For scenario 2, the applicant is responsible for closely communicating and coordinating with other developers for the upgrading details and the implementation of the proposed PSL works.	Noted.
6.	Previous general comments dated 18 March 2026 (our email dated 18.3.2025 refers) remain valid.	Noted.
<i>Comments on the revised Drainage Impact Assessment (DIA)</i>		
Specific Comments		
7.	R-to-C (No.: H(1)): DSD will not take up maintenance responsibility of the proposed decking, box culvert and maintenance access.	Noted.
8.	Para. 6.9: The applicant should specify the materials which will be used for the proposed drainage system. The roughness values for the concerned proposed drainage system should adhere to the values outlined in Table 14 of the Stormwater Drainage Manual (SDM).	Section 6.9 is revised to specify the use of precast concrete pipes with 'O' ring joints. The roughness coefficient (ks) has been updated to 0.6mm to strictly comply with SDM Table 14.

Application No. Y/YL-MP/11 Proposed Rezoning from “Residential (Group D)” to “Residential (Group C)2” Zone for Proposed Residential Development, Lot 4822 in D.D.104 and Adjoining Government Land, Mai Po, Yuen Long

Departmental Comments		Applicant’s Responses
9.	Appendix D & Appendix F: The applicant should clarify if deposition of sediment in drainage system has been considered as per the requirement in SDM (Section 9.3) (i.e. Para. 6.7 in Annex E).	Appendix D and F have been revised to incorporate a 10% allowance for blockage/sedimentation in the “Percentage Used” column to meet the requirement.
10.	Appendix D: The applicant should provide an assessment of the overall utilization of the existing drainage system (included Ngau Tam Mei Channel).	Appendix D is updated to show the equivalent C value have decreased after development. As post-development runoff will not exceed pre-development levels, there is no impact on the drainage performance of Ngau Tam Mei Channel.
11.	Appendix F: The applicant should use 0.3 as the runoff coefficient for unpaved area, consistent with the calculation in Appendix D. In addition, the utilization shall be designed lower than 85% for a conservative approach. The applicant should review and amend accordingly.	Appendix F has been revised to use 0.3 as the runoff coefficient for unpaved areas. The utilization is maintained below 85%. The approved drawings for Appendix F by the Building Department is enclosed in the R-to-C for reference.
12.	Appendix D: The applicant should clarify discrepancy of data shown in tables.	Appendix D and all relevant tables in the text section have been revised to ensure full data consistency.
13.	The applicant should clarify whether catchment areas of the application site will contribute flow to the Chuk Yuen Stormwater Pumping Station and review if the surface runoff could be diverted to Ngau Tam Mei Channel in order to avoid increasing stormwater discharge to Chuk Yuen Stormwater Pumping Station.	Appendix D is revised and Section 7.6 has been added to clarify that total runoff to the pumping station via SMH1038220 and SMH1038240 decreases from 0.27 m ³ /s to 0.26 m ³ /s after development. As discharge is reduced, there is no adverse impact on the pumping station.

Application No. Y/YL-MP/11 Proposed Rezoning from “Residential (Group D)” to “Residential (Group C)2” Zone for Proposed Residential Development, Lot 4822 in D.D.104 and Adjoining Government Land, Mai Po, Yuen Long

Departmental Comments		Applicant’s Responses
14.	Previous comments in paragraphs 3 and 8 dated 18 March 2026 (our email dated 18.3.2026 refers) remain valid.	Noted.

List of Attachments:

Annex 1: PlanD's Comments on the Key Development Parameters in Table E1 of TIA

Appendix F: Approved Record Drawings by the Building Department

norawong@visionplanning.com.hk

寄件者: Jessie Sin Yee LAU/PLAND <jsylau@pland.gov.hk>
寄件日期: 2026年5月6日星期三 15:07
收件者: [REDACTED]
副本: Chloe Kit Ying LEUNG/PLAND; Yen PY LEUNG/PLAND
主旨: Re: Y/YL-MP/11 - Further Information (5) in response to Departmental Comments
附件: 20260506_Comments on Planned Development-v1.pdf

郵件標幟: 待處理
標幟狀態: 已標幟

Dear Nora,

Attached please find our comments on the list of planned developments for further actions.
[See attachment "20260506_Comments on Planned Development-v1.pdf"]

Regards,
Jessie SY LAU
TP/YLE8, FS&YLE DPO
Planning Department

Tel: 3168 4037



規劃署
Planning
Department

透過規劃工作，使香港成為一個宜居、具競爭力和可持續發展的亞洲國際都會
We plan to make Hong Kong a Liveable • Competitive • Sustainable ASIA'S WORLD CITY



From: [REDACTED]
Sent: Friday, April 24, 2026 5:43 PM
To: Jessie Sin Yee LAU/PLAND <jsylau@pland.gov.hk>
Cc: Pak Him CHIU/PLAND <phchiu@pland.gov.hk>; Chloe Kit Ying LEUNG/PLAND <ckyleung@pland.gov.hk>; Yen PY LEUNG/PLAND <pyleung@pland.gov.hk> [REDACTED]
Subject: FW: Y/YL-MP/11 - Further Information (5) in response to Departmental Comments

Dear Jessie,

Regarding TD's Comment Item No. 6 (received on 24.4.2026), please refer to the enclosed Table E1 (extracted from FI (5)'s TIA) for PlanD's agreement.

Regards,

Nora WONG

Vision Planning Consultants Limited

Tel: [REDACTED] | Email: [REDACTED] | Fax: [REDACTED]

s.12A Application No. Y/YL-MP/11
To rezone the application site from “Residential (Group D)” to
“Residential (Group C) 2” and amend the Notes of the zone applicable to the site
List of Planned/ Committed Developments

Comments from District Planning Office/ Fanling, Sheung Shui and Yuen Long East

1. Item 14 – the applicant is advised to consider including the Third Medical School. PlanD defers to the applicant to consider whether the GIC facilities, including the fire station cum ambulance depot with potential staff quarters, to be completed by 2034 should be taken into account into the assessment.

2. Item 4 – the applicant is advised take into account the latest figures of Kam Sheung Road Phase II development, which will result in a total of 3,490 private housing units.

FS&YLE DPO
MAY 2026

Appendix F of R-to-C Table dated 12.5.2026 (Application No. Y/YL-MP/11)
--

BD Ref: 6/9069/12

Project Title: Proposed Residential Development at Kam Pok Road, Yuen Long,
Lot No. 4822 in D.D.104

Plan Index for Drainage Record Plans as Approved by Building Department

(Drawings with an asterisk (*) represent latest approved plans)

BD Dwg. No/ (For BD use)	AP Dwg. No.	<u>Drawing Title</u>	<u>Rev</u>	<u>Approved Date</u>
FINAL AMENDMENT APPROVAL				
	SF-F001	* Site Formation for Flood Mitigation – Master Drainage Plan (Permanent)	D	6 Jul 2022
	SF-F004	* Site Formation for Flood Mitigation – RC Details and Schedule for Manhole	D	6 Jul 2022

BD Dwg. No/ (For BD use)	AP Dwg. No.	<u>Drawing Title</u>	<u>Rev</u>	<u>Approved Date</u>
3rd AMENDMENT APPROVAL				
	SF-F001	Site Formation for Flood Mitigation – Master Drainage Plan (Permanent)	C	24 Feb 2022
	SF-F004	Site Formation for Flood Mitigation – RC Details and Schedule for Manhole	C	24 Feb 2022

BD Dwg. No/ (For BD use)	AP Dwg. No.	<u>Drawing Title</u>	<u>Rev</u>	<u>Approved Date</u>
2nd AMENDMENT APPROVAL				
	SF-F001	Site Formation for Flood Mitigation – Master Drainage Plan (Permanent)	B	12 Oct 2021
	SF-F002	* Site Formation for Flood Mitigation – Sections	B	12 Oct 2021
	SF-F003	* Site Formation for Flood Mitigation – General Notes for Drainage	B	12 Oct 2021
	SF-F004	Site Formation for Flood Mitigation – RC Details and Schedule for Manhole	B	12 Oct 2021
	SF-F005	* Site Formation for Flood Mitigation – RC Details of Sandtrap and Box Culvert	B	12 Oct 2021
	SF-F101	* Site Formation for Flood Mitigation – Part Plan for ELS	B	12 Oct 2021
	SF-F102	* Site Formation for Flood Mitigation – Sections for ELS	B	12 Oct 2021

BD Ref: 6/9069/12

Project Title: Proposed Residential Development at Kam Pok Road, Yuen Long,
Lot No. 4822 in D.D.104

Plan Index for Drainage Record Plans as Approved by Building Department

(Drawings with an asterisk (*) represent latest approved plans)

BD Dwg. No/ (For BD use)	AP Dwg. No.	<u>Drawing Title</u>	<u>Rev</u>	<u>Approved Date</u>
	1st Amendment APPROVAL			
	SF-F001	Site Formation for Flood Mitigation – Master Drainage Plan (Permanent)	A	11 Aug 2020
	SF-F002	Site Formation for Flood Mitigation – Sections	A	11 Aug 2020
	SF-F003	Site Formation for Flood Mitigation – General Notes for Drainage	A	11 Aug 2020
	SF-F004	Site Formation for Flood Mitigation – RC Details and Schedule for Manhole	A	11 Aug 2020
	SF-F101	Site Formation for Flood Mitigation – Part Plan for ELS	A	11 Aug 2020
	SF-F102	Site Formation for Flood Mitigation – Sections for ELS	A	11 Aug 2020
	SF-F103	* Site Formation for Flood Mitigation – Typical Details and Notes for ELS	A	11 Aug 2020
	1st Submission APPROVAL			
	SF-F001	Site Formation for Flood Mitigation – Master Drainage Plan (Permanent)	-	2 Mar 2017
	SF-F002	Site Formation for Flood Mitigation – Sections	-	2 Mar 2017
	SF-F003	Site Formation for Flood Mitigation – General Notes for Drainage	-	2 Mar 2017
	SF-F004	Site Formation for Flood Mitigation – RC Details for Manhole	-	2 Mar 2017
	SF-F005	Site Formation for Flood Mitigation – RC Details of Sandtrap and Box Culvert	-	2 Mar 2017
	SF-F006	* Site Formation for Flood Mitigation – Typical Details for Steel Cover	-	2 Mar 2017
	SF-F101	Site Formation for Flood Mitigation – Part Plan for ELS	-	2 Mar 2017
	SF-F102	Site Formation for Flood Mitigation – Sections for	-	2 Mar 2017

BD Ref: 6/9069/12

Project Title: Proposed Residential Development at Kam Pok Road, Yuen Long,
Lot No. 4822 in D.D.104

Plan Index for Drainage Record Plans as Approved by Building Department



(Drawings with an asterisk (*) represent latest approved plans)

SF-F103	ELS Site Formation for Flood Mitigation – Typical Details and Notes for ELS	-	2 Mar 2017
---------	---	---	------------

Plans and Record Drawings on Site Formation (Flood Mitigation)


CAD FILE: X:\Eng\Drawing\Kam Pok Road Lot 4807 & 4588\Drawing\Site Formation\Site Formation (Flood Mitigation)\SF-F001.DWG (Latest)\Drawing\SF-F001.DWG

B.D. REF. NO.: 6/9069/12

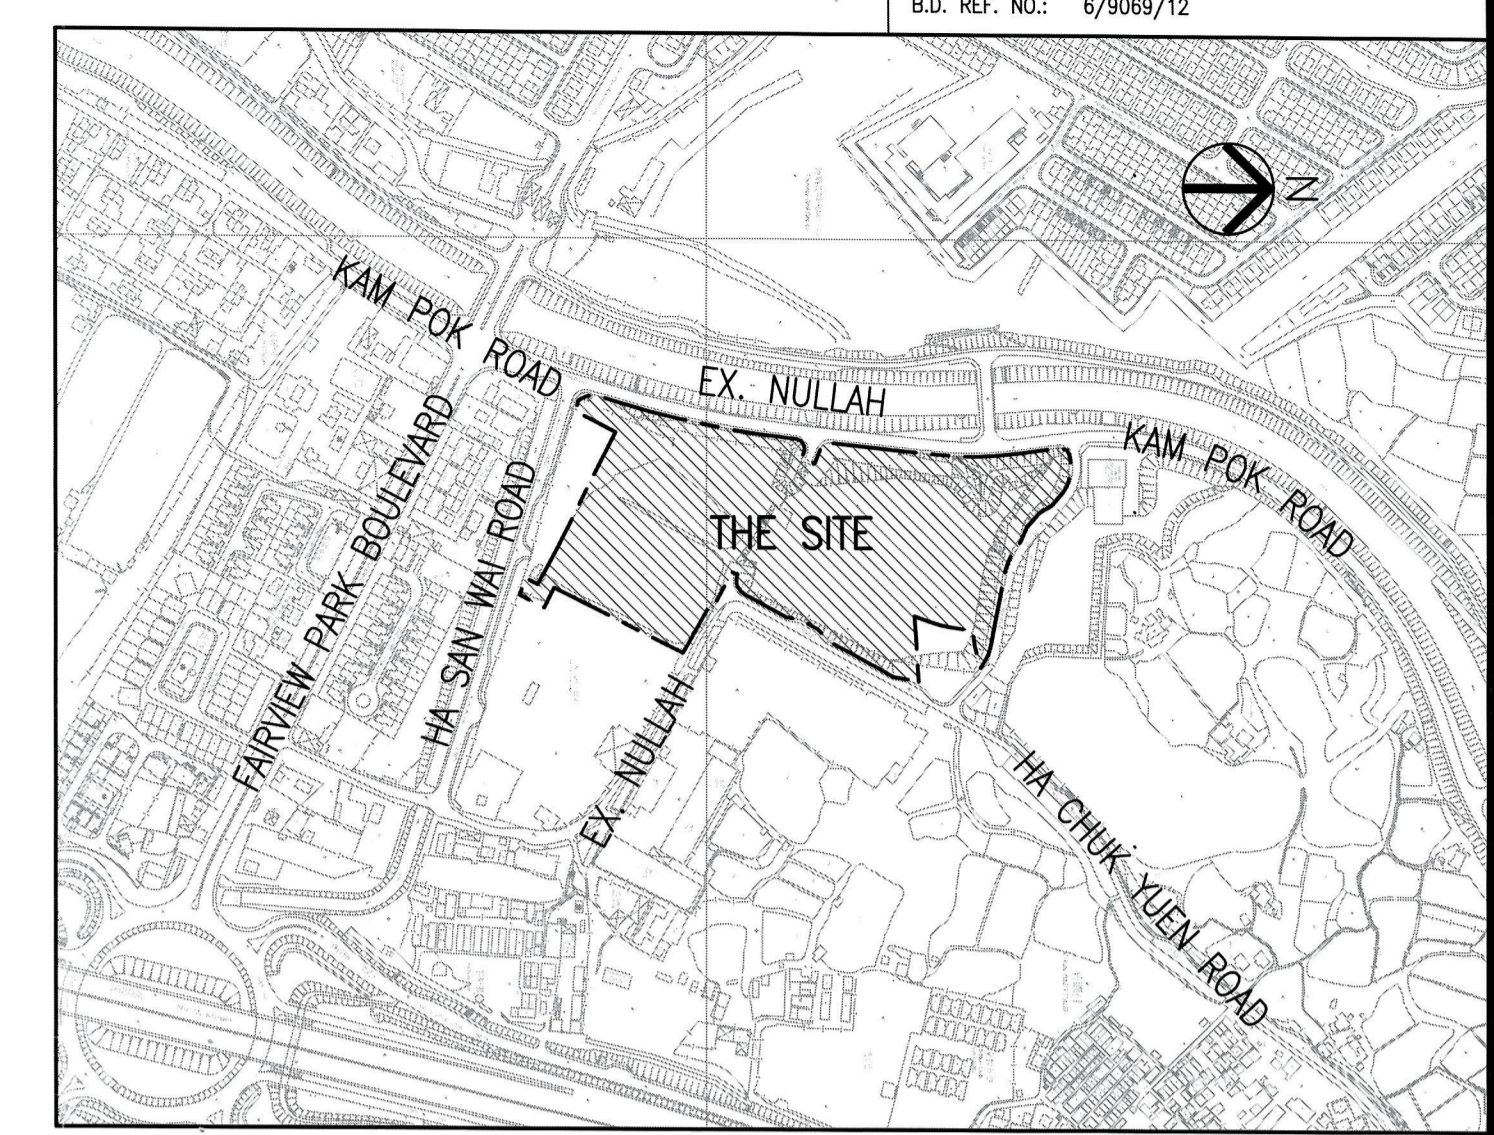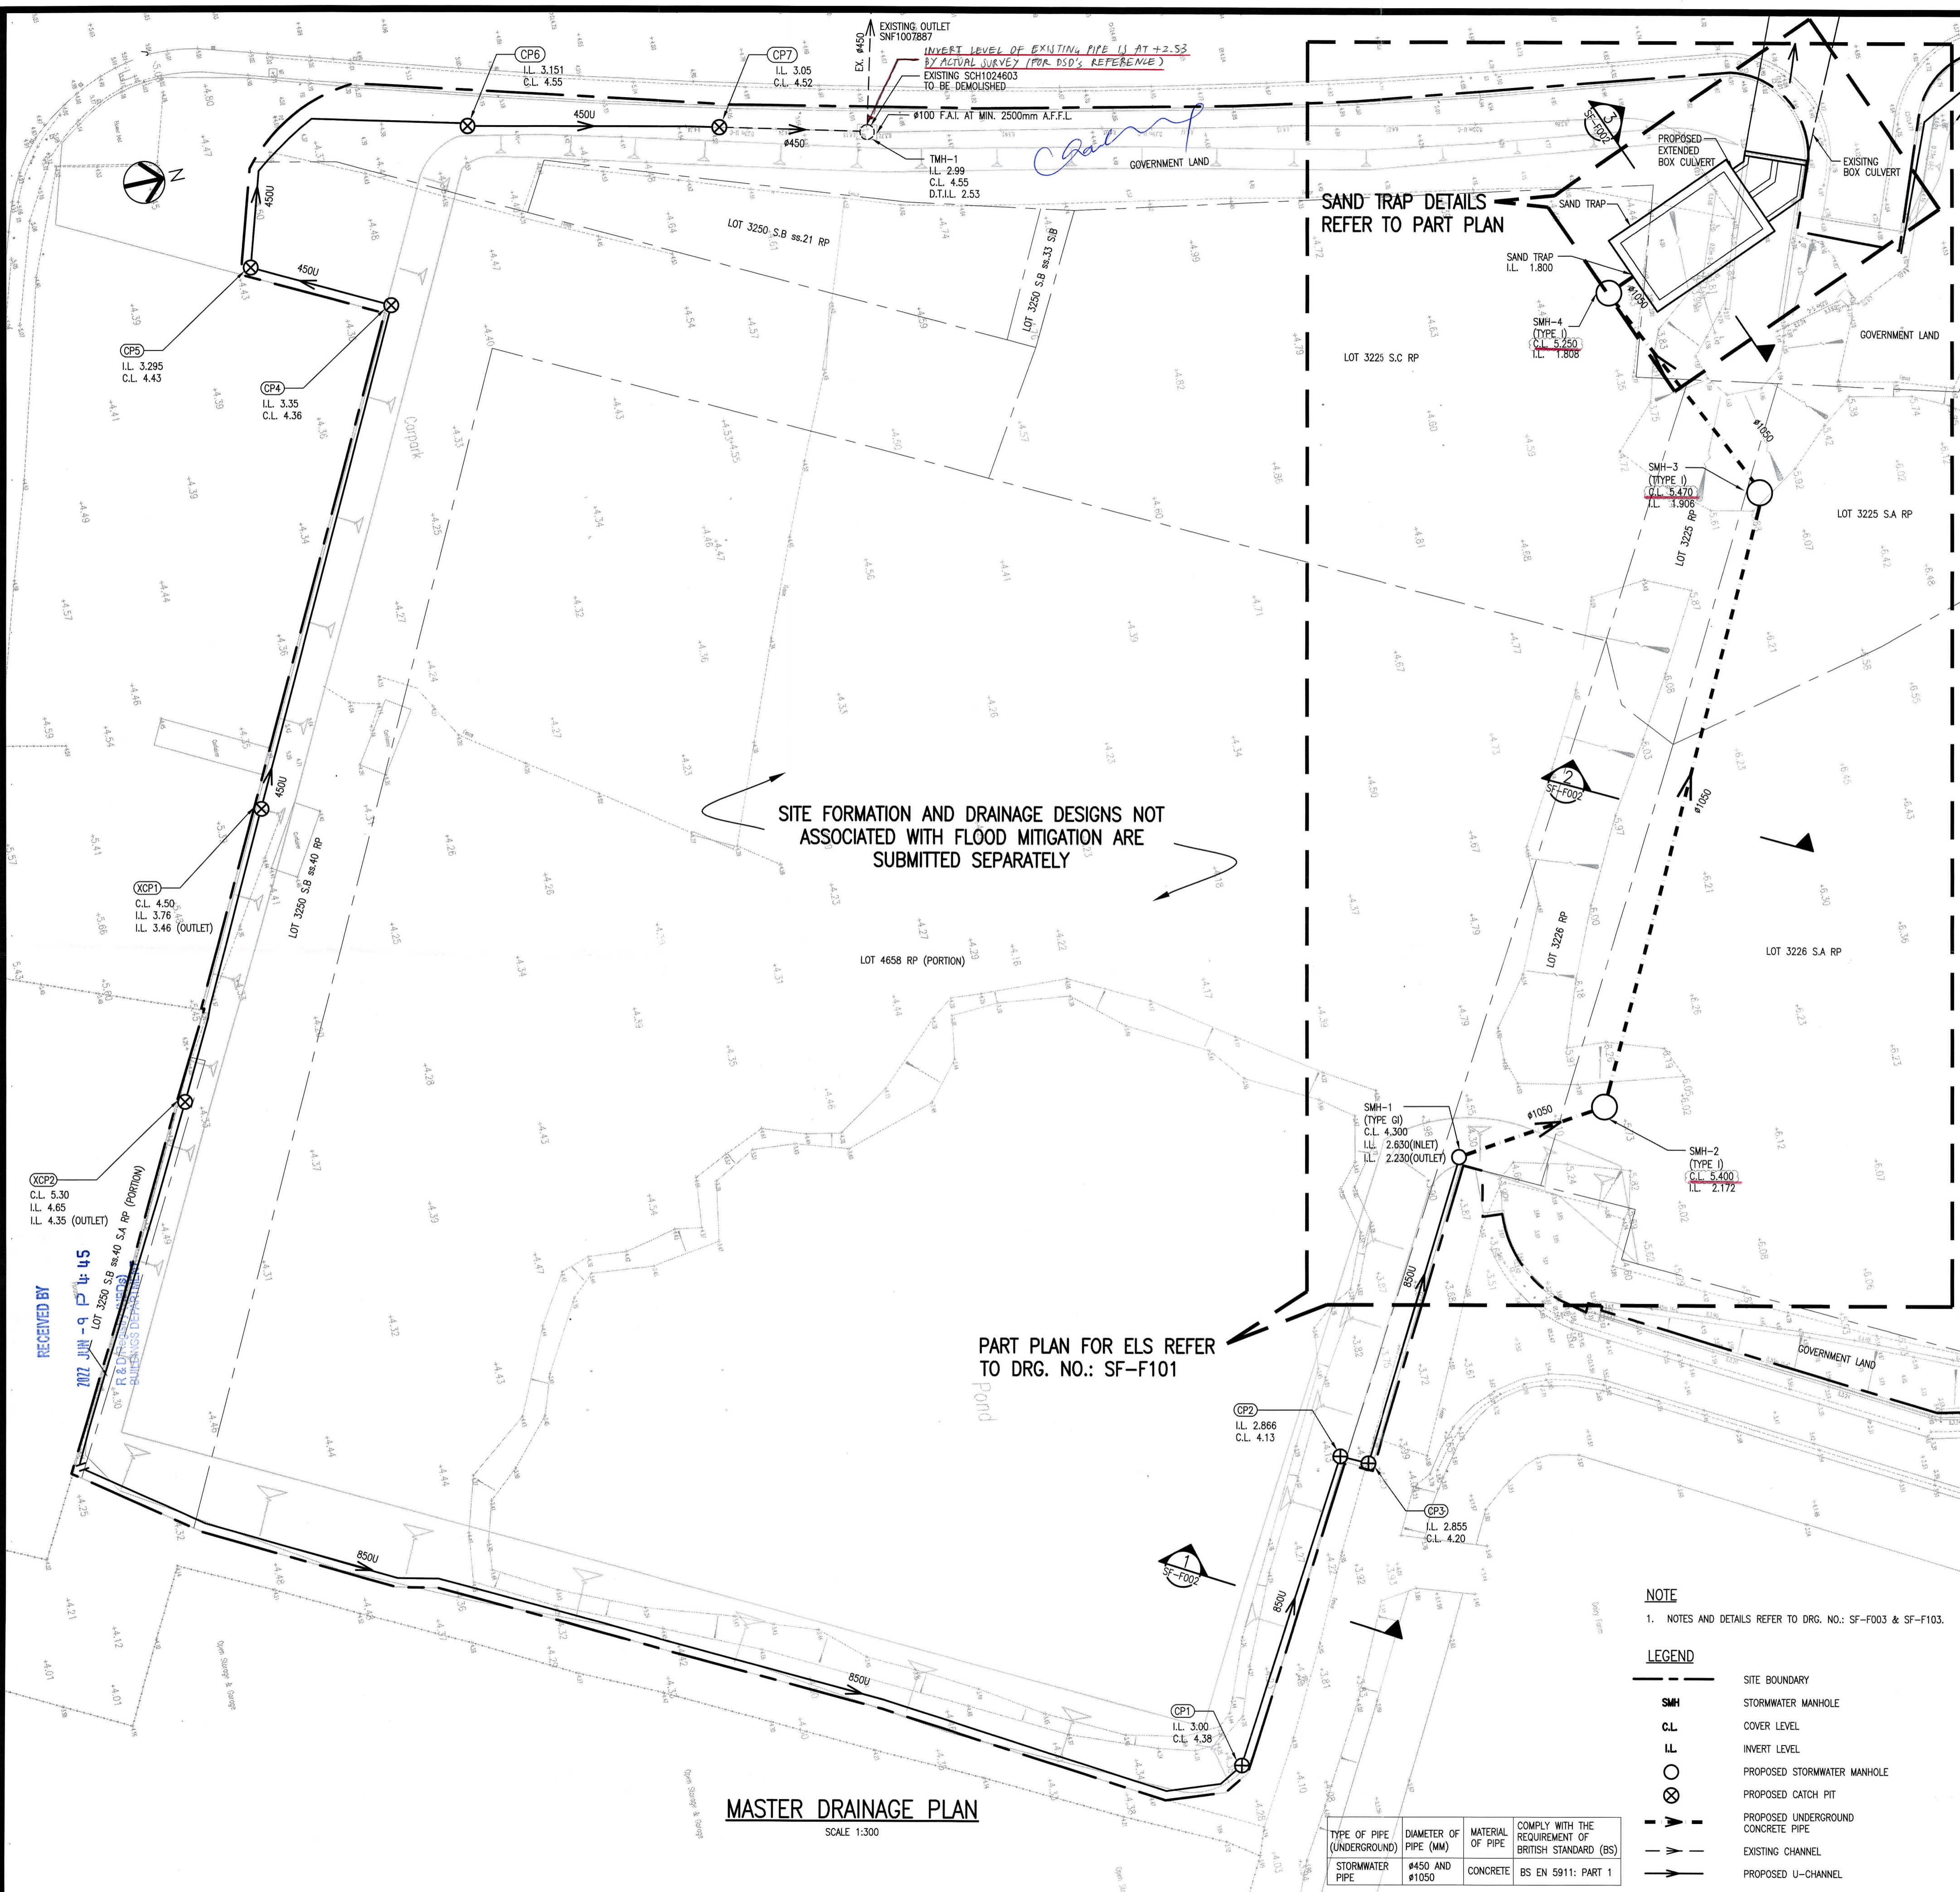

Note: This plan has been processed on a curtailed check basis under the centralized processing system as promulgated in PNAP ADM-19. The duties of the authorized person, registered structural engineer and/or registered geotechnical engineer concerned as specified under section 413(b) and the provision of section 14(2)(c) of the Buildings Ordinance are of particular relevance in this regard.

Chan Wan Ming
Authorized Person (Architect)

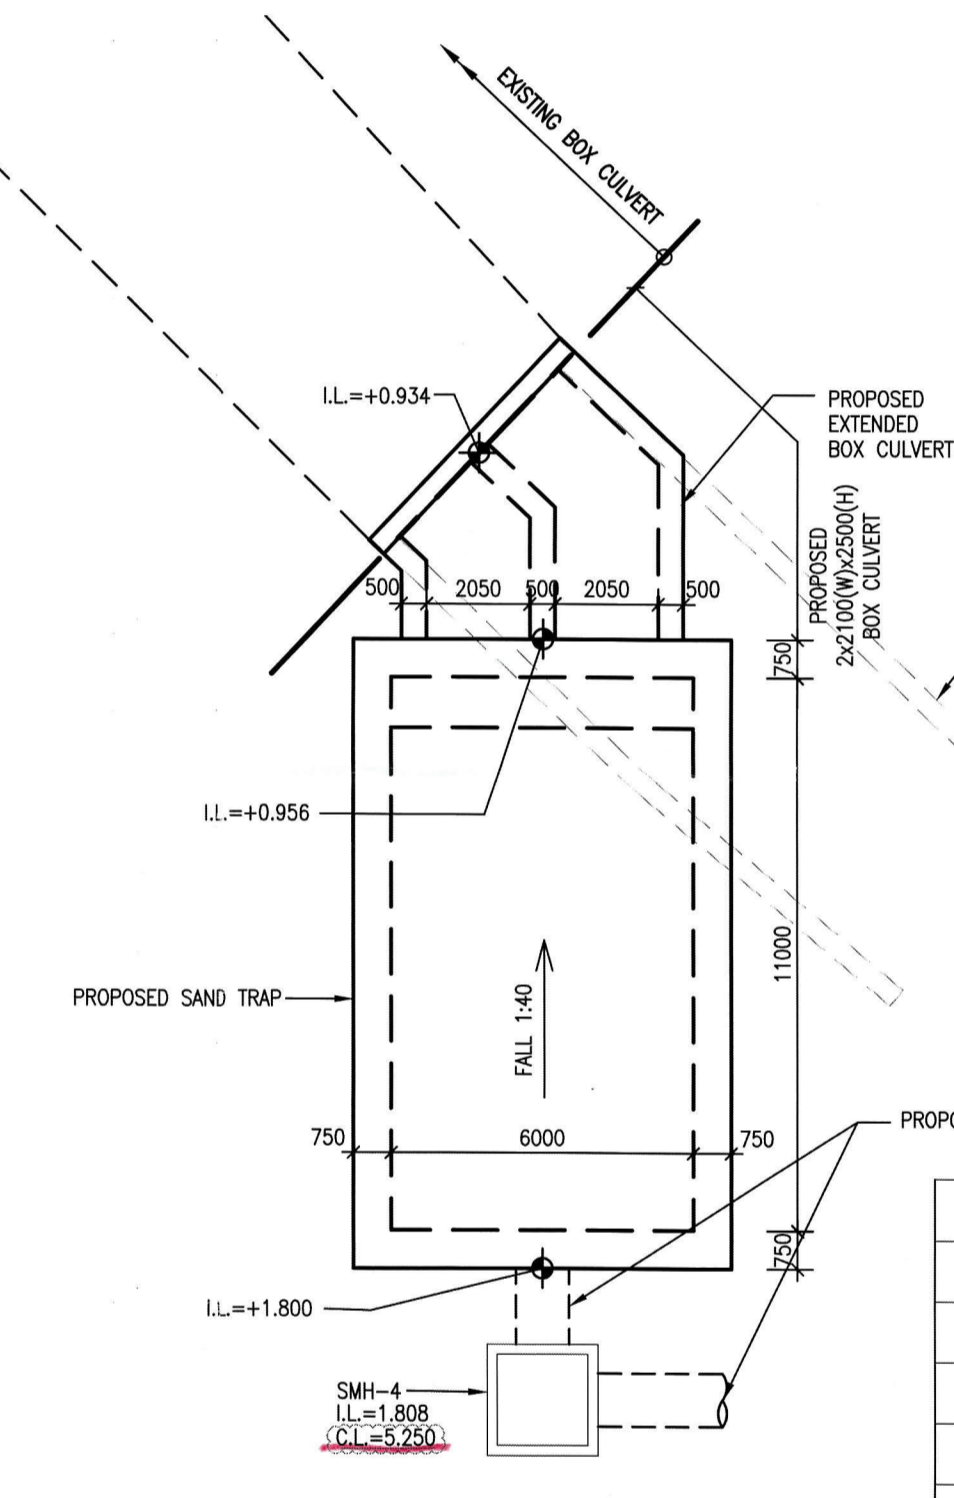

Plan Approved
Cheng Hui-jen, Colin
Senior Building Surveyor
for BUILDING AUTHORITY
- 6 JUL 2022

RECORD PLAN

"The works shown on these plans are Type II works (Site Formation (Flood Mitigation)) in respect of which consent is applied for the purpose of Fast Track consent application under regulation 33 of the Building (Administration) Regulations."

AMENDMENT

REV.	DATE	DESCRIPTION
D	06/2022	GENERAL REVISION
-	-	BD APPROVED ON 24 FEB 2022
C	01/2022	GENERAL REVISION
-	-	BD APPROVED ON 12 OCT 2021
B	09/2021	GENERAL REVISION
A	07/2020	GENERAL REVISION
-	-	BD APPROVED ON 02 MAR 2017

PROJECT
RESIDENTIAL DEVELOPMENT
KAM POK ROAD NEW TERRITORIES

DRAWING TITLE
SITE FORMATION FOR FLOOD MITIGATION - MASTER DRAINAGE PLAN (PERMANENT)

JOB NO.	DESIGNED	TONY AU
DATE	DRAWN	WIN
SCALE	CHECKED	TONY AU
DRG. NO.	STATUS	
SF-F001	SUBMISSION	

ARCHITECT
P&T Architects and Engineers Ltd
巴丹拿建築及工程師有限公司

ENGINEER
STEPHEN CHENG
Chan Chu Fai Edward
Registered Structural Engineer
CONSULTING ENGINEERS LTD.

NOTE

- NOTES AND DETAILS REFER TO DRG. NO.: SF-F003 & SF-F103.
- PARTICULAR NOTES ON DRAINAGE WORKS**
- ALL WORKS AND MATERIALS SHALL COMPLY WITH "GENERAL SPECIFICATION FOR CIVIL ENGINEERING WORKS 1992 EDITION".
- CONCRETE TO CATCHPIT, U-CHANNEL SHALL BE GRADE C30 EXCEPT OTHERWISE STATED.
- MINIMUM CONCRETE COVER TO REINFORCEMENT SHALL BE 40mm.
- ALL CONCRETE SURFACE FINISH FOR CATCHPIT, SAND TRAP AND CHANNEL SHALL BE CLASS U2 OR F2 AS APPROPRIATE.
- 75mm THICK BLINDING LAYER SHALL BE PLACED UNDER CATCHPIT. CONCRETE TO BLINDING LAYER SHALL BE PRESCRIBED MIX 10P.
- Y DENOTES HIGH TENSILE STEEL BARS OF YIELD STRESS=500 MPa COMPLYING WITH CS2:2012.
- ALL DESIGN IS IN ACCORDANCE WITH HONG KONG BUILDING (CONSTRUCTION) REGULATIONS 1990 AND STRUCTURAL USE OF CONCRETE (2013).
- CONCRETE TO SAND TRAP SHALL BE GRADE C35 EXCEPT OTHERWISE STATED.
- TO BE AT A GRADIENT IN ACCORDANCE WITH BUILDING REGULATION.
- CONCRETE FOR ALL R.C. WORKS OF DRAINAGE SYSTEM SHALL BE COMPLY WITH CS1:2010.
- GRADED STONE FILTER SHALL BE CRUSHER RUN GRANITE AGGREGATE.
- THE SAND TRAP SHOULD BE REGULARLY DESILTED BY OWNER TO PREVENT SAND AND SILT FROM BEING WASHED DOWN INTO THE EXISTING DRAINAGE SYSTEM/CHANNEL.

Note: This plan has been processed on a curtailed check basis under the centralized processing system as promulgated in PNAP ADM-19. The duties of the authorized person, registered structural engineer and/or registered geotechnical engineer concerned as specified under section 4(2)(b) and the provision of section 14(2)(c) of the Buildings Ordinance are of particular relevance in this regard.

BUILDINGS DEPARTMENT

AMENDED PLAN

Plan Approved
 NG Man Kit
 Building Surveyor
 for BUILDING AUTHORITY
 12 OCT 2021

Ching Hong Man, Michael,
 B. (S.) B. Arch. H.K.L.A. R.I.B.A.
 Authorised Person, Architect

REV.	DATE	DESCRIPTION
B	09/2021	GENERAL REVISION
A	07/2020	GENERAL REVISION
-	-	BD APPROVED ON 02 MAR 2017

PROJECT
 RESIDENTIAL DEVELOPMENT
 KAM POK ROAD NEW TERRITORIES

DRAWING TITLE
 SITE FORMATION FOR FLOOD MITIGATION - SECTIONS


JOB NO.	DESIGNED	CATH
DATE	12/2016	DRAWN WIN
SCALE	1:150 (A1)	CHECKED TONY
DRG. NO.	SF-F002	STATUS SUBMISSION

ARCHITECT
mcaal
 michael chiang and associates architects
 陳國光 蔣國強 鄧華輝 謝


ENGINEER
STEPHEN CHENG
 CONSULTING ENGINEERS LTD.
 Chan Chu Fai Edmund
 Registered Structural Engineer

RECORD PLAN


AMENDMENT

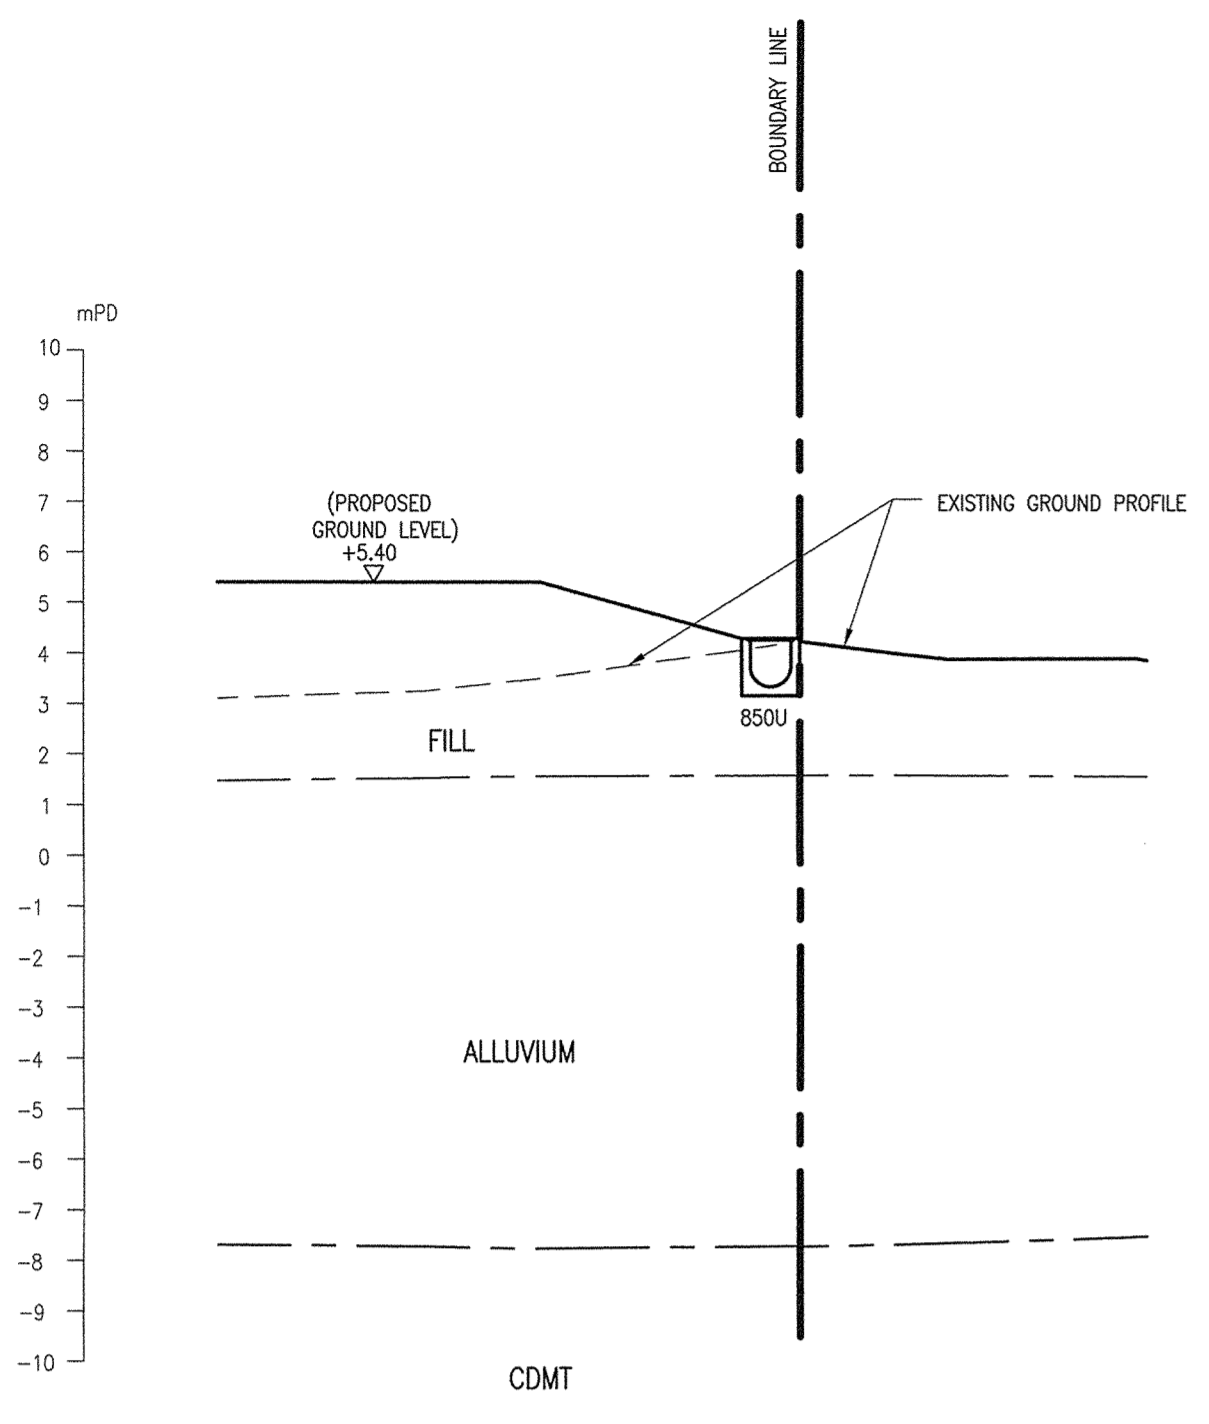

SECTION 1
 SCALE 1:150
 SF-F001

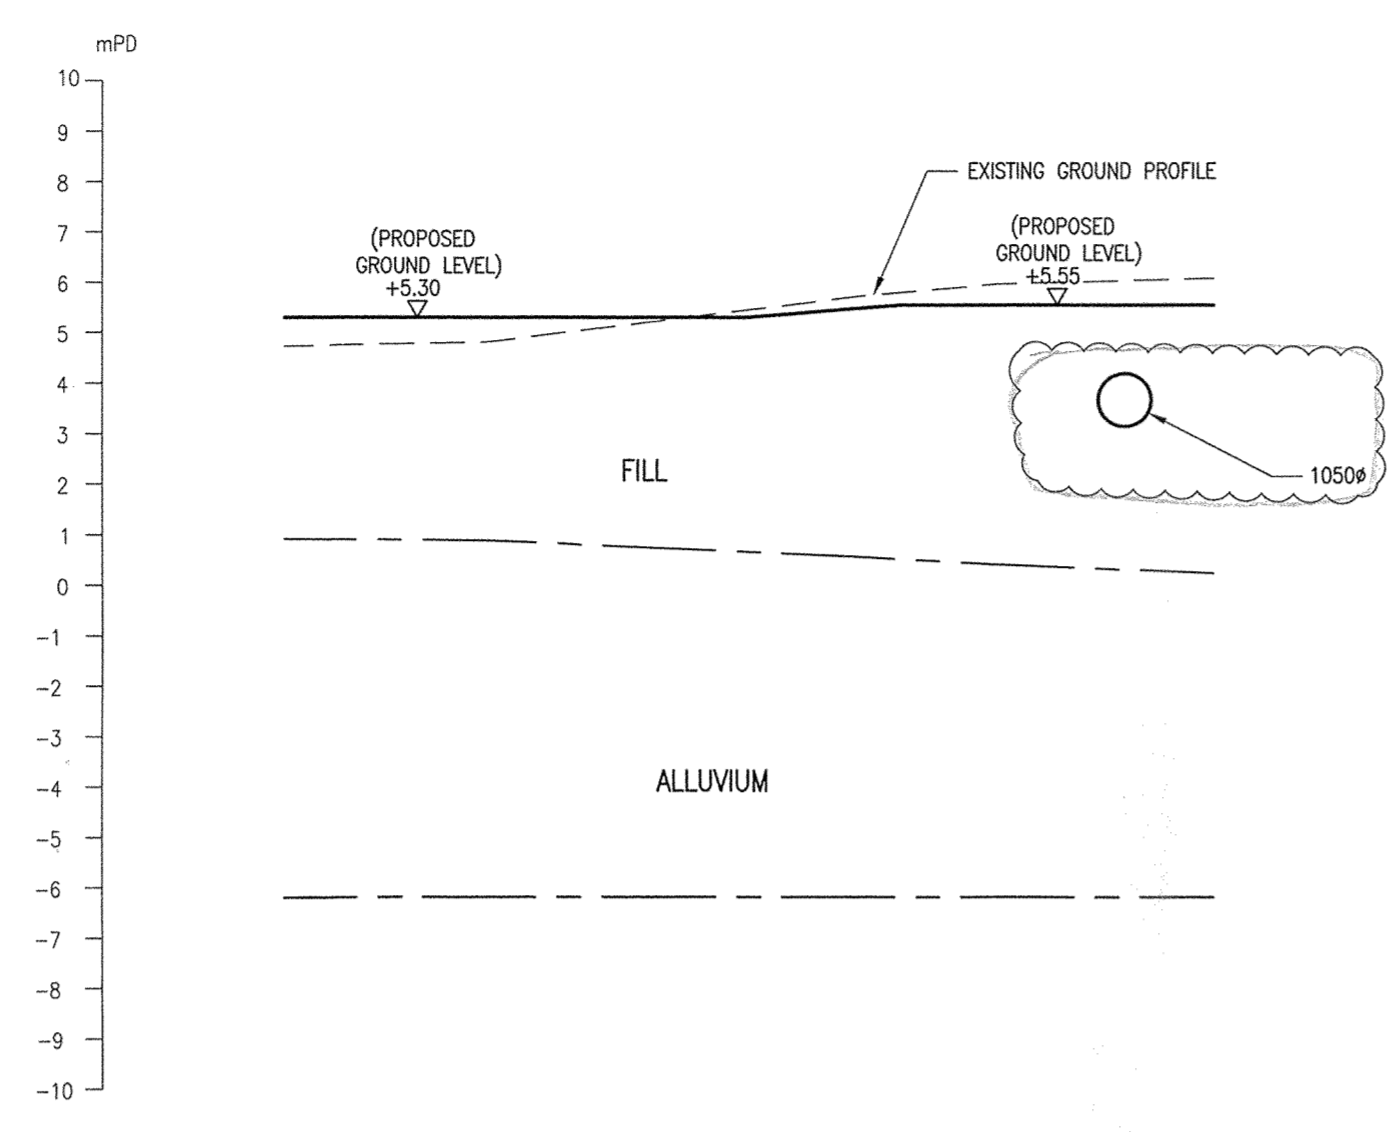


SECTION 2
 SCALE 1:150
 SF-F001

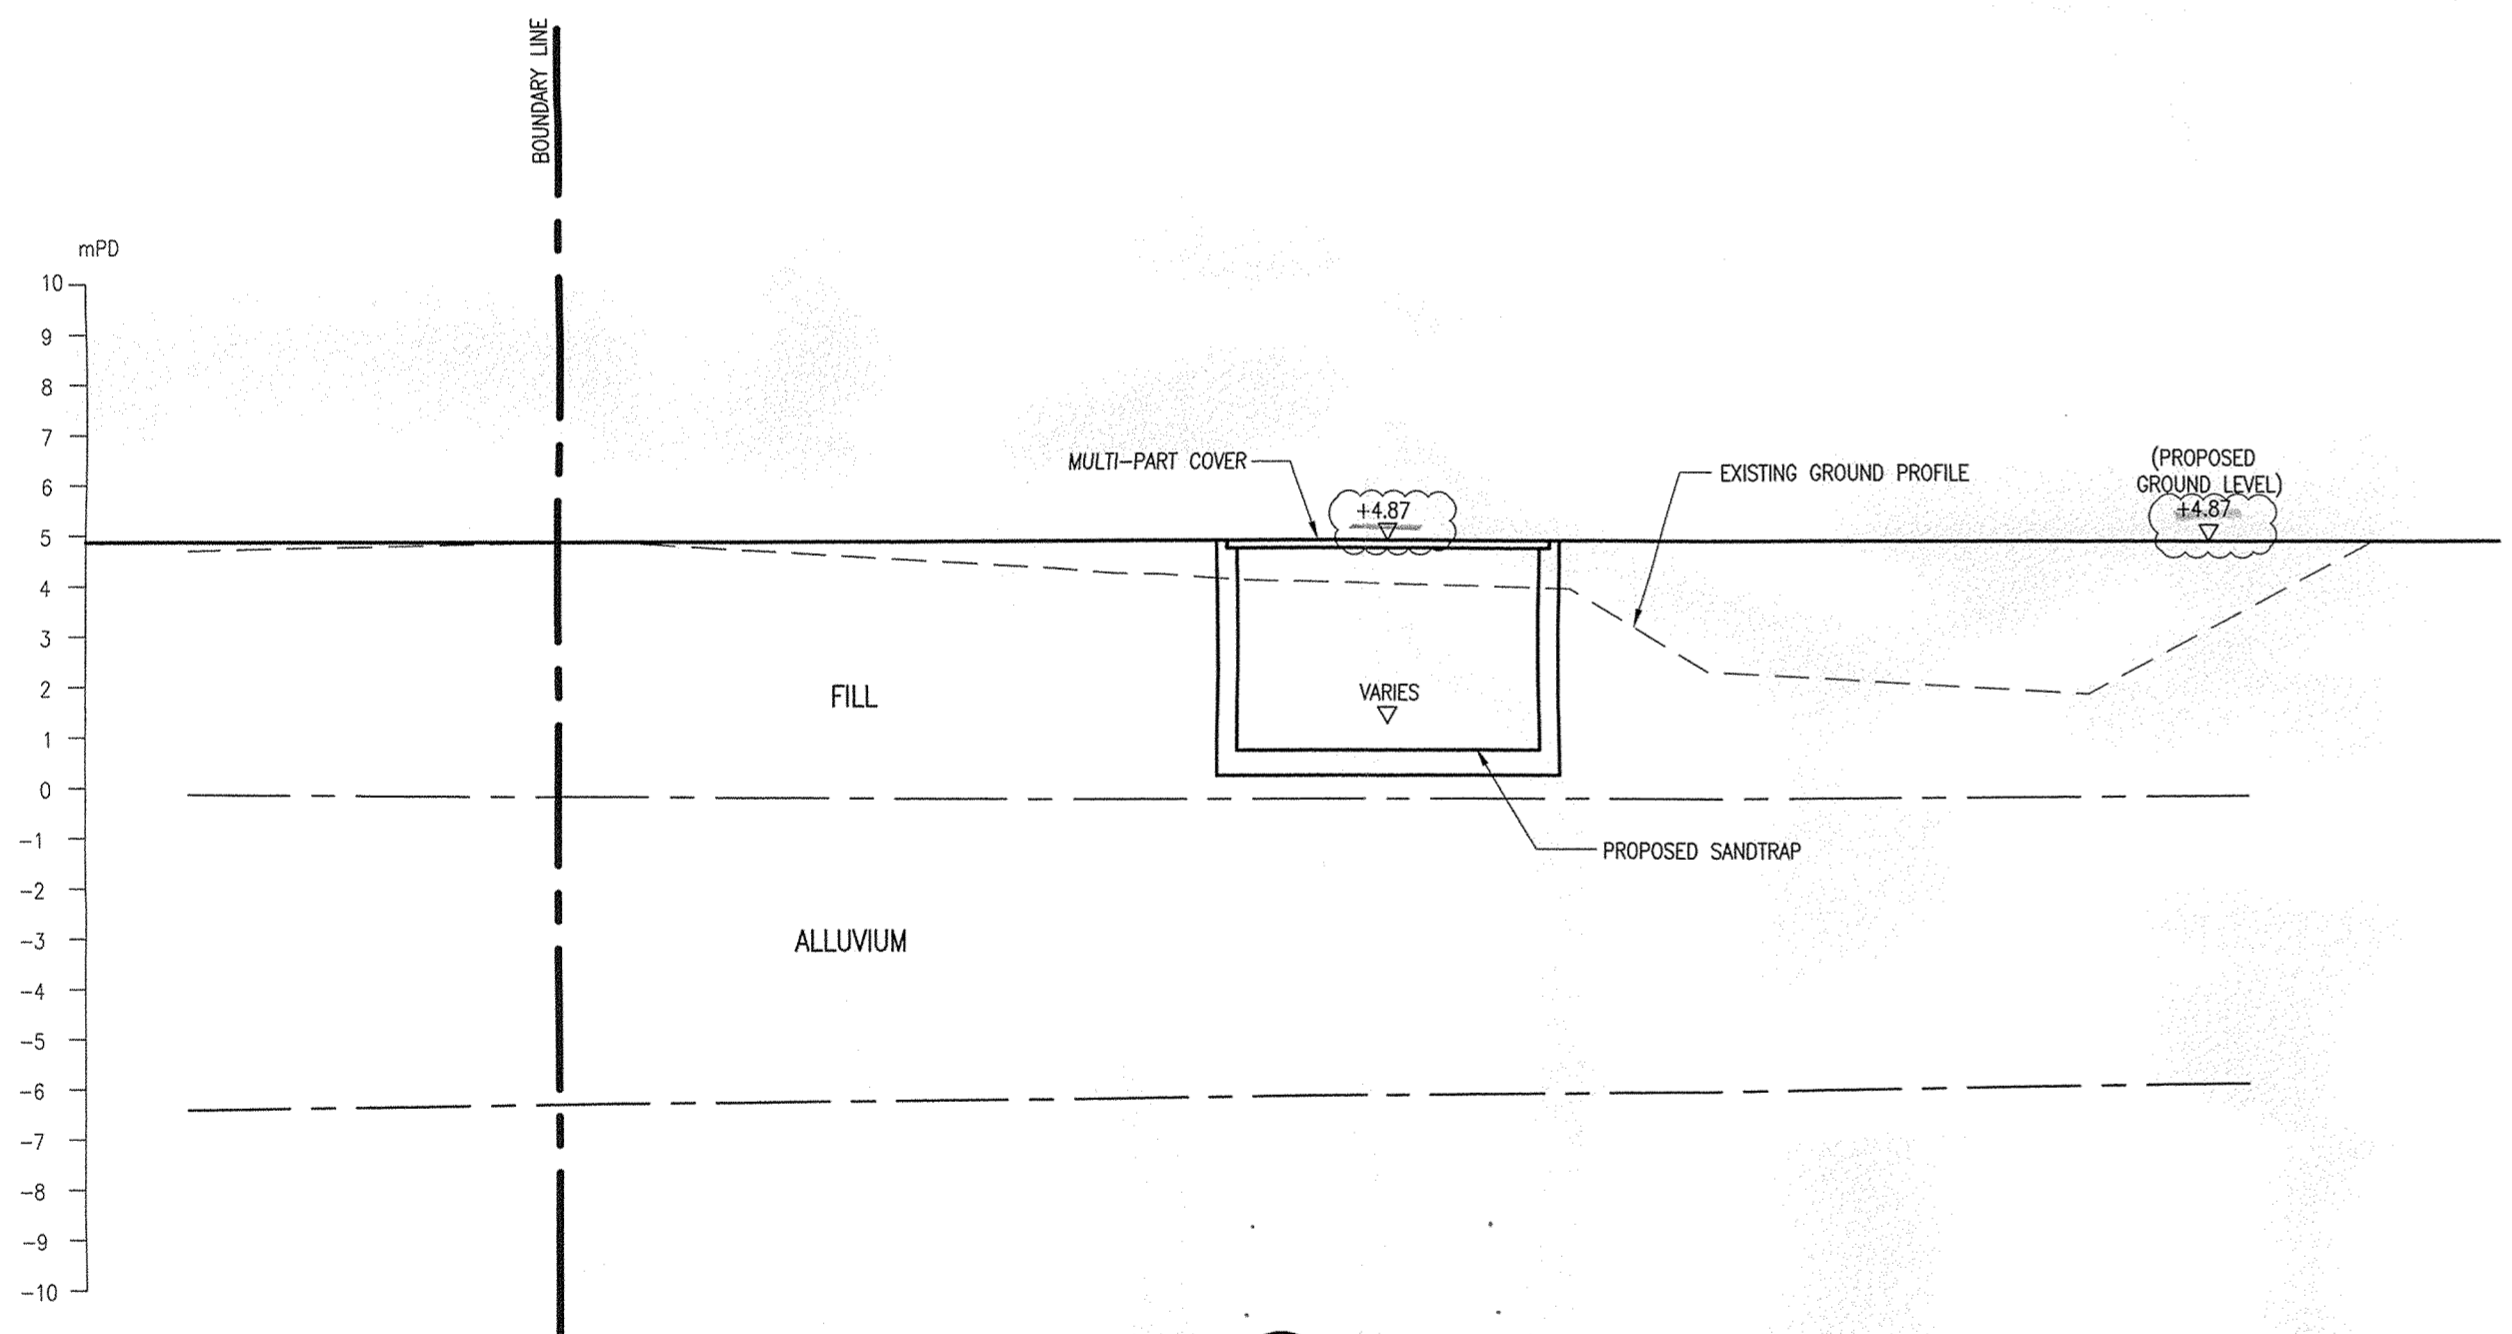

SECTION 3
 SCALE 1:150
 SF-F001


RECEIVED BY
 2021 SEP 16 P 4:48
 R & D Registry (RSD)@
 BUILDINGS DEPARTMENT

CAD FILE: X:\Engineering\Kam Pok Road Lot 4607 & 4568\Drawing\Site Formation (Flood Mitigation)\SF-F004\DR_PLAN_RC_MANHOLE.DWG

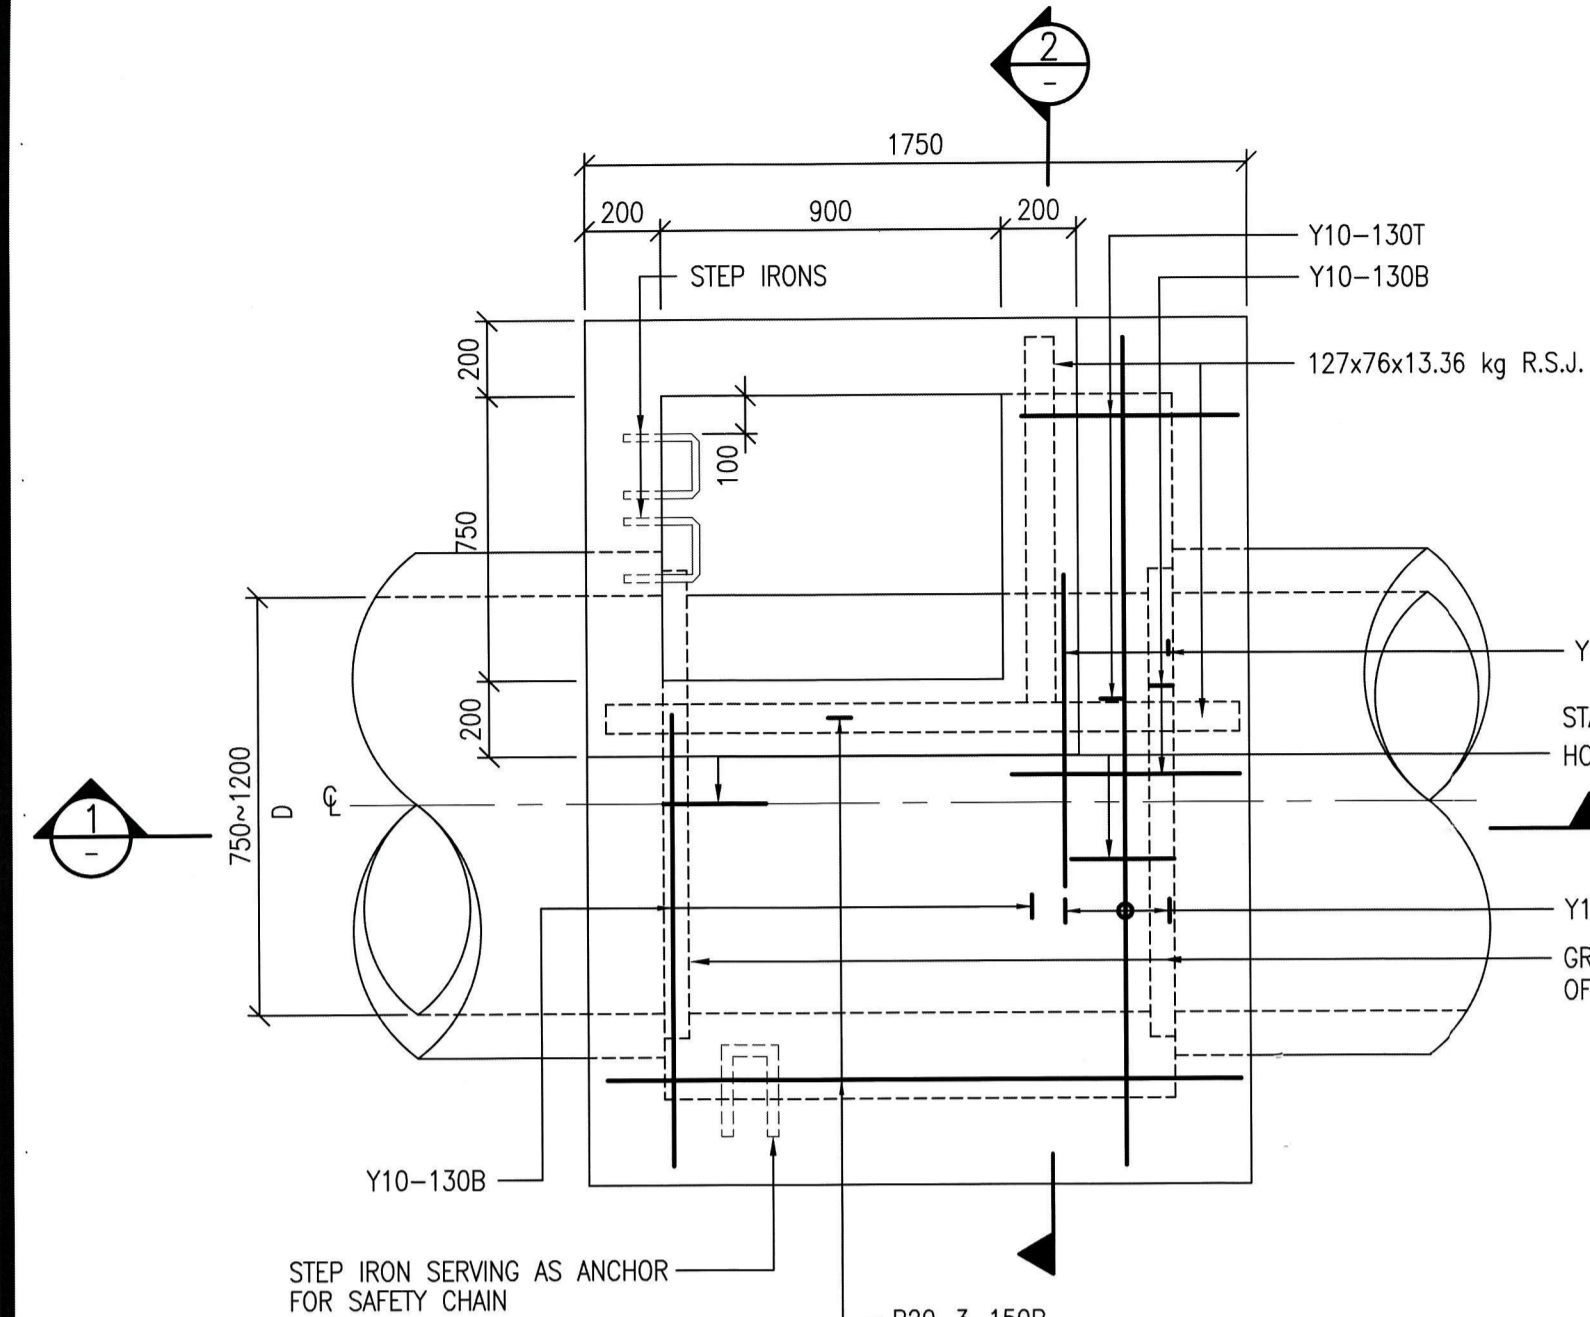

PLAN
MANHOLE TYPE I
1 : 20

BAR MARKS	SHAPE CODE
1 & 4	99
2 & 3	33
5 & 6	20

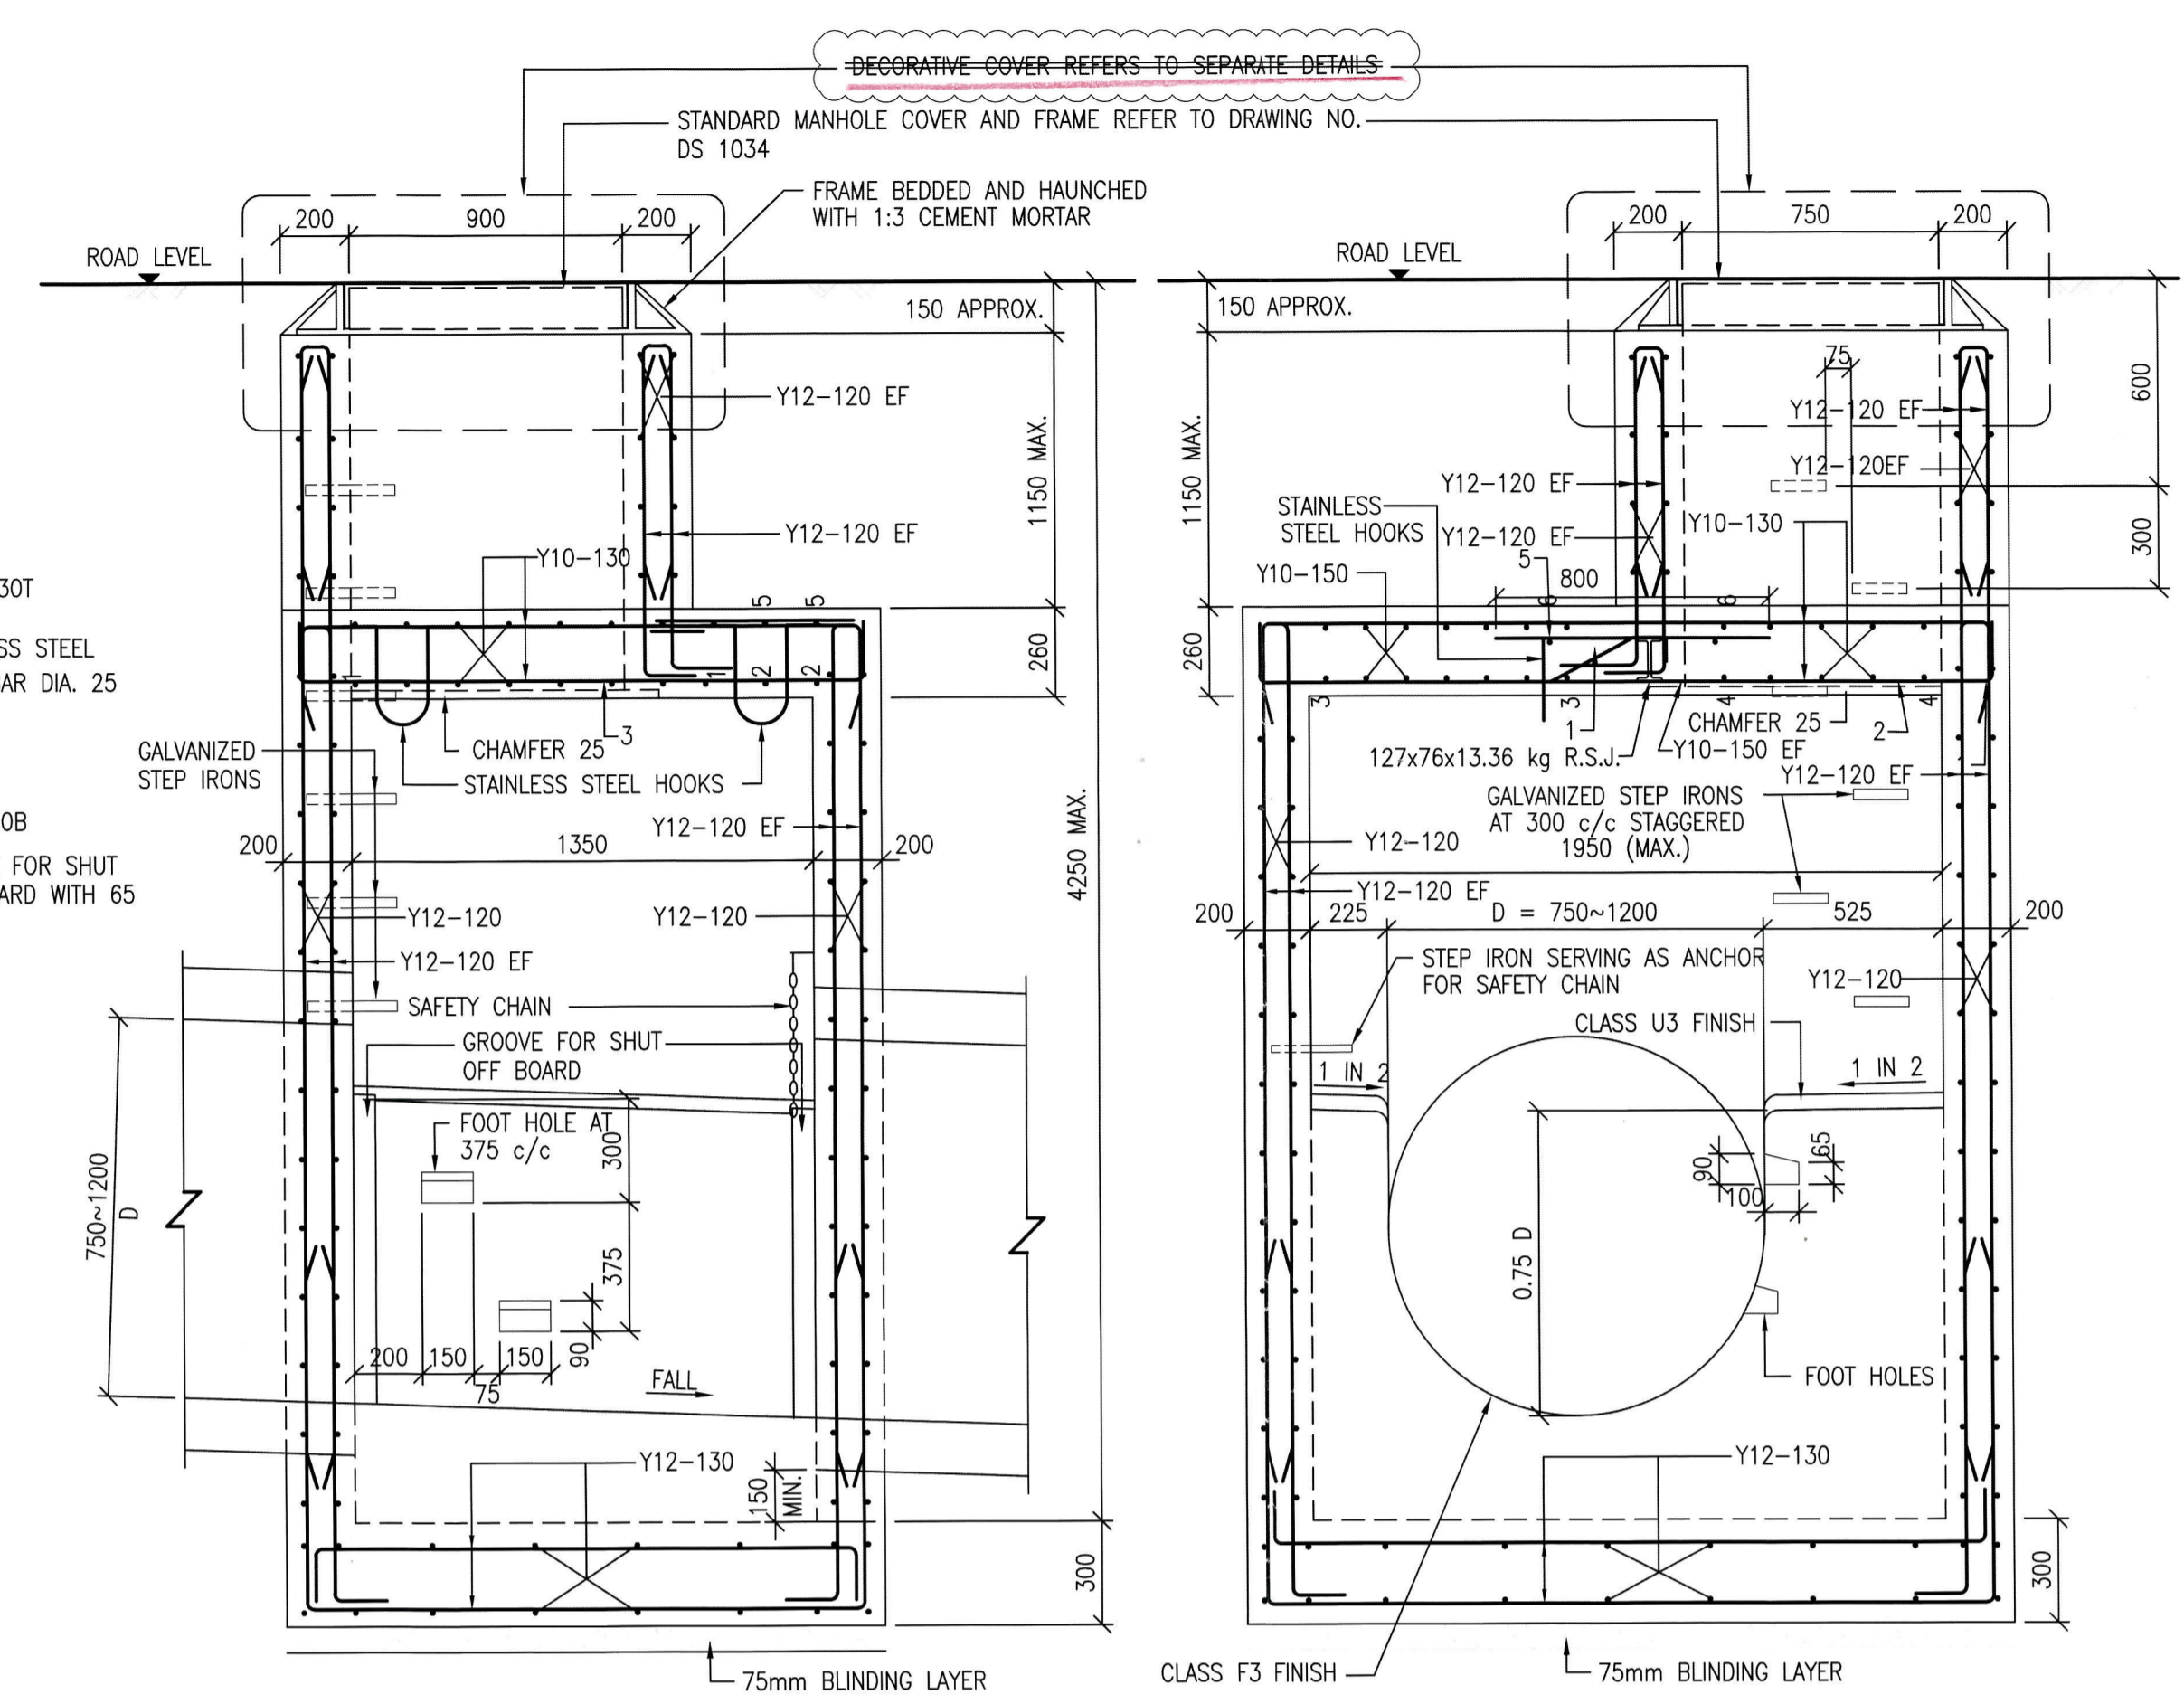

SECTION 1-1
1 : 20



SECTION 2-2
1 : 20

MANHOLE SCHEDULE


MANHOLE NO.	APPROX. COVER LEVEL (MPD)	MANHOLE TYPE	UPSTREAM INLET PIPE		DOWNSTREAM OUTLET PIPE		LENGTH (m)	GRADIENT		
			MANHOLE NO.	PIPE DIA. (mm)	INVERT LEVEL (mPD)	MANHOLE NO.			PIPE DIA. (mm)	INVERT LEVEL (mPD)
SMH-1	4.30	G1	CP3	850 DIA UC	2.230	SMH-2	1050.00	2.172	11.73	0.0049
SMH-2	5.40	I	SMH-1	1050.00	2.172	SMH-3	1050.00	1.906	53.23	0.0050
SMH-3	5.47	I	SMH-2	1050.00	1.906	SMH-4	1050.00	1.808	19.50	0.0050
SMH-4	5.25	I	SMH-3	1050.00	1.808	SAND TRAP	1050.00	1.800	1.50	0.0053

NOTES

- NOTES REFER TO DRG. NO.: SF-F003 & SF-F103.
- PIPE DIAMETER : 750 TO 1200mm
- NORMAL RANGE OF DEPTH : 2750 TO 4250mm (MEASURED FROM ROAD LEVEL TO LOWEST INVERT)
- USED IN : STORMWATER DRAIN AND SEWER.
- JUNCTION : POSITION OF JUNCTION TO BE DETERMINED IN EACH INDIVIDUAL CASE. CHANNELS IMMEDIATELY UNDER ACCESS TO MANHOLE SHOULD BE AVOIDED.
- TOP TREATMENT : SEE DRG. NO. DS 1032.
- FOUNDATION : FOUNDATION OF MANHOLE VARIES WITH SITE CONDITION. THEREFORE, IT SHOULD BE DETERMINED ON SITE BY THE ENGINEER.
- CONCRETE : GRADE 35/20.
- ALL BAR MARKS APPEARED HEREON ARE USED REFERENCE IN THIS DRAWING ONLY.
- MINIMUM COVER AT THE END OF BARS 40mm.
- REINFORCEMENT SHALL COMPLY WITH BS 4449, BENDING OF REINFORCEMENT SHALL COMPLY WITH BS 8666.
- COVER AND FRAME NOT SHOWN ON PLAN FOR CLARITY.

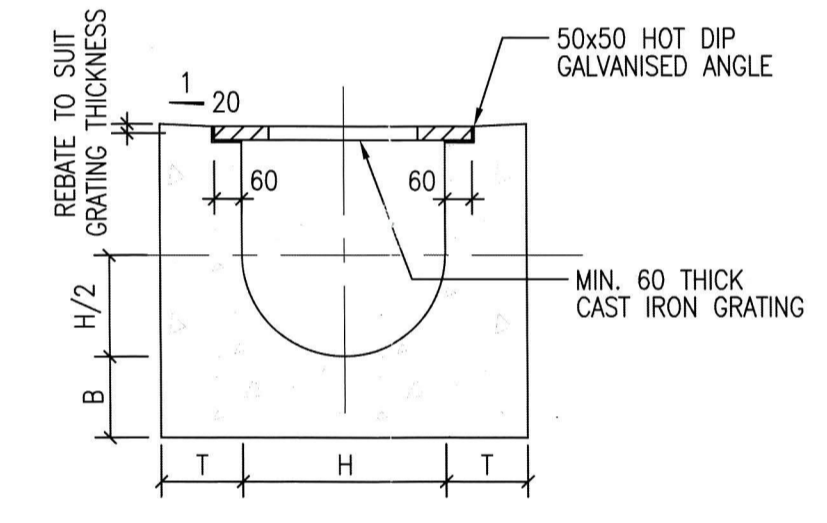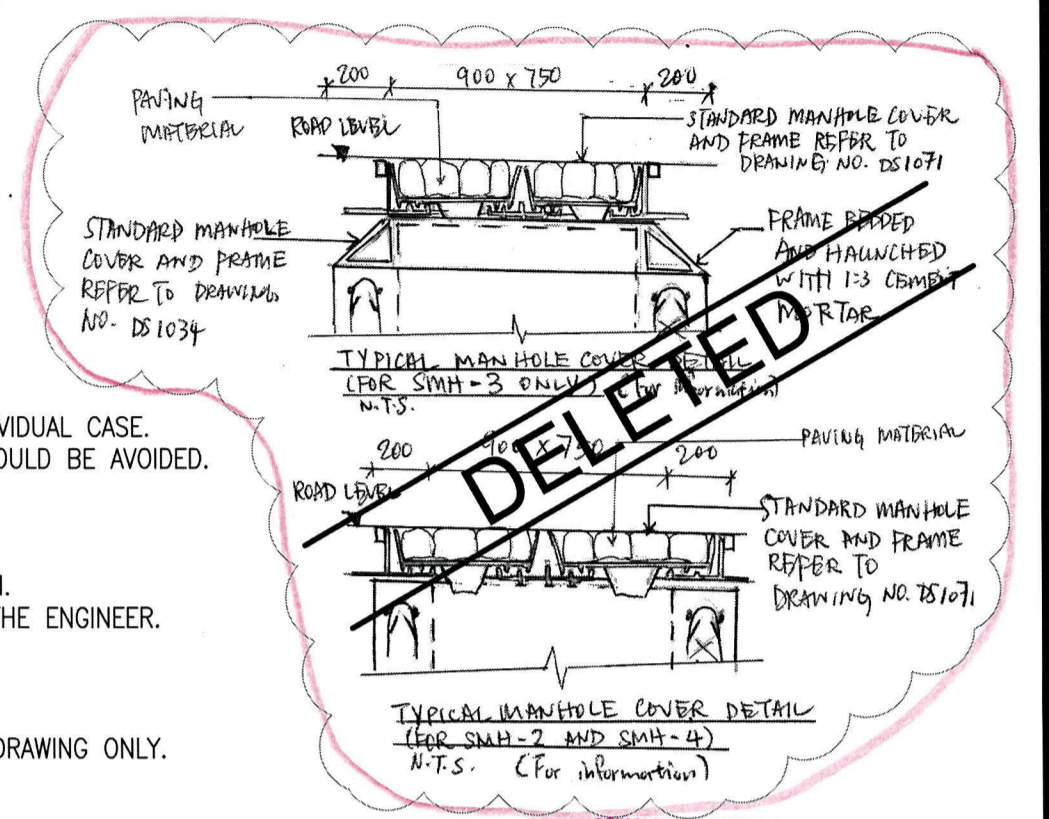

TYPICAL SECTION
N.T.S.

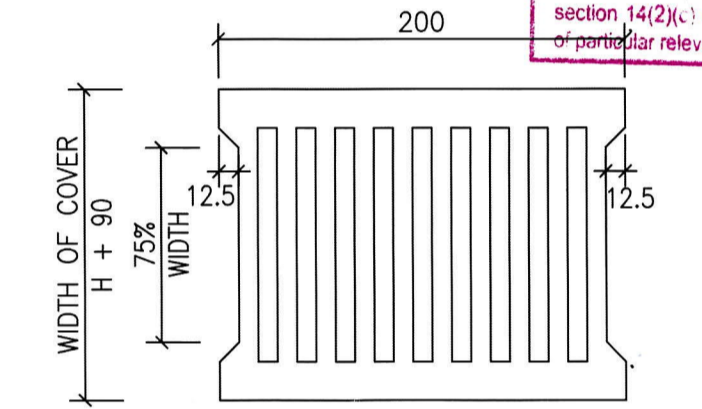

CAST IRON GRATING

NOMINAL SIZE H	T	B	REINFORCEMENT
< 300	100	100	NIL
375 - 675	150	150	A393 MESH PLACED CENTRALLY
750 - 900	175	175	B1131 MESH PLACED CENTRALLY

U-CHANNEL WITH CAST IRON GRATING
N.T.S.


CATCH PIT SCHEDULE

APPROX. COVER LEVEL (mPD)	CATCH PIT NO.	FROM		TO		LENGTH (m)	GRADIENT
		INVERT LEVEL (mPD)	CATCH PIT NO.	INVERT LEVEL (mPD)	CATCH PIT NO.		
4.38	CP1	3.000	CP2	2.866	CP3	30.3	0.0044
4.13	CP2	2.866	CP3	2.855	SMH-1	2.3	0.0047
4.20	CP3	2.855	SMH-1	2.630		13	0.0082
5.30	XCP2	4.650	XCP1	3.760		33.6	0.0176
4.43	XCP1	3.460	CP4	3.350		35.0	0.0031
4.36	CP4	3.350	CP5	3.295		12.2	0.0050
4.43	CP5	3.295	CP6	3.151		28.8	0.0050
4.55	CP6	3.151	CP7	3.050		20.3	0.0050
4.52	CP7	3.050	TMH-1	2.990		12.7	0.0050

RECORD PLAN


"The works shown on these plans are Type II works (Site Formation (Flood Mitigation)) in respect of which consent is applied for the purpose of Fast Track consent application under regulation 33 of the Building (Administration) Regulations."

AMENDMENT

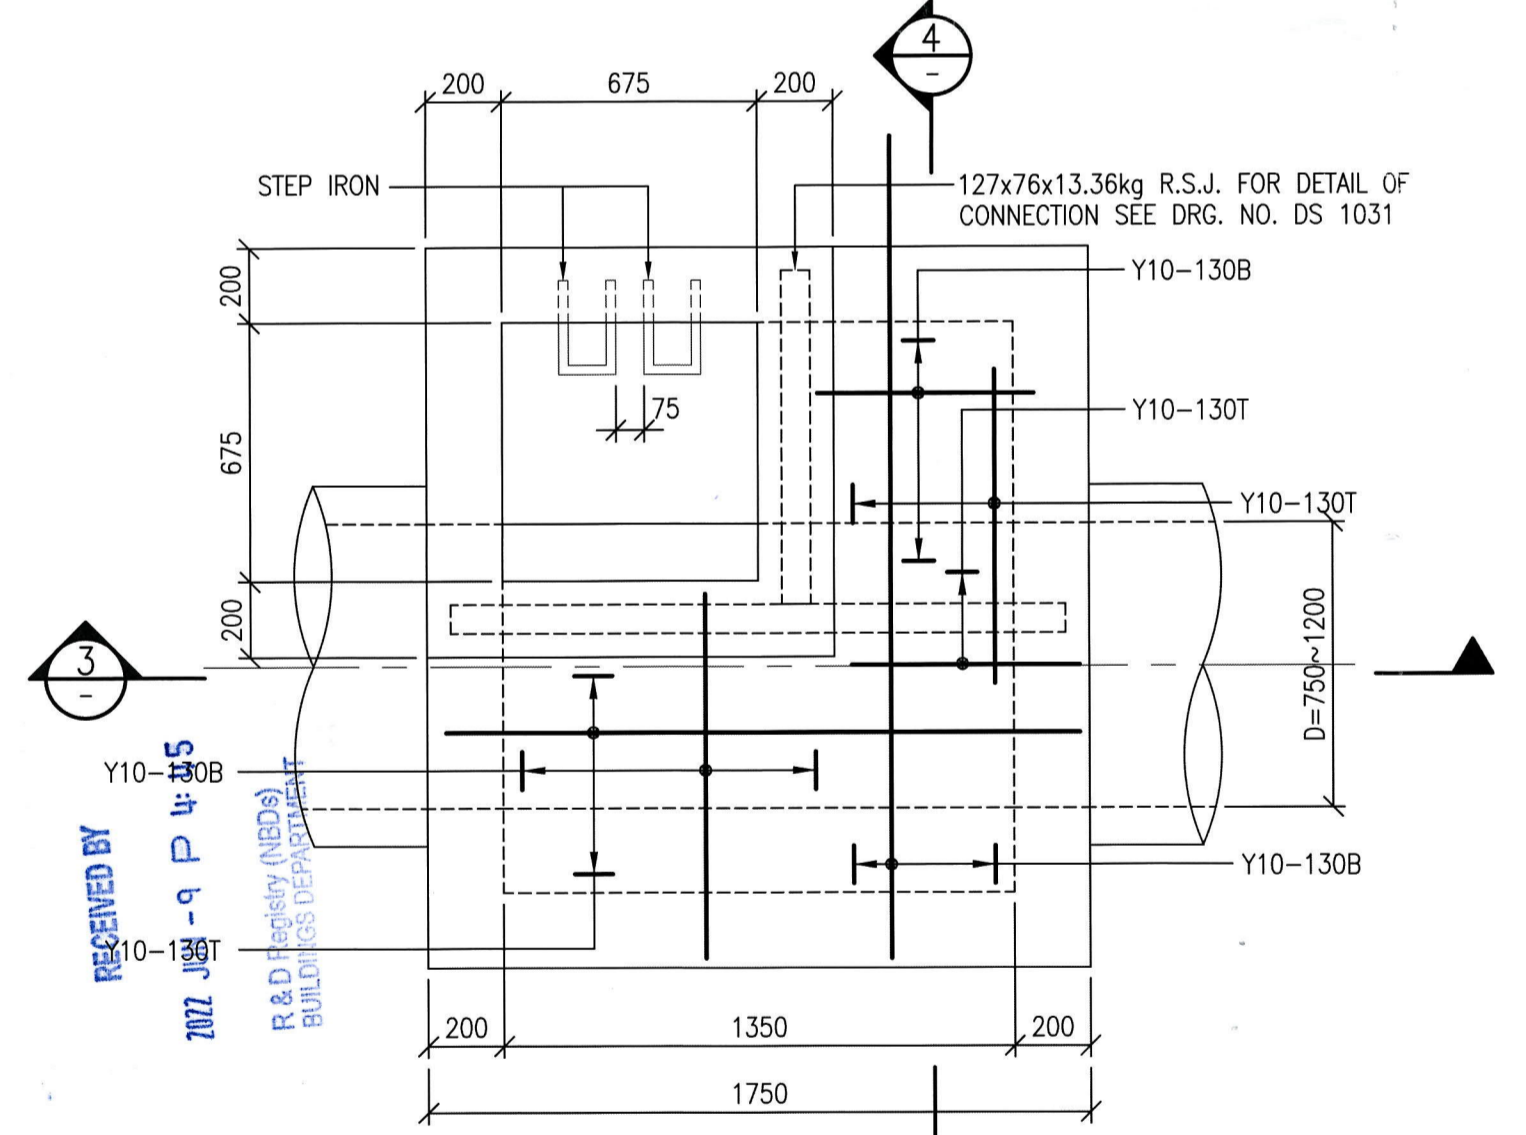


PLAN
MANHOLE TYPE G1
(WITHOUT DESILTING OPENING)
1 : 20

BAR MARKS	SHAPE CODE
1 & 4	99
2 & 3	33
5 & 6	20

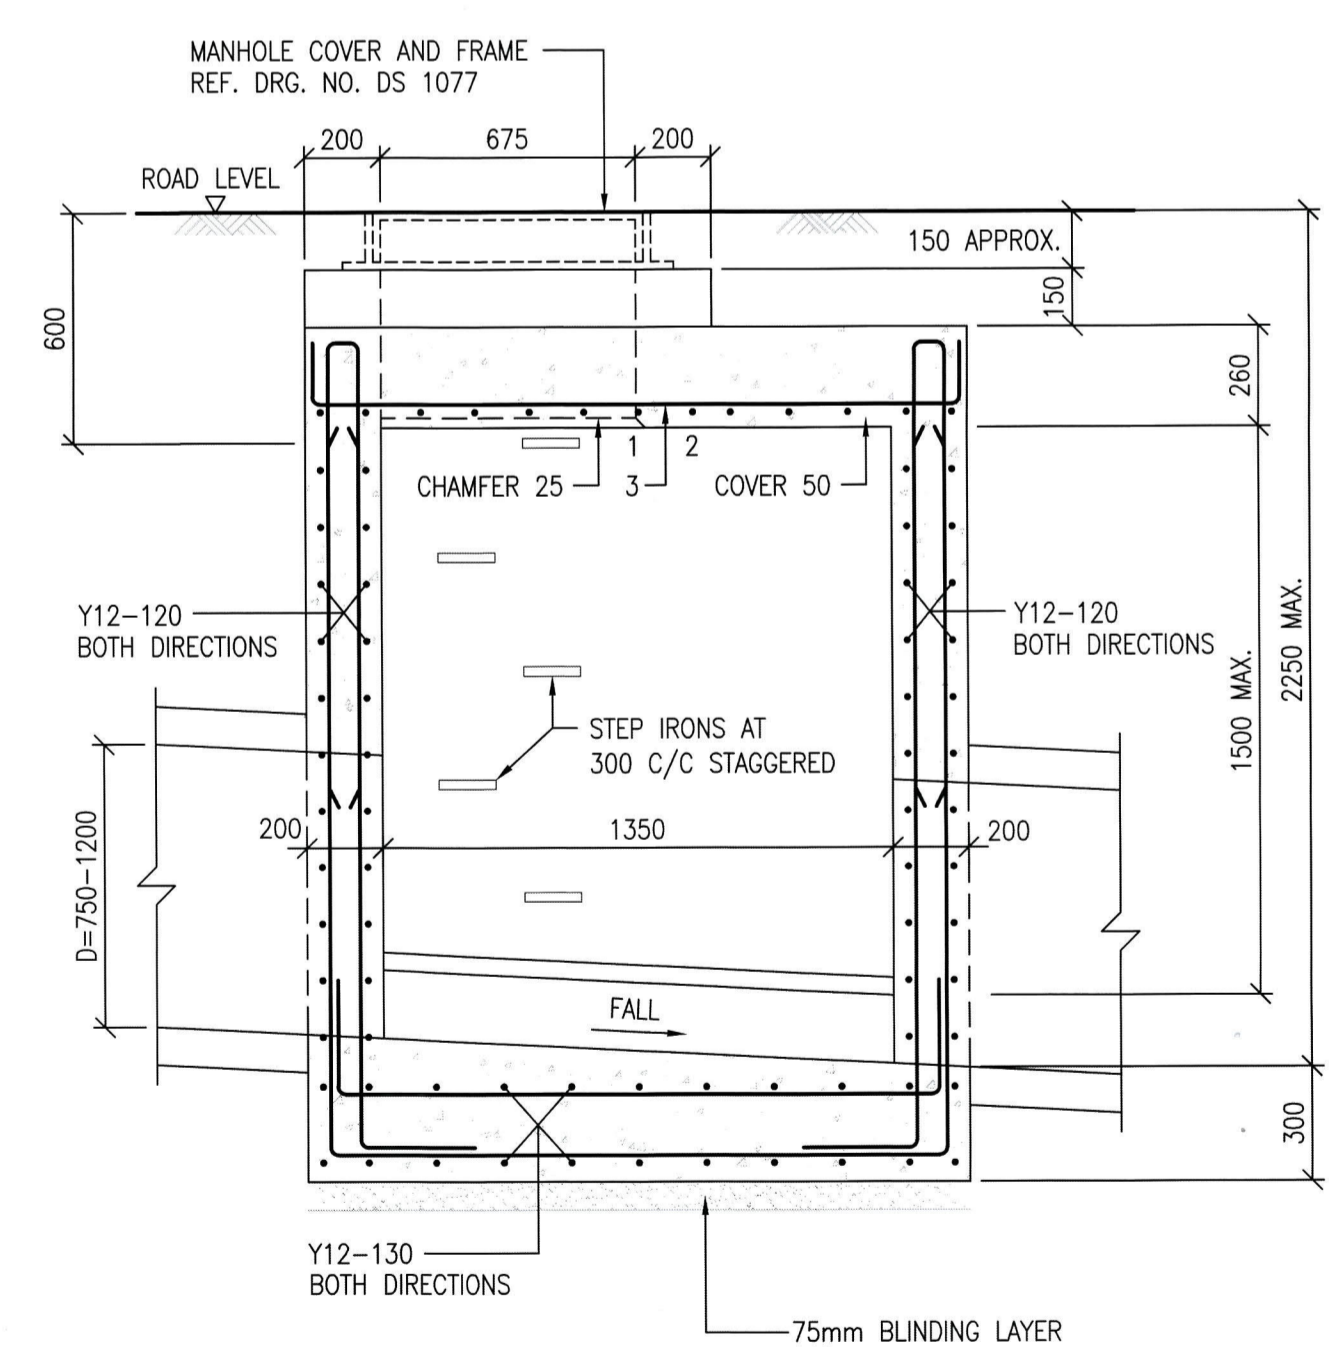

SECTION 3-3

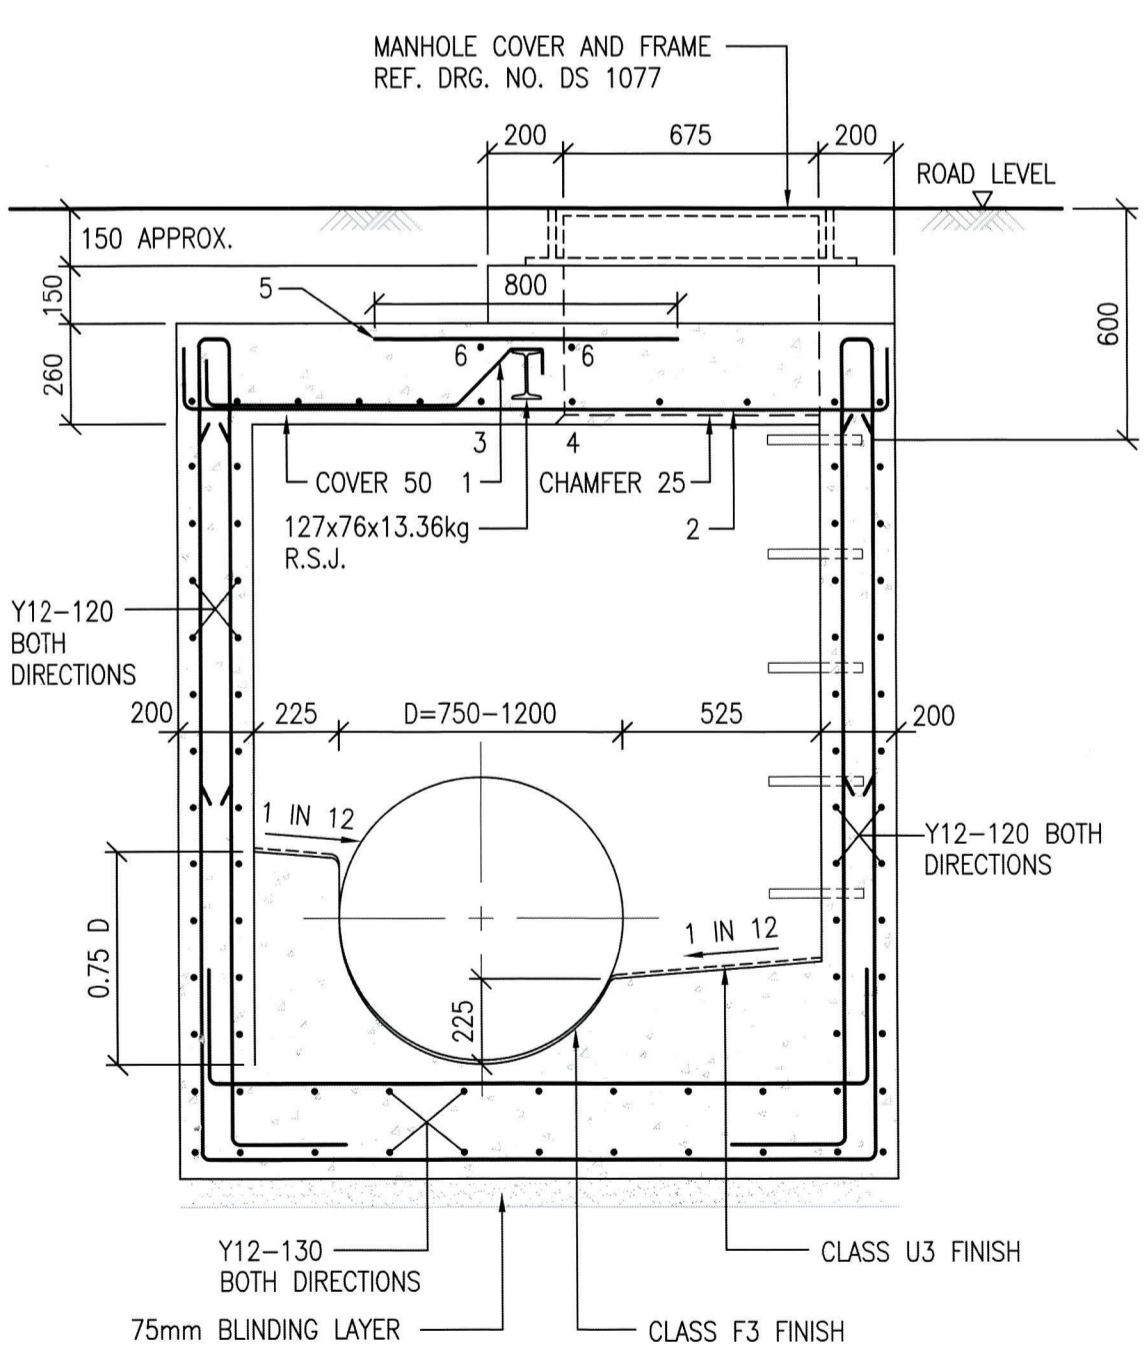

SECTION 4-4

REV.	DATE	DESCRIPTION
D	06/2022	GENERAL REVISION
-	-	BD APPROVED ON 24 FEB 2022
C	01/2022	BD APPROVED ON 24 FEB 2022
-	-	BD APPROVED ON 12 OCT 2021
B	09/2021	GENERAL REVISION
A	07/2020	GENERAL REVISION
-	-	BD APPROVED ON 02 MAR 2017

PROJECT
**RESIDENTIAL DEVELOPMENT
KAM POK ROAD NEW TERRITORIES**

DRAWING TITLE
**SITE FORMATION FOR FLOOD MITIGATION -
RC DETAILS AND SCHEDULE FOR MANHOLE**

JOB NO.	DESIGNED
	J.L.

DATE	DRAWN
12/2016	J.L.


SCALE	CHECKED
1:20 (A1)	J.L.

DRG. NO.	STATUS
SF-F004	SUBMISSION


ARCHITECT
P&T Architects and Engineers Ltd
巴馬丹拿建築及工程師有限公司

ENGINEER
STEPHEN CHENG
CONSULTING ENGINEERS LTD.


- NOTE**
1. NOTES AND DETAILS REFER TO DRG. NO.: SF-F003 & SF-F103.
 2. LOCATION OF SANDTRAP AND BOX CULVERT REFER TO DRG. NO.: SF-F001.

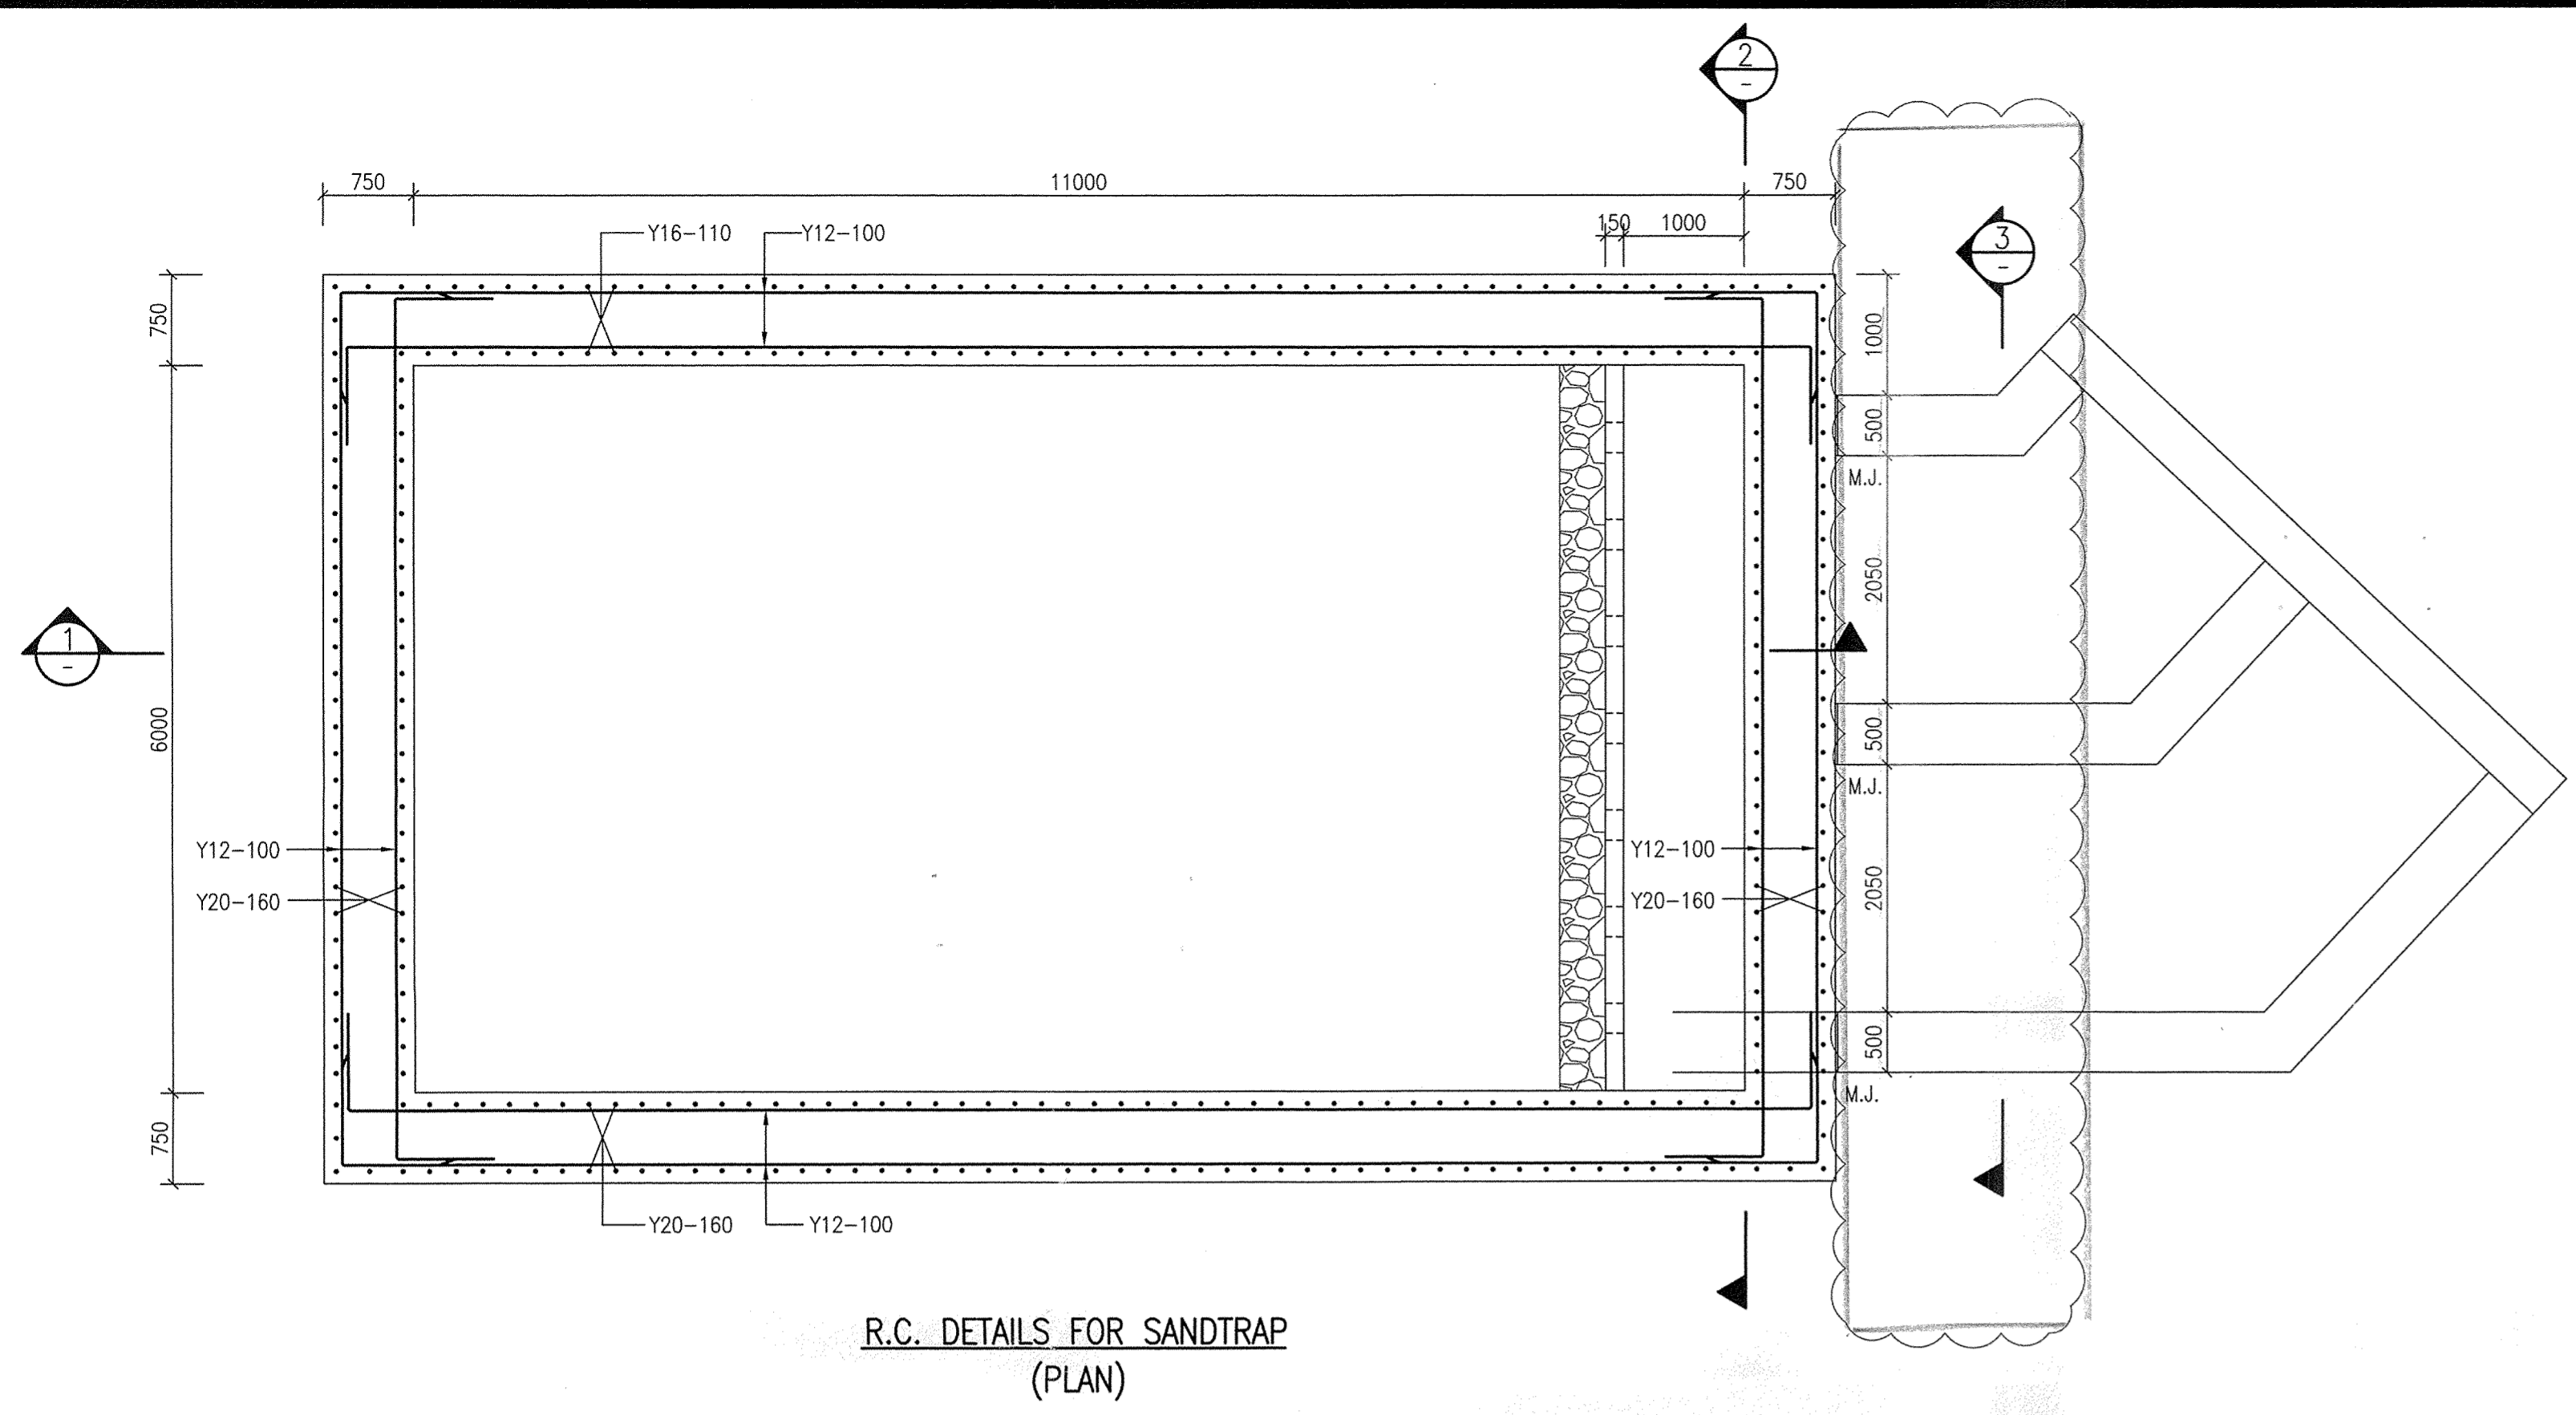


R.C. DETAILS FOR SANDTRAP (PLAN)

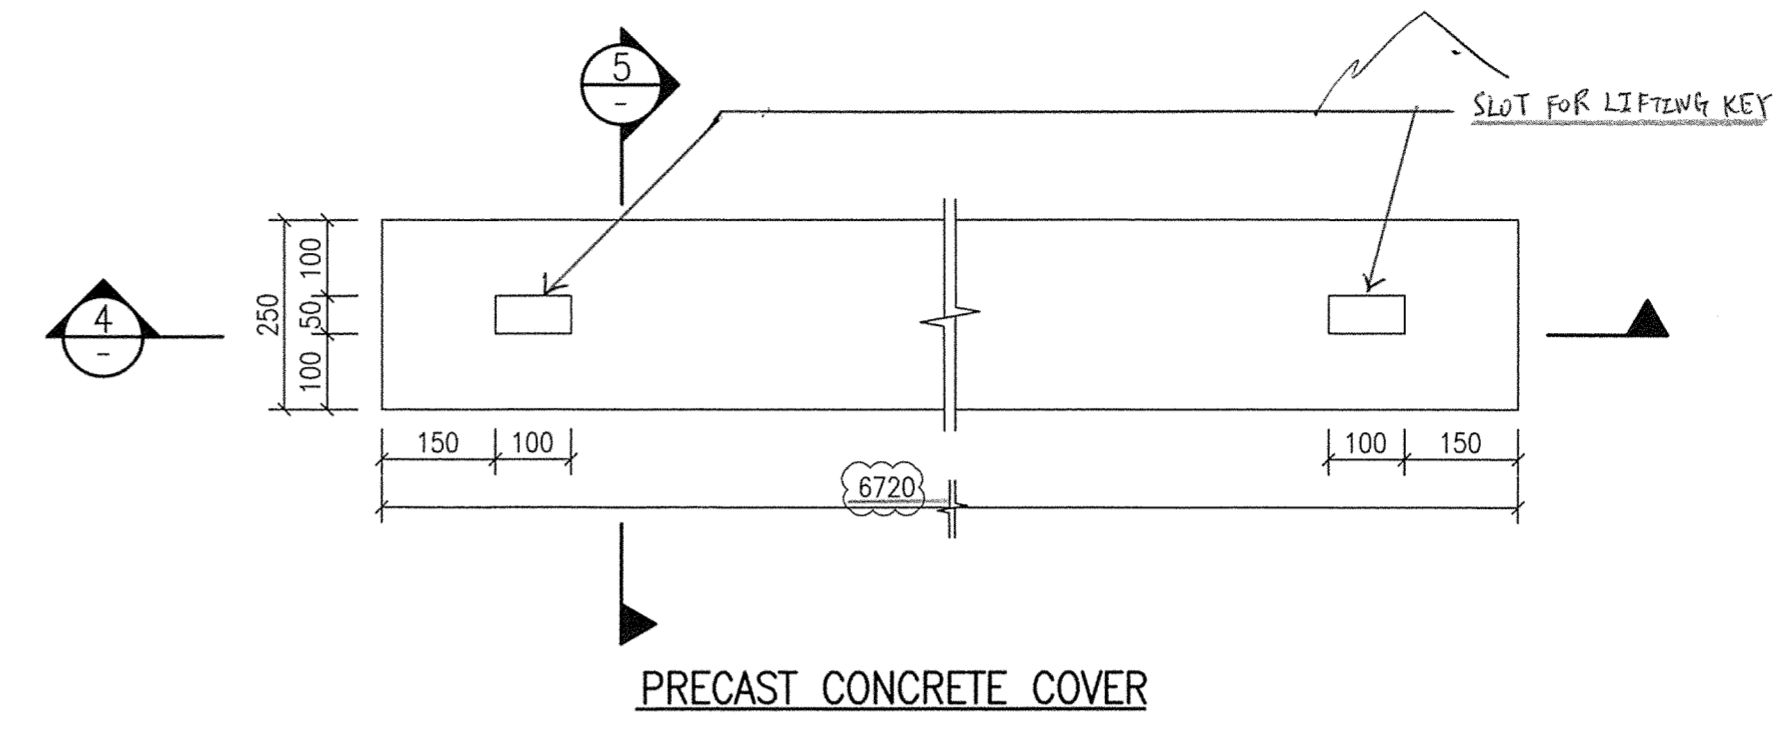

PRECAST CONCRETE COVER

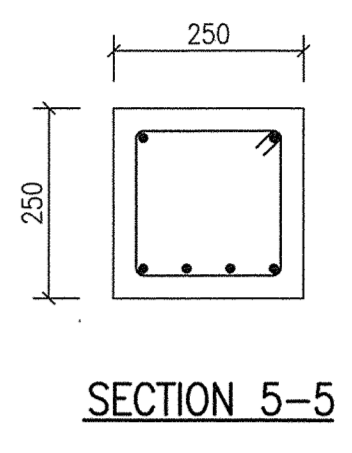

SECTION 5-5

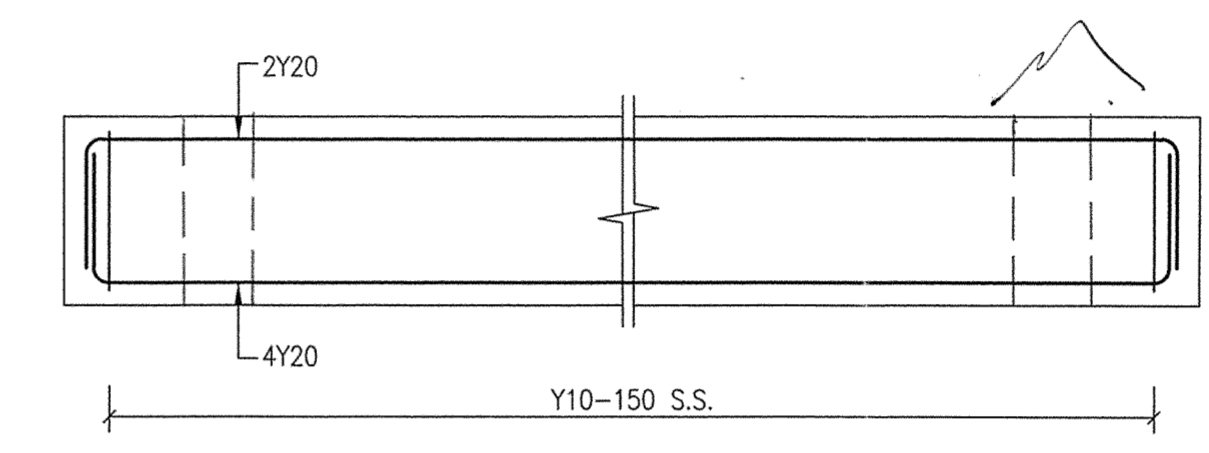


RC DETAILS FOR PRECAST CONCRETE COVER

BUILDINGS DEPARTMENT


AMENDED PLAN

Note: This plan has been processed on a computerized check base under the centralized processing system as promulgated in PNAP ADAS-19. The duties of the authorized person, registered structural engineer and/or registered geotechnical engineer contained in specified under section 4(3)(b) and the provision of section 14(2)(c) of the Buildings Ordinance are of particular relevance in this regard.


Cheng Hong Ma, Michael
B.A. (U.S.), B. Arch. H.K.I.A. R.I.B.A.
Authorized Person, Architect

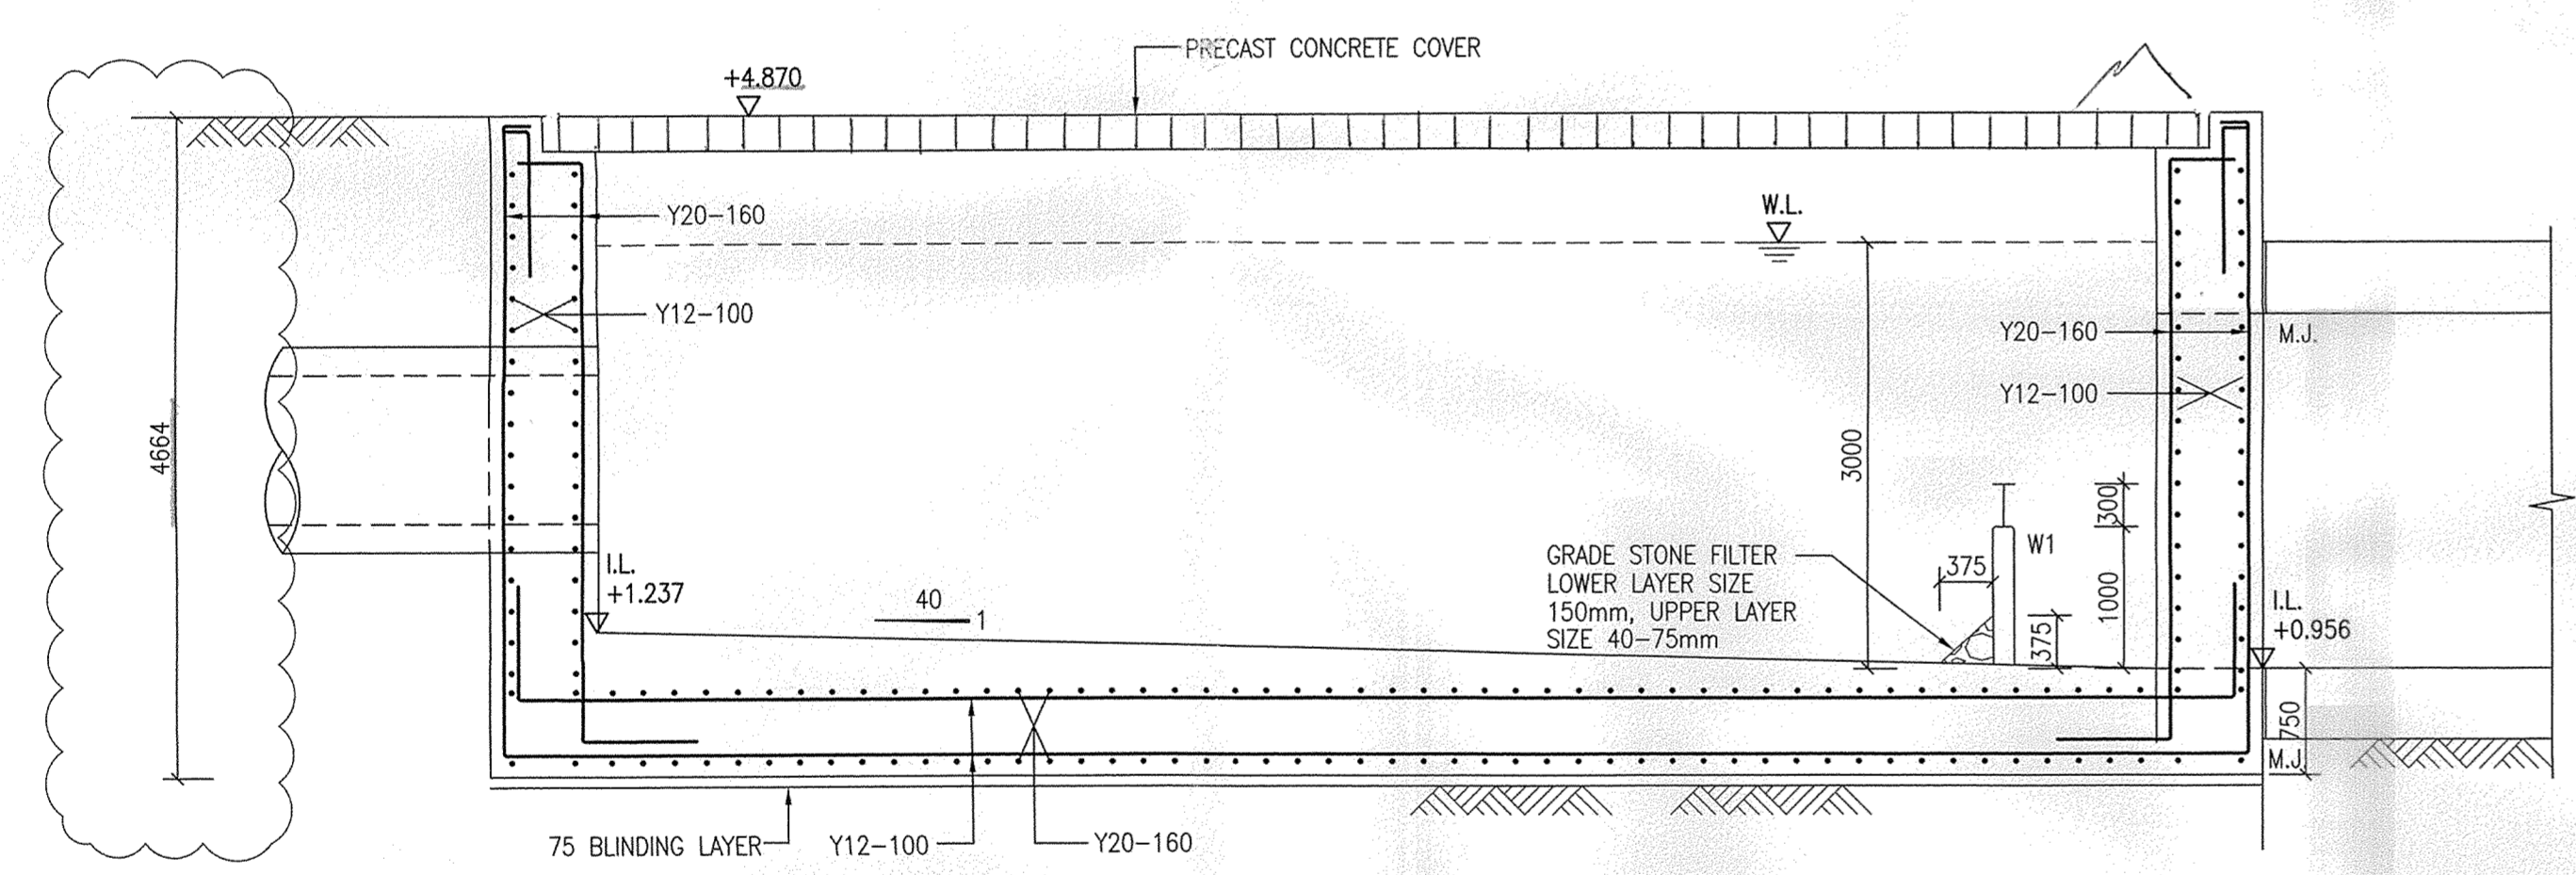


SECTION 1-1

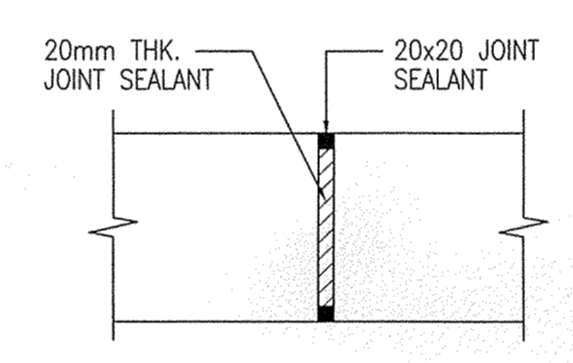


TYPICAL DETAIL OF MOVEMENT JOINT (M.J.)

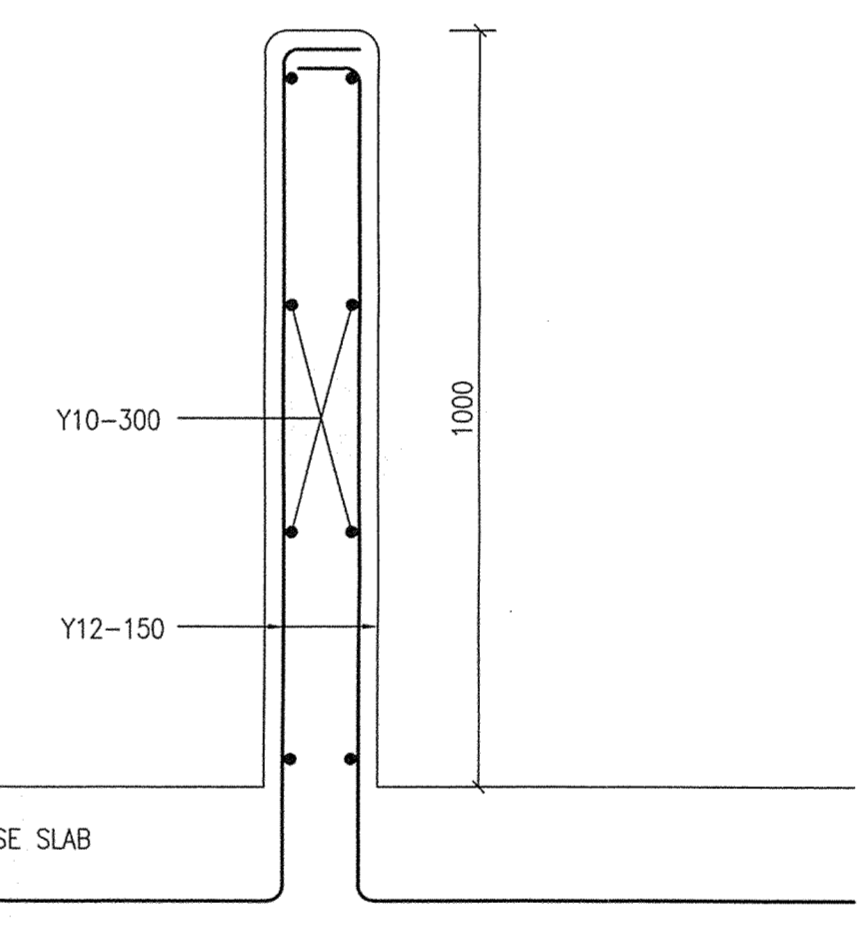


R.C. DETAIL OF LW1
N.T.S.

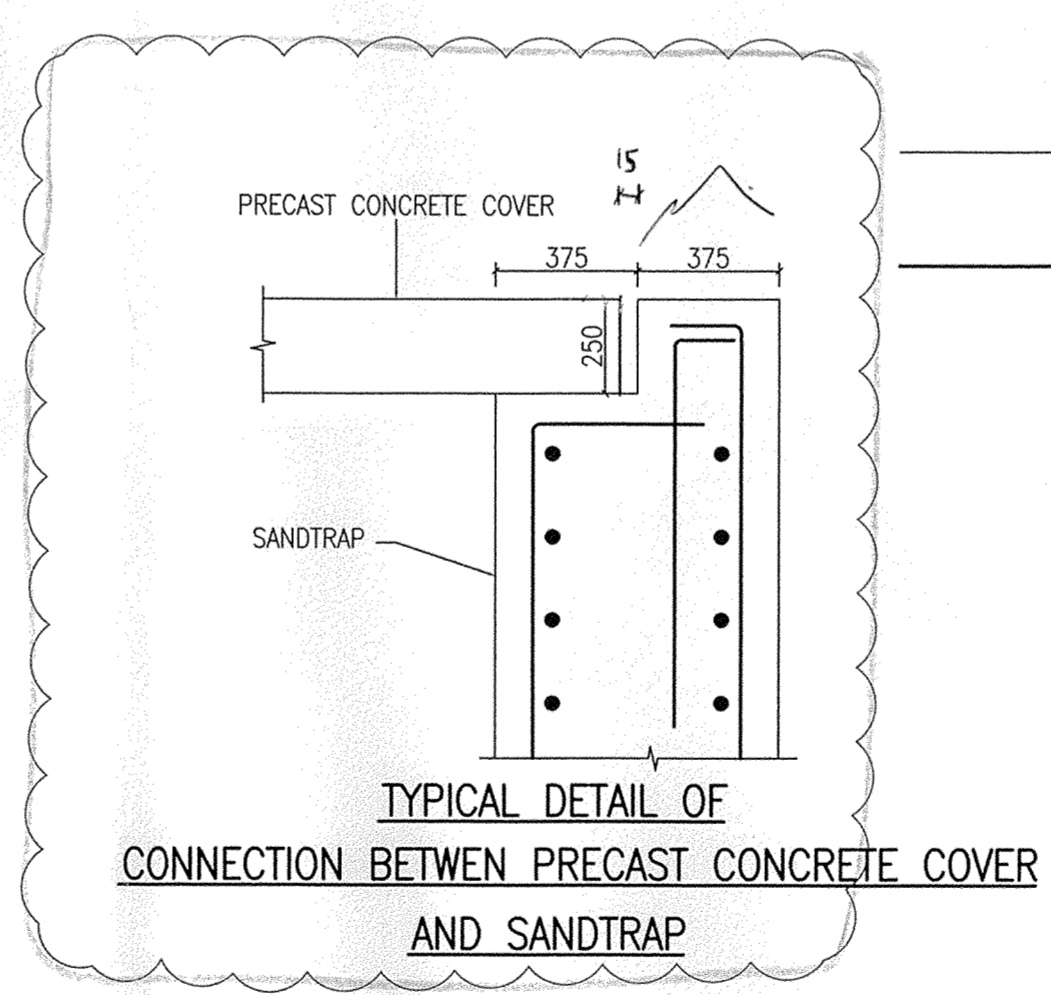

TYPICAL DETAIL OF CONNECTION BETWEEN PRECAST CONCRETE COVER AND SANDTRAP

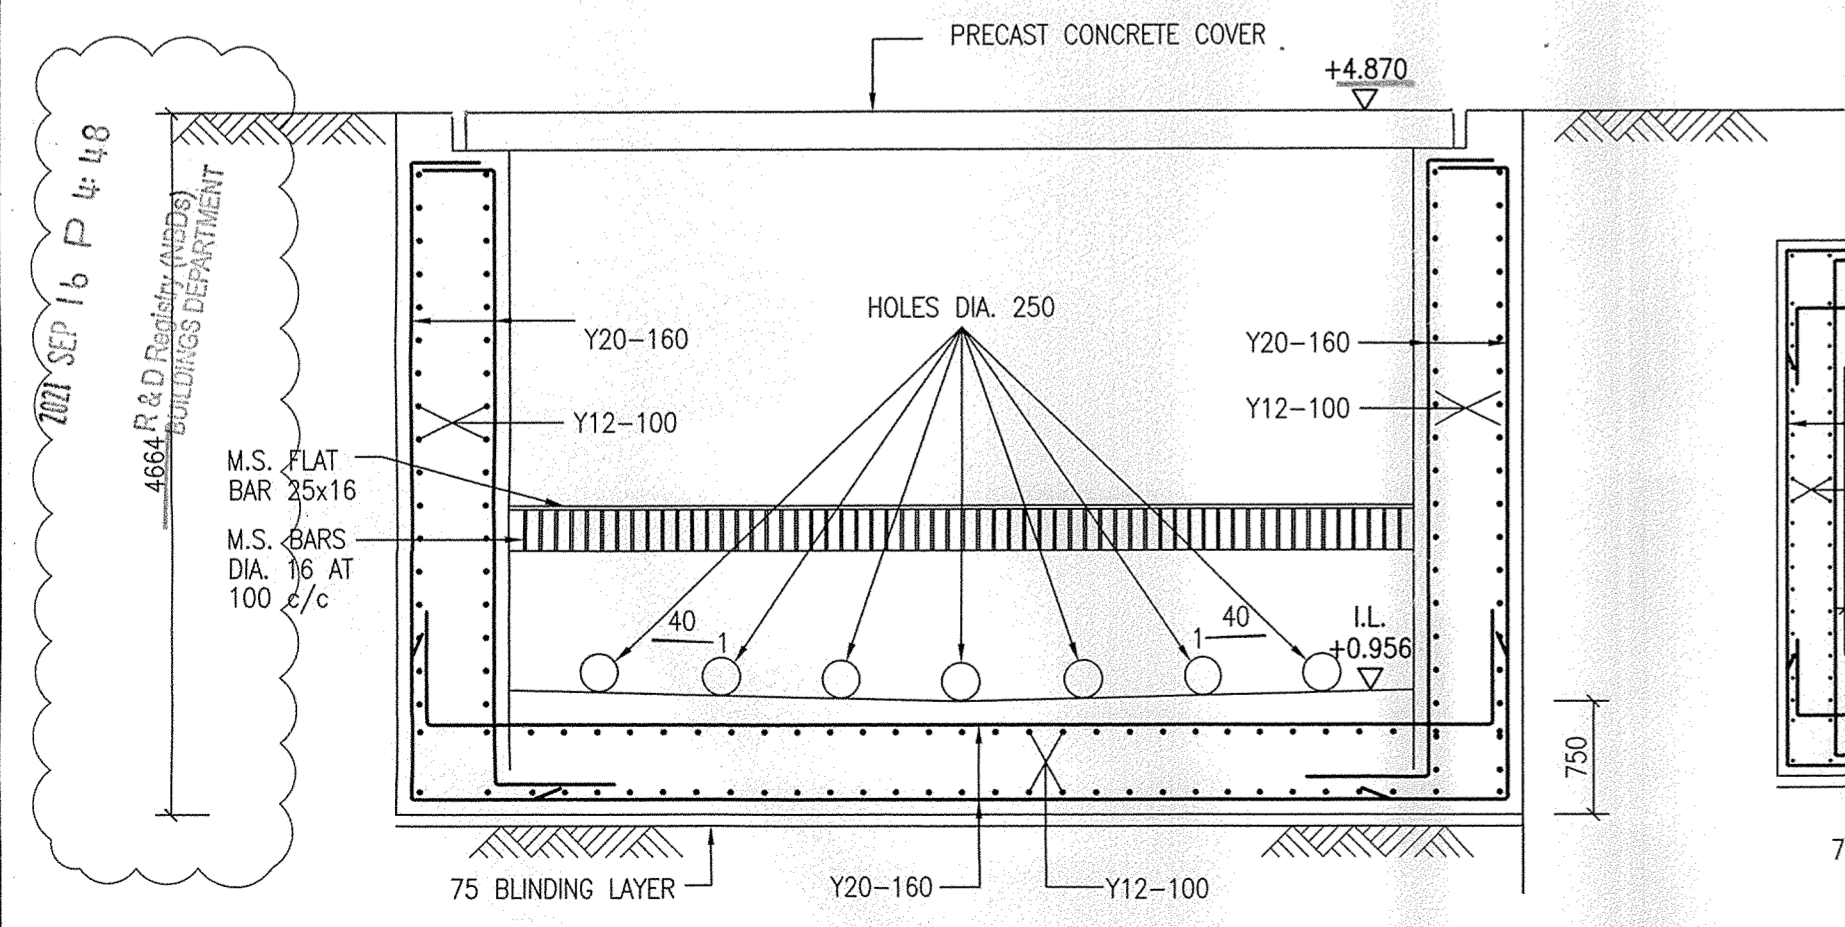

SECTION 2-2

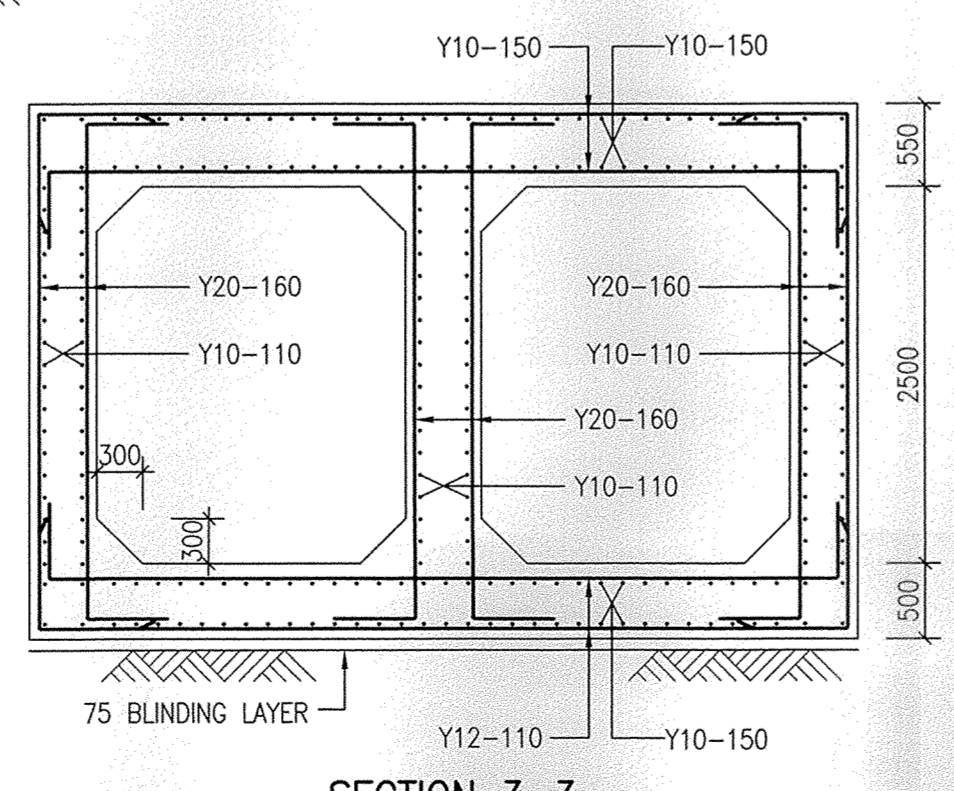

SECTION 3-3
R.C. DETAILS FOR BOX CULVERT

REV.	DATE	DESCRIPTION
B	09/2021	GENERAL REVISION
A	07/2020	GENERAL REVISION
-	-	BD APPROVED ON 02 MAR 2017

PROJECT
RESIDENTIAL DEVELOPMENT
KAM POK ROAD NEW TERRITORIES

DRAWING TITLE
SITE FORMATION FOR FLOOD MITIGATION -
RC DETAILS OF SANDTRAP AND BOX CULVERT

JOB NO.	DESIGNED	CATH
DATE	12/2016	DRAWN WIN
SCALE	1:50 (A1)	CHECKED TONY
DRG. NO.	SF-F005	STATUS SUBMISSION

ARCHITECT
mcaal
michael chiang and associates architects

ENGINEER
STEPHEN CHENG
CONSULTING ENGINEERS LTD.


RECORD PLAN

AMENDMENT


CAD FILE : D:\Low\Flood Mitigation Overlay with 20210817 Site Boundary\20210913\SF-F005B DR PLAN_RC SANDTRAP.dwg

RECEIVED BY



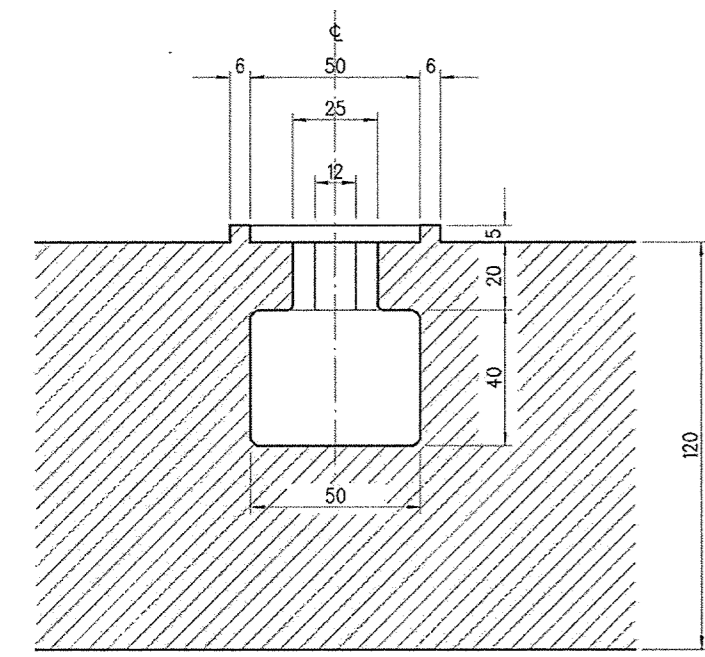


SECTION D-D

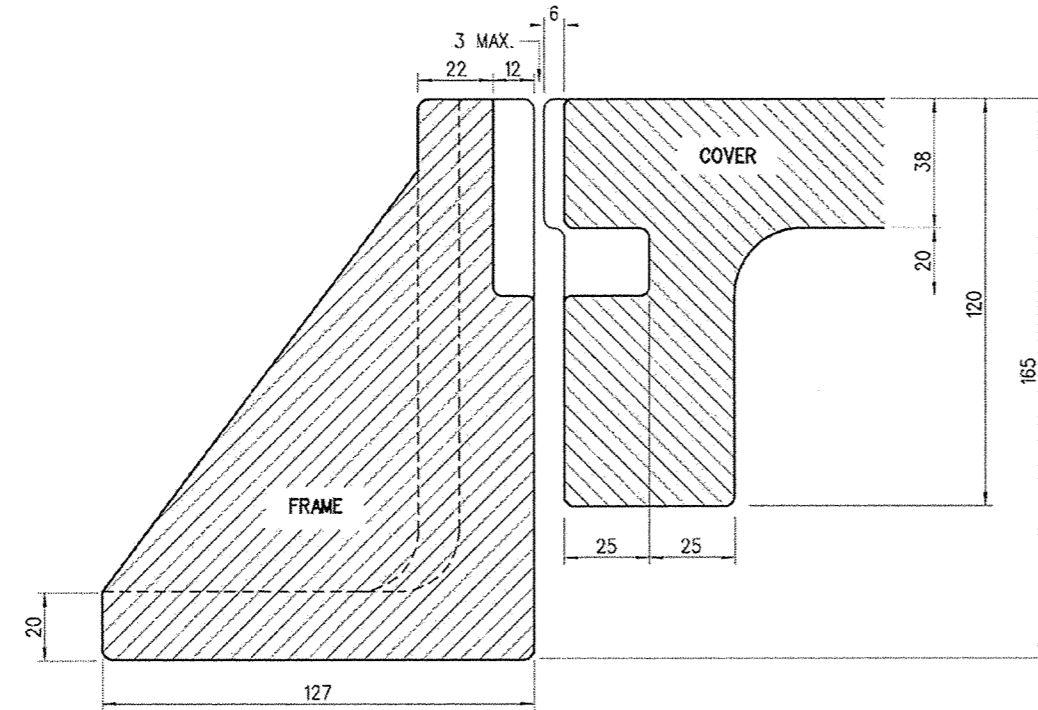


SECTION E-E

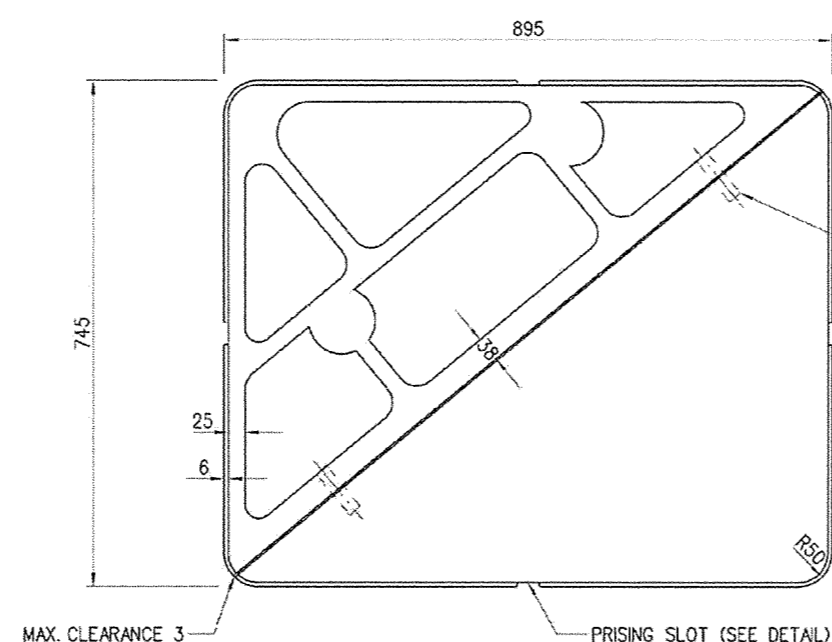


BOTTOM PLAN OF COVER

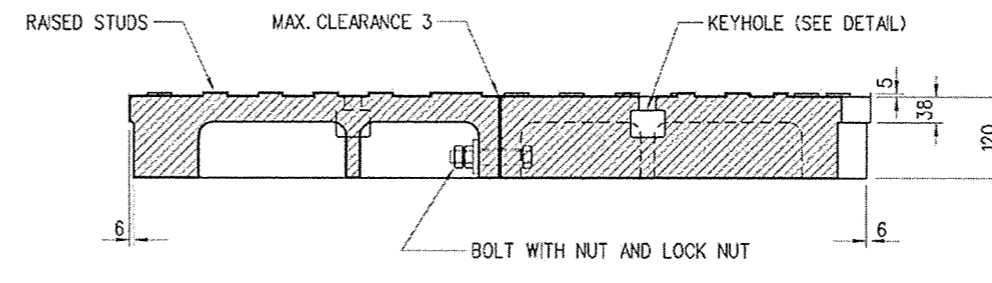


SECTION C-C

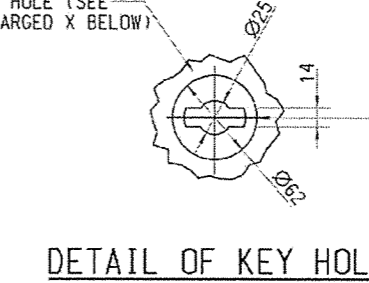


DETAIL OF KEY HOLE

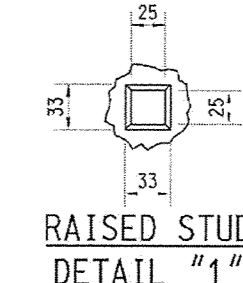


RAISED STUD DETAIL "1"

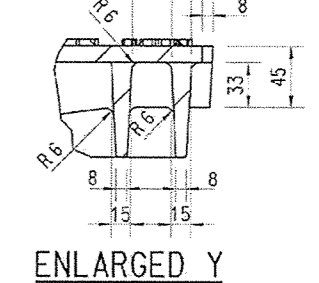


ENLARGED Y

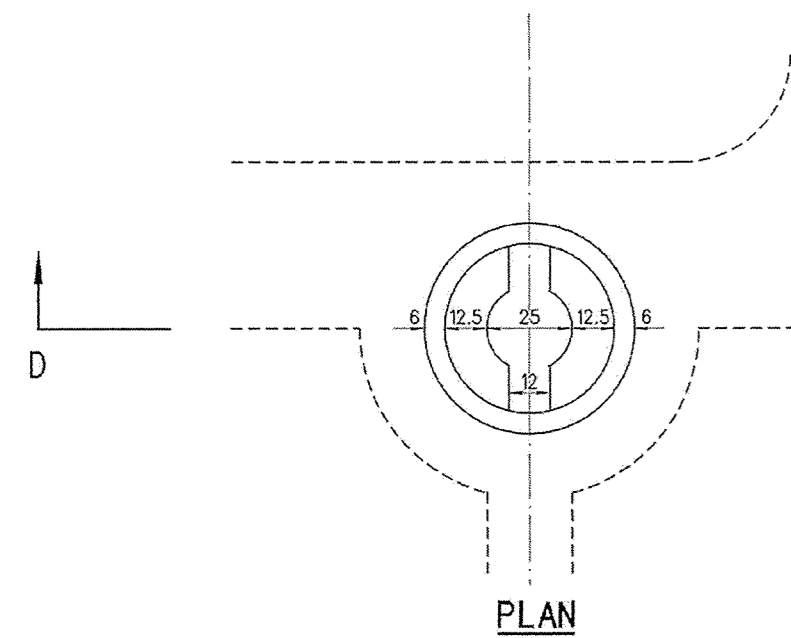


PLAN KEYHOLE

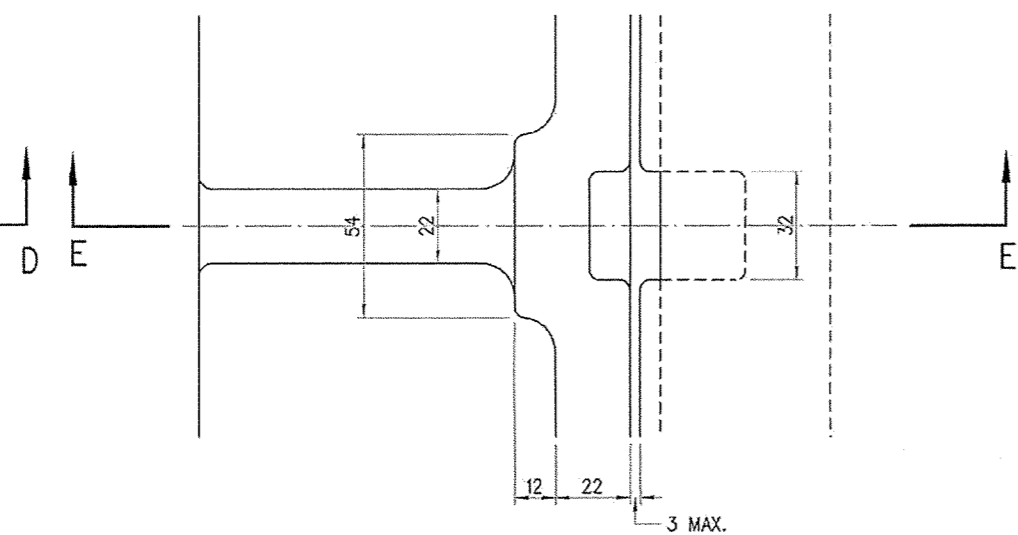


PLAN PRISING SLOT

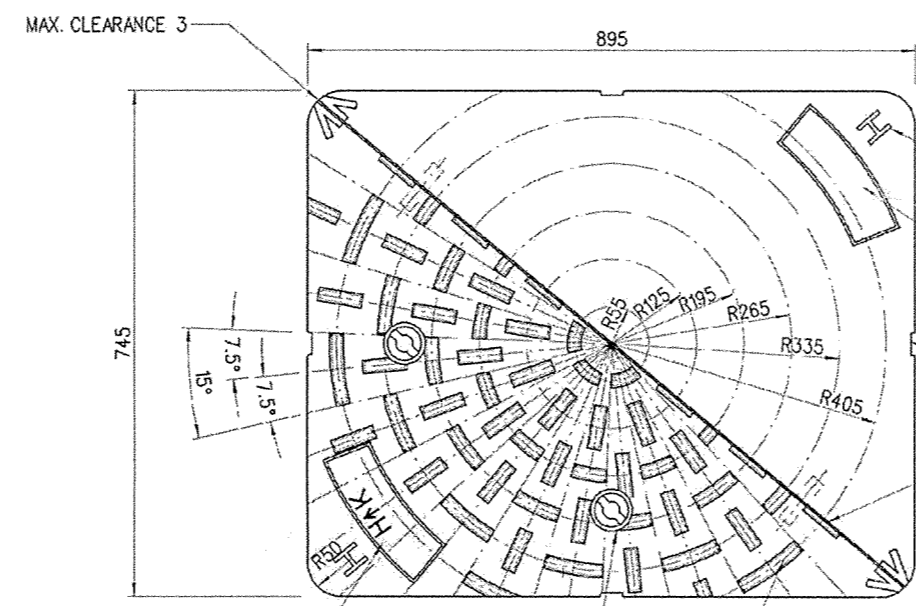


TOP PLAN OF S.W.D. MANHOLE COVER

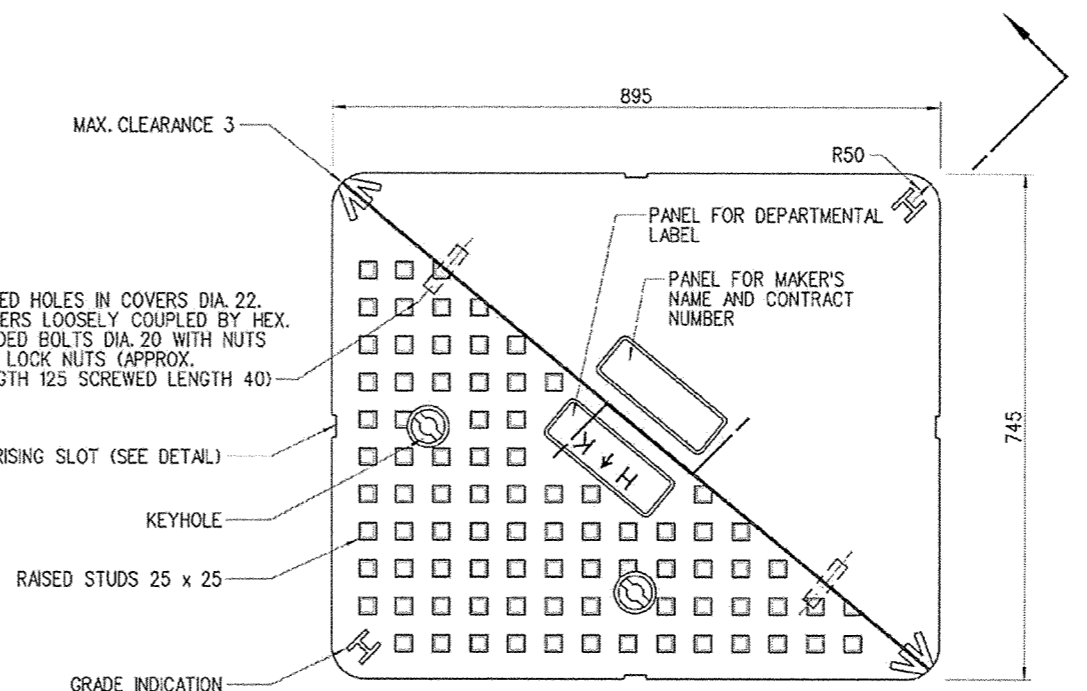

TOP PLAN OF SEWER MANHOLE COVER

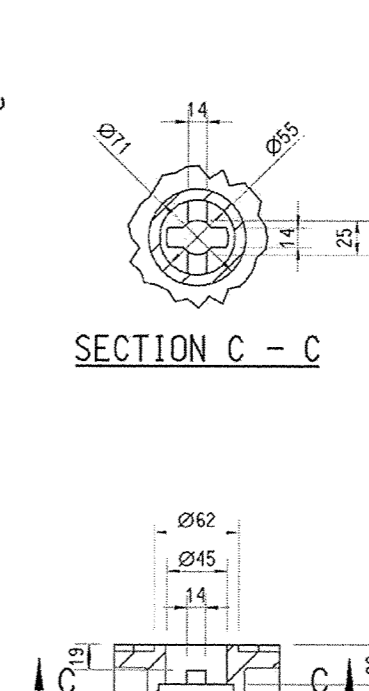


SECTION C - C

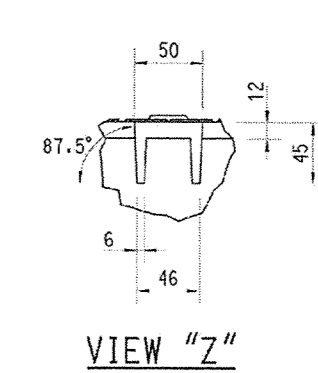


VIEW "Z"

Note: This plan has been processed on a curtailed check basis under the centralized processing system as promulgated in PNAP ADM-18. The duties of the authorized person, registered structural engineer and/or registered geotechnical engineer concerned as specified under section 14(1)(b) and the provision of section 14(1)(c) of the Building Ordinance are of particular reference in this regard.

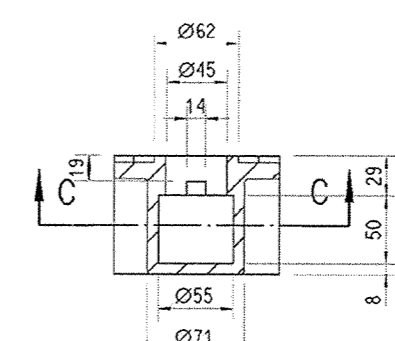


ENLARGED X (KEY HOLE)

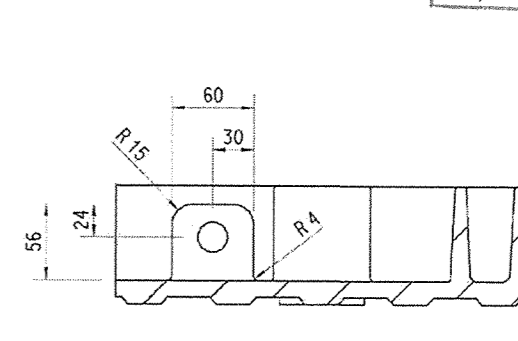


ANCHOR HOLE DETAIL "2"


- NOTES:
 1. FOR GENERAL NOTES OF DUCTILE IRON MANHOLE COVER & FRAME, REFER TO DRG. NO. DS1076 (2 SHEETS)
 2. FILLETS FOR BOTTOM ENDS OF THE COVER EDGES AND RIBS ARE R1. OTHER UNSPECIFIED FILLETS ARE R2

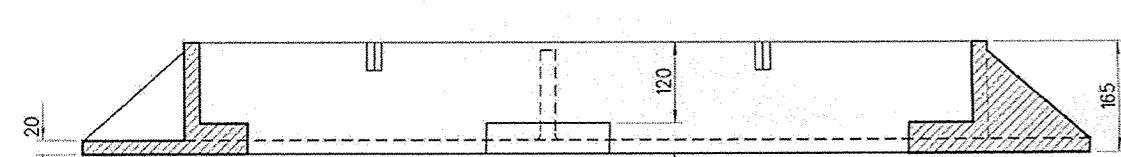


SECTION B-B

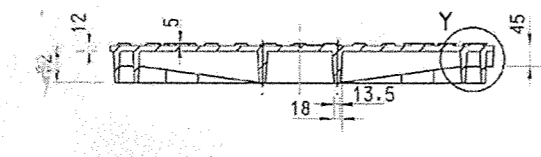


SECTION A - A = SECTION B - B

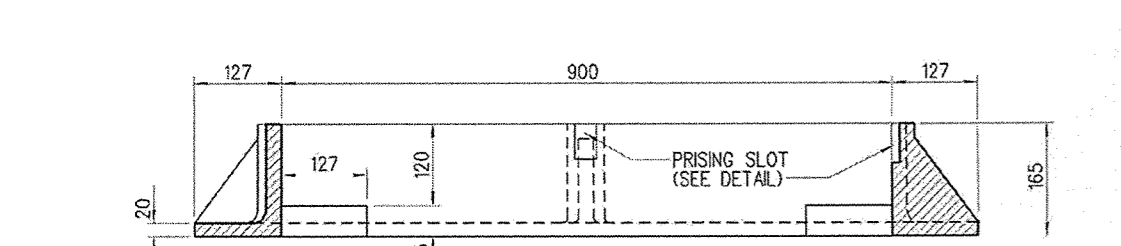


SECTION A-A

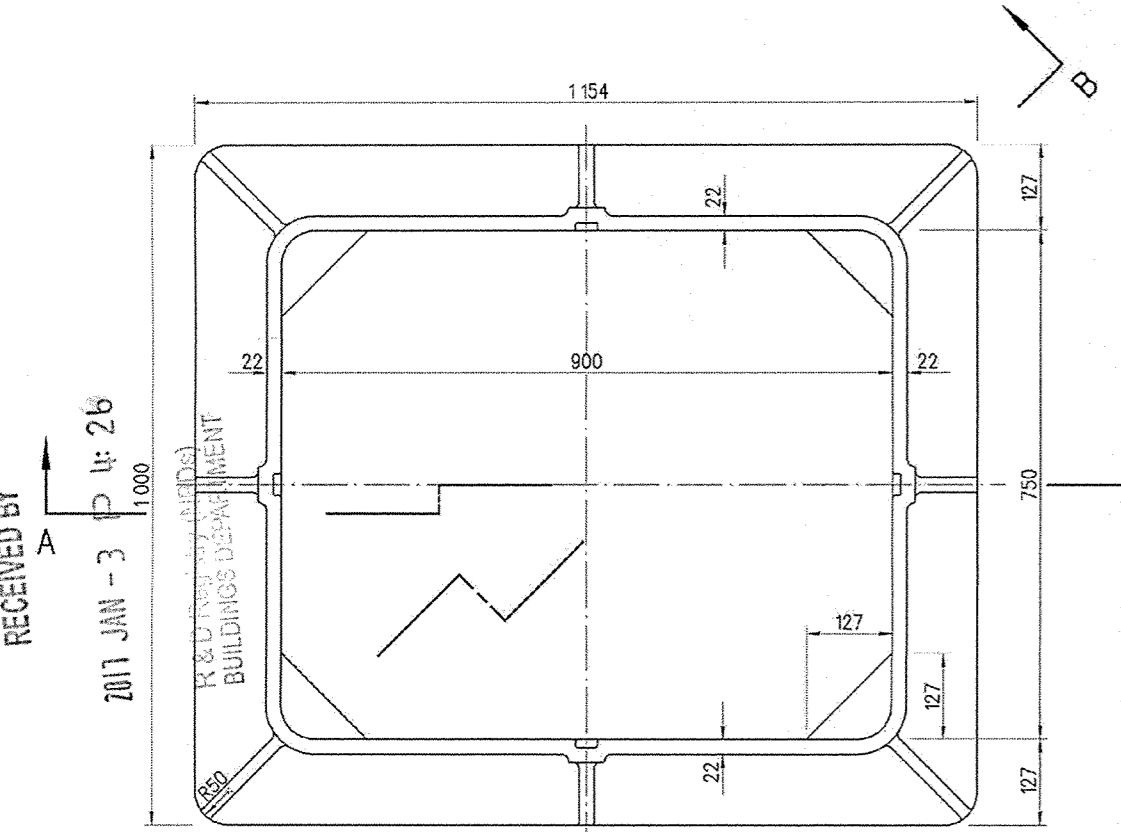


PLAN OF FRAME

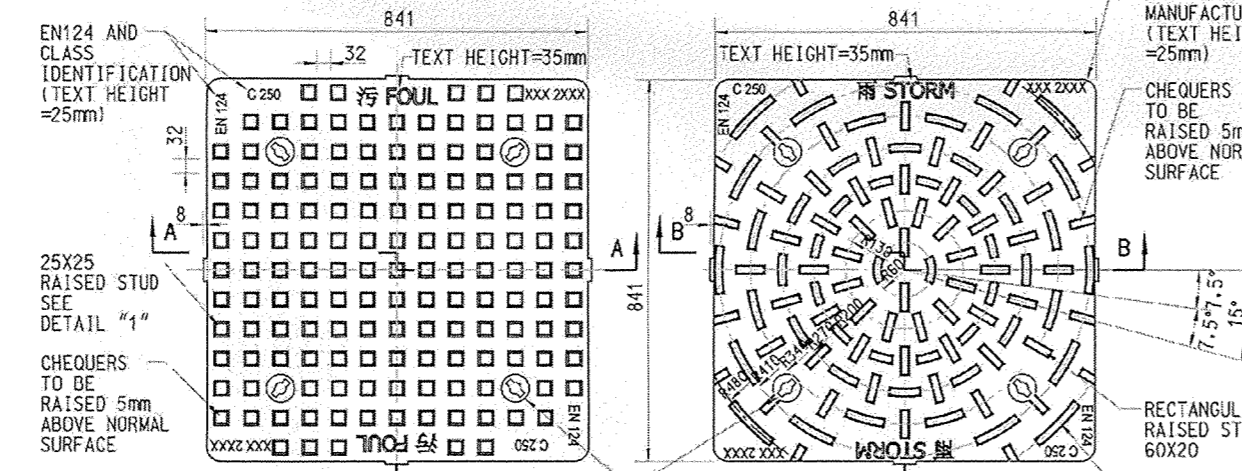


PLAN OF SEWER MANHOLE COVER (CLASS C250)

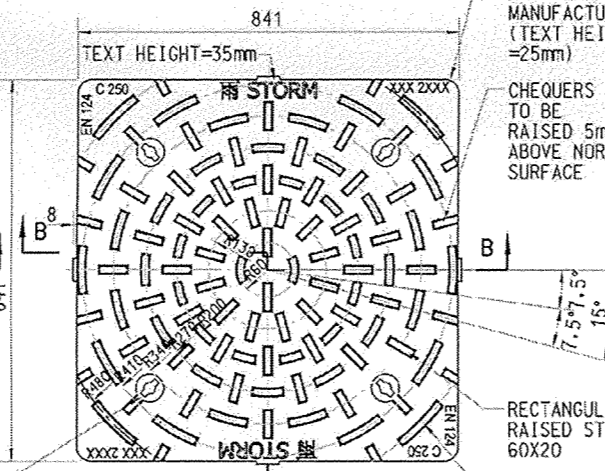


PLAN OF STORMWATER MANHOLE COVER (CLASS C250)

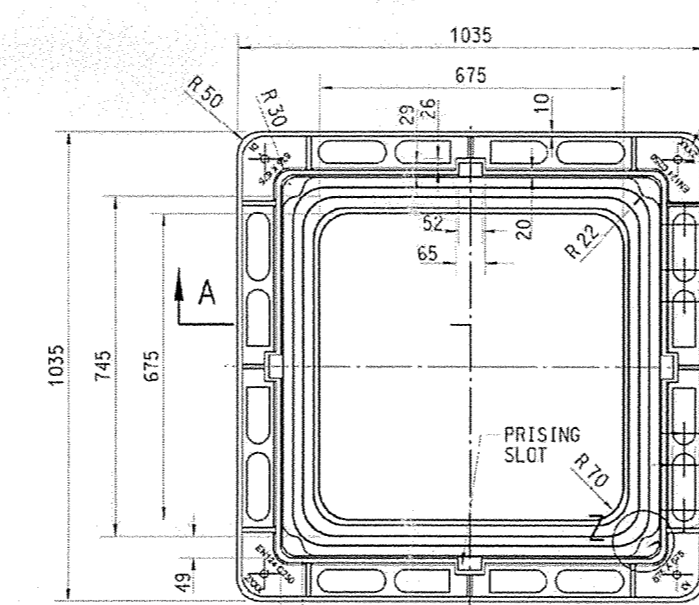

PLAN OF FRAME FOR 675X675 TERMINAL SEWER AND STORMWATER MANHOLE COVER (CLASS C250)

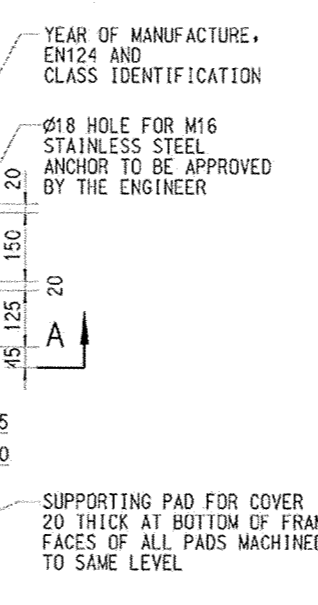


SECTION A - A

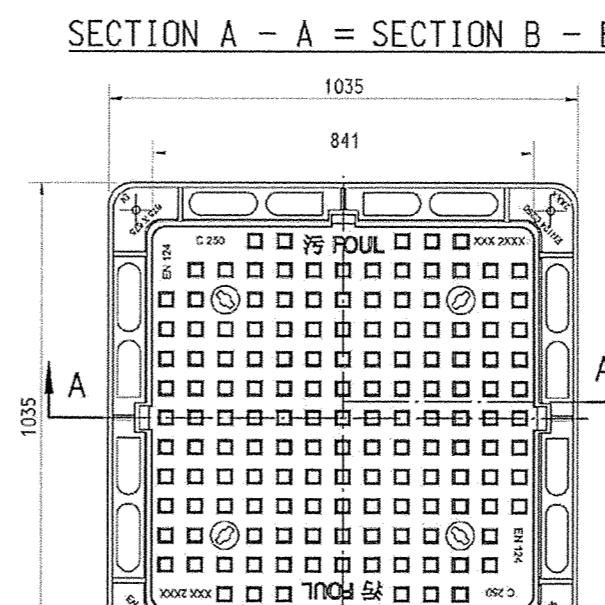


SECTION A - A = SECTION B - B




TOP

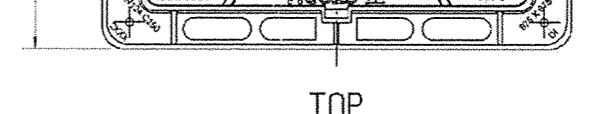


TOP

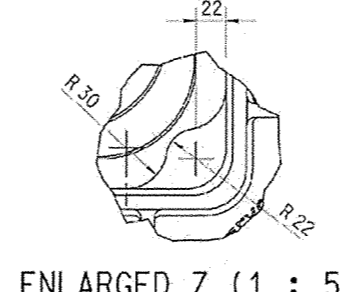


ENLARGED Z (1:5)

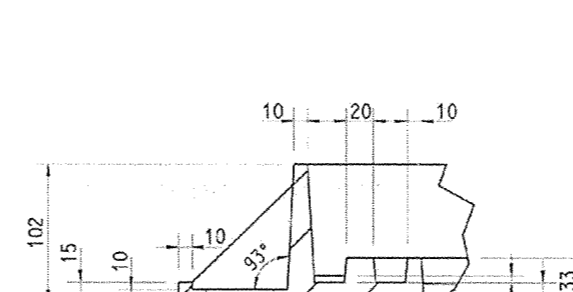


ENLARGED X (1:5)

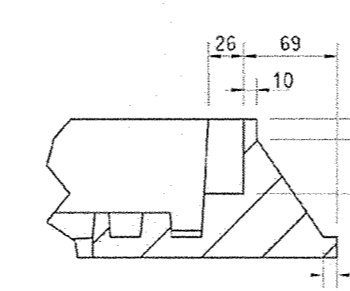

ENLARGED Y (1:5)

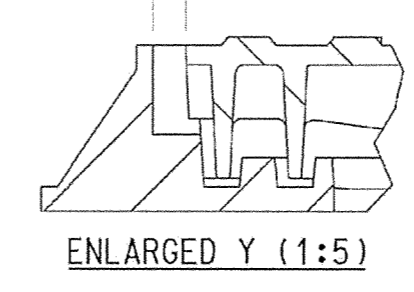


ENLARGED Y (1:5)

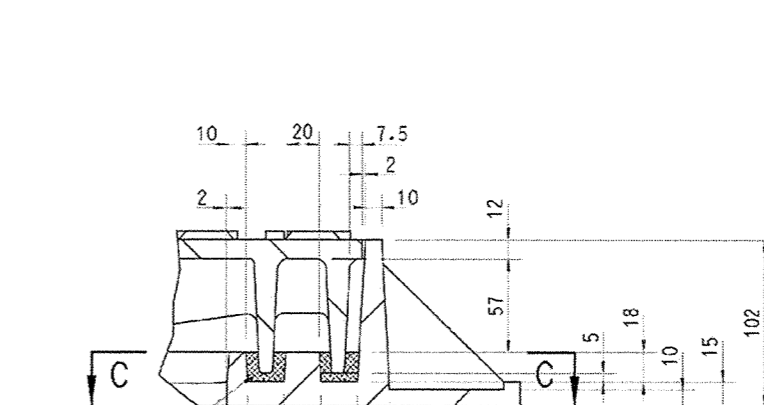

ENLARGED X (1:5)

- NOTES:
 1. FOR GENERAL NOTES OF DUCTILE IRON MANHOLE COVER & FRAME, REFER TO DRG. NO. DS1076 (2 SHEETS)
 2. FILLETS FOR BOTTOM ENDS OF THE COVER EDGES AND RIBS ARE R1. OTHER UNSPECIFIED FILLETS ARE R2

Ø20 ANCHOR HOLES IN COVER (SEE DETAIL "2") LOOSELY COUPLED BY GRADE 8.8 M16 BOLTS WITH WASHERS / NUTS AND ANCHORED TO THE MANHOLE WALL VIA GRADE 80 CHAIN (REFER TO DRG. NO. DS1086 (2 SHEETS)) FOR FULL SET OF ANCHOR AND CHAIN ARRANGEMENT)

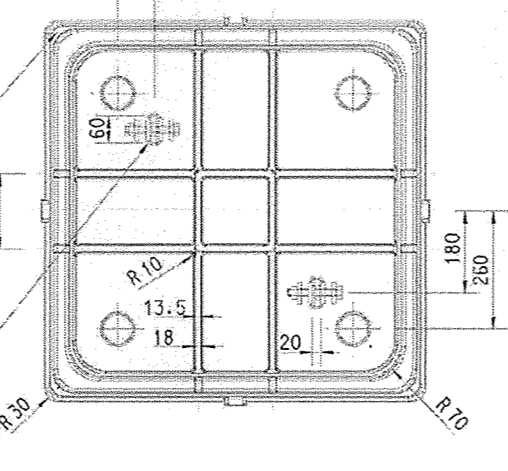

BOTTOM VIEW

- NOTES:
 1. FOR GENERAL NOTES OF DUCTILE IRON MANHOLE COVER & FRAME, REFER TO DRG. NO. DS1076 (2 SHEETS)
 2. FILLETS FOR BOTTOM ENDS OF THE COVER EDGES AND RIBS ARE R1. OTHER UNSPECIFIED FILLETS ARE R2


- NOTES:
 1. FOR GENERAL NOTES OF DUCTILE IRON MANHOLE COVER & FRAME, REFER TO DRG. NO. DS1076 (2 SHEETS)
 2. FILLETS FOR BOTTOM ENDS OF THE COVER EDGES AND RIBS ARE R1. OTHER UNSPECIFIED FILLETS ARE R2

Plan Approved
 LAW Pui-sze, Anny
 Senior Building Surveyor
 for BUILDING AUTHORITY
 - 2 MAR 2017

Michael Chiang
 Michael Chiang, Michael
 (S.A.S.), B. Arch., F.R.C.A., R.I.B.A.
 Authorised Person, Architect

REV.	DATE	DESCRIPTION
PROJECT RESIDENTIAL DEVELOPMENT KAM POK ROAD NEW TERRITORIES		
DRAWING TITLE SITE FORMATION FOR FLOOD MITIGATION - TYPICAL DETAILS FOR STEEL COVER		
JOB NO.	DESIGNED	CATH
DATE	12/2016	DRAWN WIN
SCALE	N.T.S. (A1)	CHECKED TONY
DRG. NO.	SF-F006	STATUS SUBMISSION
ARCHITECT mcaal michael chiang and associates architects		
ENGINEER STEPHEN CHENG CONSULTING ENGINEERS LTD.		

RECORD PLAN

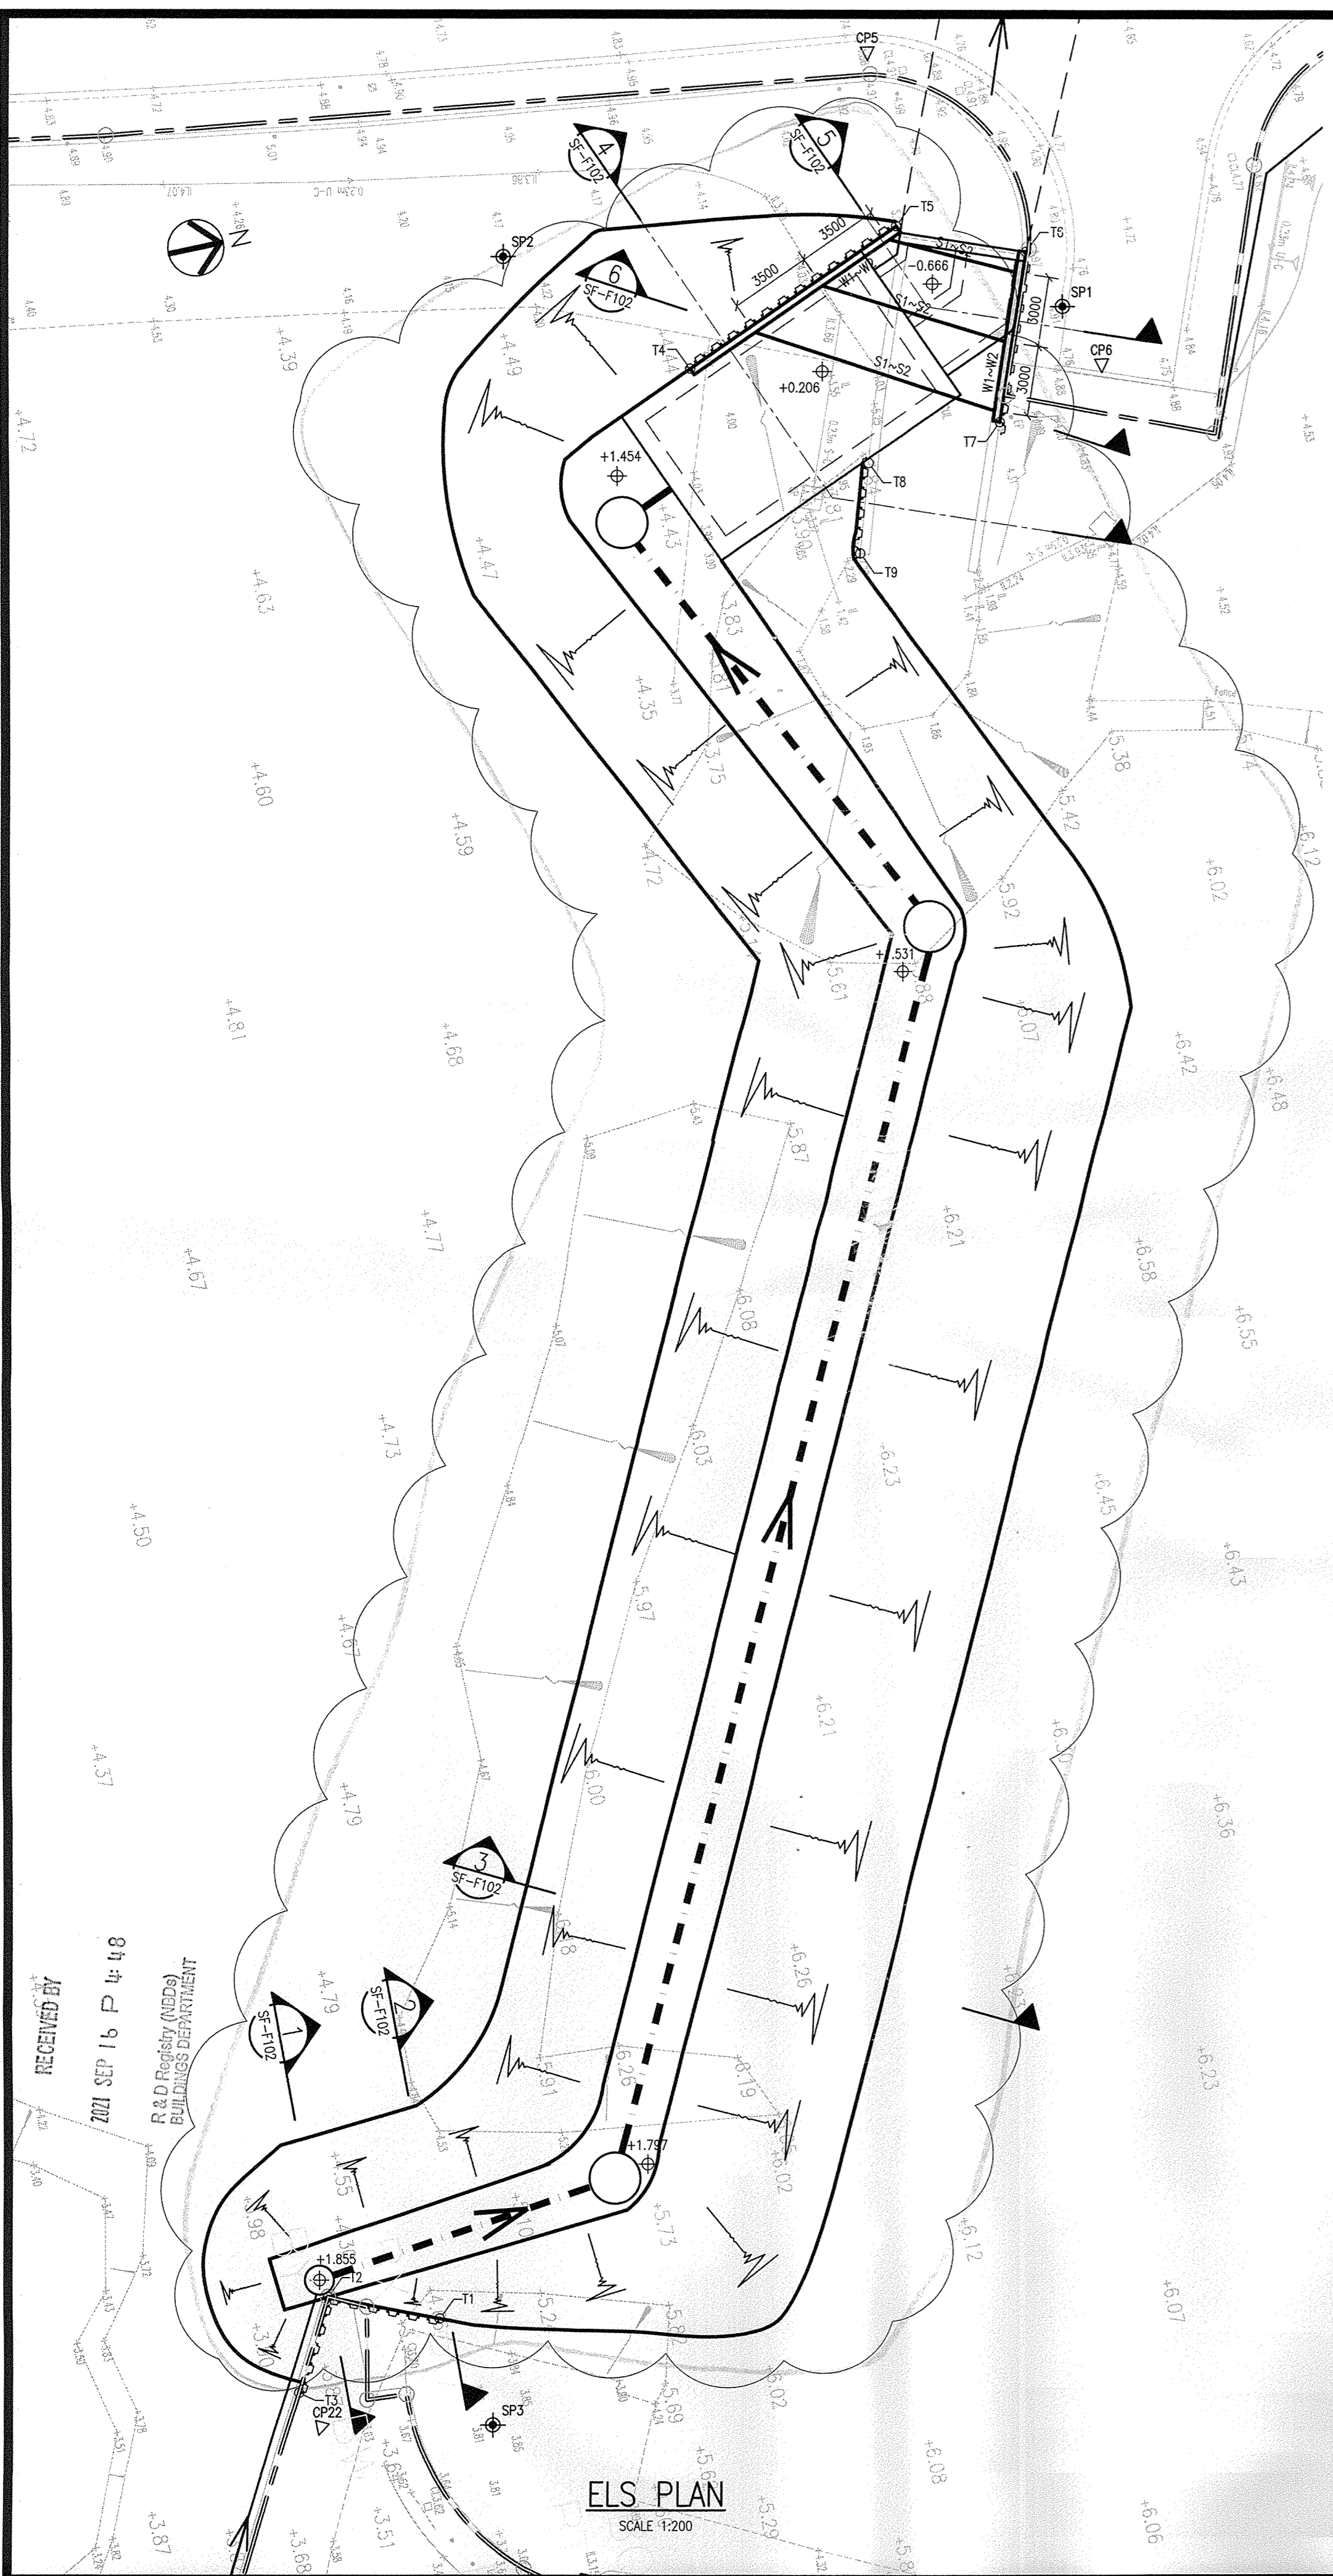

- LEGEND**
- SITE BOUNDARY
 - PROPOSED CUT SLOPE (30° MAX.)
 - S1 PROPOSED STRUT
 - W1 PROPOSED WALING
 - PROPOSED SHEETPILE
 - ALIGNMENT OF PROPOSED UNDERGROUND DRAINPIPES
 - +1.65 PROPOSED FINAL EXCAVATION LEVEL
 - CP5 PROPOSED SETTLEMENT CHECK POINT ON GROUND (CPS, CP6, CP22)
 - SP1 PROPOSED STANDPIPE (SP1-SP3)
 - T6 PROPOSED TURNING POINT

MEMBER SIZE SCHEDULE

MEMBER	TYPE	MEMBER SIZE	MAX. RETAINING HEIGHT	MIN. EMBEDMENT LENGTH
SHEET PILES FOR SANDTRAP	CASE 1	FSP-II SHEET PILE	6m	7.25m
	CASE 3	FSP-III SHEET PILE	2.445m	5.655m
WALING	W1, W2	305x305x240 kg/m UC		
	S1	203x203x86 kg/m UC		
STRUT	S2	254x254x89 kg/m UC		
SHEET PILES FOR WING WALL (BOX CULVERT)	CASE 2	FSP-III SHEET PILE	2.3m	7.206m


- NOTE**
- NOTES AND DETAILS REFER TO DRG. NO.: SF-F003 & SF-F103.
- OVERALL SEQUENCE OF CONSTRUCTION**
- WITH THE SITE IN EXISTING GROUND CONDITION, CARRY OUT EXCAVATION AND LATERAL SUPPORT WORKS TO FACILITATE THE PROPOSED FLOOD MITIGATION WORKS.
 - CONSTRUCT THE DRAINAGE WORKS ASSOCIATED WITH THE FLOOD MITIGATION.
 - BACKFILL THE EXCAVATION WITH PROPERLY COMPACTED SOIL MATERIALS.
 - THE BACKFILLING SHALL BE CARRIED OUT TO REINSTATE THE ORIGINAL GROUND PROFILE.

- NOTES ON SEQUENCE OF ELS WORKS**
- INSTALL THE MONITORING CHECK POINTS AND STANDPIPES AND RECORD THE INITIAL READINGS.
 - INSTALL THE SHEET PILES TO THE REQUIRED DEPTH BY PRESSING WITH A HEAVY EXCAVATOR OR BY MEANS OF A VIBRATOR.
 - CARRY OUT OPEN CUTTING TO THE BASE LEVEL OF THE SUBGRADE/BLINDING LAYER BENEATH THE PROPOSED MANHOLES, CATCH-PITS, AND 1050mm DIAMETER DRAINAGE PIPES.
 - CONCURRENTLY, CARRY OUT EXCAVATION AND LATERAL SUPPORT (ELS) WORKS IN FRONT OF THE SHEET PILE WALLS:
 - EXCAVATE TO 300mm BELOW THE FIRST LAYER OF LATERAL SUPPORT AND THEN INSTALL THE FIRST LAYER OF WALING AND STRUTS.
 - EXCAVATE TO 300mm BELOW THE NEXT LAYER OF LATERAL SUPPORT AND THEN INSTALL THE SECOND LAYER OF WALING AND STRUTS.
 - EXCAVATE TO THE FINAL EXCAVATION LEVEL.
 - UPON BACKFILLING IN EXCAVATION WITH SHORING WORKS, THE FILLING WORKS SHALL BE CARRIED OUT PROGRESSIVELY:
 - BACKFILL TO 300mm BELOW THE SECOND LAYER OF LATERAL SUPPORT AND THEN REMOVE THE SECOND LAYER OF WALING AND STRUTS.
 - BACKFILL TO 300mm BELOW THE FIRST LAYER OF LATERAL SUPPORT AND THEN REMOVE THE FIRST LAYER OF WALING AND STRUTS.
 - BACKFILL TO THE ORIGINAL GROUND LEVEL.


- NOTES FOR TOP SUPERVISION**
- THE TOP TS SITE SUPERVISION PERSONNEL UNDER THE REG'S STREAM SHALL SUBMIT REGULAR REPORT OF HIS/HER/ THEIR FINDING AND RECOMMENDATION TO THE REG. THE REG SHALL FORMALLY SUBMIT THESE REPORTS TO THE BD AND PROVIDE A COPY TO THE GEO AT MONTHLY INTERVALS OR MORE FREQUENTLY AS NECESSARY. THE FIRST REPORT SHALL BE SUBMITTED TO BD WITHIN ONE MONTH AFTER THE COMMENCEMENT OF THE SITE FORMATION/ELS WORKS. THE SUBSEQUENT REPORTS SHALL BE SUBMITTED TO BD WITHIN FOUR WEEKS AFTER THE REPORTING MONTH.
 - PROGRESS OF THE WORKS
 - INTERPRETATION OF INSTRUMENTARY RESULTS TAKEN DURING CONSTRUCTION
 - SITE OBSERVATIONS
 - INSPECTION RECORDS
 - REVIEW
 - TYPICAL CONTENTS OF THE REGULAR REPORTS PREPARED BY THE TOP TS SITE SUPERVISION PERSONNEL SHOULD INCLUDED THE FOLLOWING:
 - COMPLIANCE WITH APPROVED PLANS

NOTE: CUMULATIVE MONITORING RESULTS WITH THE BAA AND DESIGN LEVELS ONLY IN GRAPHICAL FORM SHOULD BE PROVIDED IN THE APPENDIX.


EACH REPORT SHALL COVER ONE CALENDAR MONTH OF SITE ACTIVITIES AND BE COMPLETED WITHIN TWO WEEKS AFTER EACH REPORTING PERIOD. THE REPORTS SHALL BE KEPT AT THE SITE OFFICE FOR INSPECTION BY THE BD/GEO.

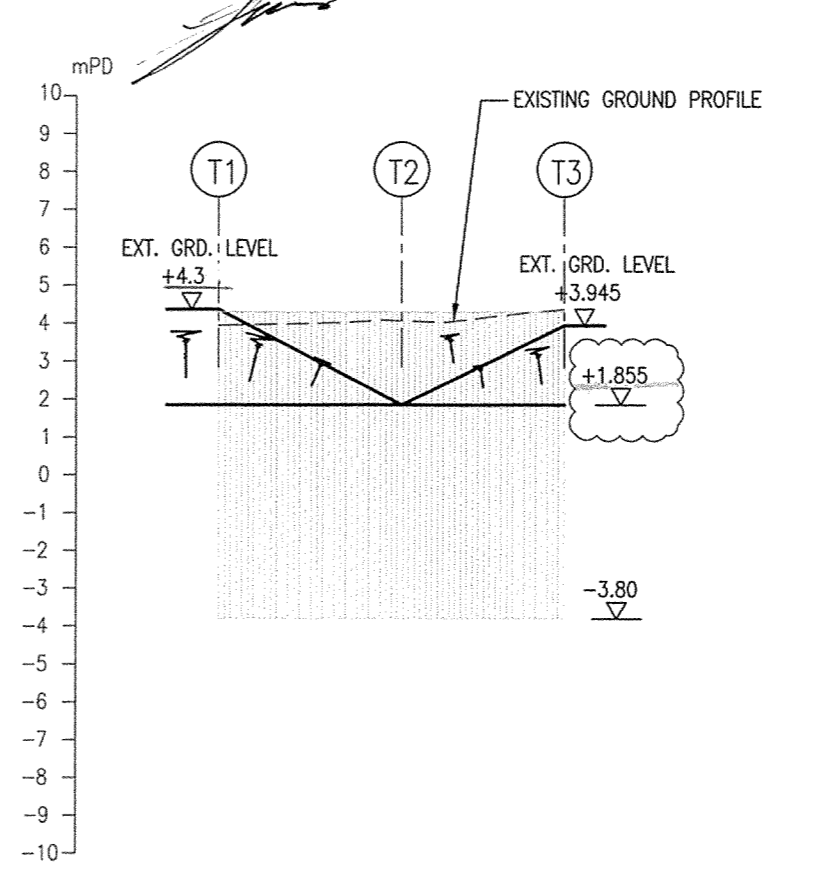


DEVELOPED ELEVATION T1 TO T3
SCALE 1:200 (CASE 3)

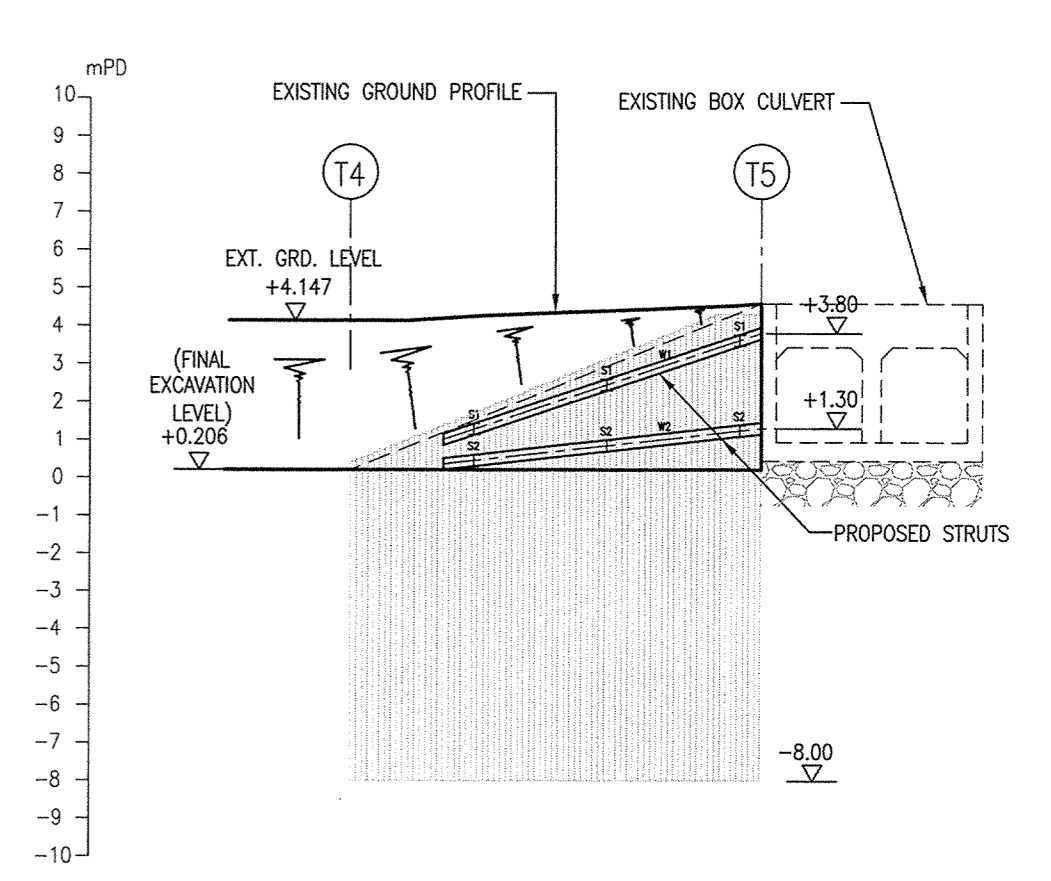

DEVELOPED ELEVATION T4 TO T5
SCALE 1:200 (CASE 1)

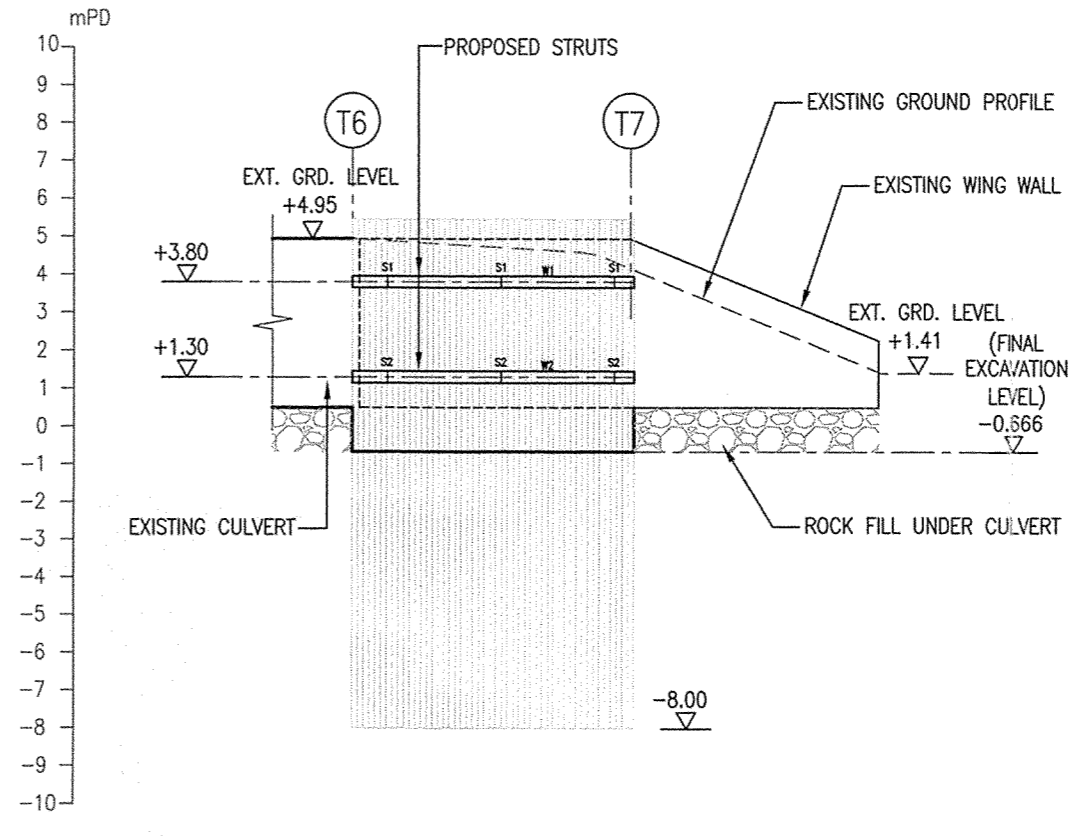

DEVELOPED ELEVATION T6 TO T7
SCALE 1:200 (CASE 1)

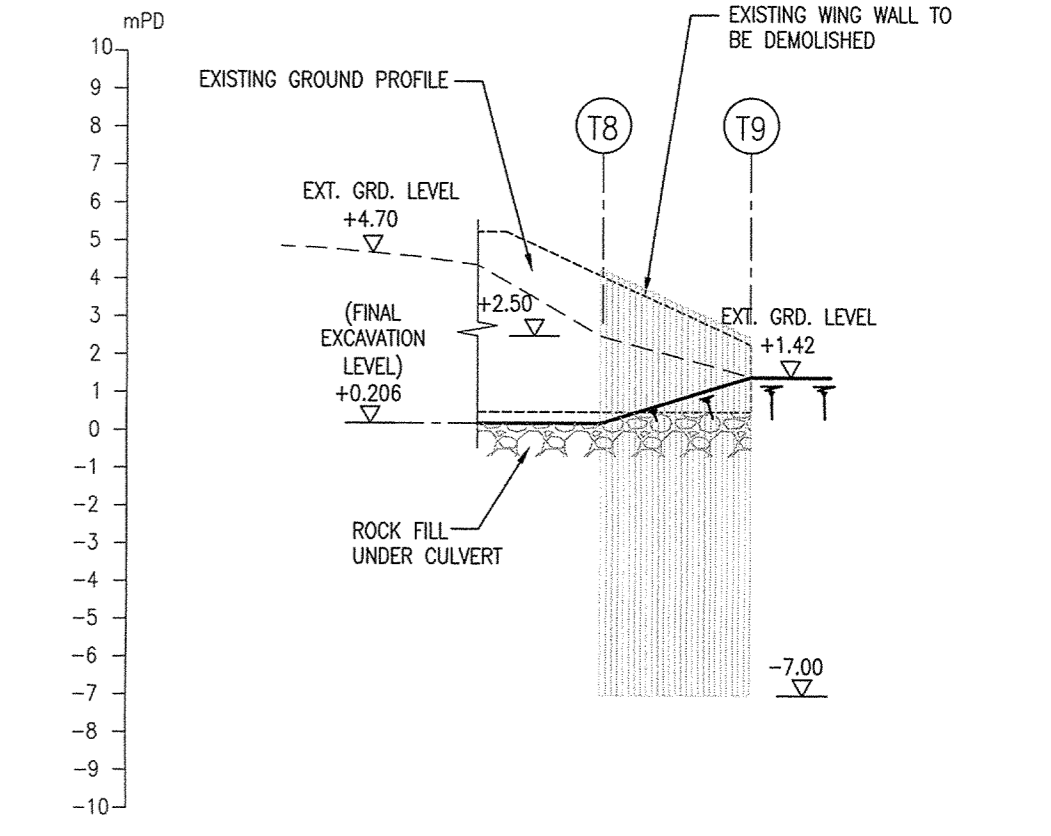

DEVELOPED ELEVATION T8 TO T9
SCALE 1:200 (CASE 2)

Note: This plan has been processed on a curtailed check basis under the centralized processing system as promulgated in PNAP ADM-19. The duties of the authorized person, registered structural engineer and/or registered geotechnical engineer concerned as specified under section 4(3)(b) and the provision of section 14(2)(c) of the Buildings Ordinance are of particular relevance in this regard.

BUILDINGS DEPARTMENT

AMENDED PLAN

Plan Approved
NG Man King
Building Surveyor
for BUILDING AUTHORITY
12 OCT 2021

Ching Hong Man, Michael
B. (A.S.) B. Arch. H.K.I.A. R.I.B.A.
Authorised Person, Architect

RECORD PLAN

AMENDMENT

REV.	DATE	DESCRIPTION
B	09/2021	GENERAL REVISION
A	07/2020	GENERAL REVISION
-	-	BD APPROVED ON 02 MAR 2017

PROJECT
RESIDENTIAL DEVELOPMENT
KAM POK ROAD NEW TERRITORIES

DRAWING TITLE
SITE FORMATION FOR FLOOD MITIGATION - PART PLAN FOR ELS

JOB NO.	DESIGNED	CATH
DATE	12/2016	DRAWN WIN
SCALE	1:200 (A1)	CHECKED TONY
DRG. NO.	SF-F101	STATUS SUBMISSION




ARCHITECT
mcaal
michael chiang and associates architects
Michael Chiang 蔣兆基 建築師事務所

ENGINEER
STEPHEN CHENG
CONSULTING ENGINEERS LTD.
Chan Chu Fai Edmond
Registered Structural Engineer

RECEIVED BY
2021 SEP 16 P 4: 18
R & O Registry (ND/De)
BUILDINGS DEPARTMENT




ELS PLAN
SCALE 1:200

CAD FILE : D:\Low\Project\Yam Pok Road\Flood Mitigation Overlay with 20210817 Site Boundary\20210910 Amendment\CAD_20210913\SF-F101B-F102B DR ELS PLAN & SECS & DETAILS.dwg

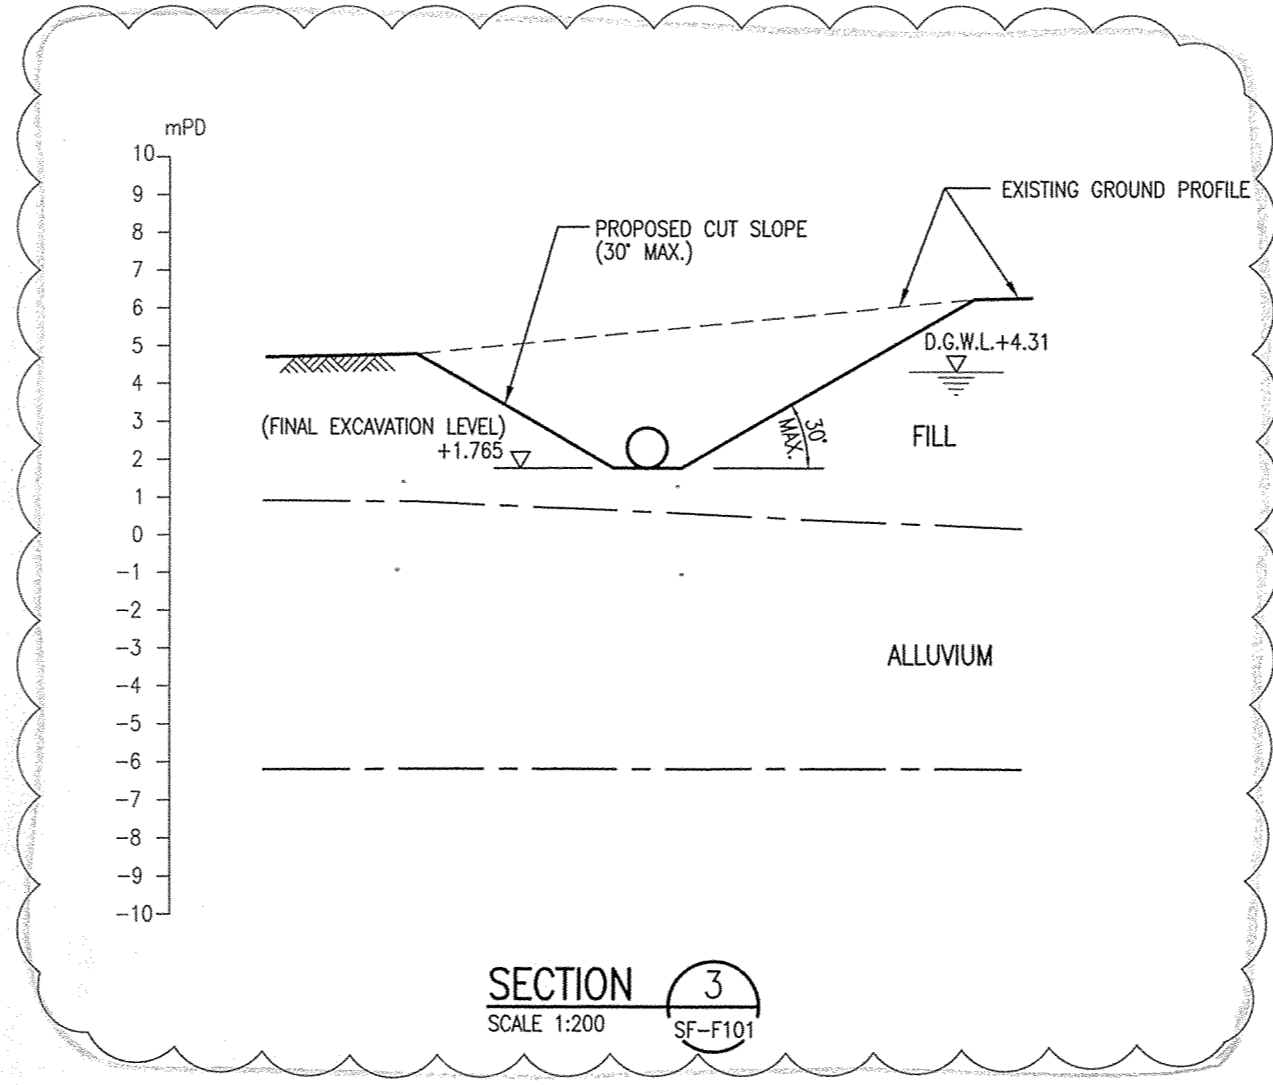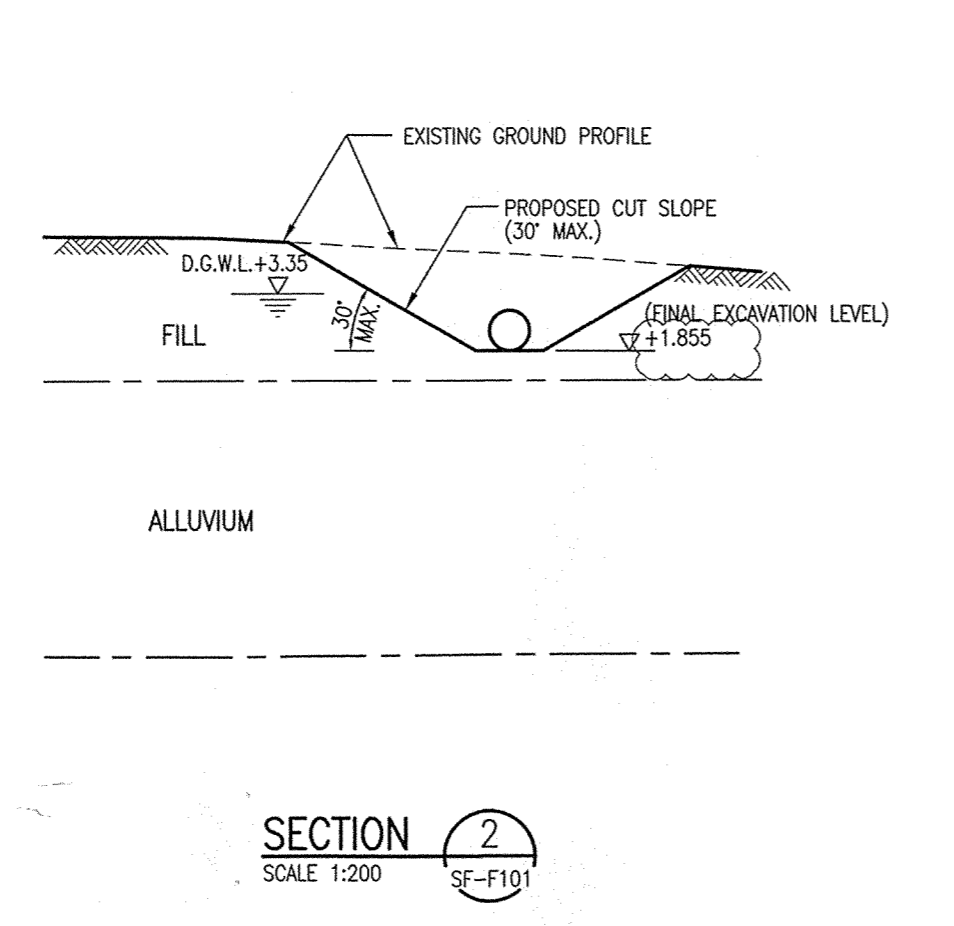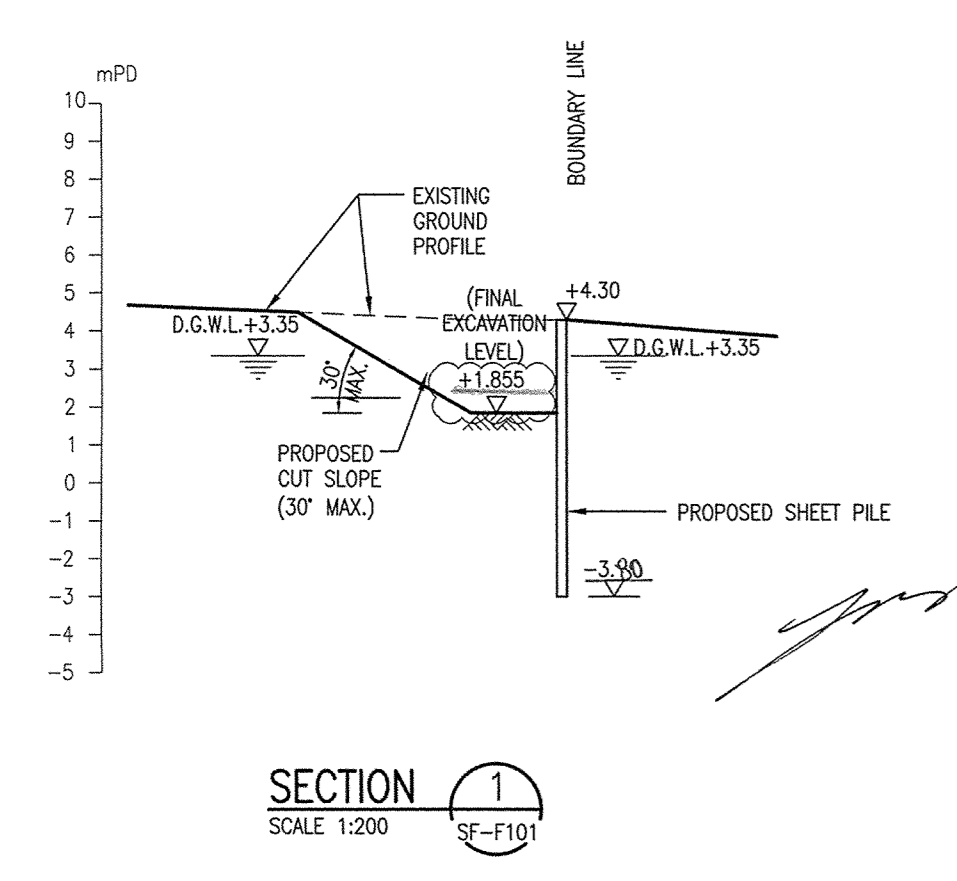

NOTE
1. NOTES AND DETAILS REFER TO DRG. NO.: SF-F003 & SF-F103.

LEGEND
D.G.W.L. - DESIGN GROUND WATER LEVEL

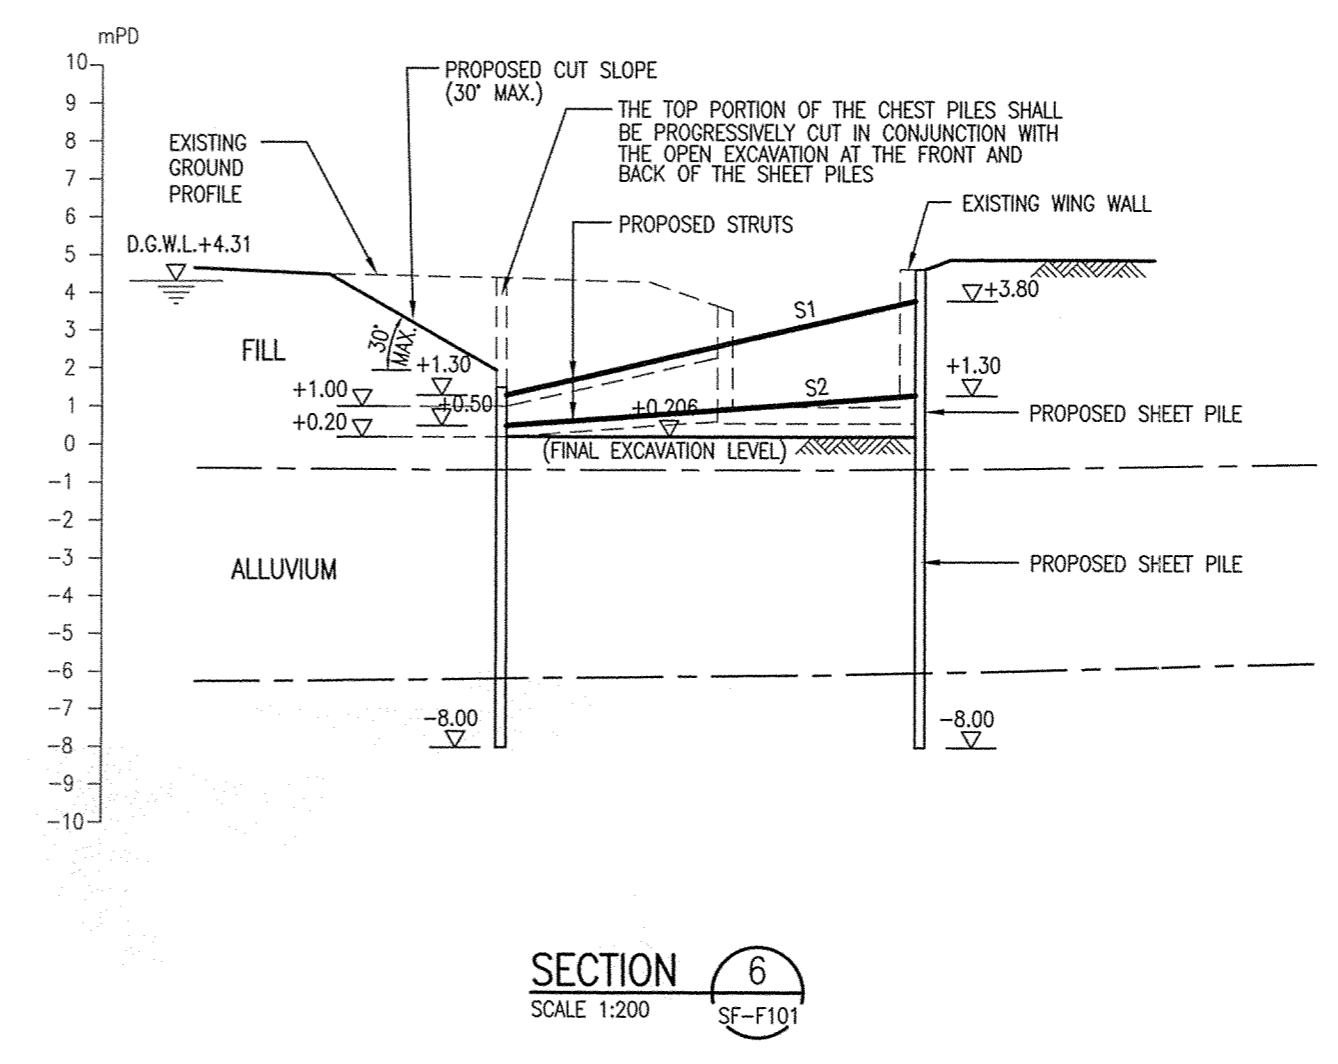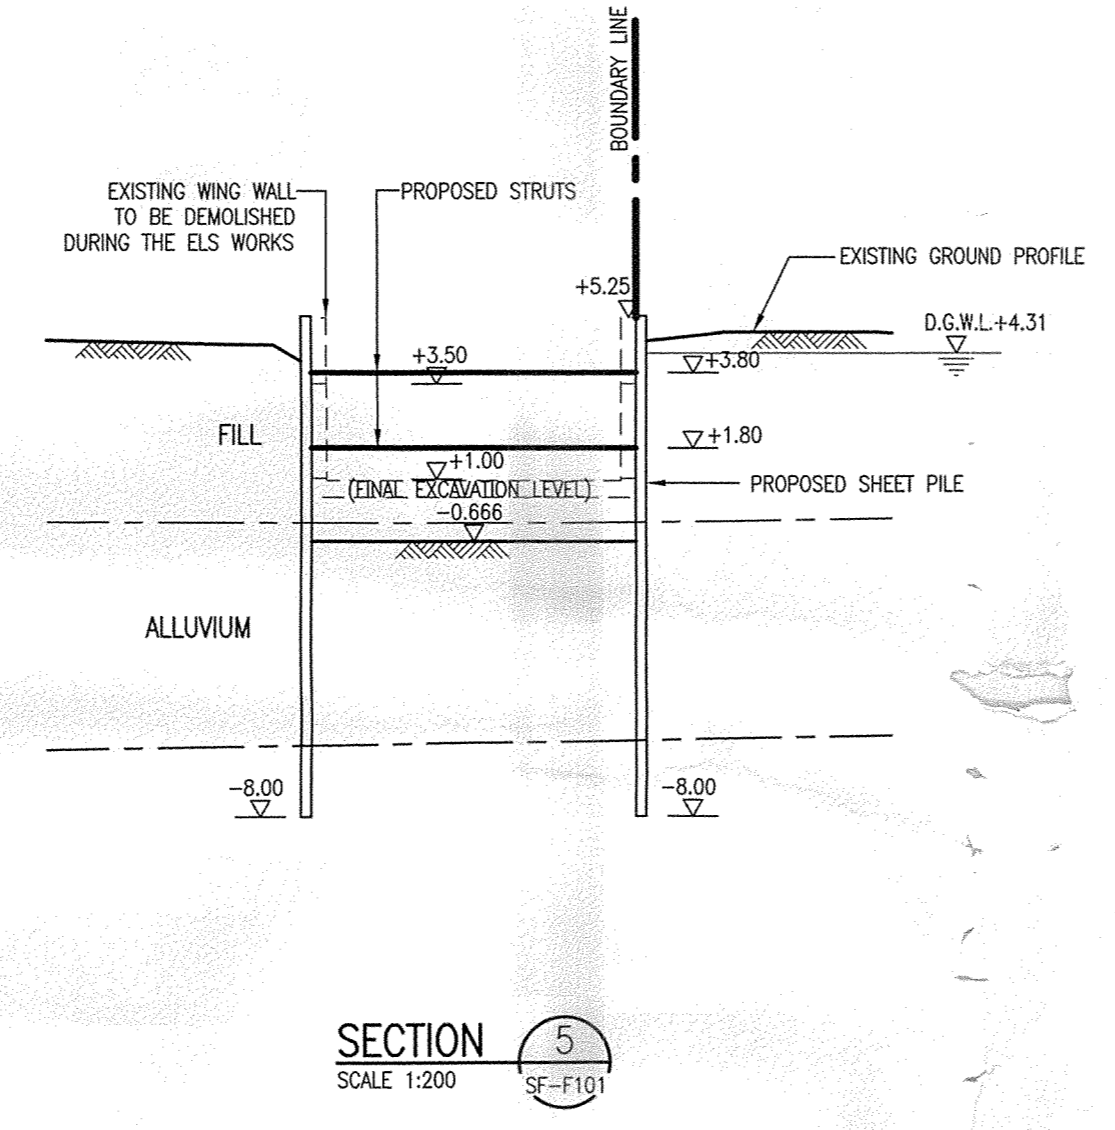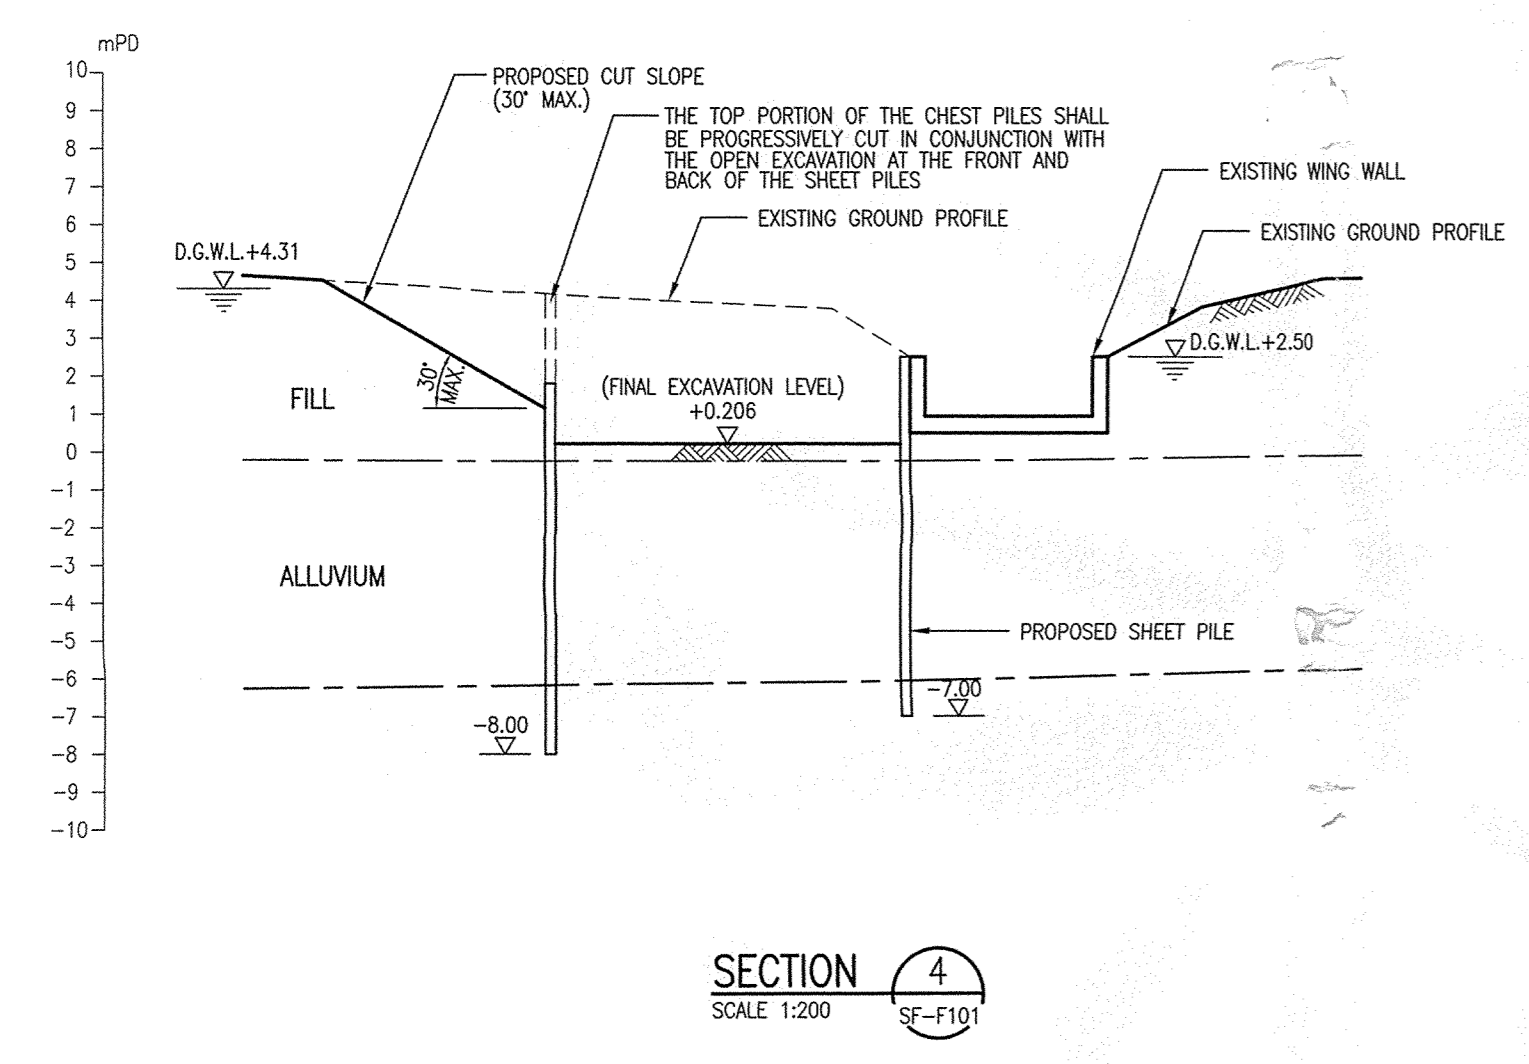

Note: This plan has been processed on a curtailed check basis under the centralized processing system as promulgated in PNAP ADM-19. The duties of the authorized person, registered structural engineer and/or registered geotechnical engineer concerned as specified under section 4(2)(b) and the provision of section 14(2)(c) of the Buildings Ordinance are of particular relevance in this regard.

BUILDINGS DEPARTMENT

AMENDED PLAN

Plan Approved

 NG Man Kit
 Building Surveyor
 for BUILDING AUTHORITY
 12 OCT 2021

Michael Chiang
 S. J. B. Arch. H.K.I.A. R.I.B.A.
 Authorized Person, Architect

RECEIVED BY
 2021 SEP 16 P 4: 48
 R.A.D. Roadby (N/SDA)
 BUILDINGS DEPARTMENT

REV.	DATE	DESCRIPTION
B	09/2021	GENERAL REVISION
A	07/2020	GENERAL REVISION
-	-	BD APPROVED ON 02 MAR 2017

PROJECT
 RESIDENTIAL DEVELOPMENT
 KAM POK ROAD NEW TERRITORIES

DRAWING TITLE
 SITE FORMATION FOR FLOOD MITIGATION -
 SECTIONS FOR ELS

JOB NO.	DESIGNED	CATH
DATE	12/2016	DRAWN WIN
SCALE	1:200 (A1)	CHECKED TONY
DRG. NO.	SF-F102	STATUS
		SUBMISSION

ARCHITECT
mcaal
 michael chiang and associates architects
 穆爾文藝建築師事務所


ENGINEER
STEPHEN CHENG
 CONSULTING ENGINEERS LTD.
 Chan Chu Fai Edmond
 Registered Structural Engineer

RECORD PLAN

AMENDMENT

GENERAL NOTES

- ALL DIMENSIONS ARE IN mm AND LEVELS IN mPD.
- THE DESIGN IS TO BE IN ACCORDANCE WITH BUILDING (CONSTRUCTION) REGULATIONS THE CODE OF PRACTICE FOR STRUCTURAL USE OF STEEL 2011, GEOGUIDE 1993 AND GCD PUBLICATION NO. 1/90.
- ALL STRUCTURAL STEEL MEMBERS SHALL COMPLY WITH BS EN 10025 2004, GRADE S275 JO. ALL SHEET PILES SHALL COMPLY WITH BS EN 10248-1:1996.
- ALL WELDS SHALL BE FILLET WELD ALL ROUND COMPLYING WITH BS EN 1011-PART II.
- ALL SHEET PILE AND LATERAL SUPPORT MEMBERS SHALL BE REFERRED TO "MEMBER SIZE SCHEDULE".
- SIZE OF WELDING AT THE CONNECTIONS BETWEEN STRUCTURAL MEMBERS SHALL BE 6mm FILLET WELD ALL ROUND UNLESS OTHERWISE STATED.
- DESIGN GROUND WATER LEVEL TO BE 1m ABOVE OBSERVED WATER LEVEL.
- DESIGN SURCHARGE LOAD = 20kPa FOR CARRIAGE WAY 10kPa FOR CONSTRUCTION LOAD AT REAR SIDE OF THE SITE
- ALL STEEL STRUCTURAL MEMBER SHALL BE 6mm GRADE S275 JO EXCEPTED GRADE S355 FOR WALINGS AND STRUTS UNLESS OTHERWISE SPECIFIED.
- CHANNEL BRACKETS FOR SUPPORTING WALING SHALL BE PROVIDED AT MAX. 3000c/c OR NOT LESS THAN 2 NOS. FOR EACH WALING.
- ALL WORKS SHALL BE CARRIED OUT IN ACCORDANCE WITH THE APPROVED PLANS. IF THERE ARE ANY VARIATIONS OF WORKS WHICH ARE INCONSISTENT WITH THE APPROVED PLANS, THE SUPERVISORS SHALL NOTIFY THE AP/RSE/RGE/RSC/RBGC OF SUCH VARIATIONS IMMEDIATELY. THE AP/RSE/RGE/RSC/RBGC SHALL REVIEW THE SITUATION AND TAKE APPROPRIATE ACTIONS SO AS TO COMPLY WITH THE BUILDING ORDINANCE.
- TOP T3 UNDER THE RICE STREAM SHOULD BE FULL TIME ON SITE DURING THE REMOVAL OF STRUTS.

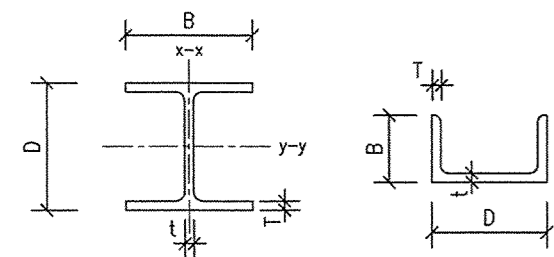

SECTION PROPERTIES FOR WALING / STRUT

SIZE	D (mm)	B (mm)	T (mm)	t (mm)	AREA (cm ²)
203x203x86 kg/m UC	222.3	208.8	20.5	13	110
305x305x240 kg/m UC	352.6	317.9	37.7	23	306
254x254x89 kg/m UC	260.4	255.9	17.3	10.5	114

NOTES ON SHEET PILING CHANNEL PLACEMENT

- ALL STEEL SHEET PILES SHOULD BE DRIVEN TO THE REQUIRED LEVEL AS SHOWN ON SECTION 1-1, 4-4, 5-5 & 6-6.
- UPON COMPLETION INSTALLATION OF SHEET PILE WALLS, A RECORD PLAN FOR SHEET PILING WALL SHALL BE SUBMITTED TO THE BUILDING AUTHORITY.

REDUCTION FACTOR FOR STEEL SHEET PILES (CATEGORY 1)

TYPE	FACTOR
β_B	0.9
β_D	0.8

STEEL MEMBER	DIMENSION	AREA	WEIGHT	I per pile	Z per pile	I	Z
	w h t	cm ²	kg/m	cm ⁴	cm ³	cm ⁴ /m	cm ³ /m
FSP-II SHEET PILE	400 100 10.5	61.18	120	1240	152	8740	874
FSP-III SHEET PILE	400 125 13	76.42	150	2220	223	16800	1340

SOIL DESIGN PARAMETERS


SOIL TYPE	c'(kPa)	ϕ' (°)	YOUNG'S MODULUS (kN/m ²)
FILL	0	33	4000
ALLUVIUM	2	34	8000

NOTES OF MONITORING

- INSTALL SETTLEMENT CHECK POINTS AS SHOWN ON PLAN BEFORE THE COMMENCEMENT OF ELS WORKS.
- THE INITIAL READINGS SHOULD BE SUBMITTED TO BUILDING AUTHORITY BEFORE WORK COMMENCE.
- THE MONITORING POINTS SHOULD BE MONITORED DAILY, AND THE RECORD SHOULD BE KEPT ON SITE FOR INSPECTION AND SUBMITTED TO THE AP/RSE AND BUILDING AUTHORITY AT TWO WEEKS INTERVAL.
- BEFORE COMMENCING EXCAVATION WORKS, INSTALL STANDPIPES SP1 TO SP3.
- SHOULD ANY UNUSUAL SETTLEMENT BE FOUND, THE WORK SHOULD BE SUSPENDED IMMEDIATELY, THE RSE AND BUILDING AUTHORITY SHOULD BE INFORMED AND REMEDIAL PROPOSAL SHOULD BE SUBMITTED FOR CONSIDERATION & APPROVAL PRIOR TO RESUMING THE ELS WORKS.
- THE PROPOSED ALERT LEVEL, ALARM LEVEL AND ACTION LEVEL FOR MONITORING WORKS ARE:

MONITORING STATION	ALERT LEVEL	ALARM LEVEL	ACTION LEVEL
STANDPIPE	SP1-SP3 R-200mm (2.12 mPD)	R-300mm (2.02 mPD)	R-600mm (1.72 mPD)
SETTLEMENT CHECK POINT ON GROUND	CP6, CP22 12mm	18mm	25mm

- WHENEVER ANY CHECK POINT REACHES ALERT LEVEL, THE FREQUENCY OF SITE SUPERVISION BY RSE(T5) AND RSC(T4) STREAMS SHOULD BE INCREASED TO NOT LESS THAN TWICE A WEEK.
 - WHENEVER ANY CHECK POINT REACHES ALARM LEVEL, THE FREQUENCY OF SITE SUPERVISION BY RSE(T5) AND RSC(T4) STREAMS SHOULD BE INCREASED TO NOT LESS THAN 3 TIMES A WEEK.
 - WHENEVER ANY CHECK POINT REACHED ACTION LEVEL, ALL WORKS SHALL BE CEASE IMMEDIATELY, AND THE ENGINEER, BD SHALL BE INFORMED. NO WORKS SHALL BE RE-STARTED UNTIL A REMEDIAL PROPOSAL HAS BEEN SUBMITTED, APPROVED BY BD AND IMPLEMENTED.
- * R DENOTES REFERENCE LEVEL WHICH IS THE LOWEST GROUND WATER PRIOR TO THE COMMENCEMENT OF EXCAVATION WORKS, BUT THE ALERT/ALARM/ACTION LEVELS ARE TENTATIVELY TAKEN TO BE THE FIGURES SHOWN WITHIN BRACKETS IN THE TABLE ABOVE BASED ON PREVIOUS GROUND INVESTIGATION RESULT. THE ALERT/ALARM/ACTION LEVELS SHALL BE REVISED BASED ON THE REFERENCE LEVEL, R, ESTABLISHED ON SITE.

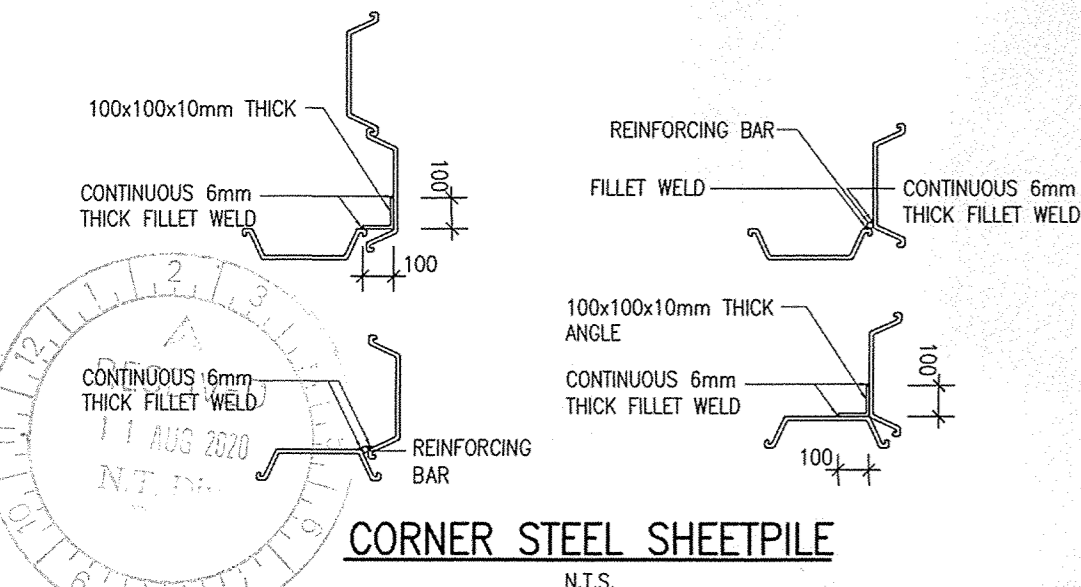

GENERAL NOTE FOR ELS WORKS

ALL WORKS SHALL BE CARRIED OUT IN ACCORDANCE WITH THE APPROVED PLANS. IF THERE ARE ANY VARIATIONS OF WORKS WHICH ARE INCONSISTENT WITH THE APPROVED PLANS, THE SUPERVISORS SHALL NOTIFY THE AP/RSE/RGE/RSC/RBGC OF SUCH VARIATIONS IMMEDIATELY. THE AP/RSE/RGE/RSC/RBGC SHALL REVIEW THE SITUATION AND TAKE APPROPRIATE ACTIONS SO AS TO COMPLY WITH THE BUILDINGS ORDINANCE.

ALERT LEVEL

- RESPONSE ACTION:
 - RC TO NOTIFY AND SUBMIT WRITTEN REPORT TO RSE/RGE.
 - RSE/RGE TO ASSESS EFFECT OF MOVEMENTS AND PREDICT FUTURE MOVEMENTS.
 - RSE/RGE TO AGREE WITH RC ON THE SUITABLE ACTION PLAN WHICH MAY INCLUDE THE INSTALLATION OF ADDITIONAL CHECK POINTS AND/OR INCREASING MONITORING FREQUENCY, AND THE REMEDIAL/MITIGATING MEASURES TO BE TAKEN UPON REACHING THE "ALARM LEVEL".

ALARM LEVEL

- RESPONSE ACTION:
 - RC TO NOTIFY AND SUBMIT UPDATED REPORT TO RSE/RGE AND NOTIFY THE BD IMMEDIATELY.
 - RSE/RGE AND RSC/RBGC TO CONDUCT JOINT SITE INSPECTION TO DETERMINE IF ANY CONSTRUCTION ACTIVITIES SHOULD BE TEMPORARILY SUSPENDED.
 - RSC/RBGC TO IMPLEMENT THE NECESSARY REMEDIAL/MITIGATING MEASURES IN ACCORDANCE WITH THE AGREED ACTION PLAN.
 - RSE/RGE AND RSC/RBGC TO DISCUSS THE INSTRUMENT RESPONSE AND REVIEW THE EFFECTIVENESS OF THE RESPONSE ACTION.
 - RSE/RGE TO AGREE WITH RC ON THE EMERGENCY PLAN DETAILING THE MEASURES TO BE TAKEN UPON REACHING "ACTION LEVEL".
 - ANY CONSTRUCTION ACTIVITIES MAY BE SUSPENDED IF THE RESPONSE ACTION HAS BEEN IMPLEMENTED AND ON THE ADVICE OF THE RSE/RGE AS NECESSARY.
 - RSE/RGE TO REVIEW THE METHOD STATEMENTS OF WORKS TO DETERMINE WHETHER MODIFICATION TO THE CONSTRUCTION METHODS IS REQUIRED TO PREVENT ACTION LEVEL FROM BEING REACHED.

ACTION LEVEL


- RESPONSE ACTION:
 - ALL WORKS ARE TO BE CEASED.
 - RSC/RBGC TO NOTIFY AND CARRY OUT A JOINT SITE INSPECTION WITH THE RSE/RGE IMMEDIATELY. THE BD AND THE RELEVANT PARTIES SHOULD BE NOTIFIED IMMEDIATELY.
 - RSC/RBGC TO IMPLEMENT THE NECESSARY EMERGENCY MEASURES IN ACCORDANCE WITH THE AGREED EMERGENCY PLAN.
 - RSC/RBGC TO SUBMIT AN INCIDENT REPORT TO RSE/RGE AND THE BD DETAILING THE FULL HISTORY OF THE MOVEMENTS AND REMEDIAL/EMERGENCY MEASURES IMPLEMENTED.
 - RSE/RGE TO REVIEW THE INCIDENT AND AGREE WITH RSC/RBGC ON FURTHER REMEDIAL AND PREVENTIVE MEASURES TO ENABLE RESUMPTION OF THE SUSPENDED WORKS.
 - CONSTRUCTION ACTIVITIES SHOULD NOT BE RESUMED UNTIL THE NECESSARY REMEDIAL AND PREVENTIVE MEASURES HAVE BEEN COMPLETED TO THE SATISFACTION OF THE BD.
 - IF THE TRIGGER VALUES AND RESPONSE ACTION ARE REVISED, THE AMENDED PLANS SHOULD BE SUBMITTED TO THE BD FOR APPROVAL. THE SUSPENDED CONSTRUCTION ACTIVITIES SHOULD NOT BE RESUMED UNTIL THE AMENDED PLANS ARE APPROVED BY THE BA AND THE CONSENT IS GIVEN.

REMARKS


- THE "ACTION LEVEL" RESPONSE ACTION SHOULD BE TAKEN IF ANY OF THE FOLLOWING SITUATION OCCURS.
- UNUSUAL SETTLEMENT AS INDICATED IN ANY CHECK POINTS (e.g. AN INCREASE OF 5mm BETWEEN TWO CONSECUTIVE DAILY READINGS.)
- SIGN OF DISTRESS OR DAMAGES OBSERVED IN ANY ADJACENT STRUCTURES AND/OR UTILITIES.

THE PROTECTION OF EARTHWORKS AGAINST HEAVY RAINFALL


- SURFACE WATER FLOWING INTO THE SITE SHALL BE INTERCEPTED AND CONDUCTED FROM THE SITE TO AN INDICATED SAFE DISCHARGE POINT.
- EARTHWORK TO FORM THE FINAL FACE SHALL BE PROTECTED WITH SHEETING WELL-SECURED AGAINST THE WIND. PROVIDE 50mm CHAINM PLASTER / HARD SURFACING FOR EXPOSED MORE THAN 2 WEEKS.
- SILT AND DEBRIS SHALL BE INTERCEPTED BY TRAPS OR DESLTING TANKS BEFORE THE WATER IS DISCHARGED FROM THE SITE.

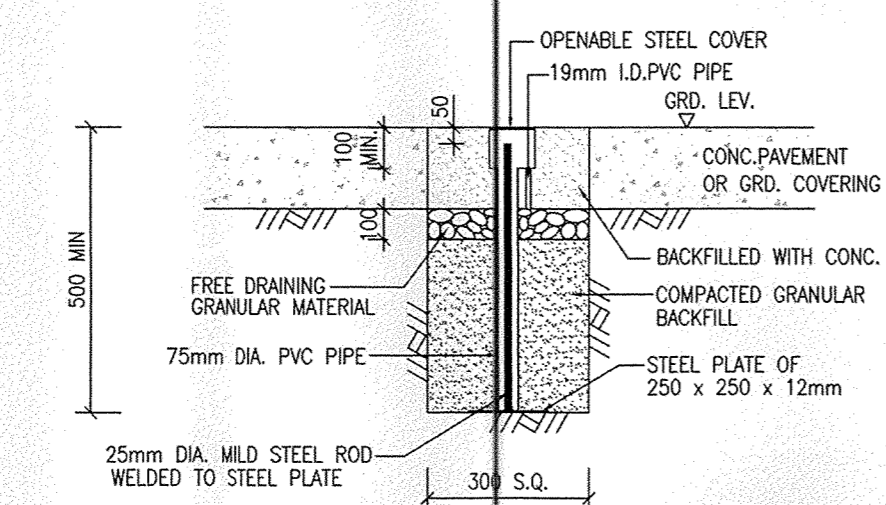

DETAILS OF SETTLEMENT CHECK POINTS ON GROUND

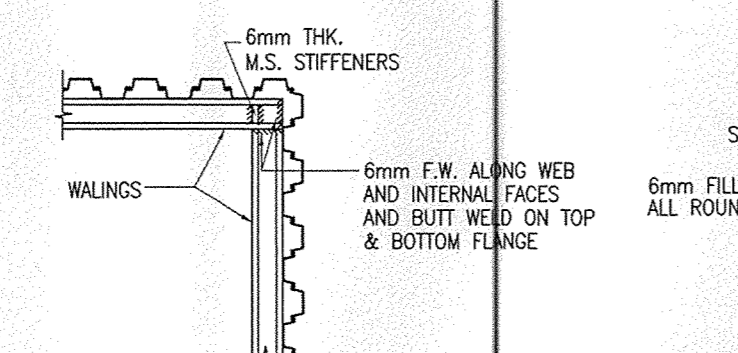

TYPICAL CONNECTION DETAIL BETWEEN WALING

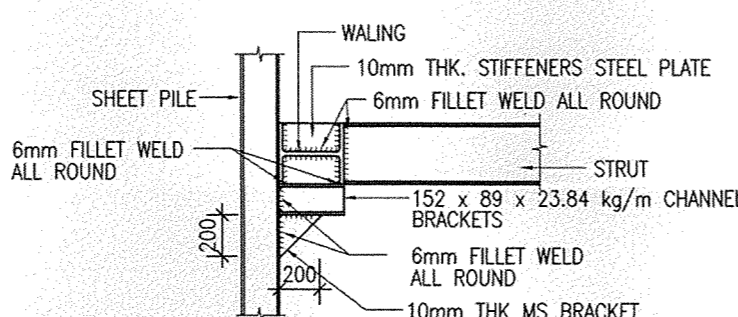

TYPICAL CONNECTION DETAIL BETWEEN SHEET PILE AND WALING AND STRUT


GENERAL NOTES

- 75mm THICK BLINDING LAYER OF PRESCRIBED MIX GRADE 10P SHALL BE PLACED BENEATH ALL FOOTING.
- ALL REINFORCEMENT SHALL COMPLY WITH CS2:2012. 'Y' INDICATES HIGH TENSILE STEEL, WITH CHARACTERISTIC STRENGTH OF 500MPa.
- THE TENSION ANCHORAGE BOND LENGTH (T.A.L.) FOR DESIGNED MIX OF 45D/20 OF ABOVE SHALL BE AS FOLLOWED:

BAR DIA. (mm)	C45/20
10	330
12	396
16	528
20	660
25	825
32	1056
40	1320

LAP LENGTH

1. ABBREVIATIONS

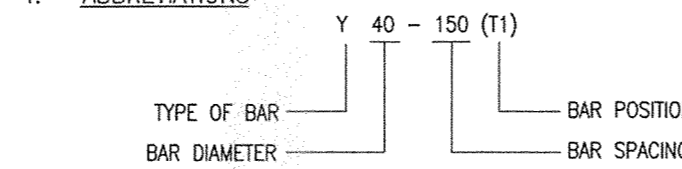

- UNLESS STATED OTHERWISE, THE MINIMUM LAP LENGTHS FOR ALL STEEL REINFORCEMENT BARS SHALL BE THE FULL TENSION LAP LENGTH (T.L.L.) AND INCREASED ACCORDING TO (c) BELOW.
- FULL TENSION LAP LENGTH (T.L.L.) AND FULL COMPRESSION LAP LENGTH (C.L.L.) SHALL BE AS FOLLOWS:

HIGH YIELD BAR DIA. (mm)	CONCRETE GRADE (45D)		
	T.L.L./C.L.L.	T.L.L.x1.4	T.L.L.x2.0
10	330	470	660
12	396	564	792
16	528	752	1056
20	660	940	1320
25	825	1175	1650
32	1056	1504	2112
40	1320	1880	2640


c). ADDITIONAL REQUIREMENT FOR TENSION LAP LENGTH

- WHERE A LAP OCCURS AT THE TOP OF A SECTION AS CAST AND THE MINIMUM COVER IS LESS THAN TWICE THE DIAMETER OF THE LAPPED REINFORCEMENT, THE LAP LENGTH SHOULD BE INCREASED BY A FACTOR OF 1.4.
- WHERE A LAP OCCURS AT A CORNER OF SECTION AND THE MINIMUM COVER TO EITHER FACE IS LESS THAN TWICE THE DIAMETER OF THE LAPPED REINFORCEMENT OR, WHERE THE CLEAR DISTANCE BETWEEN ADJACENT LAPS IS LESS THAN 75mm OR 6 TIMES THE SIZE OF THE LAPPED REINFORCEMENT, WHICHEVER IS THE GREATER, THE LAP LENGTH SHOULD BE INCREASED BY A FACTOR OF 1.4.
- WHERE BOTH CONDITIONS (1.1) & (1.2) APPLY, THE LAP LENGTH SHOULD BE INCREASED BY A FACTOR OF 2.0.



NOTE

- LAP LENGTH FOR BARS OF UNEQUAL SIZE MAY BE BASED ON THE SMALLER BAR.

e.g. TOP BARS AS CAST (NOTES: ϕ = BAR DIA.)

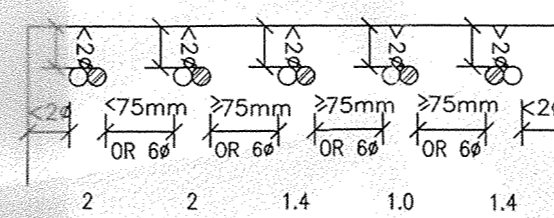


e.g. BOTTOM BARS AS CAST

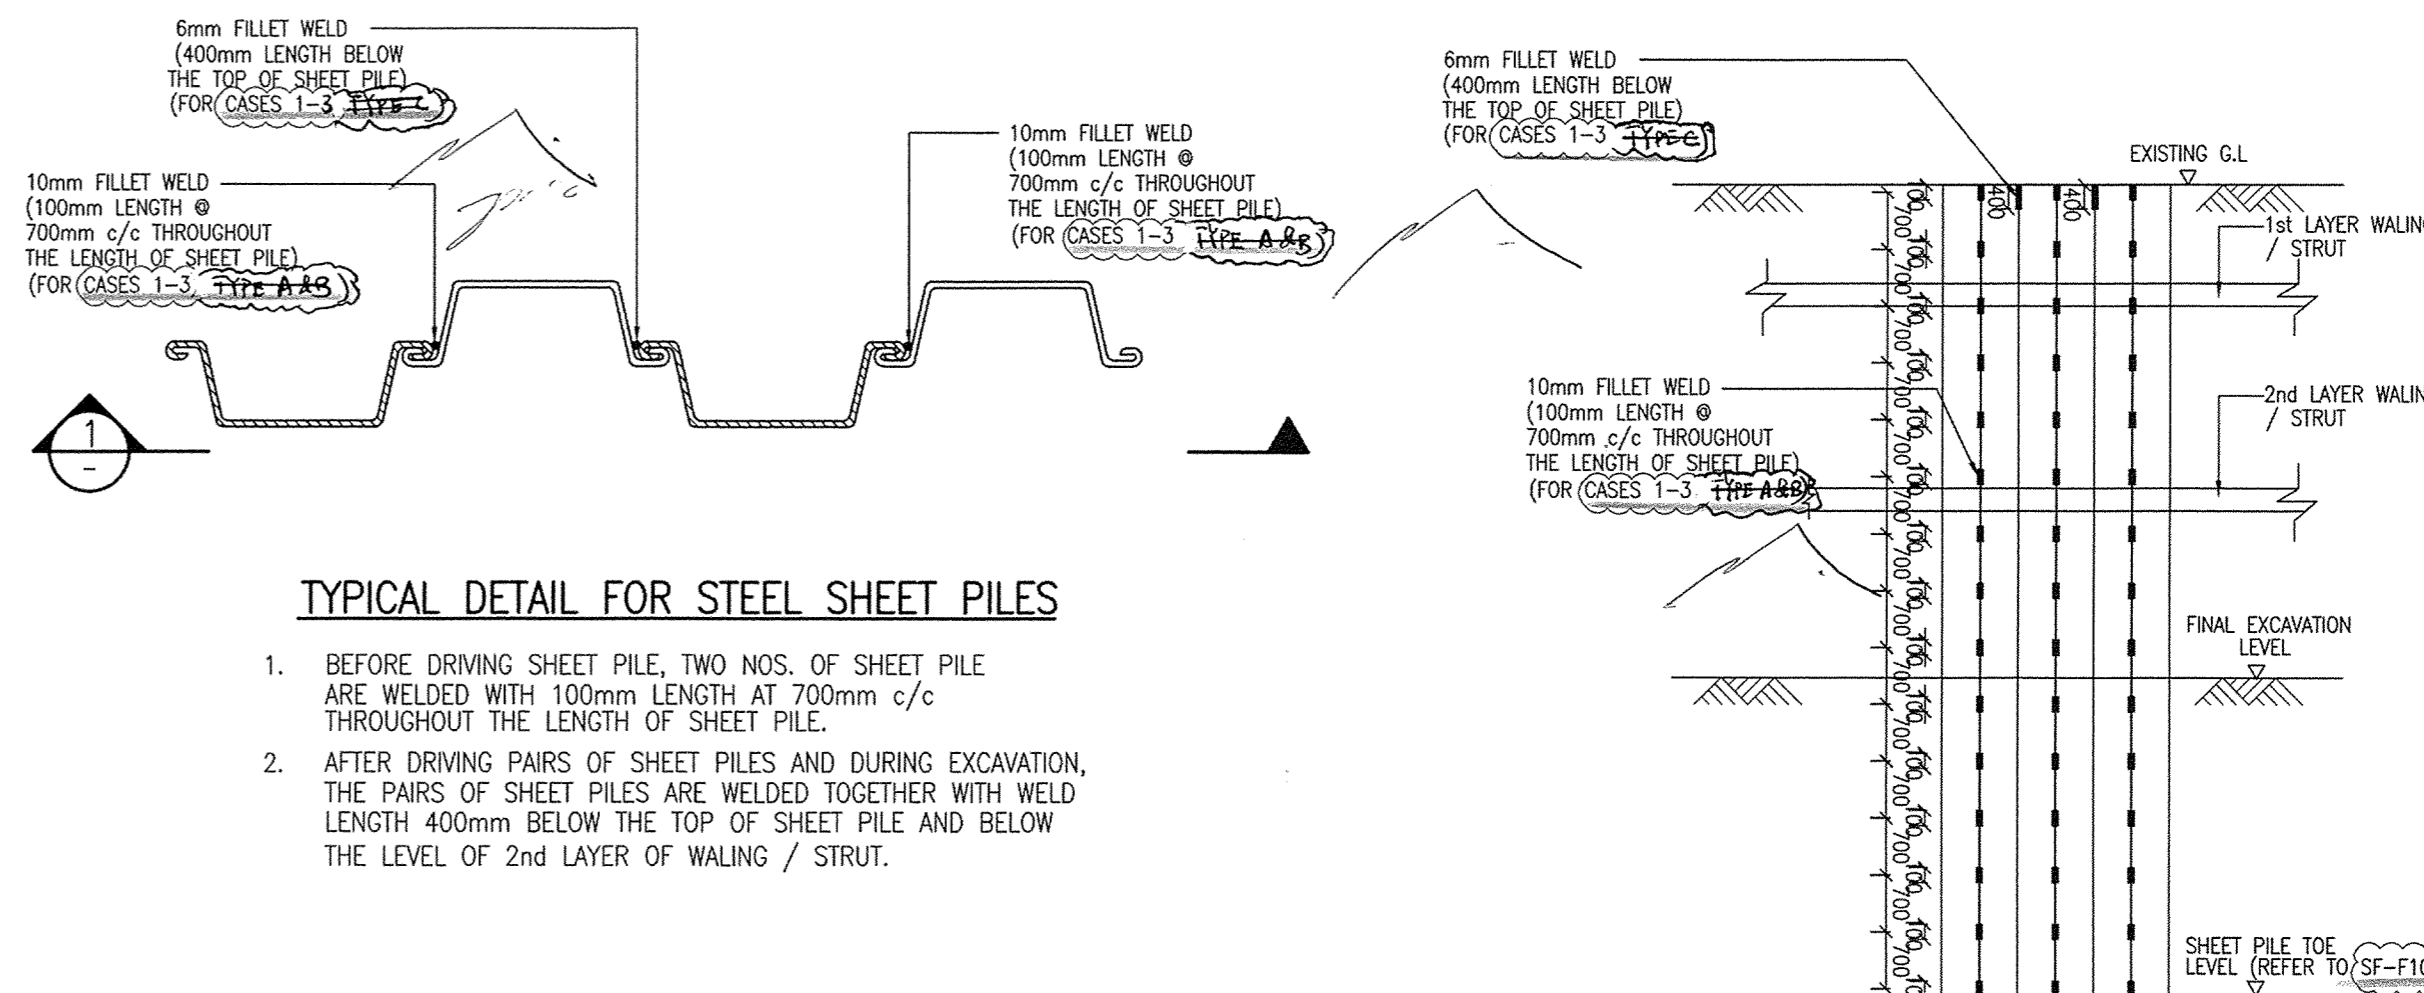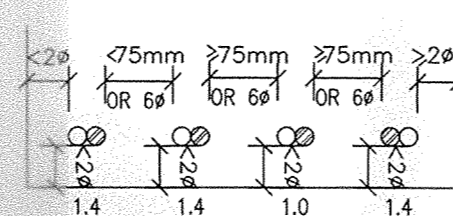

TYPICAL DETAIL FOR STEEL SHEET PILES

- BEFORE DRIVING SHEET PILE, TWO NOS. OF SHEET PILE ARE WELDED WITH 100mm LENGTH AT 700mm c/c THROUGHOUT THE LENGTH OF SHEET PILE.
- AFTER DRIVING PAIRS OF SHEET PILES AND DURING EXCAVATION, THE PAIRS OF SHEET PILES ARE WELDED TOGETHER WITH WELD LENGTH 400mm BELOW THE TOP OF SHEET PILE AND BELOW THE LEVEL OF 2nd LAYER OF WALING / STRUT.

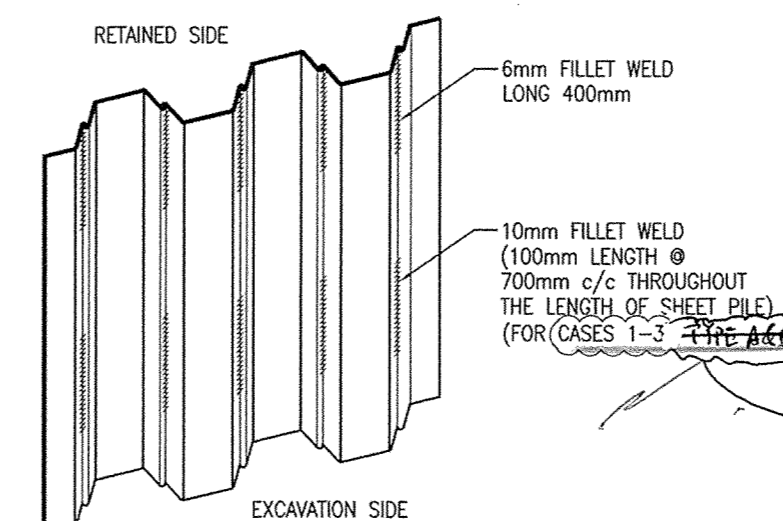

WELDING DETAILS OF SHEETPILE

Note: This plan has been processed on a curtailed check basis under the centralized processing system as promulgated in PNAP ADM-10. The duties of the authorized person, registered structural engineer and/or registered geotechnical engineer as specified under section 4(1)(b) and the provision of section 14(1)(b) of the Building Ordinance are not applicable to this report.

Plan Approved
Building Surveyor
for BUILDING AUTHORITY
11 AUG 2020

BUILDINGS DEPARTMENT

Chang Hong Man, Michael, BA (A.S.) B. Arch. R.I.B.A. R.I.B.A. Authorised Person, Architect

REV.	DATE	DESCRIPTION
-	07/2020	GENERAL REVISION
-	-	BD APPROVED ON 02 MAR 2017

PROJECT
RESIDENTIAL DEVELOPMENT
KAM POK ROAD NEW TERRITORIES

DRAWING TITLE
SITE FORMATION FOR FLOOD MITIGATION - TYPICAL DETAILS AND NOTES FOR ELS

JOB NO.	DESIGNED	CATH
DATE	12/2016	DRAWN
SCALE	N.T.S. (A1)	CHECKED
DRG. NO.	SF-F103	STATUS
		SUBMISSION

ARCHITECT
mcaal
michael chang and associates architects
謝國光 趙國興 謝國興

ENGINEER
STEPHEN CHENG
Chan Chu Fai Edmond
Registered Structural Engineer
CONSULTING ENGINEERS LTD.

RECORD PLAN
AMENDMENT

TYPICAL CONNECTION DETAIL BETWEEN SHEET PILE AND INCLINED WALING AND STRUT

