

2026年 3月 2 5日

此文件在 收到。城市規劃委員會
只會在收到所有必要的資料及文件後才正式確認收到
申請的日期。

Appendix I of RNTPC
Paper No. A/YL-KTN/1222A

This document is received on 2026-03-25
The Town Planning Board will formally acknowledge
the date of receipt of the application only upon receipt
of all the required information and documents.

Form No. S16-III
表格第 S16-III 號

**APPLICATION FOR PERMISSION
UNDER SECTION 16 OF
THE TOWN PLANNING ORDINANCE
(CAP. 131)**

根據《城市規劃條例》(第131章)
第16條遞交的許可申請

**Applicable to Proposal Only Involving Temporary Use/Development of Land
and/or Building Not Exceeding 3 Years in Rural Areas or Regulated Areas,
or Renewal of Permission for such Temporary Use or Development***

**適用於祇涉及位於鄉郊地區或受規管地區土地上及/或建築物內進行
為期不超過三年的臨時用途/發展或該等臨時用途/發展的許可續期的建議***

**Form No. S16-I should be used for other Temporary Use/Development of Land and/or Building (e.g. temporary use/developments in the Urban Area) and Renewal of Permission for such Temporary Use or Development.*

**其他土地上及/或建築物內的臨時用途/發展 (例如位於市區內的臨時用途或發展) 及有關該等臨時用途/發展的許可續期，應使用表格第 S16-I 號。*

Applicant who would like to publish the notice of application in local newspapers to meet one of the Town Planning Board's requirements of taking reasonable steps to obtain consent of or give notification to the current land owner, please refer to the following link regarding publishing the notice in the designated newspapers:
https://www.tpb.gov.hk/en/plan_application/apply.html

申請人如欲在本地報章刊登申請通知，以採取城市規劃委員會就取得現行土地擁有人的同意或通知現行土地擁有人所指定的其中一項合理步驟，請瀏覽以下網址有關在指定的報章刊登通知：
https://www.tpb.gov.hk/tc/plan_application/apply.html

General Note and Annotation for the Form

填寫表格的一般指引及註解

"Current land owner" means any person whose name is registered in the Land Registry as that of an owner of the land to which the application relates, as at 6 weeks before the application is made
「現行土地擁有人」指在提出申請前六星期，其姓名或名稱已在土地註冊處註冊為該申請所關乎的土地的擁有人的人

& Please attach documentary proof 請夾附證明文件

^ Please insert number where appropriate 請在適當地方註明編號

Please fill "NA" for inapplicable item 請在不適用的項目填寫「不適用」

Please use separate sheets if the space provided is insufficient 如所提供的空間不足，請另頁說明

Please insert a 「✓」 at the appropriate box 請在適當的方格內上加上「✓」號

2600624

12/3

By Hand

Form No. S16-III 表格第 S16-III 號

For Official Use Only 請勿填寫此欄	Application No. 申請編號	A1YL-KTN/1222
	Date Received 收到日期	2026-03-25

- The completed form and supporting documents (if any) should be sent to the Secretary, Town Planning Board (the Board), 15/F, North Point Government Offices, 333 Java Road, North Point, Hong Kong.
申請人須把填妥的申請表格及其他支持申請的文件 (倘有), 送交香港北角渣華道 333 號北角政府合署 15 樓城市規劃委員會(下稱「委員會」)秘書收。
- Please read the "Guidance Notes" carefully before you fill in this form. The document can be downloaded from the Board's website at <http://www.tpb.gov.hk/>. It can also be obtained from the Secretariat of the Board at 15/F, North Point Government Offices, 333 Java Road, North Point, Hong Kong (Tel: 2231 4810 or 2231 4835), and the Planning Enquiry Counters of the Planning Department (Hotline: 2231 5000) (17/F, North Point Government Offices, 333 Java Road, North Point, Hong Kong and 14/F, Sha Tin Government Offices, 1 Sheung Wo Che Road, Sha Tin, New Territories).
請先細閱《申請須知》的資料單張, 然後填寫此表格。該份文件可從委員會的網頁下載 (網址: <http://www.tpb.gov.hk/>), 亦可向委員會秘書處 (香港北角渣華道 333 號北角政府合署 15 樓 - 電話: 2231 4810 或 2231 4835) 及規劃署的規劃資料查詢處(熱線: 2231 5000) (香港北角渣華道 333 號北角政府合署 17 樓及新界沙田上禾輦路 1 號沙田政府合署 14 樓)索取。
- This form can be downloaded from the Board's website, and obtained from the Secretariat of the Board and the Planning Enquiry Counters of the Planning Department. The form should be typed or completed in block letters. The processing of the application may be refused if the required information or the required copies are incomplete.
此表格可從委員會的網頁下載, 亦可向委員會秘書處及規劃署的規劃資料查詢處索取。申請人須以打印方式或以正楷填寫表格。如果申請人所提交的資料或文件副本不齊全, 委員會可拒絕處理有關申請。

1. Name of Applicant 申請人姓名/名稱

(☐ Mr. 先生 / ☐ Mrs. 夫人 / ☐ Miss 小姐 / ☐ Ms. 女士 / ☒ Company 公司 / ☐ Organisation 機構)

Pearl River Holdings Limited 東江控股有限公司

2. Name of Authorised Agent (if applicable) 獲授權代理人姓名/名稱 (如適用)

(☐ Mr. 先生 / ☐ Mrs. 夫人 / ☐ Miss 小姐 / ☐ Ms. 女士 / ☒ Company 公司 / ☐ Organisation 機構)

R-riches Planning Limited 盈卓規劃有限公司

3. Application Site 申請地點

(a) Full address / location / demarcation district and lot number (if applicable) 詳細地址/地點/丈量約份及地段號碼 (如適用)	Lot 4115 (Part) in D.D. 104, Fung Kat Heung, Kam Tin, Yuen Long, New Territories
(b) Site area and/or gross floor area involved 涉及的地盤面積及/或總樓面面積	☒ Site area 地盤面積 690 sq.m 平方米 ☒ About 約 ☒ Gross floor area 總樓面面積 436 sq.m 平方米 ☒ About 約
(c) Area of Government land included (if any) 所包括的政府土地面積 (倘有)	 N/A sq.m 平方米 ☐ About 約

(d) Name and number of the related statutory plan(s) 有關法定圖則的名稱及編號	Approved Kam Tin North Outline Zoning Plan No.: S/YL-KTN/11
(e) Land use zone(s) involved 涉及的土地用途地帶	"Other Specified Uses" annotated "Railway Reserve" Zone
(f) Current use(s) 現時用途	Storage (If there are any Government, institution or community facilities, please illustrate on plan and specify the use and gross floor area) (如有任何政府、機構或社區設施，請在圖則上顯示，並註明用途及總樓面面積)

4. "Current Land Owner" of Application Site 申請地點的「現行土地擁有人」

The applicant 申請人 –

- ☒ is the sole "current land owner"[#] (please proceed to Part 6 and attach documentary proof of ownership).
是唯一的「現行土地擁有人」[#] (請繼續填寫第 6 部分，並夾附業權證明文件)。
- ☐ is one of the "current land owners"[#] (please attach documentary proof of ownership).
是其中一名「現行土地擁有人」[#] (請夾附業權證明文件)。
- ☐ is not a "current land owner"[#].
並不是「現行土地擁有人」[#]。
- ☐ The application site is entirely on Government land (please proceed to Part 6).
申請地點完全位於政府土地上 (請繼續填寫第 6 部分)。

5. Statement on Owner's Consent/Notification

就土地擁有人的同意/通知土地擁有人的陳述

- (a) According to the record(s) of the Land Registry as at (DD/MM/YYYY), this application involves a total of "current land owner(s)"[#].
根據土地註冊處截至 年 月 日的記錄，這宗申請共牽涉 名「現行土地擁有人」[#]。

(b) The applicant 申請人 –

- ☐ has obtained consent(s) of "current land owner(s)"[#].
已取得 名「現行土地擁有人」[#]的同意。

Details of consent of "current land owner(s)" [#] obtained 取得「現行土地擁有人」 [#] 同意的詳情		
No. of 'Current Land Owner(s)' 「現行土地擁有人」數目	Lot number/address of premises as shown in the record of the Land Registry where consent(s) has/have been obtained 根據土地註冊處記錄已獲得同意的地段號碼/處所地址	Date of consent obtained (DD/MM/YYYY) 取得同意的日期 (日/月/年)

(Please use separate sheets if the space of any box above is insufficient. 如上列任何方格的空間不足，請另頁說明)

- ☐ has notified "current land owner(s)"#
已通知 名「現行土地擁有人」#。

Details of the "current land owner(s)"# notified 已獲通知「現行土地擁有人」#的詳細資料

No. of 'Current Land Owner(s)' 「現行土地擁有人」數目	Lot number/address of premises as shown in the record of the Land Registry where notification(s) has/have been given 根據土地註冊處記錄已發出通知的地段號碼／處所地址	Date of notification given (DD/MM/YYYY) 通知日期(日/月/年)

(Please use separate sheets if the space of any box above is insufficient. 如上列任何方格的空間不足，請另頁說明)

- ☐ has taken reasonable steps to obtain consent of or give notification to owner(s):

已採取合理步驟以取得土地擁有人的同意或向該人發給通知。詳情如下：

Reasonable Steps to Obtain Consent of Owner(s) 取得土地擁有人的同意所採取的合理步驟

- ☐ sent request for consent to the "current land owner(s)" on _____ (DD/MM/YYYY)#&
於_____ (日/月/年)向每一名「現行土地擁有人」#郵遞要求同意書&

Reasonable Steps to Give Notification to Owner(s) 向土地擁有人發出通知所採取的合理步驟

- ☐ published notices in local newspapers on _____ (DD/MM/YYYY)&
於_____ (日/月/年)在指定報章就申請刊登一次通知&
- ☐ posted notice in a prominent position on or near application site/premises on _____ (DD/MM/YYYY)&
於_____ (日/月/年)在申請地點／申請處所或附近的顯明位置貼出關於該申請的通知&
- ☐ sent notice to relevant owners' corporation(s)/owners' committee(s)/mutual aid committee(s)/management office(s) or rural committee on _____ (DD/MM/YYYY)&
於_____ (日/月/年)把通知寄往相關的業主立案法團／業主委員會／互助委員會或管理處，或有關的鄉事委員會&

Others 其他

- ☐ others (please specify)
其他（請指明）

Note: May insert more than one 「✓」.

Information should be provided on the basis of each and every lot (if applicable) and premises (if any) in respect of the application.

註：可在多於一個方格內加上「✓」號

申請人須就申請涉及的每一地段（倘適用）及處所（倘有）分別提供資料

6. Type(s) of Application 申請類別**(A) Temporary Use/Development of Land and/or Building Not Exceeding 3 Years in Rural Areas or Regulated Areas**

位於鄉郊地區或受規管地區土地上及/或建築物內進行為期不超過三年的臨時用途/發展

(For Renewal of Permission for Temporary Use or Development in Rural Areas or Regulated Areas, please proceed to Part (B))

(如屬位於鄉郊地區或受規管地區臨時用途/發展的規劃許可續期，請填寫(B)部分)

(a) Proposed use(s)/development
擬議用途/發展

Proposed Temporary Warehouse (excluding Dangerous Goods Godown) and Open Storage of Construction Materials with Ancillary Facilities for a Period of 3 Years

(Please illustrate the details of the proposal on a layout plan) (請用平面圖說明擬議詳情)

(b) Effective period of permission applied for
申請的許可有效期☒ year(s) 年 3☐ month(s) 個月**(c) Development Schedule 發展細節表**Proposed uncovered land area 擬議露天土地面積 463sq.m ☒ About 約Proposed covered land area 擬議有上蓋土地面積 227sq.m ☐ About 約

Proposed number of buildings/structures 擬議建築物/構築物數目 2

Proposed domestic floor area 擬議住用樓面面積 N/Asq.m ☐ About 約Proposed non-domestic floor area 擬議非住用樓面面積 436sq.m ☒ About 約Proposed gross floor area 擬議總樓面面積 436sq.m ☐ About 約

Proposed height and use(s) of different floors of buildings/structures (if applicable) 建築物/構築物的擬議高度及不同樓層的擬議用途 (如適用) (Please use separate sheets if the space below is insufficient) (如以下空間不足，請另頁說明)

STRUCTURE	USE	COVERED AREA	GFA	BUILDING HEIGHT
B1 (G/F) (1/F)	STORAGE OF GOODS WAREHOUSE (EXCLUDING D.G.G.), SITE OFFICE	219 m ² (ABOUT)*	219 m ² (ABOUT)* 209 m ² (ABOUT)	8m (ABOUT)(2-STOREY)
B2	PORTABLE TOILET	8 m ² (ABOUT)	8 m ² (ABOUT)	3m (ABOUT)(1-STOREY)
TOTAL		227m ² (ABOUT)	436m ² (ABOUT)	

*INCLUDE 10m² STAIRCASE

Proposed number of car parking spaces by types 不同種類停車位的擬議數目

Private Car Parking Spaces 私家車車位

2

Motorcycle Parking Spaces 電單車車位

N/A

Light Goods Vehicle Parking Spaces 輕型貨車泊車位

N/A

Medium Goods Vehicle Parking Spaces 中型貨車泊車位

N/A

Heavy Goods Vehicle Parking Spaces 重型貨車泊車位

N/A

Others (Please Specify) 其他 (請列明)

Proposed number of loading/unloading spaces 上落客貨車位的擬議數目

Taxi Spaces 的士車位

N/A

Coach Spaces 旅遊巴車位

N/A

Light Goods Vehicle Spaces 輕型貨車車位

1

Medium Goods Vehicle Spaces 中型貨車車位

N/A

Heavy Goods Vehicle Spaces 重型貨車車位

N/A

Others (Please Specify) 其他 (請列明)

Proposed operating hours 擬議營運時間 Monday to Saturday from 08:00 to 19:00. No operation on Sunday and public holidays			
(d) Any vehicular access to the site/subject building? 是否有車路通往地盤／有關建築物？	Yes 是	☒ There is an existing access. (please indicate the street name, where appropriate) 有一條現有車路。(請註明車路名稱(如適用)) Accessible from San Tam Road via a local access ☐ There is a proposed access. (please illustrate on plan and specify the width) 有一條擬議車路。(請在圖則顯示，並註明車路的闊度) ☐	
	No 否		
(e) Impacts of Development Proposal 擬議發展計劃的影響 (If necessary, please use separate sheets to indicate the proposed measures to minimise possible adverse impacts or give justifications/reasons for not providing such measures. 如需要的話，請另頁註明可盡量減少可能出現不良影響的措施，否則請提供理據/理由。)			
(i) Does the development proposal involve alteration of existing building? 擬議發展計劃是否包括現有建築物的改動？	Yes 是	☐ Please provide details 請提供詳情 No 否 ☒	
(ii) Does the development proposal involve the operation on the right? 擬議發展是否涉及右列的工程？	Yes 是	☐ (Please indicate on site plan the boundary of concerned land/pond(s), and particulars of stream diversion, the extent of filling of land/pond(s) and/or excavation of land) (請用地盤平面圖顯示有關土地／池塘界線，以及河道改道、填塘、填土及／或挖土的細節及／或範圍) ☐ Diversion of stream 河道改道 ☐ Filling of pond 填塘 Area of filling 填塘面積 sq.m 平方米 ☐ About 約 Depth of filling 填塘深度 m 米 ☒ About 約 ☐ Filling of land 填土 Area of filling 填土面積 sq.m 平方米 ☐ About 約 Depth of filling 填土厚度 m 米 ☐ About 約 ☐ Excavation of land 挖土 Area of excavation 挖土面積 sq.m 平方米 ☐ About 約 Depth of excavation 挖土深度 m 米 ☐ About 約 No 否 ☒	
	No 否		
(iii) Would the development proposal cause any adverse impacts? 擬議發展計劃會否造成不良影響？	On environment 對環境 Yes 會 ☐ No 不會 ☒ On traffic 對交通 Yes 會 ☐ No 不會 ☒ On water supply 對供水 Yes 會 ☐ No 不會 ☒ On drainage 對排水 Yes 會 ☐ No 不會 ☒ On slopes 對斜坡 Yes 會 ☐ No 不會 ☒ Affected by slopes 受斜坡影響 Yes 會 ☐ No 不會 ☒ Landscape Impact 構成景觀影響 Yes 會 ☐ No 不會 ☒ Tree Felling 砍伐樹木 Yes 會 ☐ No 不會 ☒ Visual Impact 構成視覺影響 Yes 會 ☐ No 不會 ☒ Others (Please Specify) 其他 (請列明) Yes 會 ☐ No 不會 ☒		

	Please state measure(s) to minimise the impact(s). For tree felling, please state the number, diameter at breast height and species of the affected trees (if possible) 請註明盡量減少影響的措施。如涉及砍伐樹木，請說明受影響樹木的數目、及胸高度的樹幹直徑及品種(倘可)
--	--

(B) Renewal of Permission for Temporary Use or Development in Rural Areas or Regulated Areas	
位於鄉郊地區或受規管地區臨時用途/發展的許可續期	
(a) Application number to which the permission relates 與許可有關的申請編號	A/ _____ / _____
(b) Date of approval 獲批給許可的日期	 (DD 日/MM 月/YYYY 年)
(c) Date of expiry 許可屆滿日期	 (DD 日/MM 月/YYYY 年)
(d) Approved use/development 已批給許可的用途/發展	
(e) Approval conditions 附帶條件	☐ The permission does not have any approval condition 許可並沒有任何附帶條件 ☐ Applicant has complied with all the approval conditions 申請人已履行全部附帶條件 ☐ Applicant has not yet complied with the following approval condition(s): 申請人仍未履行下列附帶條件： Reason(s) for non-compliance: 仍未履行的原因： (Please use separate sheets if the space above is insufficient) (如以上空間不足，請另頁說明)
(f) Renewal period sought 要求的續期期間	☐ year(s) 年 ☐ month(s) 個月

8. Declaration 聲明

I hereby declare that the particulars given in this application are correct and true to the best of my knowledge and belief.
本人謹此聲明，本人就這宗申請提交的資料，據本人所知及所信，均屬真實無誤。

I hereby grant a permission to the Board to copy all the materials submitted in this application and/or to upload such materials to the Board's website for browsing and downloading by the public free-of-charge at the Board's discretion.

本人現准許委員會酌情將本人就此申請所提交的所有資料複製及/或上載至委員會網站，供公眾免費瀏覽或下載。

Signature
簽署

☐ Applicant 申請人 / ☒ Authorised Agent 獲授權代理人

.....
Michael WONG
.....

Name in Block Letters
姓名（請以正楷填寫）

Position (if applicable)
職位（如適用）

Professional Qualification(s)
專業資格

☐ Member 會員 / ☐ Fellow of 資深會員

☐ HKIP 香港規劃師學會 / ☐ HKIA 香港建築師學會 /

☐ HKIS 香港測量師學會 / ☐ HKIE 香港工程師學會 /

☐ HKILA 香港園境師學會 / ☐ HKIUD 香港城市設計學會

☐ RPP 註冊專業規劃師

Others 其他

on behalf of
代表

R-riches Planning Limited 盈卓規劃有限公司



☒ Company 公司 / ☐ Organisation Name and Chop (if applicable) 機構名稱及蓋章（如適用）

Date 日期

02/03/2026 (DD/MM/YYYY 日/月/年)

Remark 備註

The materials submitted in this application and the Board's decision on the application would be disclosed to the public. Such materials would also be uploaded to the Board's website for browsing and free downloading by the public where the Board considers appropriate.

委員會會向公眾披露申請人所遞交的申請資料和委員會對申請所作的決定。在委員會認為合適的情況下，有關申請資料亦會上載至委員會網頁供公眾免費瀏覽及下載。

Warning 警告

Any person who knowingly or wilfully makes any statement or furnish any information in connection with this application, which is false in any material particular, shall be liable to an offence under the Crimes Ordinance.

任何人在明知或故意的情況下，就這宗申請提出在任何要項上是虛假的陳述或資料，即屬違反《刑事罪行條例》。

Statement on Personal Data 個人資料的聲明

1. The personal data submitted to the Board in this application will be used by the Secretary of the Board and Government departments for the following purposes:

委員會就這宗申請所收到的個人資料會交給委員會秘書及政府部門，以根據《城市規劃條例》及相關的城市規劃委員會規劃指引的規定作以下用途：

(a) the processing of this application which includes making available the name of the applicant for public inspection when making available this application for public inspection; and

處理這宗申請，包括公布這宗申請供公眾查閱，同時公布申請人的姓名供公眾查閱；以及

(b) facilitating communication between the applicant and the Secretary of the Board/Government departments.

方便申請人與委員會秘書及政府部門之間進行聯絡。

2. The personal data provided by the applicant in this application may also be disclosed to other persons for the purposes mentioned in paragraph 1 above.

申請人就這宗申請提供的個人資料，或亦會向其他人士披露，以作上述第 1 段提及的用途。

3. An applicant has a right of access and correction with respect to his/her personal data as provided under the Personal Data (Privacy) Ordinance (Cap. 486). Request for personal data access and correction should be addressed to the Secretary of the Board at 15/F, North Point Government Offices, 333 Java Road, North Point, Hong Kong.

根據《個人資料(私隱)條例》(第 486 章)的規定，申請人有權查閱及更正其個人資料。如欲查閱及更正個人資料，應向委員會秘書提出有關要求，其地址為香港北角渣華道 333 號北角政府合署 15 樓。

Gist of Application 申請摘要

(Please provide details in both English and Chinese as far as possible. This part will be circulated to relevant consultees, uploaded to the Town Planning Board's Website for browsing and free downloading by the public and available at the Planning Enquiry Counters of the Planning Department for general information.)

(請盡量以英文及中文填寫。此部分將會發送予相關諮詢人士、上載至城市規劃委員會網頁供公眾免費瀏覽及下載及於規劃署規劃資料查詢處供一般參閱。)

Application No. 申請編號	(For Official Use Only) (請勿填寫此欄)
Location/address 位置/地址	Lot 4115 (Part) in D.D. 104, Fung Kat Heung, Kam Tin, Yuen Long, New Territories
Site area 地盤面積	690 sq. m 平方米 ☒ About 約 (includes Government land of 包括政府土地 N/A sq. m 平方米 ☐ About 約)
Plan 圖則	Approved Kam Tin North Outline Zoning Plan No.: S/YL-KTN/11
Zoning 地帶	"Other Specified Uses" annotated "Railway Reserve" Zone
Type of Application 申請類別	☒ Temporary Use/Development in Rural Areas or Regulated Areas for a Period of 位於鄉郊地區或受規管地區的臨時用途/發展為期 ☒ Year(s) 年 3 ☐ Month(s) 月 _____ ☐ Renewal of Planning Approval for Temporary Use/Development in Rural Areas or Regulated Areas for a Period of 位於鄉郊地區或受規管地區臨時用途/發展的規劃許可續期為期 ☐ Year(s) 年 _____ ☐ Month(s) 月 _____
Applied use/ development 申請用途/發展	Proposed Temporary Warehouse (excluding Dangerous Goods Godown) and Open Storage of Construction Materials with Ancillary Facilities for a Period of 3 Years

(i) Gross floor area and/or plot ratio 總樓面面積及／或地積比率		sq.m 平方米	Plot Ratio 地積比率
	Domestic 住用	N/A ☐ About 約 ☐ Not more than 不多於	N/A ☐ About 約 ☐ Not more than 不多於
	Non-domestic 非住用	436 ☐ About 約 ☐ Not more than 不多於	0.63 ☐ About 約 ☐ Not more than 不多於
(ii) No. of blocks 幢數	Domestic 住用	N/A	
	Non-domestic 非住用	2	
(iii) Building height/No. of storeys 建築物高度／層數	Domestic 住用	N/A m 米 ☐ (Not more than 不多於)	
		N/A Storeys(s) 層 ☐ (Not more than 不多於)	
	Non-domestic 非住用	3 - 8 m 米 ☐ (Not more than 不多於)	
		1 - 2 Storeys(s) 層 ☐ (Not more than 不多於)	
(iv) Site coverage 上蓋面積	33 % ☐ About 約		
(v) No. of parking spaces and loading / unloading spaces 停車位及上落客貨車位數目	Total no. of vehicle parking spaces 停車位總數		2
	Private Car Parking Spaces 私家車車位 Motorcycle Parking Spaces 電單車車位 Light Goods Vehicle Parking Spaces 輕型貨車泊車位 Medium Goods Vehicle Parking Spaces 中型貨車泊車位 Heavy Goods Vehicle Parking Spaces 重型貨車泊車位 Others (Please Specify) 其他 (請列明) 		2 N/A N/A N/A N/A
	Total no. of vehicle loading/unloading bays/lay-bys 上落客貨車位／停車處總數		1
	Taxi Spaces 的士車位 Coach Spaces 旅遊巴車位 Light Goods Vehicle Spaces 輕型貨車車位 Medium Goods Vehicle Spaces 中型貨車車位 Heavy Goods Vehicle Spaces 重型貨車車位 Others (Please Specify) 其他 (請列明) 		N/A N/A 1 N/A N/A

Submitted Plans, Drawings and Documents 提交的圖則、繪圖及文件

	Chinese 中文	English 英文
Plans and Drawings 圖則及繪圖		
Master layout plan(s)/Layout plan(s) 總綱發展藍圖／布局設計圖	☐	☒
Block plan(s) 樓宇位置圖	☐	☐
Floor plan(s) 樓宇平面圖	☐	☐
Sectional plan(s) 截視圖	☐	☐
Elevation(s) 立視圖	☐	☐
Photomontage(s) showing the proposed development 顯示擬議發展的合成照片	☐	☐
Master landscape plan(s)/Landscape plan(s) 園境設計總圖／園境設計圖	☐	☐
Others (please specify) 其他（請註明）	☐	☒
<u>Location Plan; Zoning Plan; Plan showing Land Status of the Site; Swept Path Analyses; Fire Service Installations Proposal, As-built Drainage Record, TPB PG 13G</u>		
Reports 報告書		
Planning Statement/Justifications 規劃綱領/理據	☐	☒
Environmental assessment (noise, air and/or water pollutions) 環境評估（噪音、空氣及／或水的污染）	☐	☐
Traffic impact assessment (on vehicles) 就車輛的交通影響評估	☐	☐
Traffic impact assessment (on pedestrians) 就行人的交通影響評估	☐	☐
Visual impact assessment 視覺影響評估	☐	☐
Landscape impact assessment 景觀影響評估	☐	☐
Tree Survey 樹木調查	☐	☐
Geotechnical impact assessment 土力影響評估	☐	☐
Drainage impact assessment 排水影響評估	☐	☐
Sewerage impact assessment 排污影響評估	☐	☐
Risk Assessment 風險評估	☐	☐
Others (please specify) 其他（請註明）	☐	☐
Note: May insert more than one 「✓」. 註：可在多於一個方格內加上「✓」號		

Note: The information in the Gist of Application above is provided by the applicant for easy reference of the general public. Under no circumstances will the Town Planning Board accept any liabilities for the use of the information nor any inaccuracies or discrepancies of the information provided. In case of doubt, reference should always be made to the submission of the applicant.

註：上述申請摘要的資料是由申請人提供以方便市民大眾參考。對於所載資料在使用上的問題及文義上的歧異，城市規劃委員會概不負責。若有任何疑問，應查閱申請人提交的文件。

Supplementary Statement

1) Background

- 1.1 The applicant seeks planning permission from the Town Planning Board (the Board) to use *Lot 4115 (Part) in D.D. 104* (the Site) for '**Proposed Temporary Warehouse (Excluding Dangerous Goods Godown (D.G.G.)) and Open Storage of Construction Materials with Ancillary Facilities for a Period of 3 Years**' (the proposed development) (**Plans 1 to 3**).
- 1.2 In view of the pressing demand for indoor storage space in New Territories in recent years, the applicant would like to continue to use the Site to operate a warehouse for storage of miscellaneous goods (including but not limited to packaged herbal medicine, apparel, footwear, electronic goods, construction materials and machinery etc.); whereas the open storage is intended for the storage of construction materials (e.g. bricks, scaffold, steel beam etc.) to support the local warehousing and storage industry.

2) Planning Context

- 2.1 The Site currently falls within an area zoned "Other Specified Uses" annotated "Railway Reserve" ("OU(RR)") on the Approved Kam Tin North Outline Zoning Plan No.: S/YL-KTN/11 (**Plan 2**). According to the Notes of the OZP, the applied use is not a column one nor column two use within the "OU(RR)" zone. Therefore, planning permission is required for the proposed development.
- 2.2 The Site falls within Category 2 area under the Town Planning Board Guidelines No. 13G (TPB PG-No. 13G), which is considered suitable for open storage and port back-up uses (**Plan 4**). Although the Site falls within area zoned as "OU(RR)" which is reserved for phase 2 development of the Northern Link alignment, the temporary basis of the development is considered not affecting the commencement of the railway project. Hence, approval of the application on a temporary basis of 3 years would not frustrate the long-term planning intention of the "OU(RR)" zone and better utilize precious land resources in the New Territories.
- 2.3 Furthermore, several applications for 'Warehouse' and 'Storage' uses were approved by the Board within/partly within the same "OU(RR)" zone in the previous 5 years, which the application site of the latest application (No. A/YL-KTN/949) for 'storage' use is located approximately 480m southwest to the Site, was approved by the Board on a temporary basis

of 3 years in September 2023. Hence, approval of the current application would not set an undesirable precedent within the "OU(RR)" zone.

- 2.4 The Site is the subject of an approved S.16 planning application (No. A/YL-KTN/841) for 'open storage' use submitted by the same applicant as the current application, which was approved by the Board on a temporary basis in July 2022. The applicant has made effort to comply with approval conditions of the previous application, details are shown at **Table 1** below:

Table 1 – Details of Compliance with Approval Conditions of the Previous Application

Approval Conditions of Application No. A/YL-KTN/841		Date of Compliance
(d)	The submission of a condition record of the existing drainage facilities	Not complied with
(f)	The submission of a revised fire service installations (FSIs) proposal	29.09.2022
(g)	The implementation of the revised FSIs proposal	Not complied with

- 2.5 During the approval period of the previous application, the applicant has made effort in complying with approval conditions in regard to drainage and fire safety aspects. Details are as follow:

Drainage aspect

For condition (d), the applicant has made submission with a photographic record showing the existing drainage facilities on the Site on 29.09.2022 and 18.08.2023 while both submissions were considered not acceptable by the Chief Engineering/Mainland North, Drainage Services Department (CE/MN, DSD). The applicant is therefore failed to comply with this condition within the specified period of time.

Fire safety aspect

For condition (f), the applicant submitted a FSIs proposal to comply with condition (f) on 22.08.2022. It was considered acceptable by the Director of Fire Services (D of FS) on 29.09.2022. However, the applicant faced difficulties in coordinating with the fire services contractors for the required installations and inspections. The scheduling conflicts and resource constraints on both sides resulted in delays in meeting installation requirements.

Therefore, the applicant failed to comply with this approval condition within the specified period.

- 2.6 In support of the application, the applicant has submitted a FSIs proposal and an as-built drainage record to minimise potential impact(s) to the surrounding areas, as well as for the consideration of relevant government bureaux/departments and members of the Board (**Appendices I to II**).

3) Development Proposal

- 3.1 The Site area is 690 m² (about) (**Plan 3**). The operation hours of the proposed development are Monday to Saturday from 08:00 to 19:00. No operation on Sunday and public holiday. A total of two structures are proposed at the Site for warehouse (excluding D.G.G.), storage of goods, site office and portable toilet with total GFA of 436 m² (about) (**Plan 4**). It is estimated that the Site would be able to accommodate 3 staff. As the Site is proposed for 'warehouse' use without shopfront, no visitor is anticipated at the Site. Details of development parameters are shown at **Table 1** below:

Table 2 – Major Development Parameters

Application Site Area	690 m ² (about)
Covered Area	227 m ² (about)
Uncovered Area	463 m ² (about)
Plot Ratio	0.63 (about)
Site Coverage	33 % (about)
Number of Structure	2
Total GFA	436 m ² (about)
- Domestic GFA	Not applicable
- Non-Domestic GFA	436 m ² (about)
Building Height	3m - 8 m (about)
No. of Storey	1 - 2

- 3.2 The Site has already been hard paved for site formation of structure, loading/unloading (L/UL) and circulation spaces. The current application serves to regularize the existing land filling area. As heavy loading of vehicles and construction materials would compact the existing

soiled ground and weaken the ground surface, concrete site formation is required to meet the operational meet and that has been kept to minimal for the operation of the proposed development.

- 3.3 The Site is accessible from San Tam Road via a local access (**Plan 1**). A total of 3 parking and L/UL spaces will be provided within the Site, details are as shown below at **Table 3**:

Table 3 – Parking and L/UL provisions

Types of Space	No. of Spaces
Parking Space for Private Cars (PC) - 2.5 m (W) x 5 m (L)	2
L/UL Space for Light Goods Vehicle (LGV) - 3.5 m (W) x 7 m (L)	1

- 3.4 LGV is deployed for transportation of construction materials to/out of the Site, hence, L/UL space for the aforesaid vehicle is provided. Sufficient space is provided for vehicle to smoothly manoeuvre within the Site to ensure that no vehicle will turn back onto the local access (**Plan 5**). Staff will be deployed by the applicant to direct vehicle entering/exiting the Site to ensure pedestrian safety to/from the Site. As traffic generated and attracted by the proposed development as shown at **Table 4** below is minimal, adverse traffic impact to the surrounding road network should not be anticipated.

Table 4 – Estimated Trips Generation/Attraction

Time Period	Estimated Trips Generation/Attraction				
	PC		LGV		2-Way Total
	In	Out	In	Out	
Trips at <u>AM peak</u> per hour (08:00 – 09:00)	2	0	0	0	2
Trips at <u>PM peak</u> per hour (18:00 – 19:00)	0	2	0	0	2
Average trip per hour (09:00 – 18:00)	0	0	1	1	2

- 3.5 No storage of dangerous goods will be allowed at the Site at any time during the planning approval period. All construction materials would be stored at the designated storage area

(i.e. about 71 m²) with stacking height of not more than 3m. No dismantling, maintenance, recycling, cleaning, paint spraying and other workshop activities will be carried out at the Site at any time during the planning approval period.

- 3.6 The applicant will implement good practices stated in *Professional Persons Environmental Consultative Committee Practice Notes (ProPECCPN) 1/24* to when designing on-site sewage system within the Site.
- 3.7 Relevant environmental protection/pollution control ordinances, i.e. *Water Pollution Control Ordinance, Air Pollution Control Ordinance, Noise Control Ordinance* etc. will be strictly complied with at all times during the planning approval period. The applicant will also follow relevant mitigation measures and requirements in the latest '*Code of Practice on Handling the Environmental Aspects of Temporary Uses and Open Storage Sites*' issued by the Environmental Protection Department to minimise adverse environmental impacts and nuisance to the surrounding area.

4) Conclusion

- 4.1 The development will not create nuisance to the surrounding areas. Adequate mitigation measures are provided by the applicant, i.e. the submission a FSIs proposal and an as-built drainage record to mitigate any adverse impact arising from the proposed development (**Appendices I to II**).
- 4.2 In view of the above, the Board is hereby respectfully recommended to approve the subject application for '**Proposed Temporary Warehouse (Excluding D.G.G.) and Open Storage of Construction Materials with Ancillary Facilities for a Period of 3 Years**'.

R-riches Planning Limited


March 2026

LIST OF PLANS

Plan 1	Location Plan
Plan 2	Zoning Plan
Plan 3	Land Status Plan
Plan 4	TPB PG-No. 13G
Plan 5	Layout Plan
Plan 6	Swept Path Analysis

APPENDICES


Appendix I	Fire Service Installations Proposal
Appendix II	As-built Drainage Record

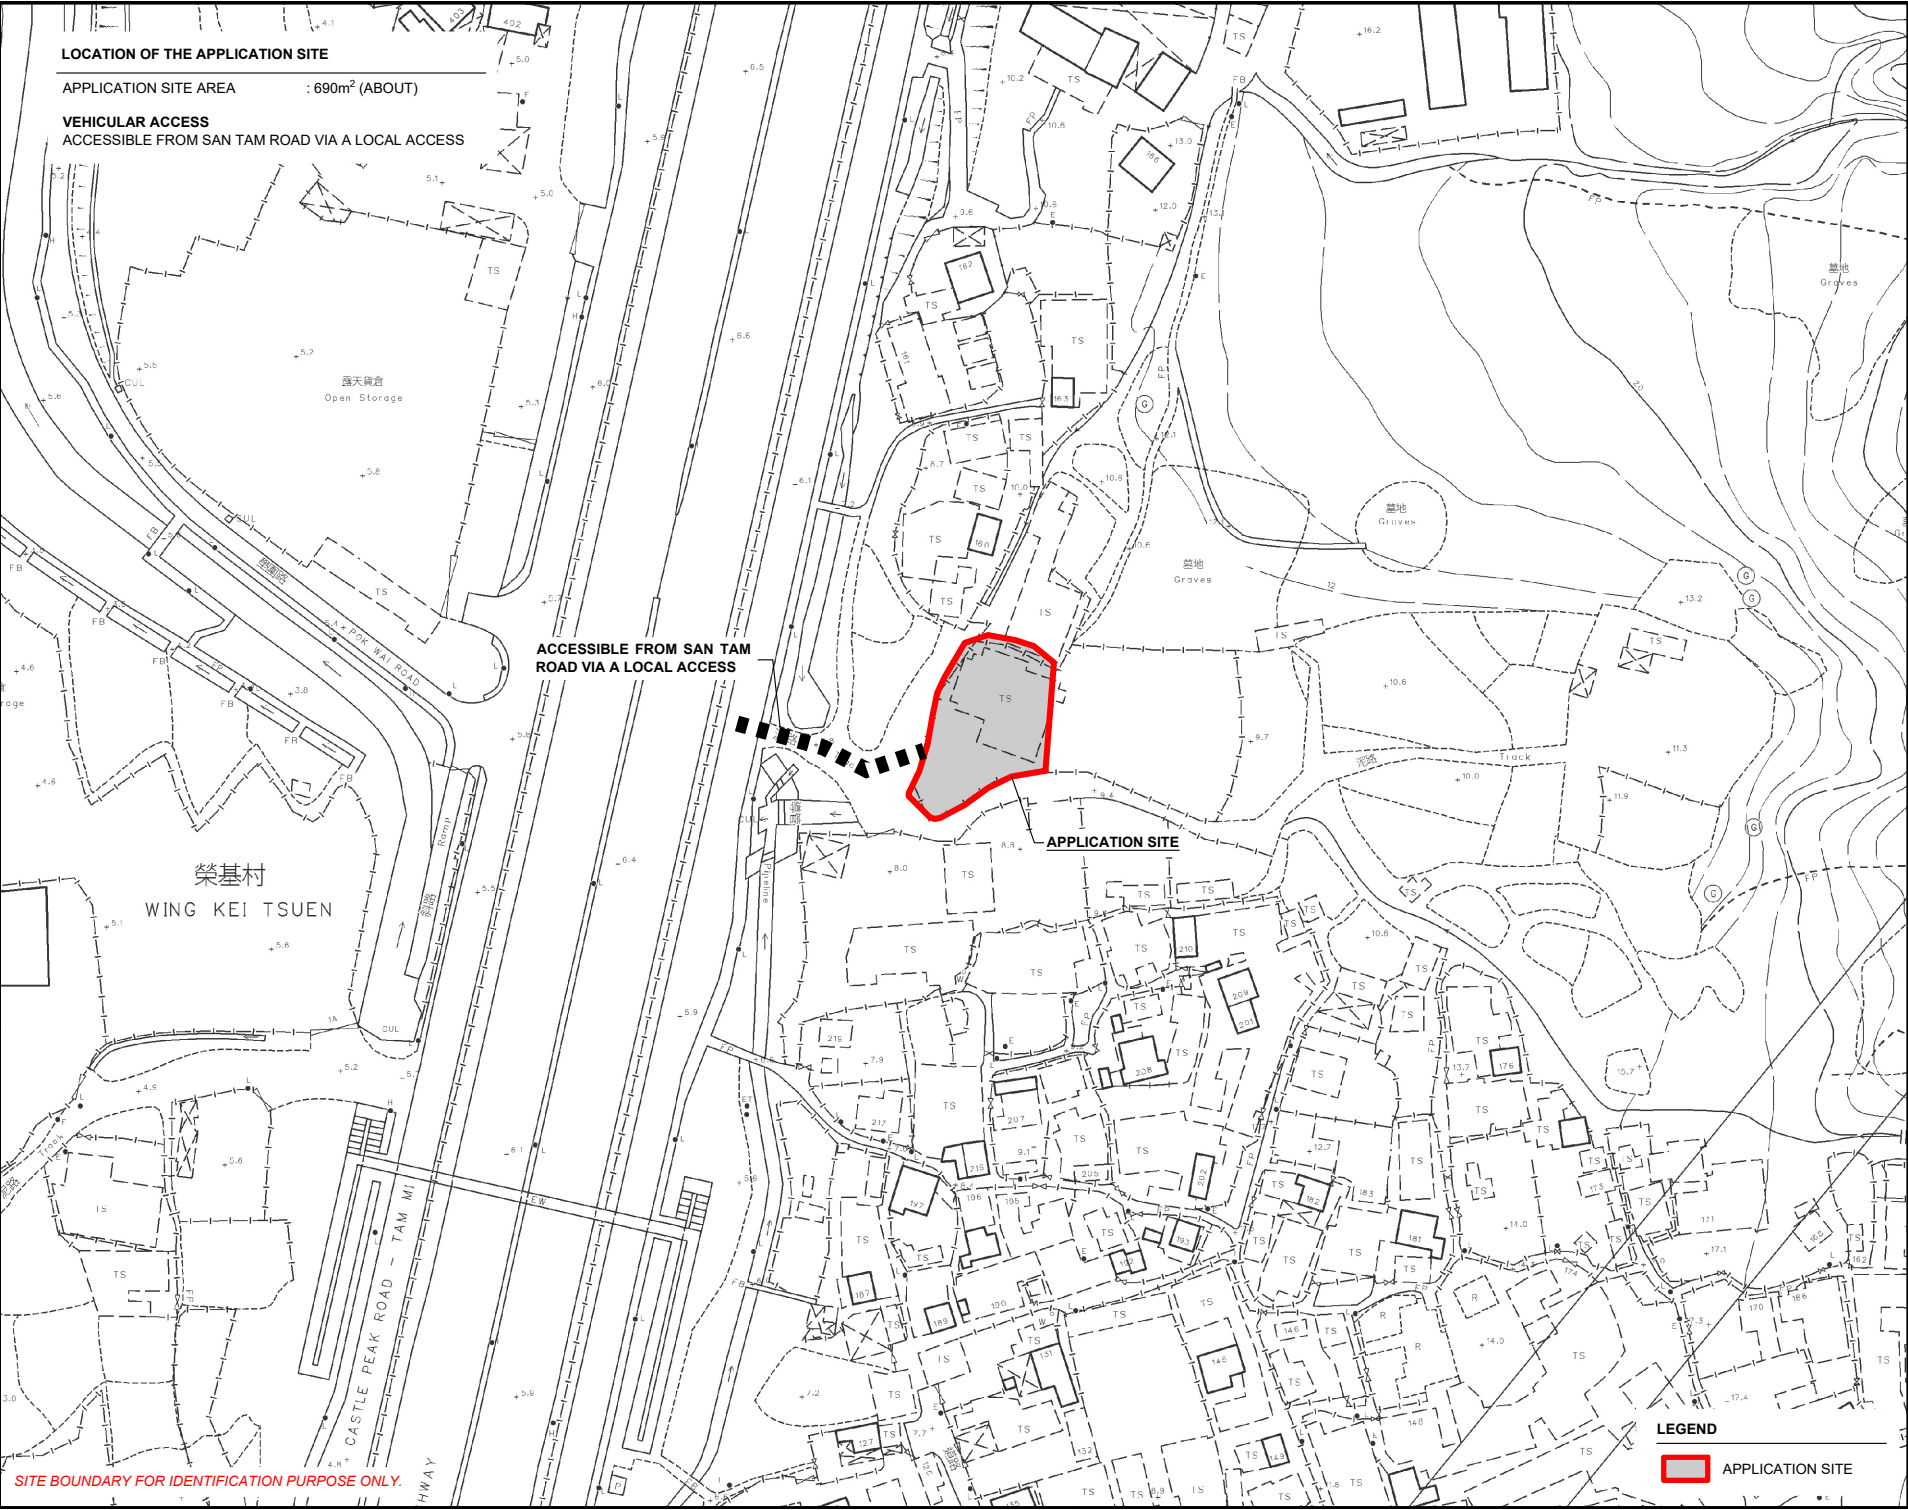

LOCATION OF THE APPLICATION SITE
APPLICATION SITE AREA : 690m² (ABOUT)
VEHICULAR ACCESS
ACCESSIBLE FROM SAN TAM ROAD VIA A LOCAL ACCESS

ACCESSIBLE FROM SAN TAM ROAD VIA A LOCAL ACCESS

APPLICATION SITE

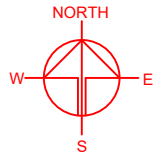

PLANNING CONSULTANT



PROJECT

PROPOSED WAREHOUSE (EXCLUDING DANGEROUS GOODS GODOWN) AND OPEN STORAGE OF CONSTRUCTION MATERIALS WITH ANCILLARY FACILITIES FOR A PERIOD OF 3 YEARS

SITE LOCATION

LOT 4115 (PART) IN D.D. 104, FUNG KAT HEUNG, KAM TIN, YUEN LONG, NEW TERRITORIES

SCALE

1: 1500 @ A4

DRAWN BY

MN

DATE

19.2.2024

CHECKED BY

DATE

APPROVED BY

DATE

LEGEND



APPLICATION SITE

DWG. TITLE

LOCATION PLAN

DWG. NO.

PLAN 1

VER.

001



SITE BOUNDARY FOR IDENTIFICATION PURPOSE ONLY.

ZONING OF THE APPLICATION SITE

APPLICATION SITE AREA : 690 m² (ABOUT)

OUTLINE ZONING PLAN : APPROVED KAM TIN NORTH OZP
OZP PLAN NO. : S/YL-KTN/11

ZONING OF THE SITE : "OTHER SPECIFIED USES"
ANNOTATED "RAILWAY RESERVE"

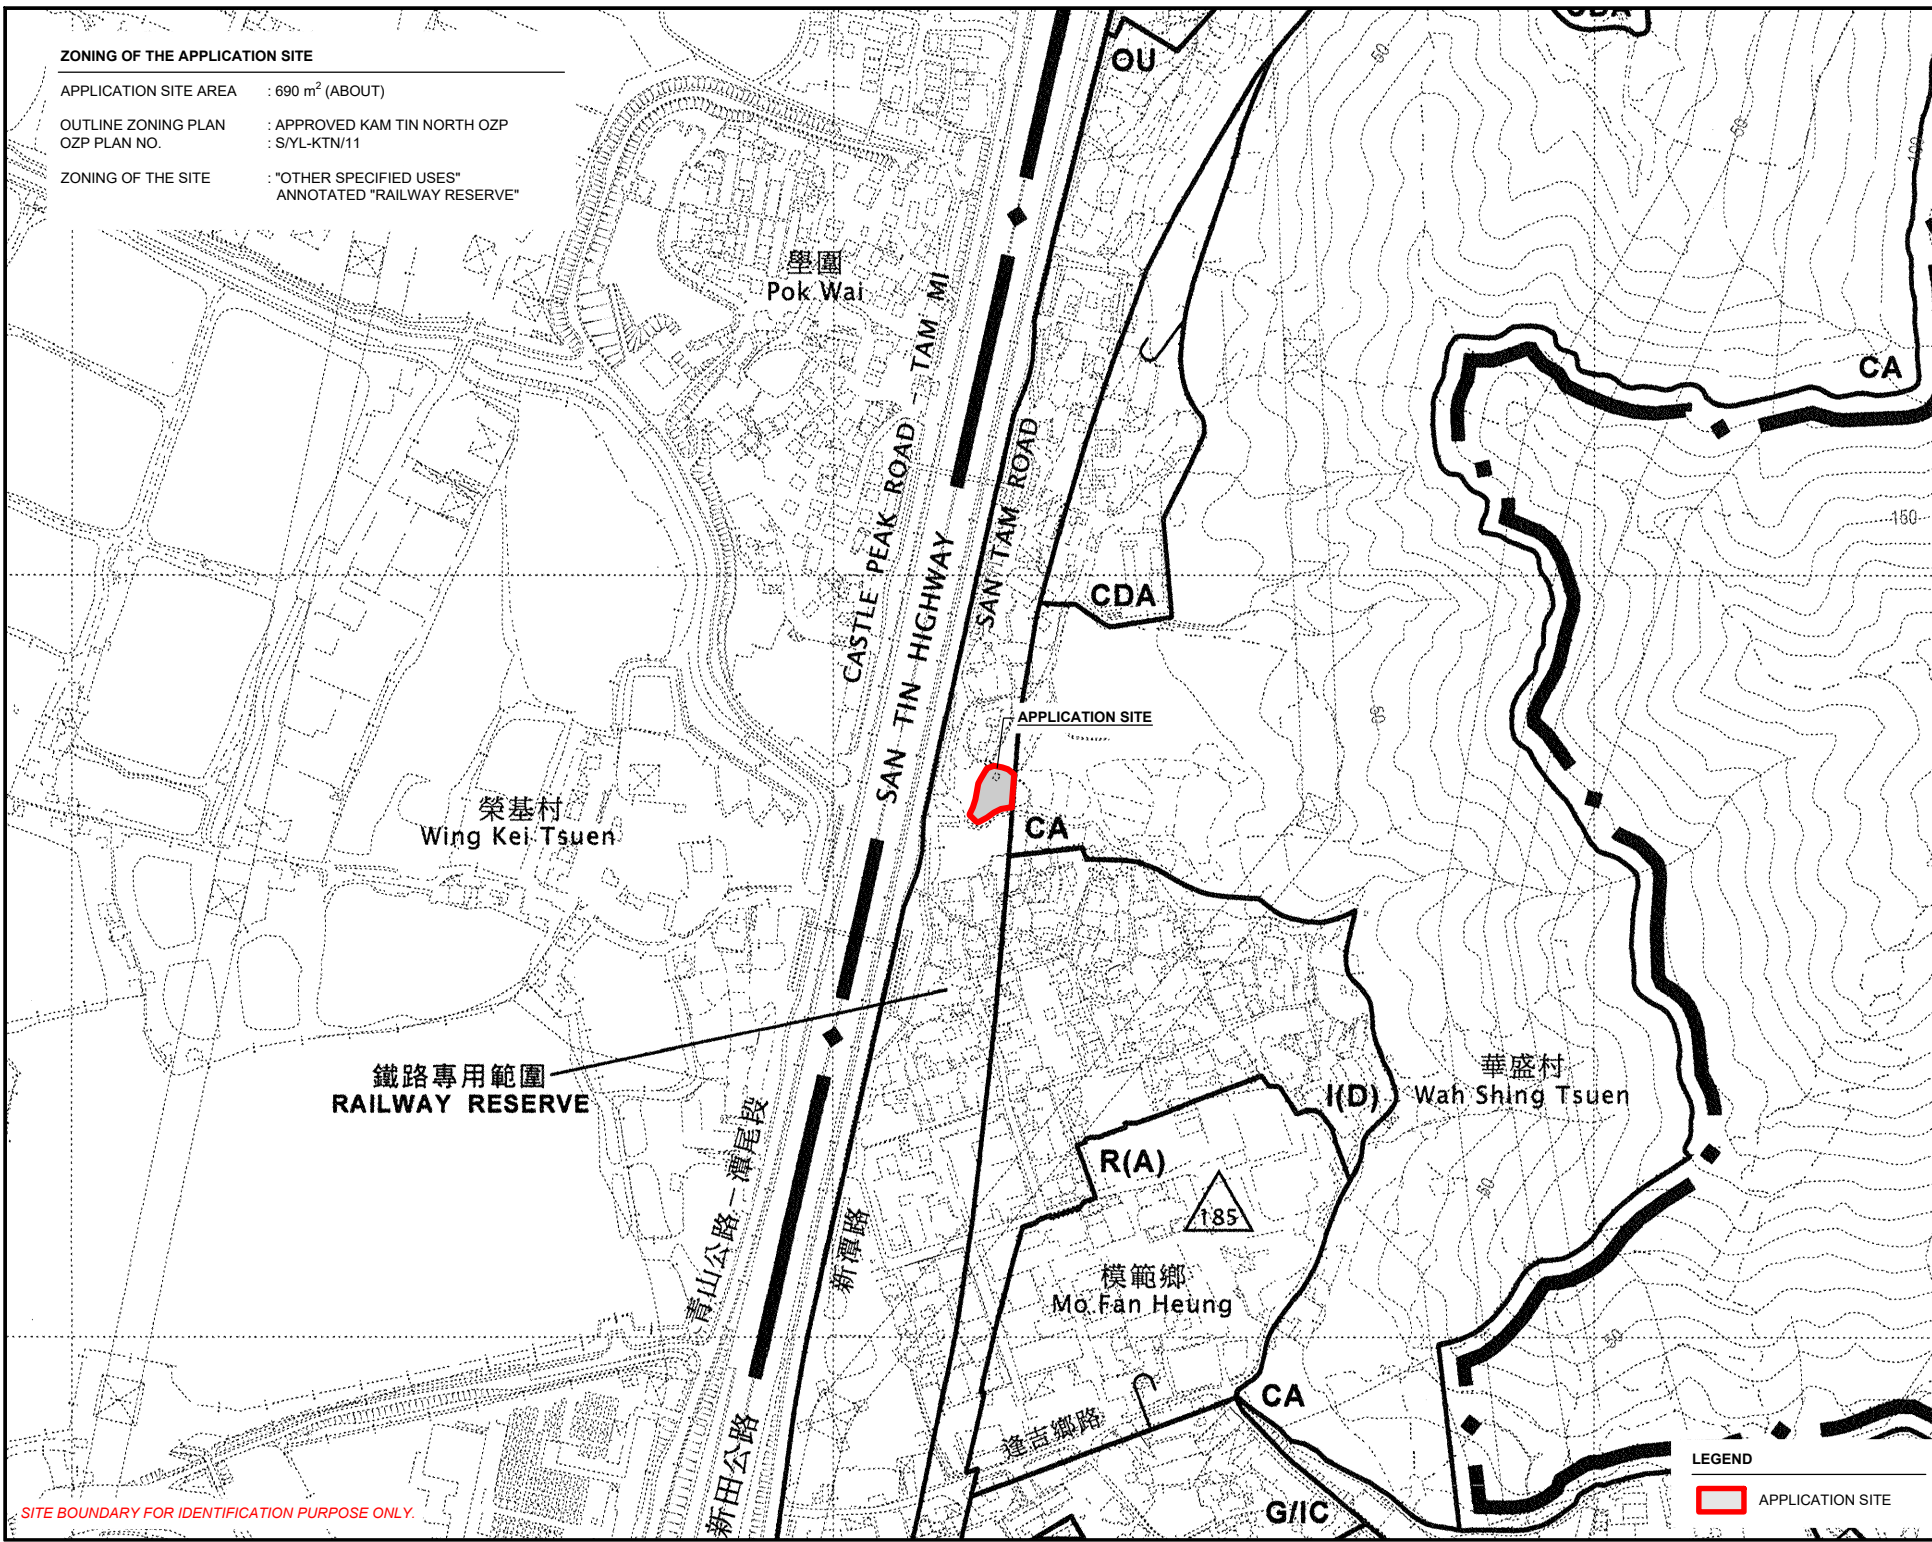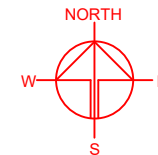

SITE BOUNDARY FOR IDENTIFICATION PURPOSE ONLY.

PLANNING CONSULTANT



PROJECT

PROPOSED WAREHOUSE (EXCLUDING DANGEROUS GOODS GODOWN) AND OPEN STORAGE OF CONSTRUCTION MATERIALS WITH ANCILLARY FACILITIES FOR A PERIOD OF 3 YEARS

TEMPORARY (EXCLUDING DANGEROUS GOODS GODOWN)

SITE LOCATION

LOT 4115 (PART) IN D.D. 104, FUNG KAT HEUNG, KAM TIN, YUEN LONG, NEW TERRITORIES

SCALE

1 : 5000 @ A4

DRAWN BY	DATE
MN	19.2.2024
CHECKED BY	DATE
APPROVED BY	DATE

DWG. TITLE

ZONING OF THE SITE



DWG. NO.	VER.
PLAN 2	001

LEGEND

APPLICATION SITE

LAND STATUS OF THE APPLICATION SITE

APPLICATION SITE AREA : 690 m² (ABOUT)
 AREA OF PRIVATE LAND : 690 m² (ABOUT)
 AREA OF GOVERNMENT LAND : NOT APPLICABLE

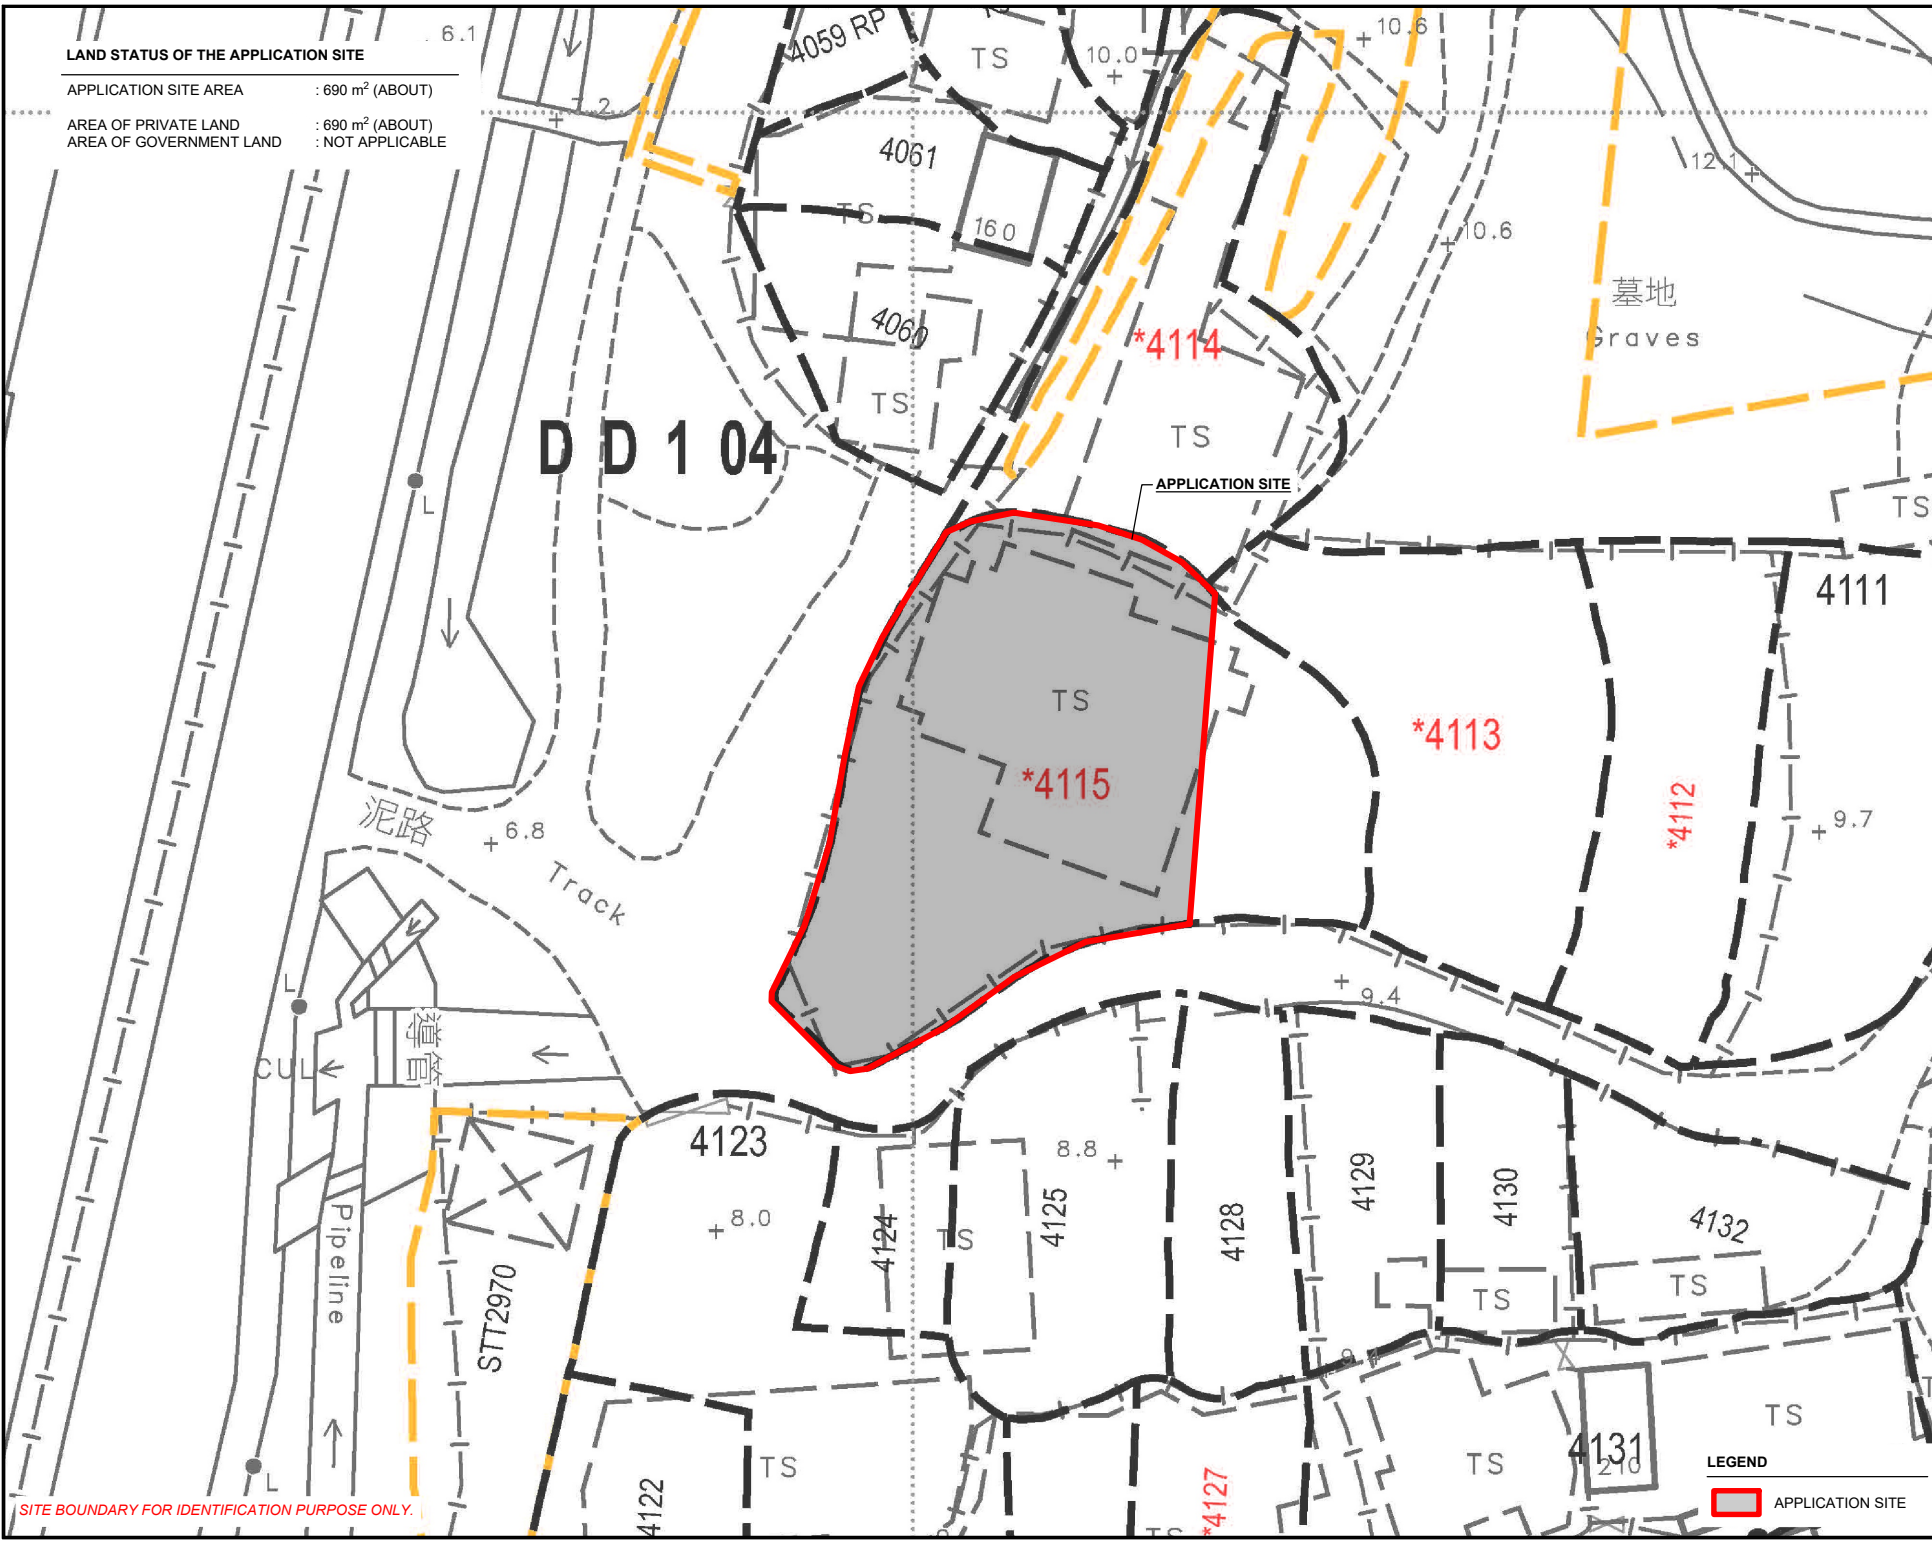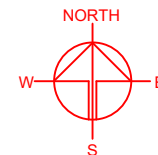

SITE BOUNDARY FOR IDENTIFICATION PURPOSE ONLY.

LEGEND

APPLICATION SITE

PLANNING CONSULTANT



PROJECT

PROPOSED WAREHOUSE (EXCLUDING DANGEROUS GOODS GODOWN) AND OPEN STORAGE OF CONSTRUCTION MATERIALS WITH ANCILLARY FACILITIES FOR A PERIOD OF 3 YEARS

SITE LOCATION

LOT 4115 (PART) IN D.D. 104, FUNG KAT HEUNG, KAM TIN, YUEN LONG, NEW TERRITORIES

SCALE

1 : 500 @ A4

DRAWN BY

MN

DATE

19.2.2024

CHECKED BY

DATE

APPROVED BY

DATE

DWG. TITLE

LAND STATUS OF THE SITE

DWG NO.

PLAN 3



VER.

001

TOWN PLANNING BOARD GUIDELINES NO. 13G FOR
APPLICATION FOR OPEN STORAGE AND PORT BACK-UP USES
UNDER S.16 OF THE TOWN PLANNING ORDINANCE

APPLICATION SITE AREA : 690 m² (ABOUT)

CATEGORY OF SITE : CATEGORY 2 AREA

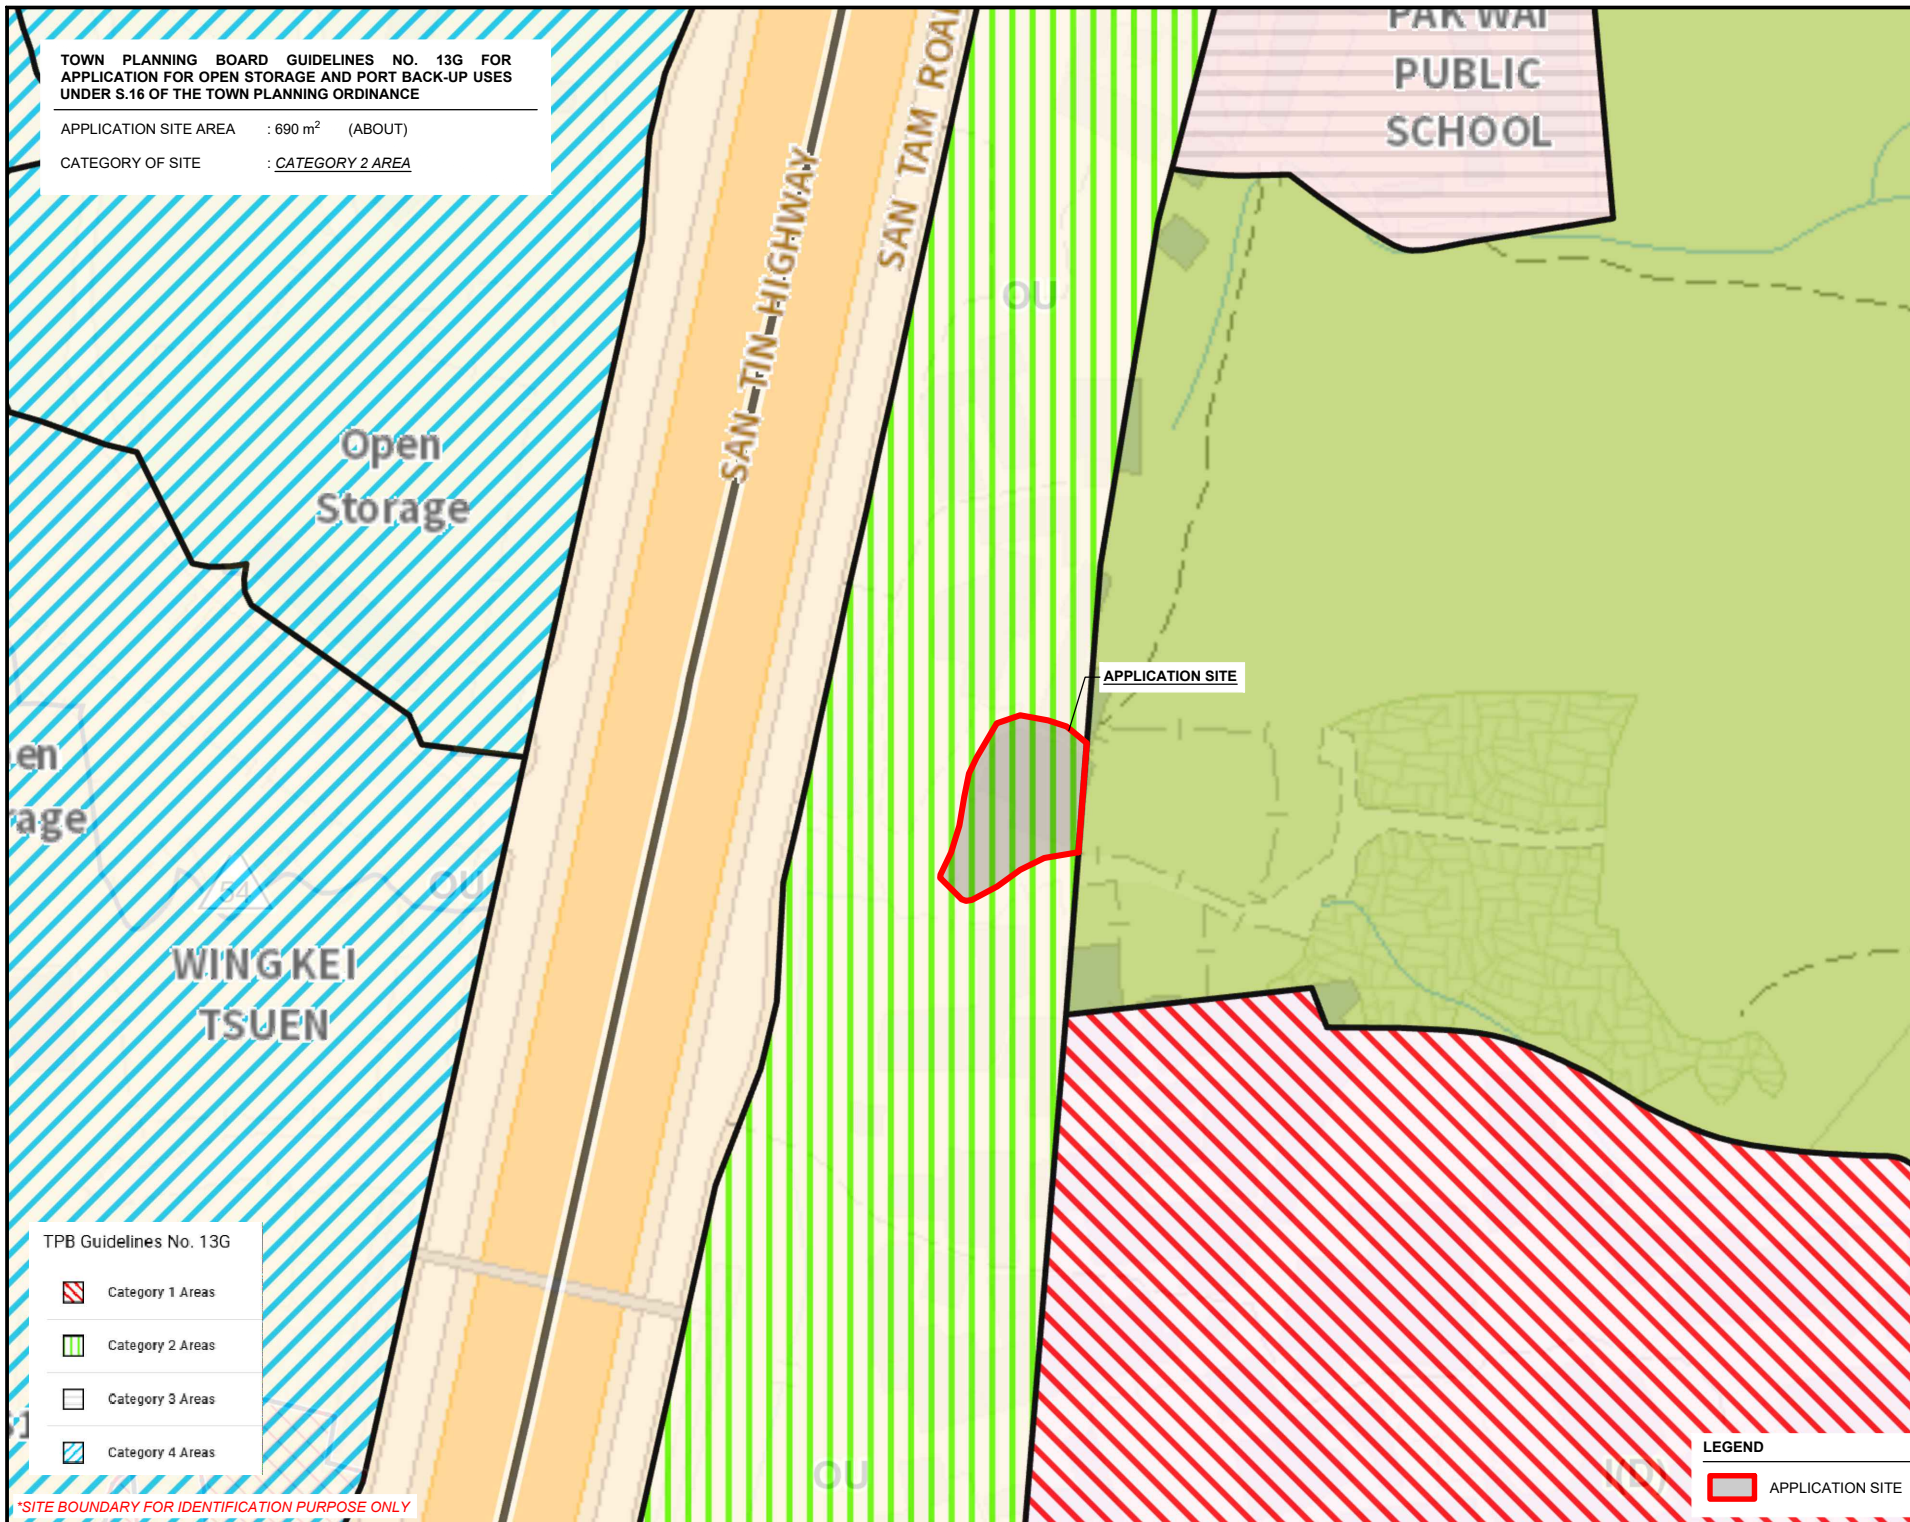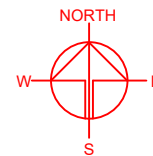

PLANNING CONSULTANT



PROJECT

PROPOSED WAREHOUSE (EXCLUDING DANGEROUS GOODS GODOWN) AND OPEN STORAGE OF CONSTRUCTION MATERIALS WITH ANCILLARY FACILITIES FOR A PERIOD OF 3 YEARS

SITE LOCATION

LOT 4115 (PART) IN D.D. 104, FUNG KAT HEUNG, KAM TIN, YUEN LONG, NEW TERRITORIES

SCALE

1 : 1500 @ A4

DRAWN BY MN DATE 9.3.2026

CHECKED BY DATE

APPROVED BY DATE

LEGEND

APPLICATION SITE

DWG. TITLE

TPB PG-NO. 13G

DWG. NO.

PLAN 4

VER.

001

TPB Guidelines No. 13G

Category 1 Areas

Category 2 Areas

Category 3 Areas

Category 4 Areas




*SITE BOUNDARY FOR IDENTIFICATION PURPOSE ONLY

DEVELOPMENT PARAMETERS

APPLICATION SITE AREA	: 690 m ²	(ABOUT)
COVERED AREA	: 227 m ²	(ABOUT)
UNCOVERED AREA	: 463 m ²	(ABOUT)
PLOT RATIO	: 0.63	(ABOUT)
SITE COVERAGE	: 33 %	(ABOUT)
NO. OF STRUCTURE	: 2	
DOMESTIC GFA	: NOT APPLICABLE	
NON-DOMESTIC GFA	: 436 m ²	(ABOUT)
TOTAL GFA	: 436 m ²	(ABOUT)
BUILDING HEIGHT	: 3 - 8 m	(ABOUT)
NO. OF STOREY	: 1 - 2	
OPEN STORAGE AREA	: 71 m	(ABOUT)
STACKING HEIGHT	: NOT MORE THAN 3 m	

STRUCTURE	USE	COVERED AREA	GFA	BUILDING HEIGHT
B1	(G/F) (1/F)	STORAGE OF GOODS WAREHOUSE (EXCLUDING D.G.G.), SITE OFFICE	219 m ² (ABOUT)* 219 m ² (ABOUT)* 209 m ² (ABOUT)	8m (ABOUT)(2-STOREY)
B2		PORTABLE TOILET	8 m ² (ABOUT)	3m (ABOUT)(1-STOREY)
TOTAL		227m² (ABOUT)	436m² (ABOUT)	

*INCLUDE 10m² STAIRCASE

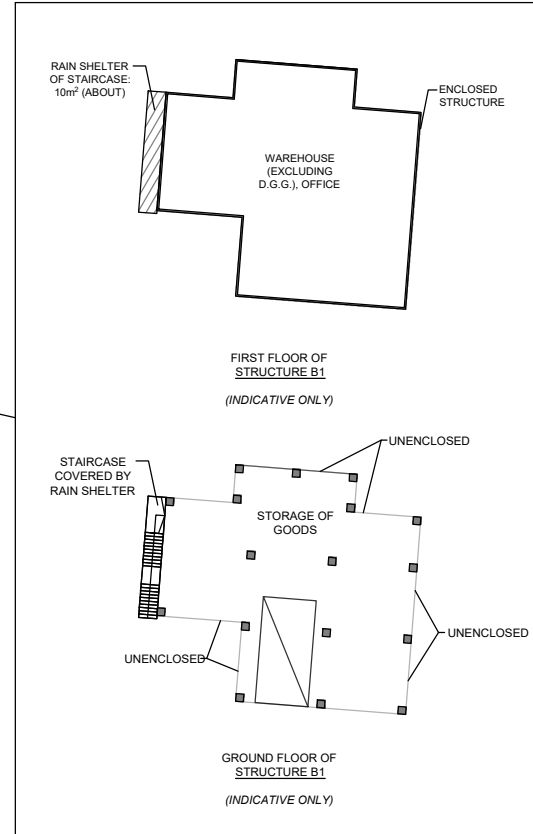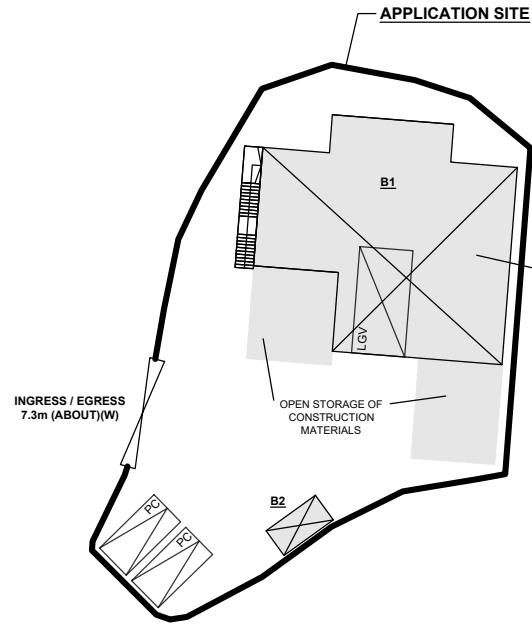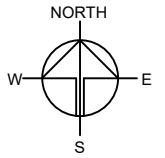

PARKING AND LOADING/UNLOADING PROVISIONS

NO. OF PRIVATE CAR PARKING SPACE	: 2
DIMENSION OF PARKING SPACE	: 5 m (L) X 2.5 m (W)
NO. OF L/U/L SPACE FOR LIGHT GOODS VEHICLE	: 1
DIMENSION OF L/U/L SPACE	: 7 m (L) X 3.5 m (W)
CLEAR HEADROOM	: 3.7 m

LEGEND

	APPLICATION SITE
	STRUCTURE
	STRUCTURE (CANOPY)
	PARKING SPACE (PC)
	LOADING / UNLOADING SPACE (LGV)
	INGRESS / EGRESS

PLANNING CONSULTANT



PROJECT

PROPOSED TEMPORARY
WAREHOUSE (EXCLUDING
DANGEROUS GOODS GODOWN)
AND OPEN STORAGE OF
CONSTRUCTION MATERIALS
WITH ANCILLARY FACILITIES
FOR A PERIOD OF 3 YEARS

SITE LOCATION

LOT 4115 (PART) IN D.D. 104,
FUNG KAT HEUNG, KAM TIN,
YUEN LONG, NEW TERRITORIES

SCALE

1 : 500 @ A4

DRAWN BY	DATE
MN	19.2.2024
CHECKED BY	DATE
APPROVED BY	DATE

DWG. TITLE



LAYOUT PLAN

DWG NO.	VER.
PLAN 5	001

SWEPT PATH ANALYSIS


TYPE OF VEHICLE : LIGHT GOODS VEHICLE
DIMENSION OF VEHICLE : 2.1m (W) X 5.2m (L)

SWEPT PATHS GENERATED BY AUTODESK VEHICLE TRACKING 2019

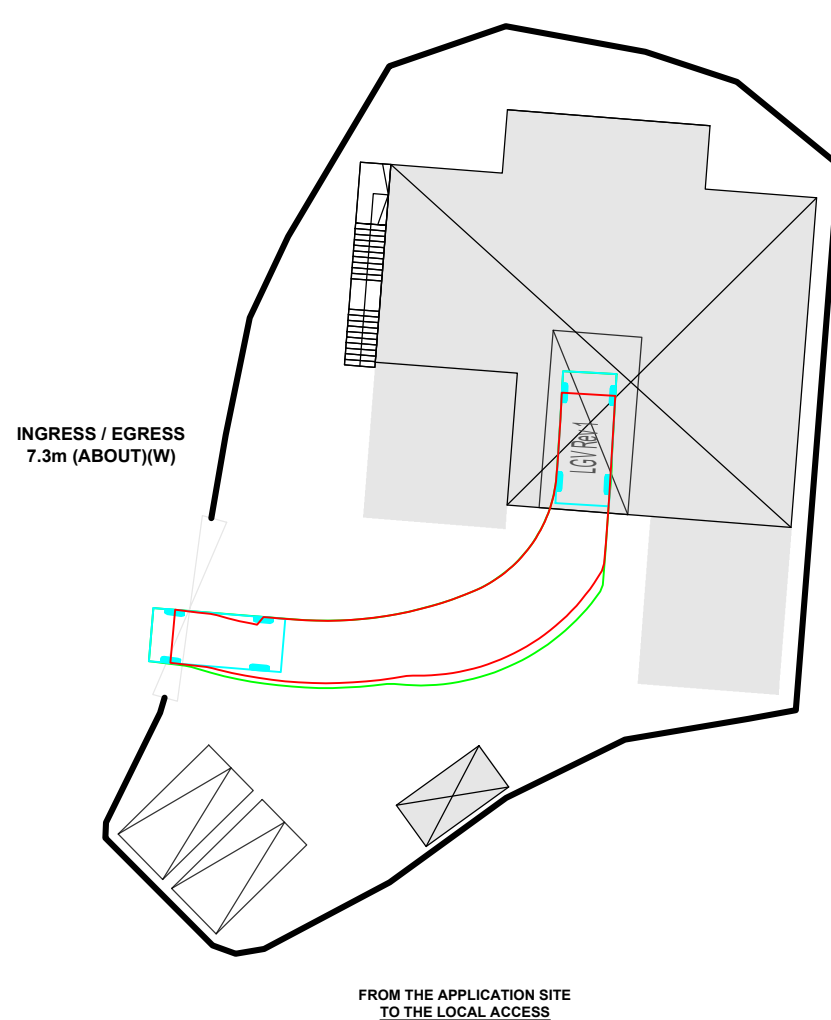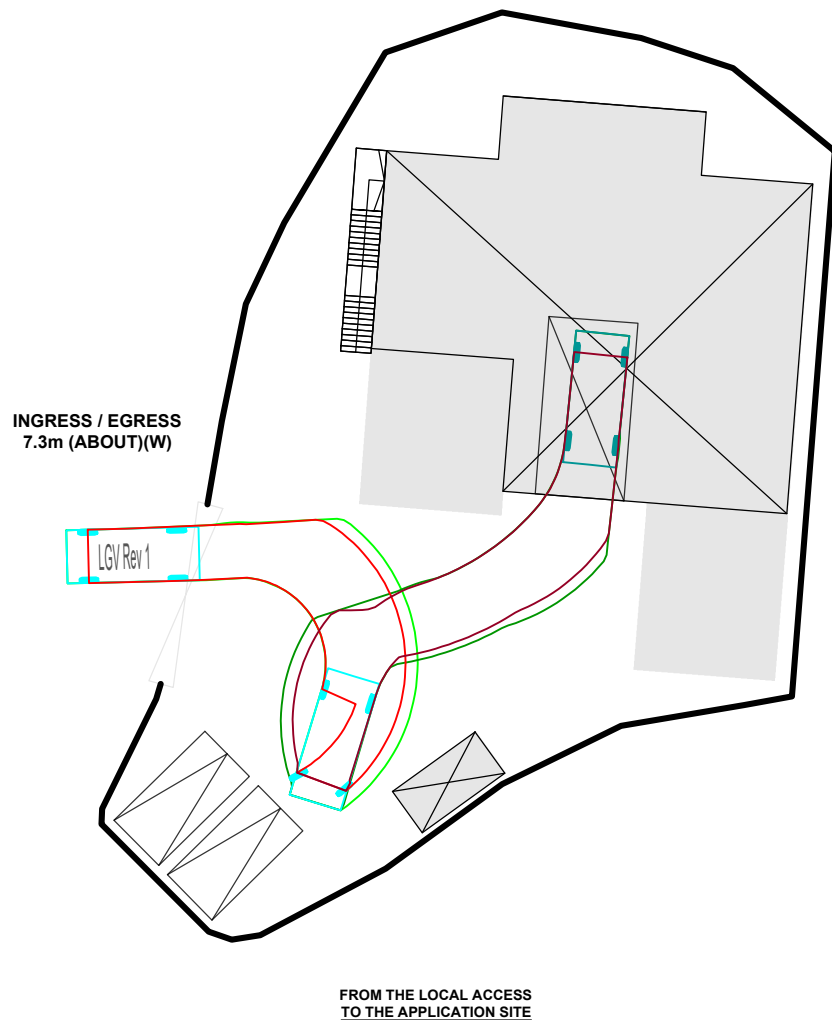

LEGEND

- APPLICATION SITE
- STRUCTURE
- PARKING SPACE (PC)
- LOADING / UNLOADING SPACE (LGV)
- INGRESS / EGRESS
- LIGHT GOODS VEHICLE
- SWEPT PATH OF VEHICLE

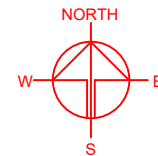

PLANNING CONSULTANT



PROJECT

PROPOSED WAREHOUSE (EXCLUDING DANGEROUS GOODS GODOWN) AND OPEN STORAGE OF CONSTRUCTION MATERIALS WITH ANCILLARY FACILITIES FOR A PERIOD OF 3 YEARS

SITE LOCATION

LOT 4115 (PART) IN D.D. 104, FUNG KAT HEUNG, KAM TIN, YUEN LONG, NEW TERRITORIES

SCALE

1 : 300 @ A4

DRAWN BY

MN

DATE

19.2.2024

CHECKED BY

DATE

APPROVED BY

DATE

DWG. TITLE

SWEPT PATH ANALYSIS

DWG. NO.



PLAN 6

VER.


001

Appendix I

Fire Service Installations Proposal

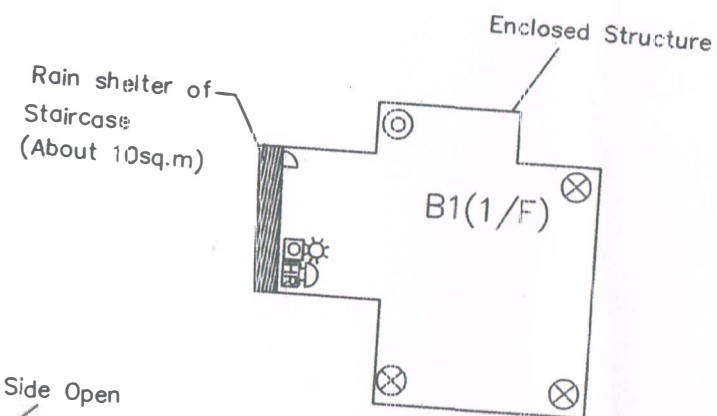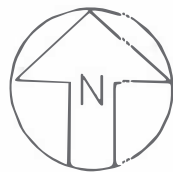

F.S. LAYOUT PLAN OF B1(1/F)

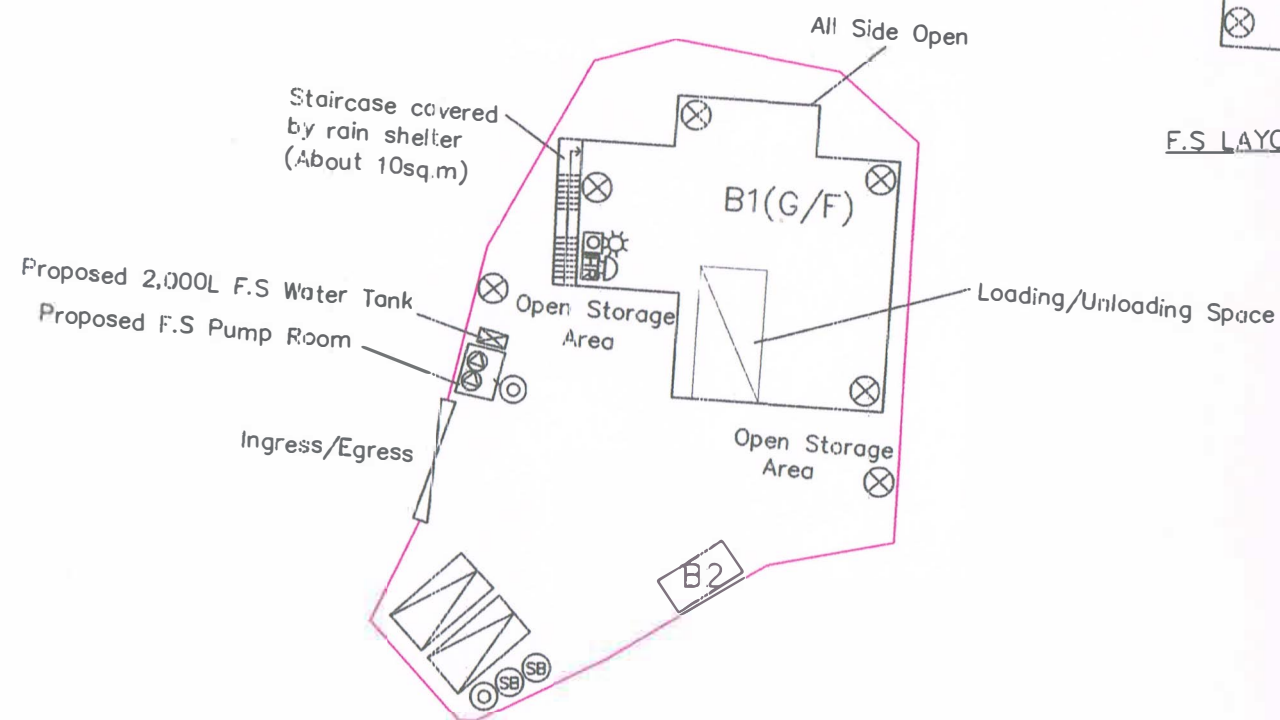

F.S. LAYOUT PLAN OF B1(G/F) & B2

NATURE OF OCCUPANCY:

B1(G/F): Staircase & All side open Structure for Storage of Goods (GFA: About: 219 sq.m)

B1(1/F): Structure for Office & Storage of Goods (GFA: About: 209 sq.m, G/F & 1/F Height: 8m)

B2: 1-Storey Portable Toilet (GFA: About: 8 sq.m, Height: 3m)

Legend:

-  4kg dry powder type fire extinguisher
-  5kg co2 type fire extinguisher
-  Sand Bucket
-  Hore Reel Set
-  150mm Fire Alarm Bell
-  Break Glass Call Point
-  Visual Alarm Device
-  F.S. Pump
-  Lot Boundary
-  New installations
-  parking spaces

Fire Notes:

1. Sufficient emergency lighting shall be provided throughout the entire building in accordance with BS5266:Part 1 and BS EN 1838.
2. Sufficient directional and exit sign shall be provided in accordance with BS 5266: Part 1 and FSD Circular letter 5/2008.
3. Sufficient portable hand-operated approved appliance shall be provided as marked on plans.
4. The goods to be stored in open storage area and should be combustible in nature.
5. A hose reel system should be supplied by a 2.0m³ F.S. Water tank. There shall be sufficient hose reel to ensure that every part of each building can be reached by a length of not more than 30m of hose reel tubing. The F.S. water tank, F.S. pump room and hose reel shall be clearly marked on plans.
6. Fire alarm system shall be provided throughout the entire building in accordance with BS 5839-1: 2002+A2: 2008 and FSD Circular Letter 1/2009. One actuation point and one audio warning device to be located at each hose reel point. The actuation point should include facilities for fire pump start and audio/Visual warning device initiation.
7. Hose Reel pump (HR-P1, HR-P2) and 1 no 5kg co2 type fire extinguisher shall be provided at F.S. pump Room.
8. The Secondary source of electrical supply should be provided.

INTERCEPT FIRE & SECURITY
TECHNICIANS LIMITED

Business Address:

Project:
Proposed Temporary Open Storage of
Construction Materials and Office for
a Period of 3 Years at Lot 4115 (Part) in
D.D.104, Fung Kat Heung, Kam Tin,
Yuen Long.

Title:
Proposed Fire Service Installation
Layout Plan

Drawn by:	W.C. WONG
Date:	2022-07-30
Scale:	1:400 @ A3
Ref No:	
Drawing No:	2022/FS/011


Appendix II

As-Built Drainage Record

Drainage Record


**Proposed Temporary Warehouse (Excluding Dangerous Goods Godown) and Open Storage of Construction Materials with Ancillary Facilities for a Period of 3 Years in "Other Specified Uses" annotated "Railway Reserve",
Lot 4115 (Part) in D.D. 104, Kam Tin, Yuen Long**

a) Accepted drainage proposal layout

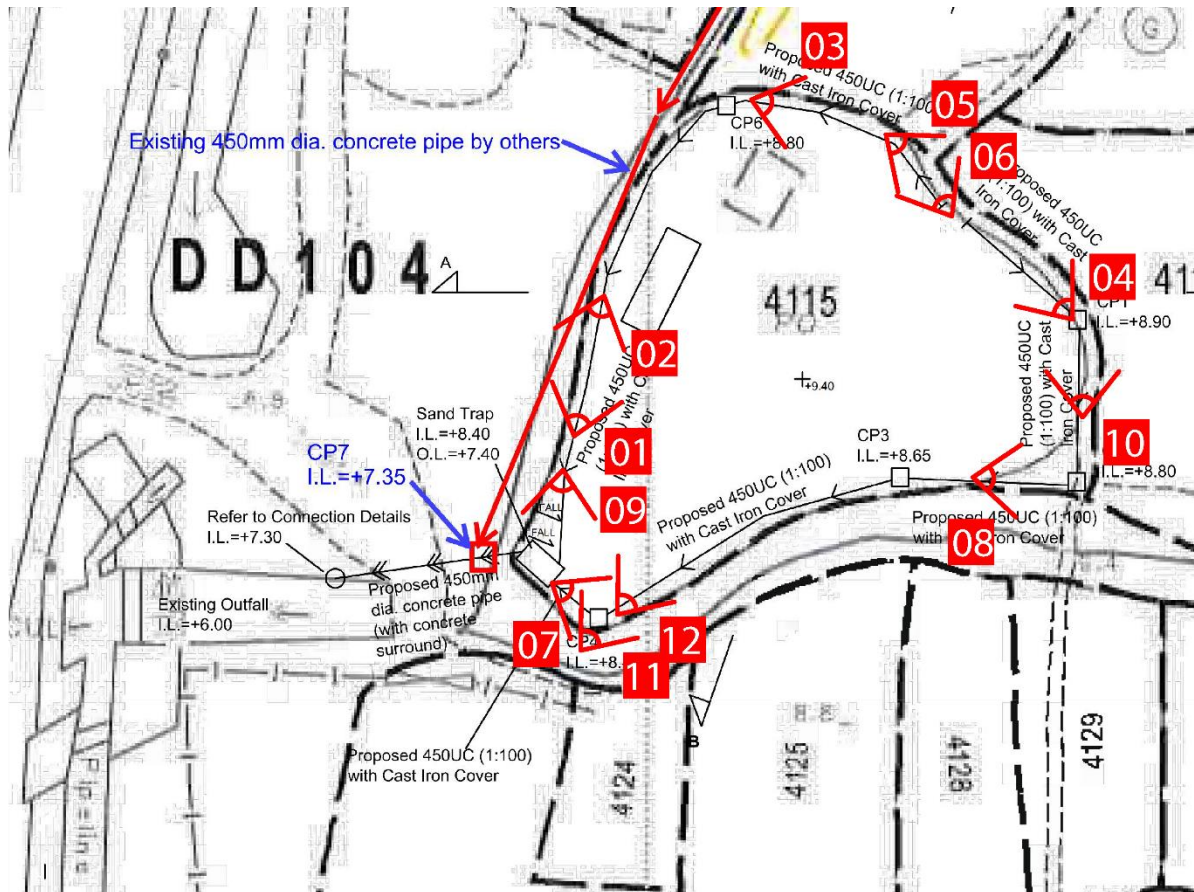

b) Site photo taken on 3.3.2026



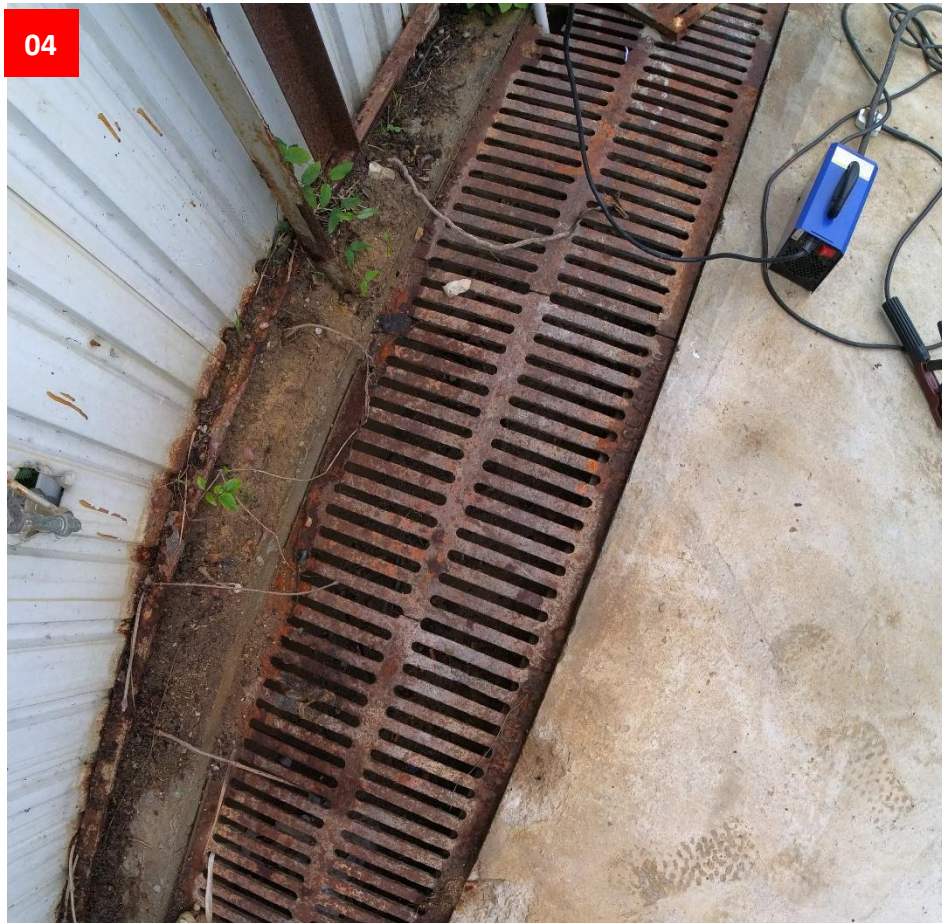


05



06



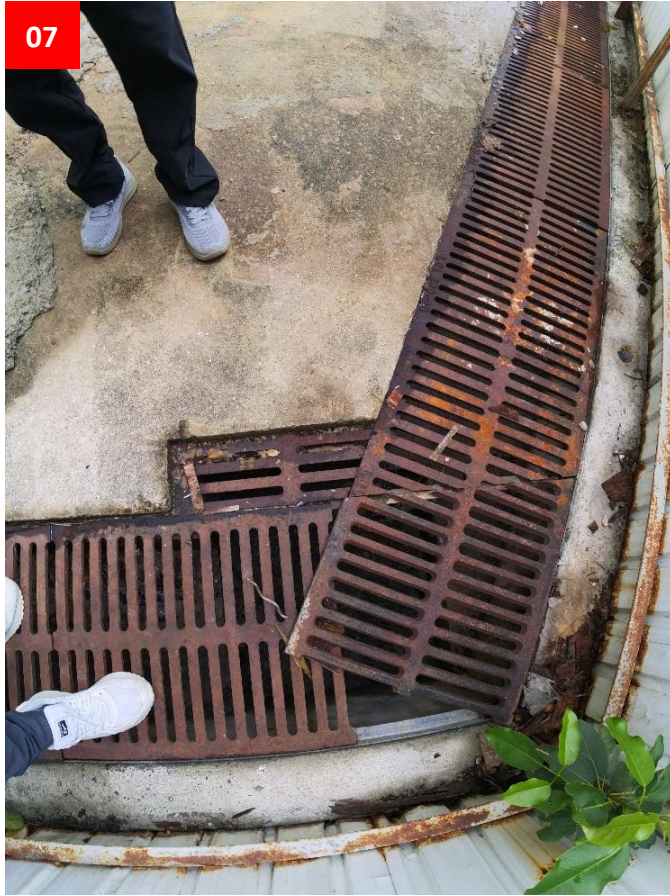


09



10



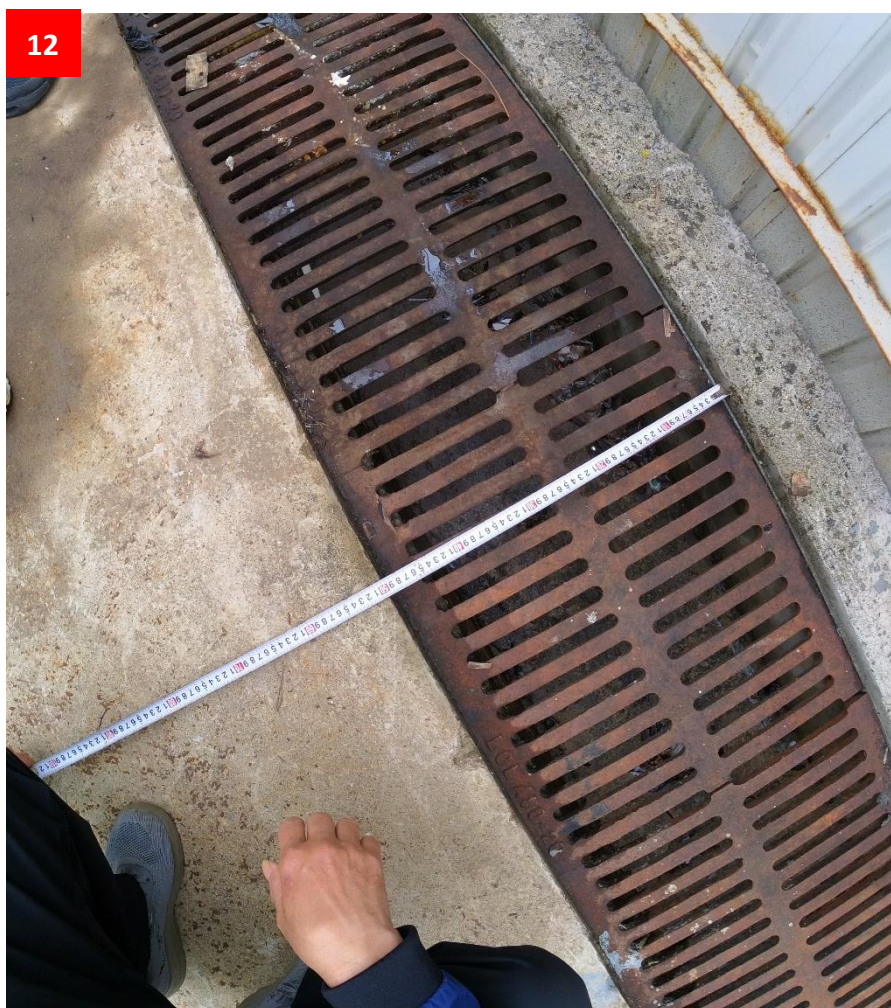

寄件者: Louis Tse <[REDACTED]>
寄件日期: 2026年03月27日星期五 17:11
收件者: tpbpd/PLAND
副本: Athena Pui Yin LAI/PLAND; Bon Tang; Matthew Ng; Christian Chim; Danny Ng; Grace Wong
主旨: [SI] S.16 Application No. A/YL-KTN/1222 - Supplementary Information
附件: SI for A_YL-KTN_1222 (20260327).pdf
類別: Internet Email

Dear Sir,

We write to submit supplementary information in support of the subject application (*attached*).

Should you require more information, please do not hesitate to contact us. Thank you for your kind attention.

Kind Regards,

Louis TSE | Town Planner
R-riches Group (HK) Limited

R-riches Property Consultants Limited | R-riches Planning Limited | R-riches Construction Limited

[REDACTED]

Our Ref. : DD104 Lot 4115(Pt)
Your Ref. : TPB/A/YL-KTN/1222

The Secretary,
Town Planning Board,
15/F, North Point Government Offices,
333 Java Road,
North Point, Hong Kong

By Email

27 March 2026

Dear Sir,

Supplementary Information

Proposed Temporary Warehouse (Excluding Dangerous Goods Godown) with Ancillary Open Storage of Construction Materials and Facilities for a Period of 3 Years in “Other Specified Use” annotated “Railway Reserve” Zone, Lot 4115 (Part) in D.D. 104, Kam Tin, Yuen Long, New Territories

(S.16 Planning Application No. A/YL-KTN/1222)

We are writing to submit supplementary information for the subject application, details are as follows:

- The applied use is revised as ‘*Proposed Temporary Warehouse (Excluding Dangerous Goods Godown) with Ancillary Open Storage of Construction Materials and Facilities for a Period of 3 Years*’ (**Annex I**).
- The application site (the Site) is the subject of an approved S.16 planning application (No. A/YL-KTN/841) for ‘open storage’ use submitted by a different applicant. As the applicant of the current application is the sole “current land owner” of the Site, the applicant would like to use the Site for the applied use in support of the local warehousing industry.
- 2.5m high solid metal fencing will be erected on the Site to minimize any potential nuisance to the surrounding areas.




Should you require more information regarding the application, please contact our Mr. Danny NG at [REDACTED] or the undersigned at your convenience. Thank you for your kind attention.

Yours faithfully,

For and on behalf of
R-riches Planning Limited



Louis TSE
Town Planner

 

6. Type(s) of Application 申請類別																					
(A) Temporary Use/Development of Land and/or Building Not Exceeding 3 Years in Rural Areas or Regulated Areas 位於鄉郊地區或受規管地區土地上及/或建築物內進行為期不超過三年的臨時用途/發展 (For Renewal of Permission for Temporary Use or Development in Rural Areas or Regulated Areas, please proceed to Part (B)) (如屬位於鄉郊地區或受規管地區臨時用途/發展的規劃許可續期，請填寫(B)部分)																					
(a) Proposed use(s)/development 擬議用途/發展	Proposed Temporary Warehouse (excluding Dangerous Goods Godown) with Ancillary Open Storage of Construction Materials and Facilities for a Period of 3 Years (Please illustrate the details of the proposal on a layout plan) (請用平面圖說明擬議詳情)																				
(b) Effective period of permission applied for 申請的許可有效期	☒ year(s) 年 3 ☐ month(s) 個月																				
(c) Development Schedule 發展細節表 Proposed uncovered land area 擬議露天土地面積 463sq.m ☒ About 約 Proposed covered land area 擬議有上蓋土地面積 227sq.m ☐ About 約 Proposed number of buildings/structures 擬議建築物／構築物數目 2 Proposed domestic floor area 擬議住用樓面面積 N/Asq.m ☐ About 約 Proposed non-domestic floor area 擬議非住用樓面面積 436sq.m ☒ About 約 Proposed gross floor area 擬議總樓面面積 436sq.m ☐ About 約																					
Proposed height and use(s) of different floors of buildings/structures (if applicable) 建築物/構築物的擬議高度及不同樓層的擬議用途 (如適用) (Please use separate sheets if the space below is insufficient) (如以下空間不足，請另頁說明)																					
<table border="1"> <thead> <tr> <th>STRUCTURE</th> <th>USE</th> <th>COVERED AREA</th> <th>GFA</th> <th>BUILDING HEIGHT</th> </tr> </thead> <tbody> <tr> <td>B1 (G/F) (1/F)</td> <td>STORAGE OF GOODS WAREHOUSE (EXCLUDING D.G.G.), SITE OFFICE</td> <td>219 m² (ABOUT)*</td> <td>219 m² (ABOUT)* 209 m² (ABOUT)</td> <td>8m (ABOUT)(2-STOREY)</td> </tr> <tr> <td>B2</td> <td>PORTABLE TOILET</td> <td>8 m² (ABOUT)</td> <td>8 m² (ABOUT)</td> <td>3m (ABOUT)(1-STOREY)</td> </tr> <tr> <td colspan="2">TOTAL</td> <td>227m² (ABOUT)</td> <td>436m² (ABOUT)</td> <td></td> </tr> </tbody> </table>	STRUCTURE	USE	COVERED AREA	GFA	BUILDING HEIGHT	B1 (G/F) (1/F)	STORAGE OF GOODS WAREHOUSE (EXCLUDING D.G.G.), SITE OFFICE	219 m ² (ABOUT)*	219 m ² (ABOUT)* 209 m ² (ABOUT)	8m (ABOUT)(2-STOREY)	B2	PORTABLE TOILET	8 m ² (ABOUT)	8 m ² (ABOUT)	3m (ABOUT)(1-STOREY)	TOTAL		227m ² (ABOUT)	436m ² (ABOUT)		*INCLUDE 10m ² STAIRCASE
STRUCTURE	USE	COVERED AREA	GFA	BUILDING HEIGHT																	
B1 (G/F) (1/F)	STORAGE OF GOODS WAREHOUSE (EXCLUDING D.G.G.), SITE OFFICE	219 m ² (ABOUT)*	219 m ² (ABOUT)* 209 m ² (ABOUT)	8m (ABOUT)(2-STOREY)																	
B2	PORTABLE TOILET	8 m ² (ABOUT)	8 m ² (ABOUT)	3m (ABOUT)(1-STOREY)																	
TOTAL		227m ² (ABOUT)	436m ² (ABOUT)																		
Proposed number of car parking spaces by types 不同種類停車位的擬議數目 Private Car Parking Spaces 私家車車位 2 Motorcycle Parking Spaces 電單車車位 N/A Light Goods Vehicle Parking Spaces 輕型貨車泊車位 N/A Medium Goods Vehicle Parking Spaces 中型貨車泊車位 N/A Heavy Goods Vehicle Parking Spaces 重型貨車泊車位 N/A Others (Please Specify) 其他 (請列明)																					
Proposed number of loading/unloading spaces 上落客貨車位的擬議數目 Taxi Spaces 的士車位 N/A Coach Spaces 旅遊巴車位 N/A Light Goods Vehicle Spaces 輕型貨車車位 1 Medium Goods Vehicle Spaces 中型貨車車位 N/A Heavy Goods Vehicle Spaces 重型貨車車位 N/A Others (Please Specify) 其他 (請列明)																					

Gist of Application 申請摘要 (Please provide details in both English and Chinese as far as possible. This part will be circulated to relevant consultees, uploaded to the Town Planning Board's Website for browsing and free downloading by the public and available at the Planning Enquiry Counters of the Planning Department for general information.) (請盡量以英文及中文填寫。此部分將會發送予相關諮詢人士、上載至城市規劃委員會網頁供公眾免費瀏覽及下載及於規劃署規劃資料查詢處供一般參閱。)	
Application No. 申請編號	(For Official Use Only) (請勿填寫此欄)
Location/address 位置／地址	Lot 4115 (Part) in D.D. 104, Kam Tin, Yuen Long, New Territories
Site area 地盤面積	690 sq. m 平方米 ☒ About 約 (includes Government land of 包括政府土地 N/A sq. m 平方米 ☐ About 約)
Plan 圖則	Approved Kam Tin North Outline Zoning Plan No.: S/YL-KTN/11
Zoning 地帶	"Other Specified Uses" annotated "Railway Reserve" Zone
Type of Application 申請類別	☒ Temporary Use/Development in Rural Areas or Regulated Areas for a Period of 位於鄉郊地區或受規管地區的臨時用途/發展為期 ☒ Year(s) 年 3 ☐ Month(s) 月 ☐ Renewal of Planning Approval for Temporary Use/Development in Rural Areas or Regulated Areas for a Period of 位於鄉郊地區或受規管地區臨時用途/發展的規劃許可續期為期 ☐ Year(s) 年 ☐ Month(s) 月
Applied use/development 申請用途/發展	Proposed Temporary Warehouse (excluding Dangerous Goods Godown) with Ancillary Open Storage of Construction Materials and Facilities for a Period of 3 Years