


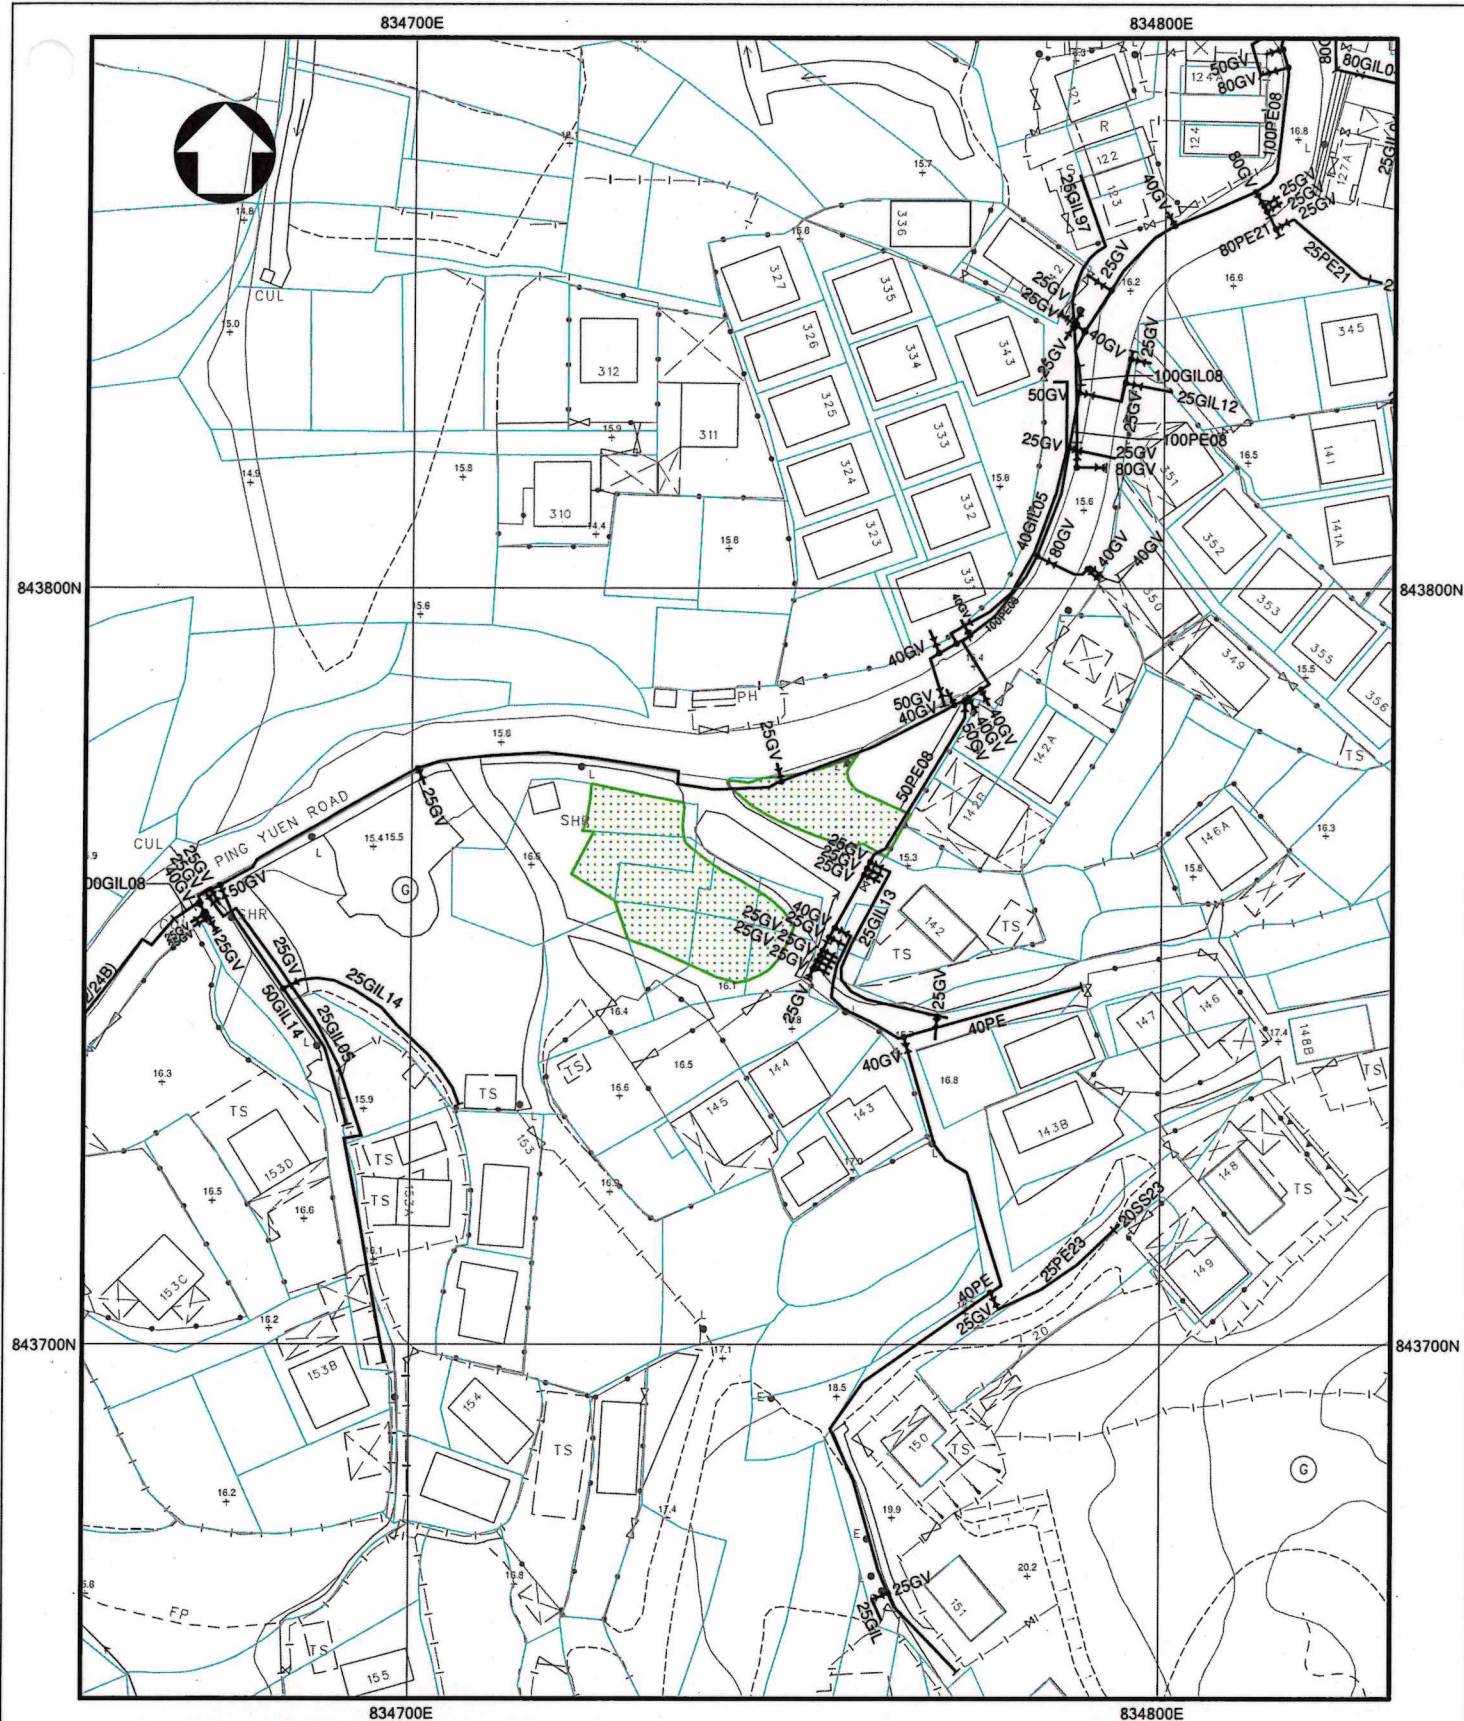

- NOTES:
1. ALL DIMENSIONS ARE IN MILLIMETRES UNLESS OTHERWISE SPECIFIED.
 2. ALL LEVELS ARE IN METRES ABOVE PRINCIPAL DATUM.
 3. INFORMATION ON ALIGNMENT OF MAINS IS OF INDICATIVE VALUE ONLY. WHERE POSITIONAL ACCURACY MAY BE OF IMPORTANCE, DETAILS SHOULD BE SITE CHECKED.
 4. FOR MAINS RECORDS SIGN CONVENTIONS AND DESIGNATIONS SEE SKETCH NO. 3988.
 5. NO EXISTING SALT WATER MAINS IN THE VICINITY OF THE SITE.
 6. NO PROPOSED WATER MAINS IN THE VICINITY OF THE SITE.
 7. NO EXISTING WSD CABLE IN THE VICINITY OF THE SITE.
 8. NO PROPOSED WSD CABLE IN THE VICINITY OF THE SITE.
 9. THE SITE IS NOT WITHIN WSD GATHERING GROUNDS.
 10. NO WSD LAND ALLOCATION / WWR WITHIN THE SITE AREA.
 11. NO WSD SLOPES ARE AFFECTED IN THE VICINITY OF THE SITE.

SUBJECT SITE



PRIVATE LOT
BOUNDARY
(FOR REF. ONLY)



PART COPY OF FRESH WATER MAINS RECORD PLAN(S)

W67880/3-NW-19A & 19C

FILE REF: (8) IN WSD/M/SP 3051/437/11S/96 PT.1

REF. CODE: 37W26M

SHEET 1 OF 1

SCALE 1:1000



水務署
Water Supplies Department